

DURABLE 4 INCH WHITE LINE (SEE OPTION ITEMS)
 STA. 214+75 - STA. 220+25 (SOLID LT & RT)

TEMPORARY 4 INCH WHITE LINE, PAINT
 STA. 214+75 - STA. 220+25 (SOLID LT & RT)

STONE FILL, TYPE I
 STA. 218+25 - STA. 218+40 RT
 STA. 218+68 - STA. 218+85 LT

DURABLE 4 INCH YELLOW LINE, POLYUREA
 STA. 214+75 - STA. 220+25 (SOLID LT & RT)

TEMPORARY 4 INCH YELLOW LINE, PAINT
 STA. 214+75 - STA. 220+25 (SOLID LT & RT)


GEOTEXTILE FOR SILT FENCE
 STA. 218+25 - STA. 218+40 RT
 STA. 218+68 - STA. 218+85 LT

6 INCH UNDERDRAIN PIPE
~~STA. 217+50 - STA. 218+61 LT~~
~~STA. 218+85 - STA. 220+25 LT~~
~~STA. 216+17 - STA. 219+25 LT~~
 MILLED RUMBLE STRIPS
 STA. 214+75 - STA. 220+25 CTR

REMOVING SIGNS
 AS SHOWN - 1

ERECTING SALVAGED SIGNS
 AS SHOWN - 1

GRUBBING MATERIAL (6")
 STA. 218+25 - STA. 218+40 RT
 STA. 218+68 - STA. 218+85 LT

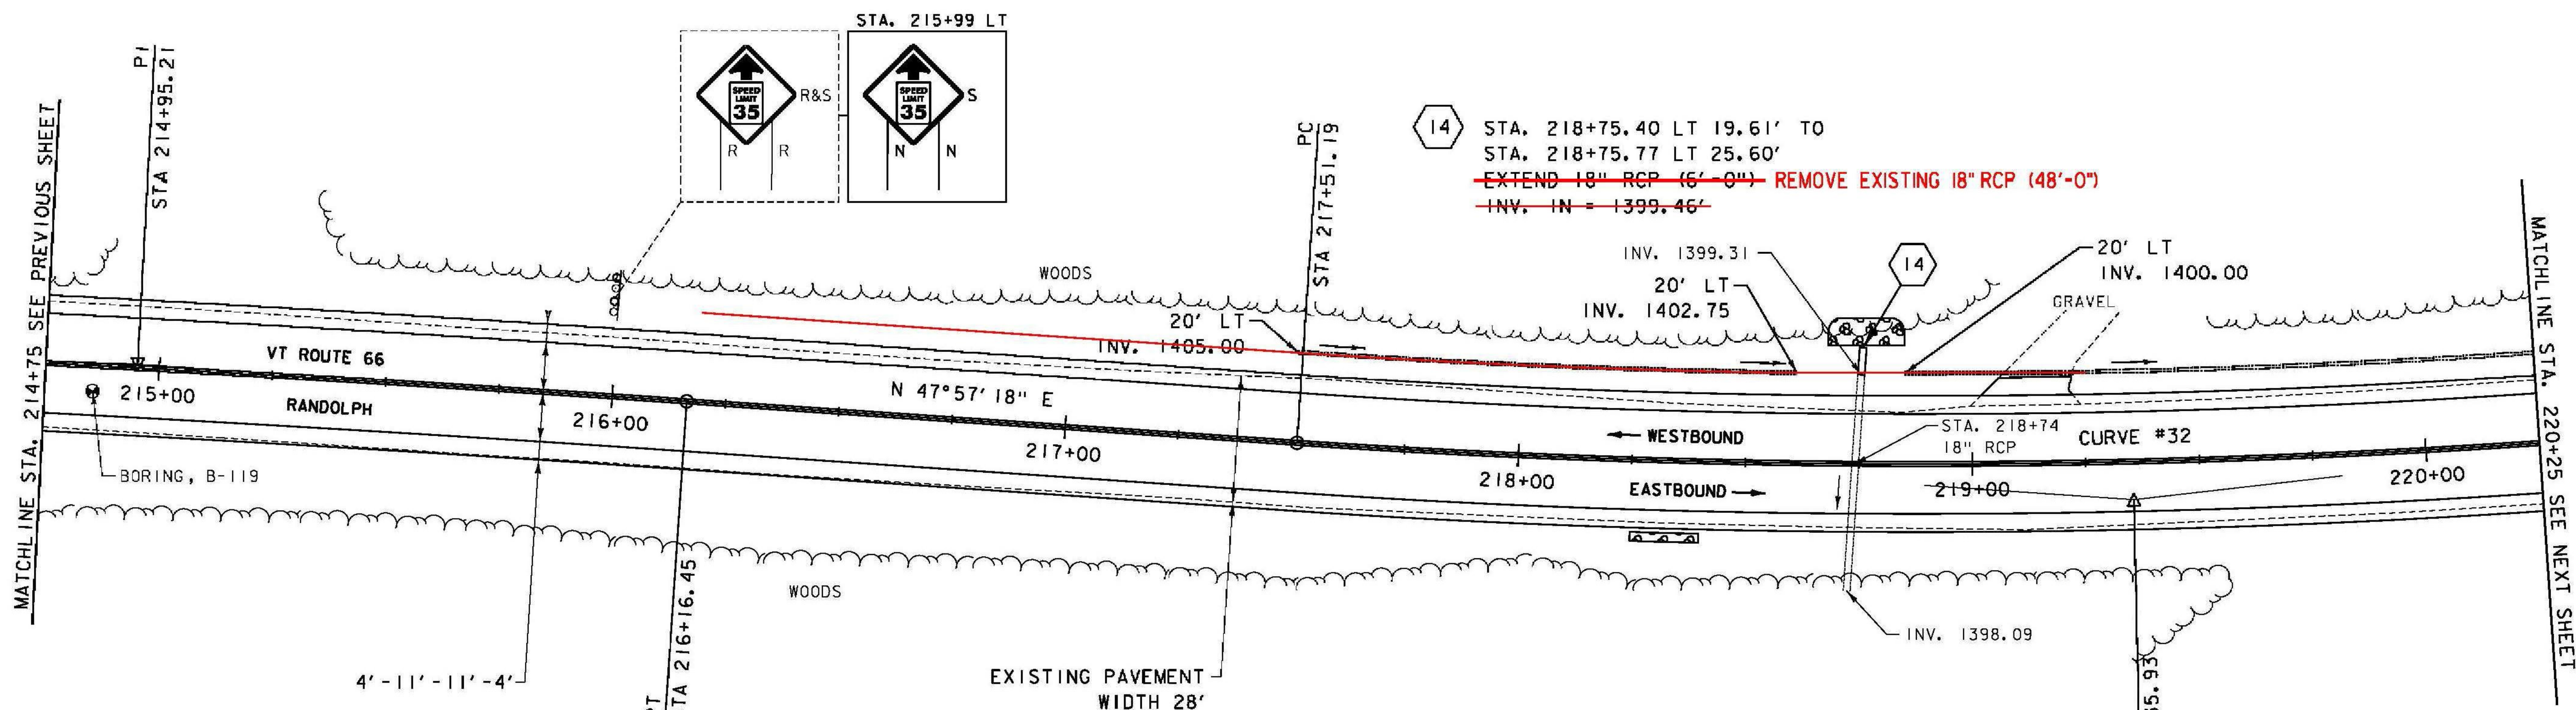

14 STA. 218+75.40 LT 19.61' TO
 STA. 218+75.77 LT 25.60'
~~EXTEND 18" RCP (6'-0") REMOVE EXISTING 18" RCP (48'-0")~~
~~INV. IN = 1399.46'~~

CURVE #32
 DELTA = 10° 25' 31"
 D = 2° 49' 46"
 R = 2025.00'
 T = 184.74'
 L = 368.46'
 E = 8.41'
 BANKING 0.051 FT/FT
 DESIGN SPEED 50 MPH
 SEE SUPERELEVATION DIAGRAMS
 FOR MORE INFORMATION

SIGN LEGEND
 R = REMOVE
 R&S = REMOVE AND SALVAGE
 RET = RETAIN
 S = SALVAGE
 N = NEW
 B-B = BACK TO BACK
 --- = EXISTING
 ——— = NEW



PROJECT NAME: RANDOLPH	FILE NAME: z10c270.dgn	PLOT DATE: 6/5/2014
PROJECT NUMBER: STP 2932 (1)	DESIGNED BY: B. BRESLEND	DRAWN BY: B. BRESLEND
	PROJECT LAYOUT SHEET 35	CHECKED BY: C. LATHROP
		SHEET 66 OF 276