

DURABLE 4 INCH WHITE LINE (SEE OPTION ITEMS)  
STA. 225+75 - STA. 231+25 (SOLID LT & RT)

TEMPORARY 4 INCH WHITE LINE, PAINT  
STA. 225+75 - STA. 231+25 (SOLID LT & RT)

DURABLE 4 INCH YELLOW LINE, POLYUREA  
STA. 225+75 - STA. 231+25 (SOLID LT & RT)

TEMPORARY 4 INCH YELLOW LINE, PAINT  
STA. 225+75 - STA. 231+25 (SOLID LT & RT)

REMOVING SIGNS  
AS SHOWN - 1


6 INCH UNDERDRAIN PIPE

STA. 225+75 - STA. 228+00 RT  
~~STA. 226+55 - STA. 228+00 LT~~  
~~STA. 228+50 - STA. 229+75 LT~~ STA. 226+35 - STA. 228+00 LT  
STA. 228+35 - STA. 229+67 LT

16 STA. 229+88.34 LT 27.99' TO  
STA. 229+89.86 RT 31.99'  
REMOVE HEADWALL AND PIPE  
INSTALL NEW 18" CPEP (60' - 0")  
INV. IN = 1420.60'  
INV. OUT = 1418.45'


SOLID ROCK EXCAVATION  
STA. 228+60 - STA. 229+05 LT

MILLED RUMBLE STRIPS  
STA. 225+75 - STA. 231+25 CTR

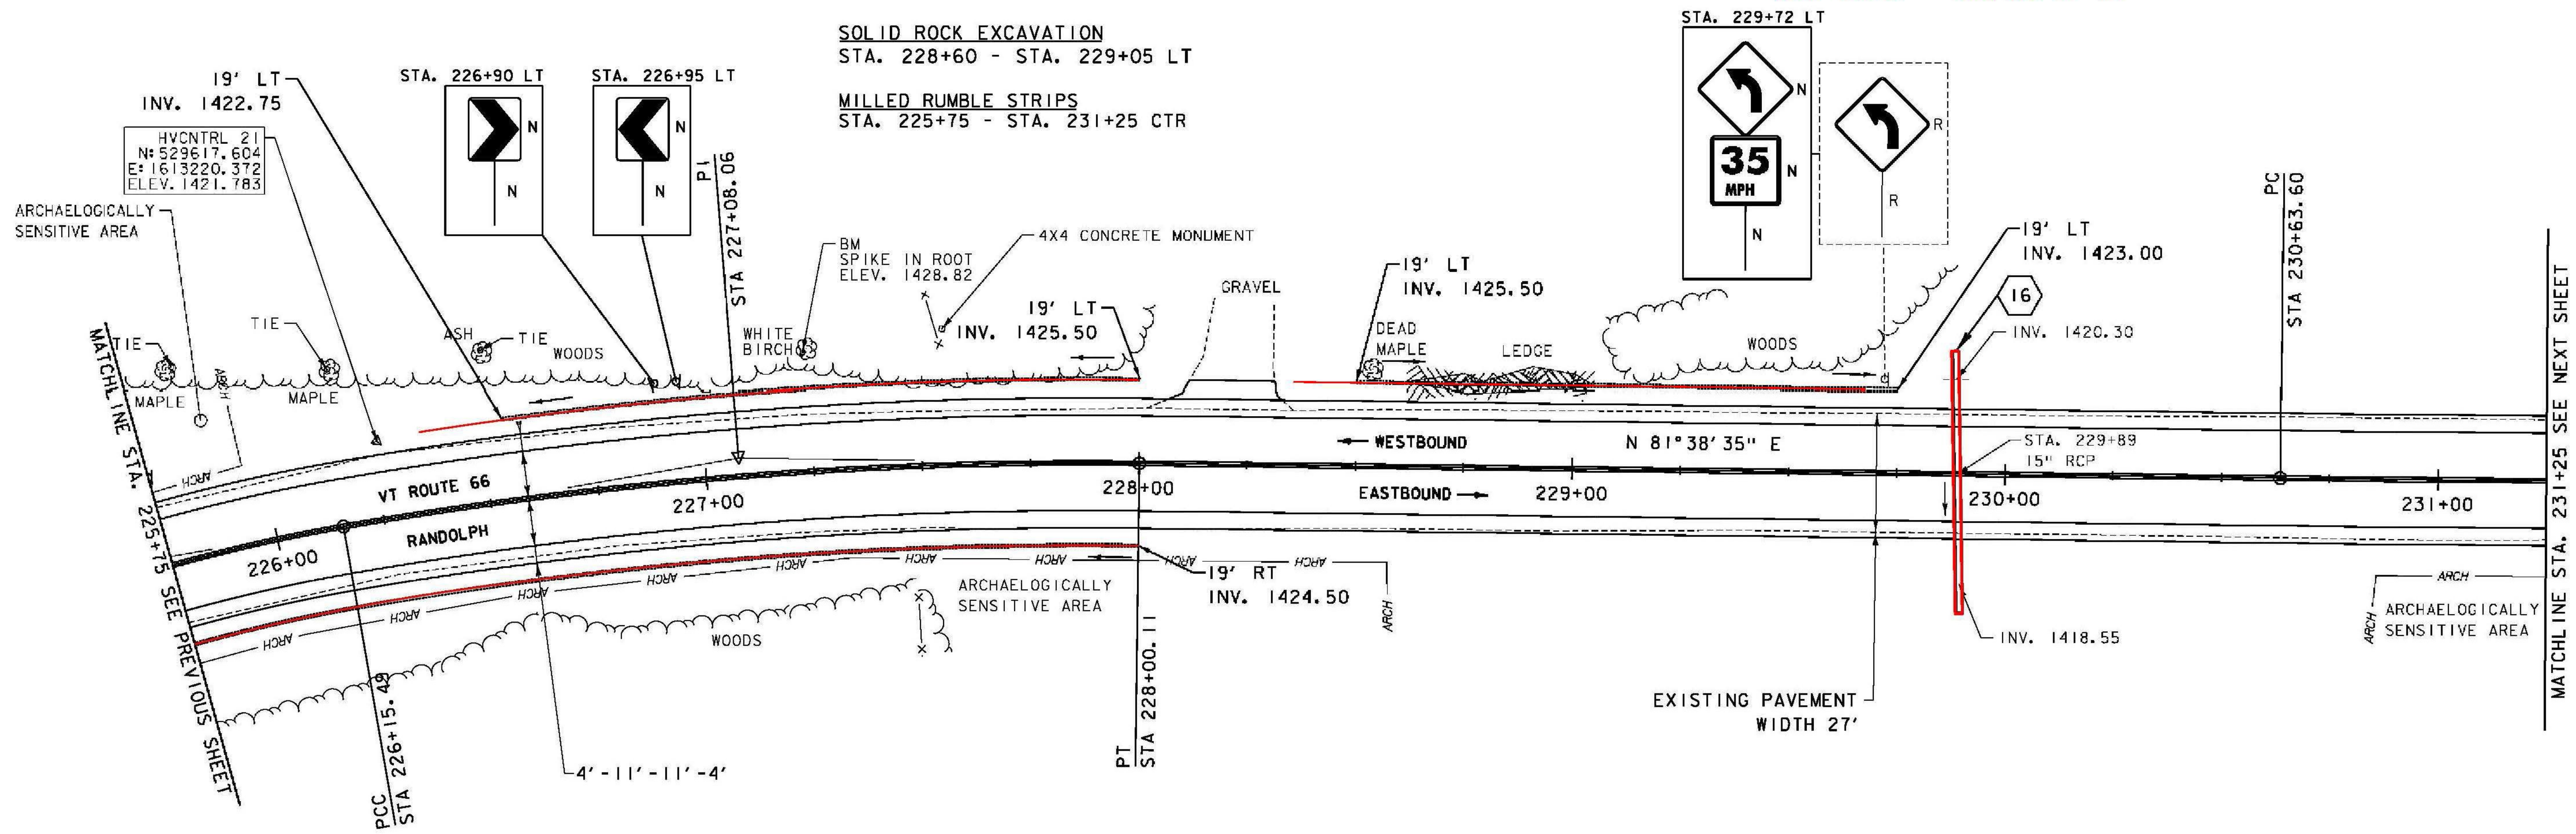

**SIGN LEGEND**

- R = REMOVE
- R&S = REMOVE AND SALVAGE
- RET = RETAIN
- S = SALVAGE
- N = NEW
- B-B = BACK TO BACK
- = EXISTING
- = NEW

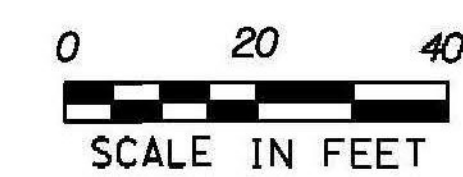

PROJECT NAME: RANDOLPH  
PROJECT NUMBER: STP 2932 (1)

FILE NAME: z10c270.dgn  
PROJECT LEADER: C. LATHROP  
DESIGNED BY: B. BRESLEND  
PROJECT LAYOUT SHEET 37

PLOT DATE: 6/5/2014  
DRAWN BY: B. BRESLEND  
CHECKED BY: C. LATHROP  
SHEET 68 OF 276