

DURABLE 4 INCH WHITE LINE (SEE OPTION ITEMS)
 STA. 242+50 - STA. 247+75 (SOLID LT & RT)

TEMPORARY 4 INCH WHITE LINE, PAINT
 STA. 242+50 - STA. 247+75 (SOLID LT & RT)



DURABLE 4 INCH YELLOW LINE, POLYUREA
 STA. 242+50 - STA. 247+75 (SOLID LT & RT)

TEMPORARY 4 INCH YELLOW LINE, PAINT
 STA. 242+50 - STA. 247+75 (SOLID LT & RT)


REMOVING SIGNS
 AS SHOWN - 4

MILLED RUMBLE STRIPS
 STA. 242+50 - STA. 247+75 CTR

6 INCH UNDERDRAIN PIPE
 STA. 242+50 - STA. 244+75 RT
 STA. 244+92 - STA. 247+75 RT
 STA. 247+50 - STA. 247+75 LT NA

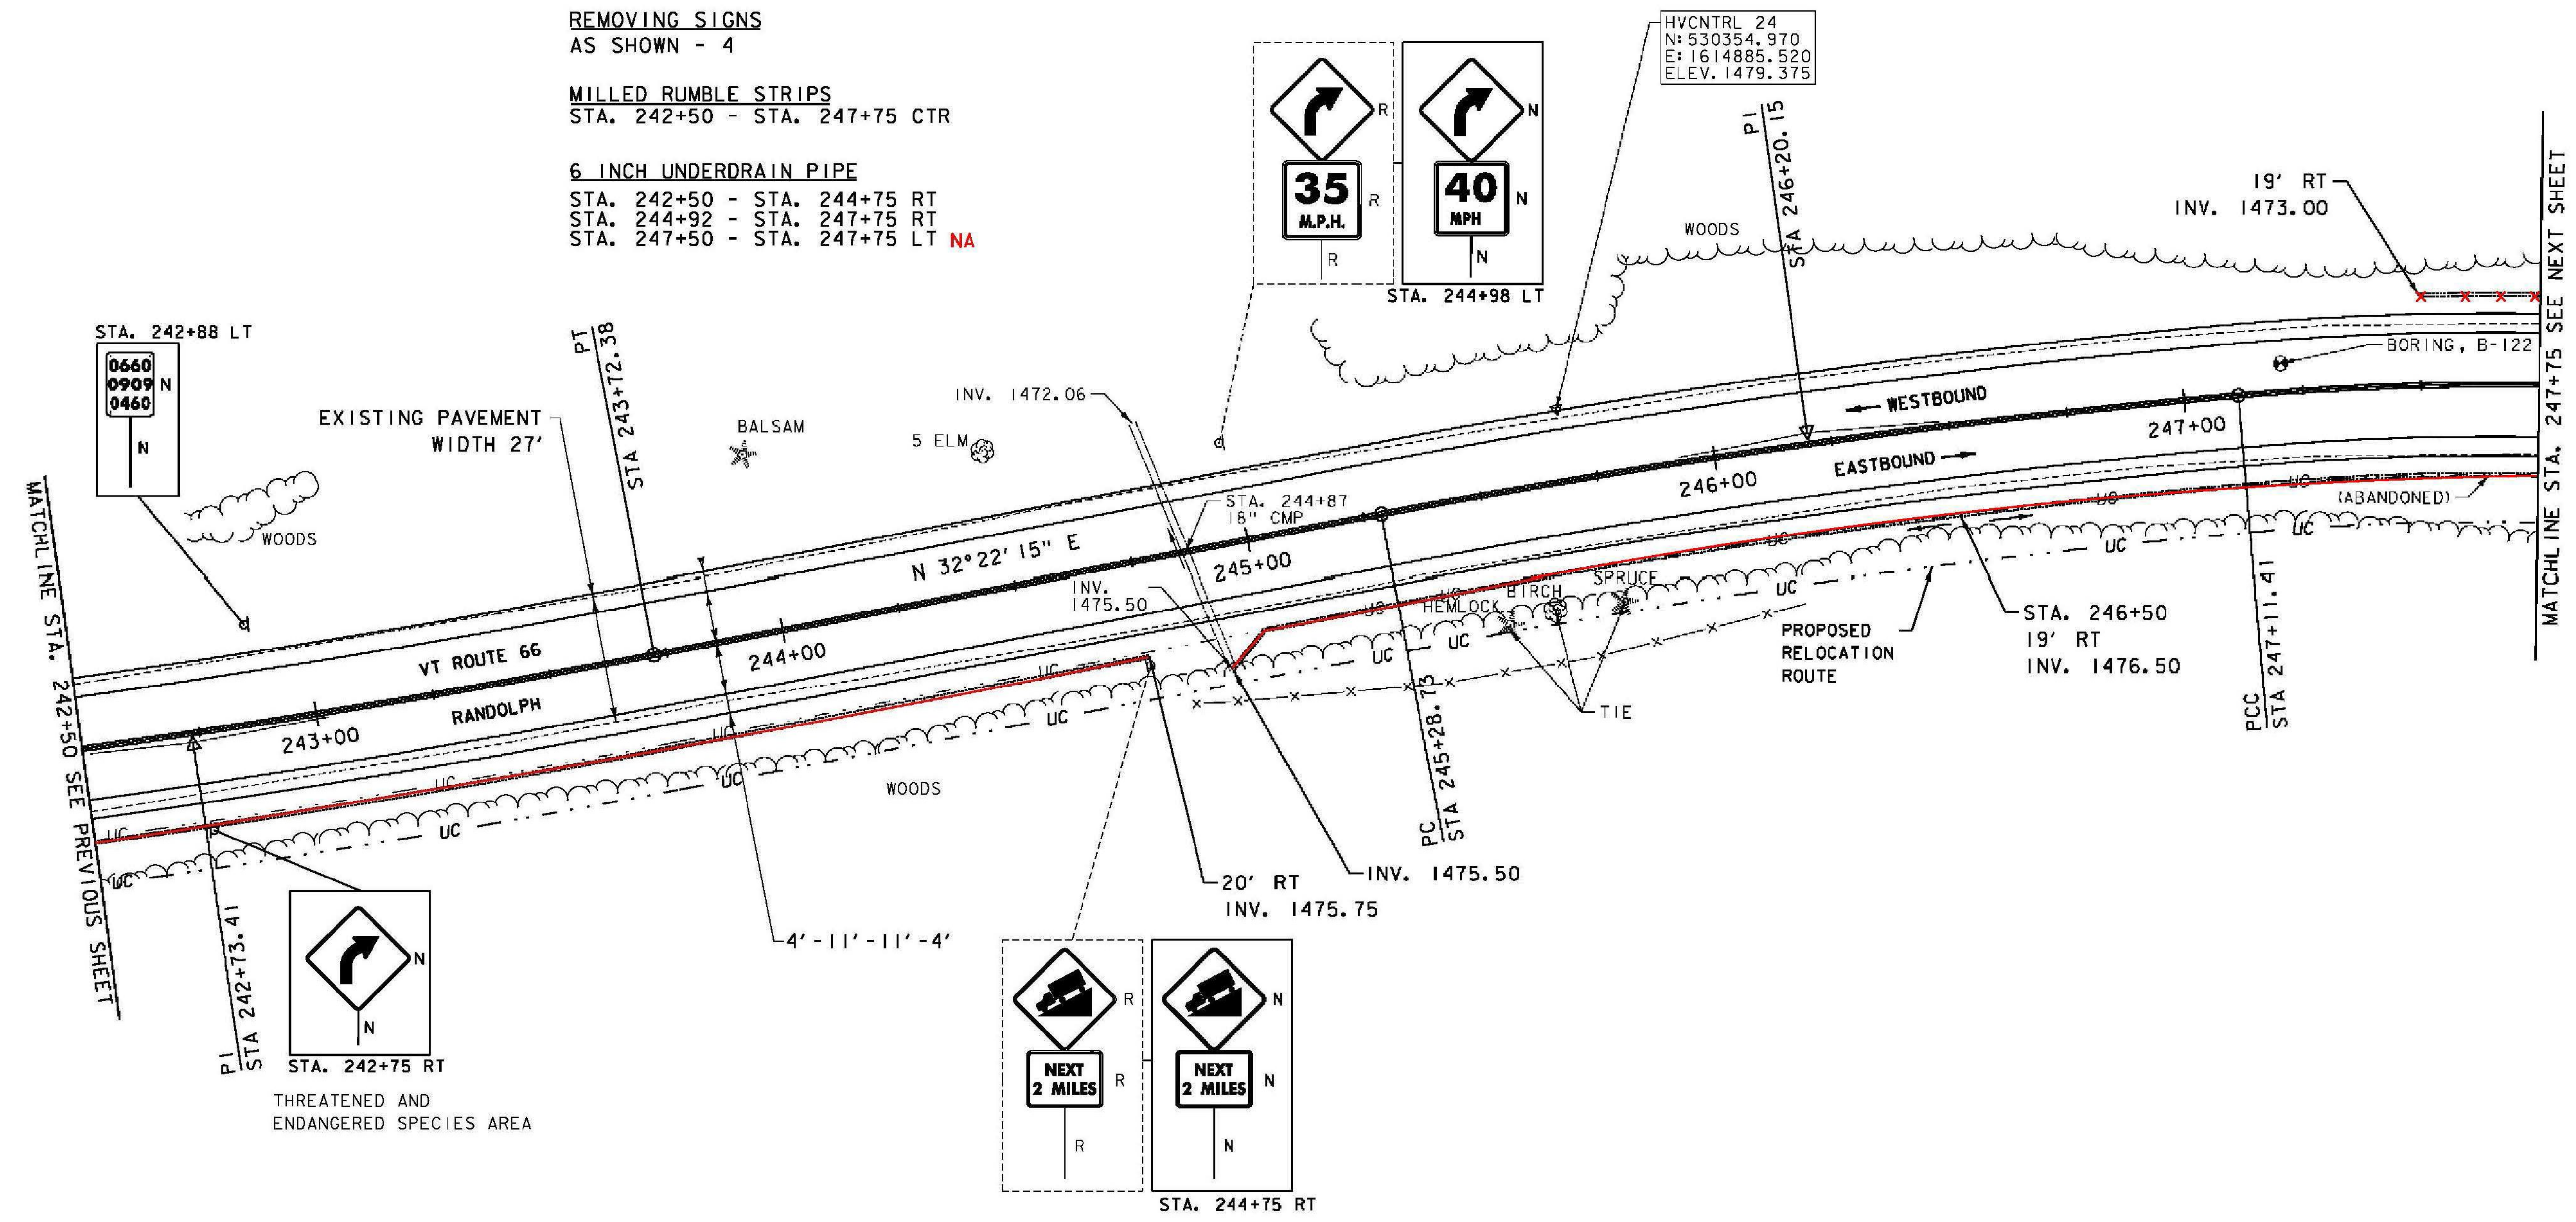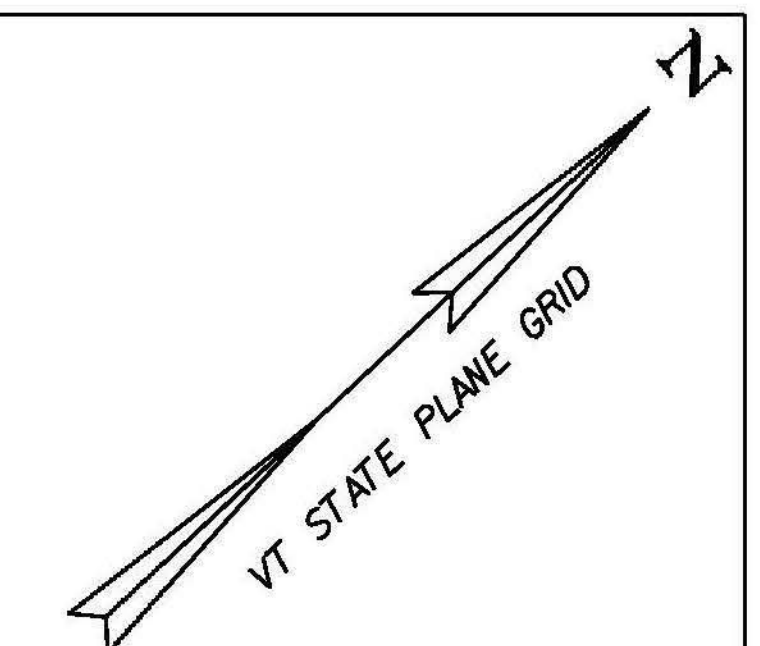

SIGN LEGEND
 R = REMOVE
 R&S = REMOVE AND SALVAGE
 RET = RETAIN
 S = SALVAGE
 N = NEW
 B-B = BACK TO BACK
 --- = EXISTING
 — = NEW

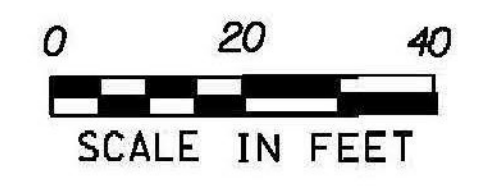

PROJECT NAME: RANDOLPH	PLOT DATE: 6/5/2014
PROJECT NUMBER: STP 2932 (1)	DRAWN BY: B. BRESLEND
FILE NAME: z10c270.dgn	CHECKED BY: C. LATHROP
PROJECT LEADER: C. LATHROP	SHEET 71 OF 276
DESIGNED BY: B. BRESLEND	
PROJECT LAYOUT SHEET 40	