

DURABLE 4 INCH WHITE LINE (SEE OPTION ITEMS)
 STA. 259+25 - STA. 264+50 (SOLID LT & RT)

TEMPORARY 4 INCH WHITE LINE, PAINT
 STA. 259+25 - STA. 264+50 (SOLID LT & RT)



REMOVING SIGNS
 AS SHOWN - 1

DURABLE 4 INCH YELLOW LINE, POLYUREA
 STA. 259+25 - STA. 264+50 (SOLID LT & RT)

TEMPORARY 4 INCH YELLOW LINE, PAINT
 STA. 259+25 - STA. 264+50 (SOLID LT & RT)


MILLED RUMBLE STRIPS
 STA. 259+25 - STA. 264+50 CTR

6 INCH UNDERDRAIN PIPE
~~STA. 259+25 - STA. 263+75 RT~~ STA. 259+35 - STA. 264+05 RT
 STA. 259+25 - STA. 264+50 LT

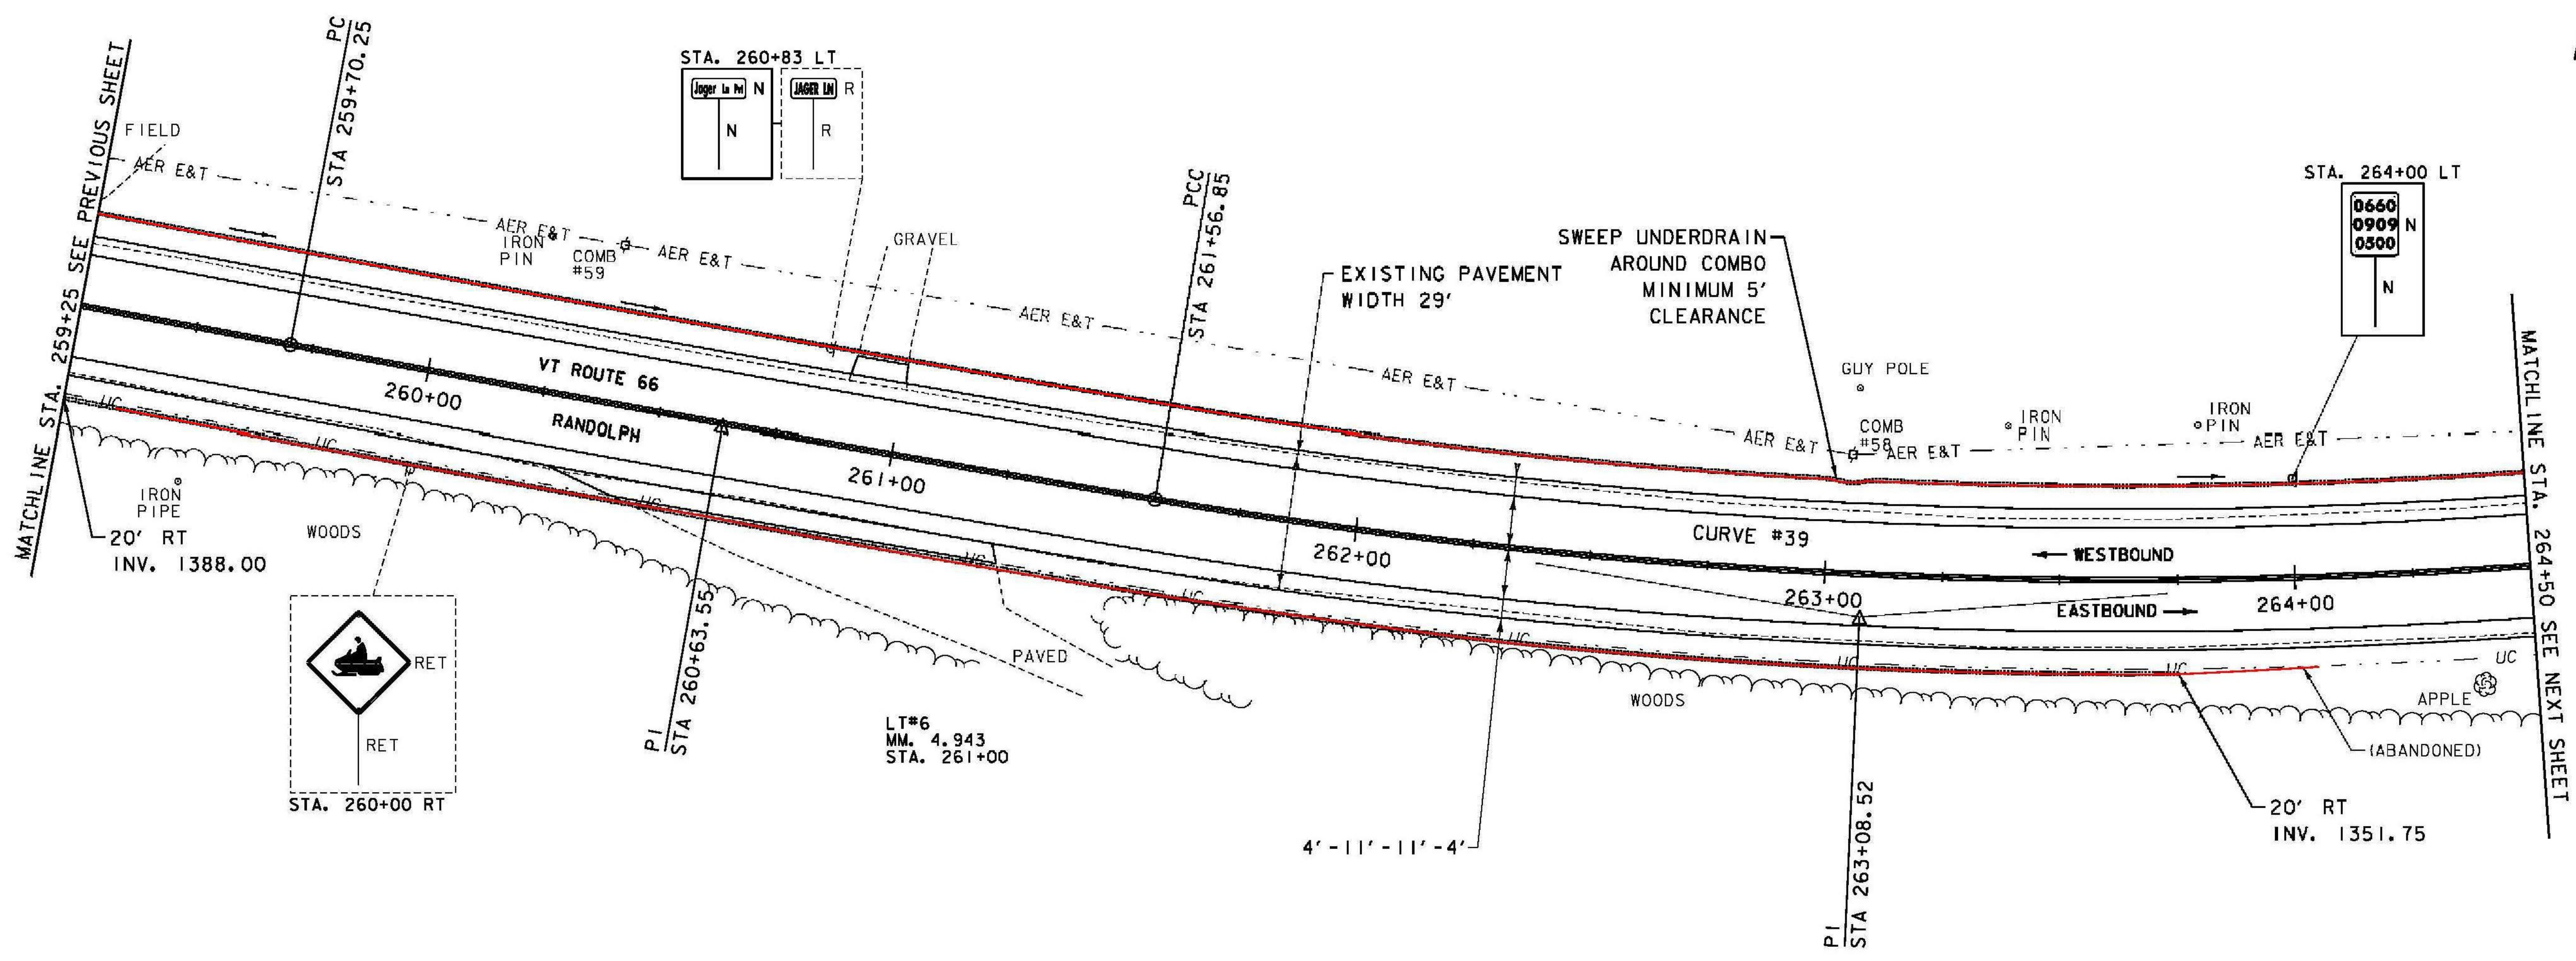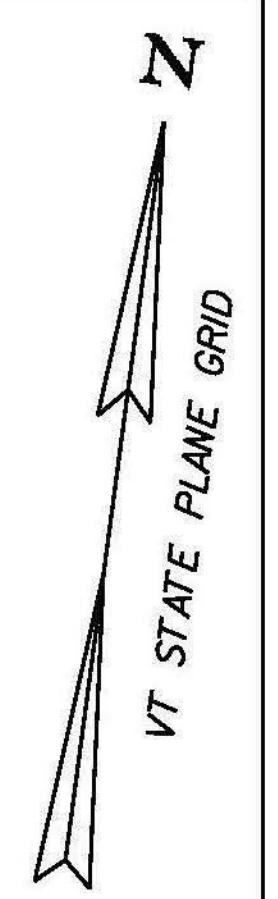

CURVE #39
 DELTA = 14° 54' 18"
 D = 0° 34' 23" (1) D = 4° 35' 01" (2)
 R = 10000.00' (1) R = 1250.00' (2)
 T = 321.05' (1) T = 169.43' (2)
 L = 186.60' (1) L = 301.85' (2)
 E = 5.15'
 BANKING NORMAL CROWN, 0.069 FT/FT
 DESIGN SPEED 50 MPH
 SEE SUPERELEVATION DIAGRAMS
 FOR MORE INFORMATION

- SIGN LEGEND**
- R = REMOVE
 - R&S = REMOVE AND SALVAGE
 - RET = RETAIN
 - S = SALVAGE
 - N = NEW
 - B-B = BACK TO BACK
 - = EXISTING
 - = NEW

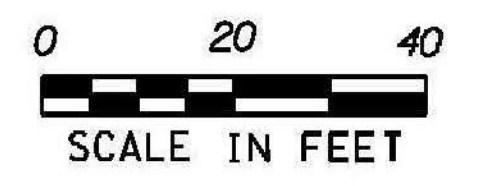

PROJECT NAME: RANDOLPH	PLOT DATE: 6/5/2014
PROJECT NUMBER: STP 2932 (1)	DRAWN BY: B. BRESLEND
FILE NAME: z10c270.dgn	CHECKED BY: C. LATHROP
DESIGNED BY: B. BRESLEND	PROJECT LAYOUT SHEET 43
	SHEET 74 OF 276