

DURABLE 4 INCH WHITE LINE (SEE OPTION ITEMS)
 STA. 270+25 - STA. 275+75 (SOLID LT & RT)

TEMPORARY 4 INCH WHITE LINE, PAINT
 STA. 270+25 - STA. 275+75 (SOLID LT & RT)



DURABLE 4 INCH YELLOW LINE, POLYUREA
 STA. 270+25 - STA. 275+75 (SOLID LT & RT)

TEMPORARY 4 INCH YELLOW LINE, PAINT
 STA. 270+25 - STA. 275+75 (SOLID LT & RT)

REMOVING SIGNS
 AS SHOWN - 1

SOLID ROCK EXCAVATION
 STA. 273+35 - STA. 273+80 LT

6 INCH UNDERDRAIN PIPE
 STA. 270+25 - STA. 270+41 LT
~~STA. 270+50 - STA. 274+80 LT~~
 STA. 270+55 - STA. 274+61 LT

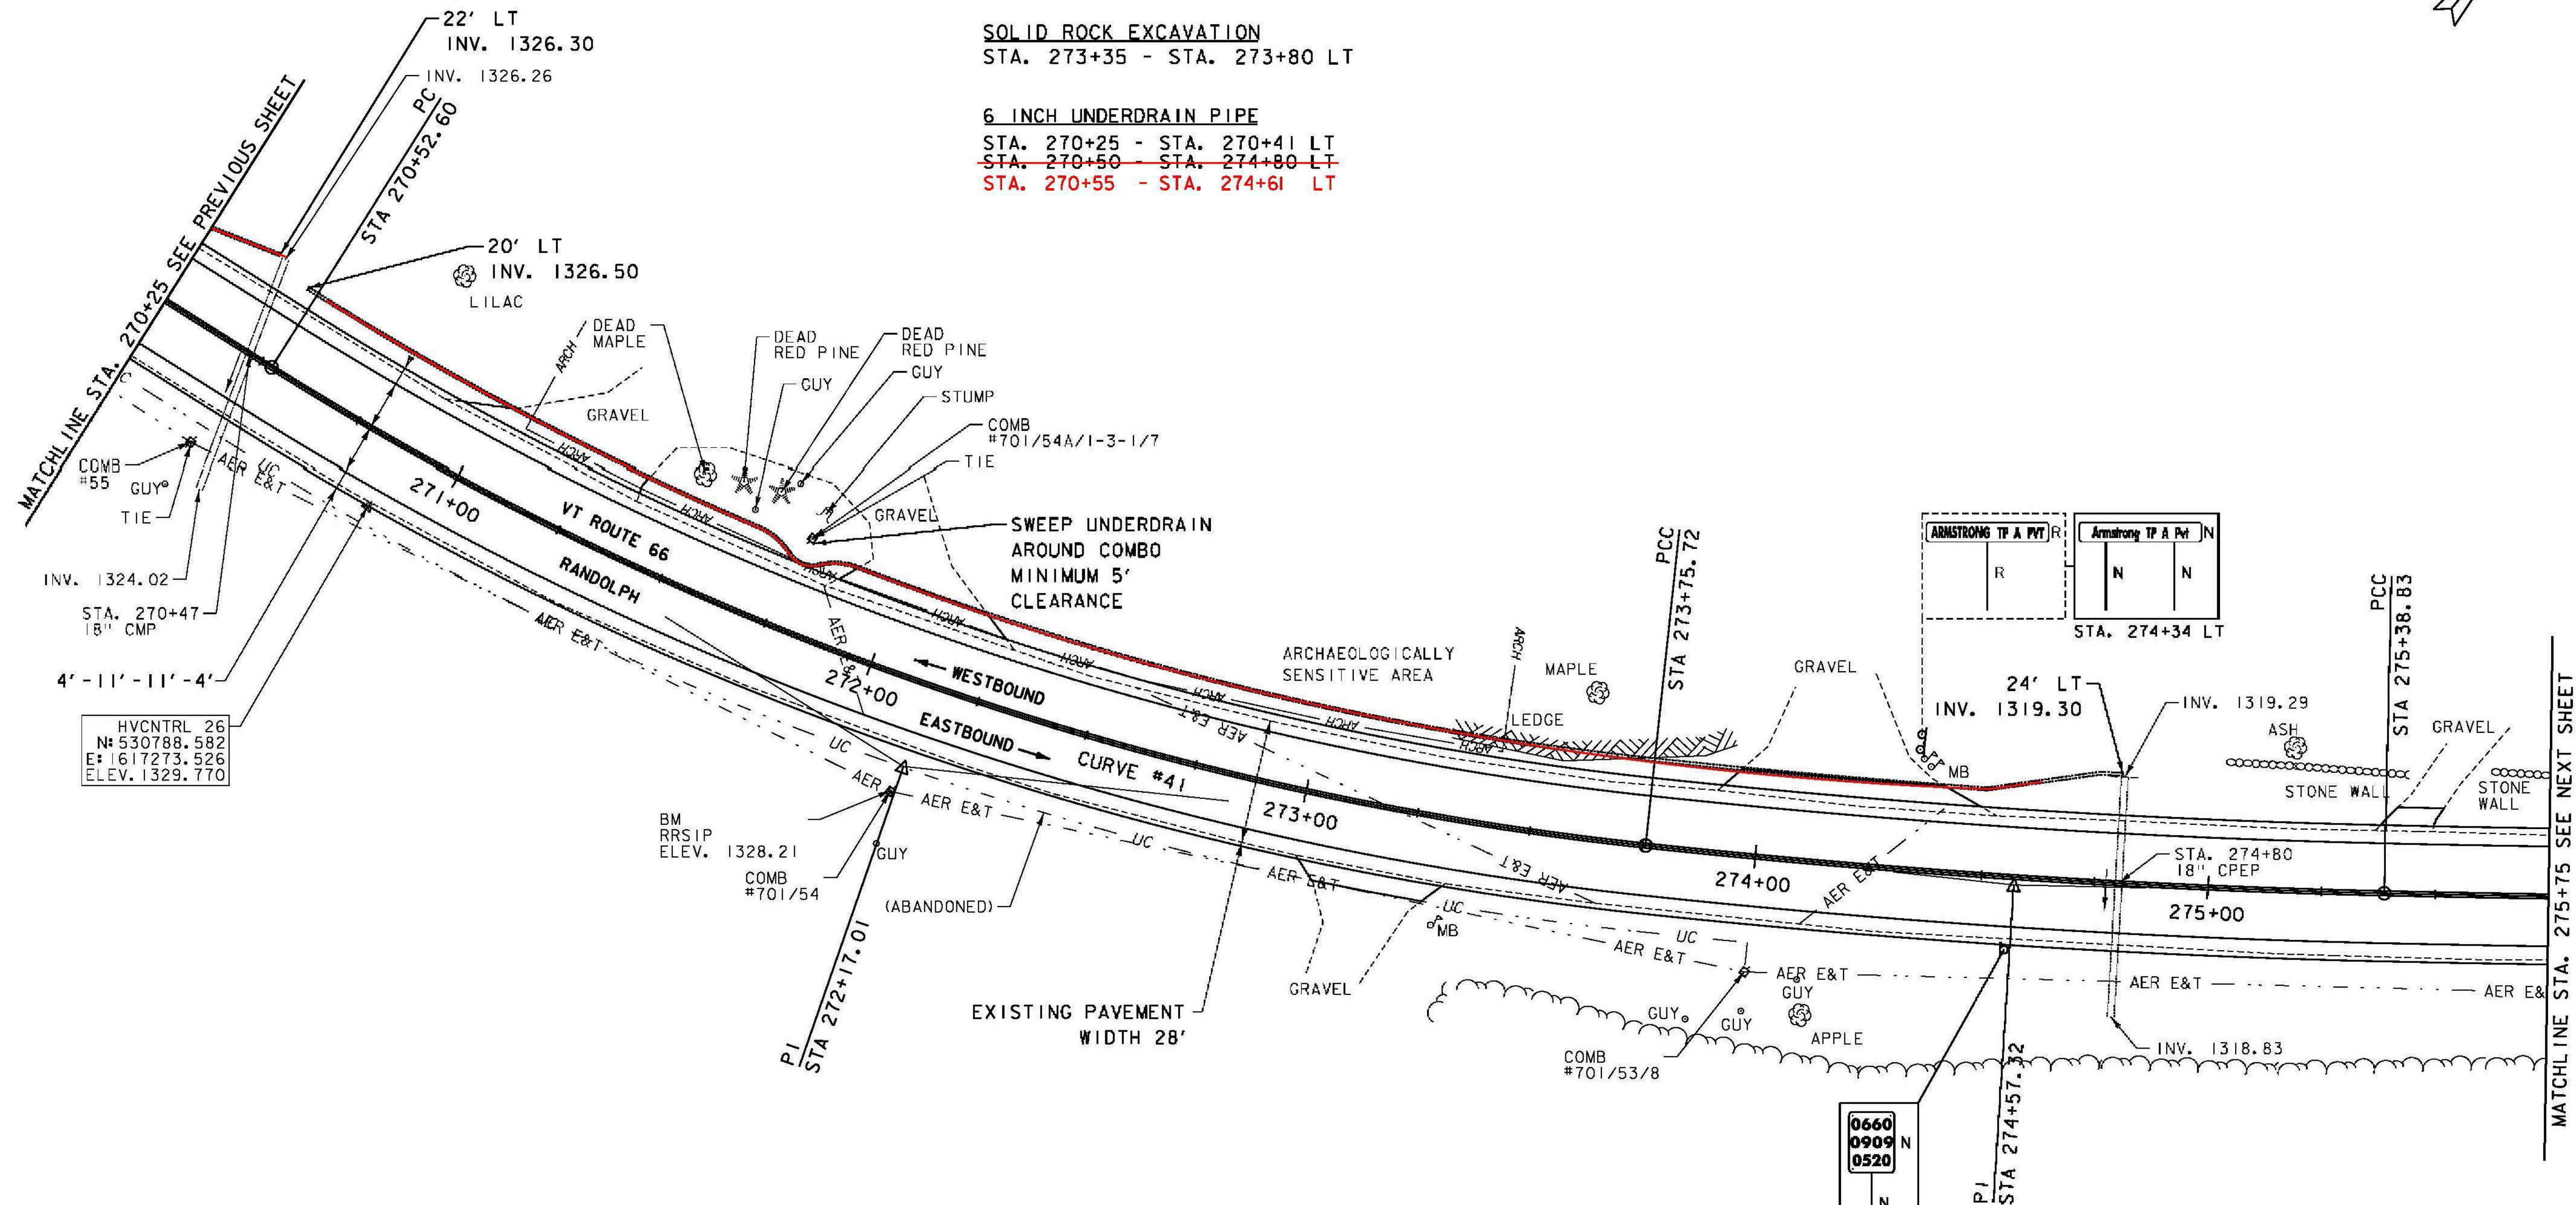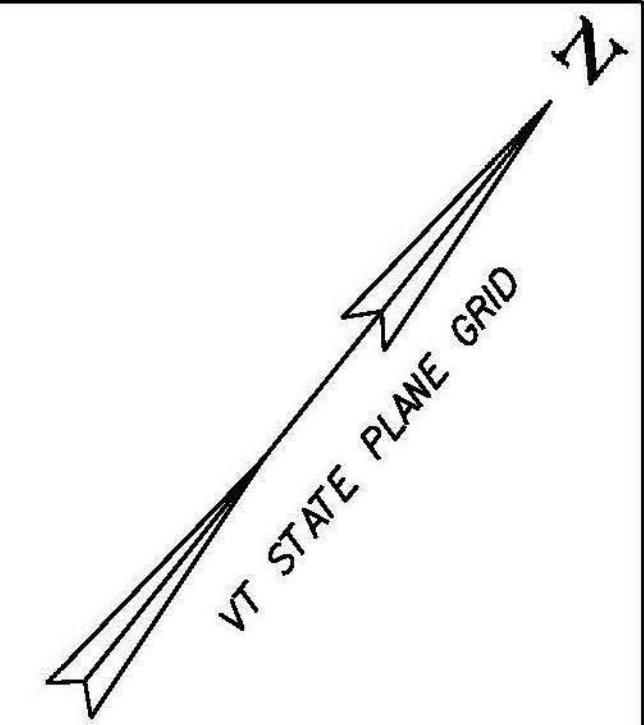


HVCNTRL 26
 N: 530788.582
 E: 1617273.526
 ELEV. 1329.770

CURVE #41
 DELTA = 32° 26' 38"
 D = 8° 04' 11" (1) D = 2° 56' 18" (2) D = 1° 08' 45" (3)
 R = 710.00' (1) R = 1950.00' (2) R = 5000.00' (3)
 T = 222.98' (1) T = 414.13' (2)
 L = 323.12' (1) L = 163.11' (2) L = 137.51' (3)
 E = 34.19'
 BANKING 0.080 FT/FT, 0.052 FT/FT, 0.024 FT/FT
 DESIGN SPEED 45/50/50 MPH
 SEE SUPERELEVATION DIAGRAMS
 FOR MORE INFORMATION

SIGN LEGEND

- R = REMOVE
- R&S = REMOVE AND SALVAGE
- RET = RETAIN
- S = SALVAGE
- N = NEW
- B-B = BACK TO BACK
- = EXISTING
- = NEW

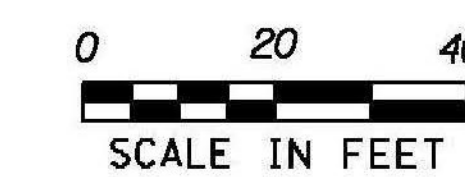

PROJECT NAME: RANDOLPH
 PROJECT NUMBER: STP 2932 (1)

FILE NAME: z10c270.dgn
 PROJECT LEADER: C. LATHROP
 DESIGNED BY: B. BRESLEND
 PROJECT LAYOUT SHEET 45

PLOT DATE: 6/5/2014
 DRAWN BY: B. BRESLEND
 CHECKED BY: C. LATHROP
 SHEET 76 OF 276