

DURABLE 4 INCH WHITE LINE (SEE OPTION ITEMS)
STA. 346+75 - STA. 352+75 (SOLID LT & RT)

TEMPORARY 4 INCH WHITE LINE, PAINT
STA. 346+75 - STA. 352+75 (SOLID LT & RT)

MILLED RUMBLE STRIPS
STA. 346+75 - STA. 352+75 CTR

DURABLE 4 INCH YELLOW LINE, POLYUREA
STA. 346+75 - STA. 352+75 (SOLID LT & RT)

TEMPORARY 4 INCH YELLOW LINE, PAINT
STA. 346+75 - STA. 352+75 (SOLID LT & RT)


REMOVING SIGNS
AS SHOWN - 2

REMOVAL AND DISPOSAL OF GUARDRAIL
STA. 346+75 - STA. 347+13 LT
STA. 346+75 - STA. 346+85 RT

S.P. BARRIER FOR TEMPORARY TRAFFIC PROTECTION
~~STEEL BEAM GUARDRAIL, GALVANIZED~~
STA. 346+75 - STA. 347+15 LT CONTRACTOR/VTRANS
STA. 346+75 - STA. 346+85 RT AGREEMENT

6 INCH UNDERDRAIN PIPE
346+85 STA. 347+00 - STA. 348+95 RT
STA. 349+25 - STA. 352+75 RT

ANCHOR FOR STEEL BEAM RAIL
STA. 346+85 RT 346+80
STA. 347+15 LT 347+10

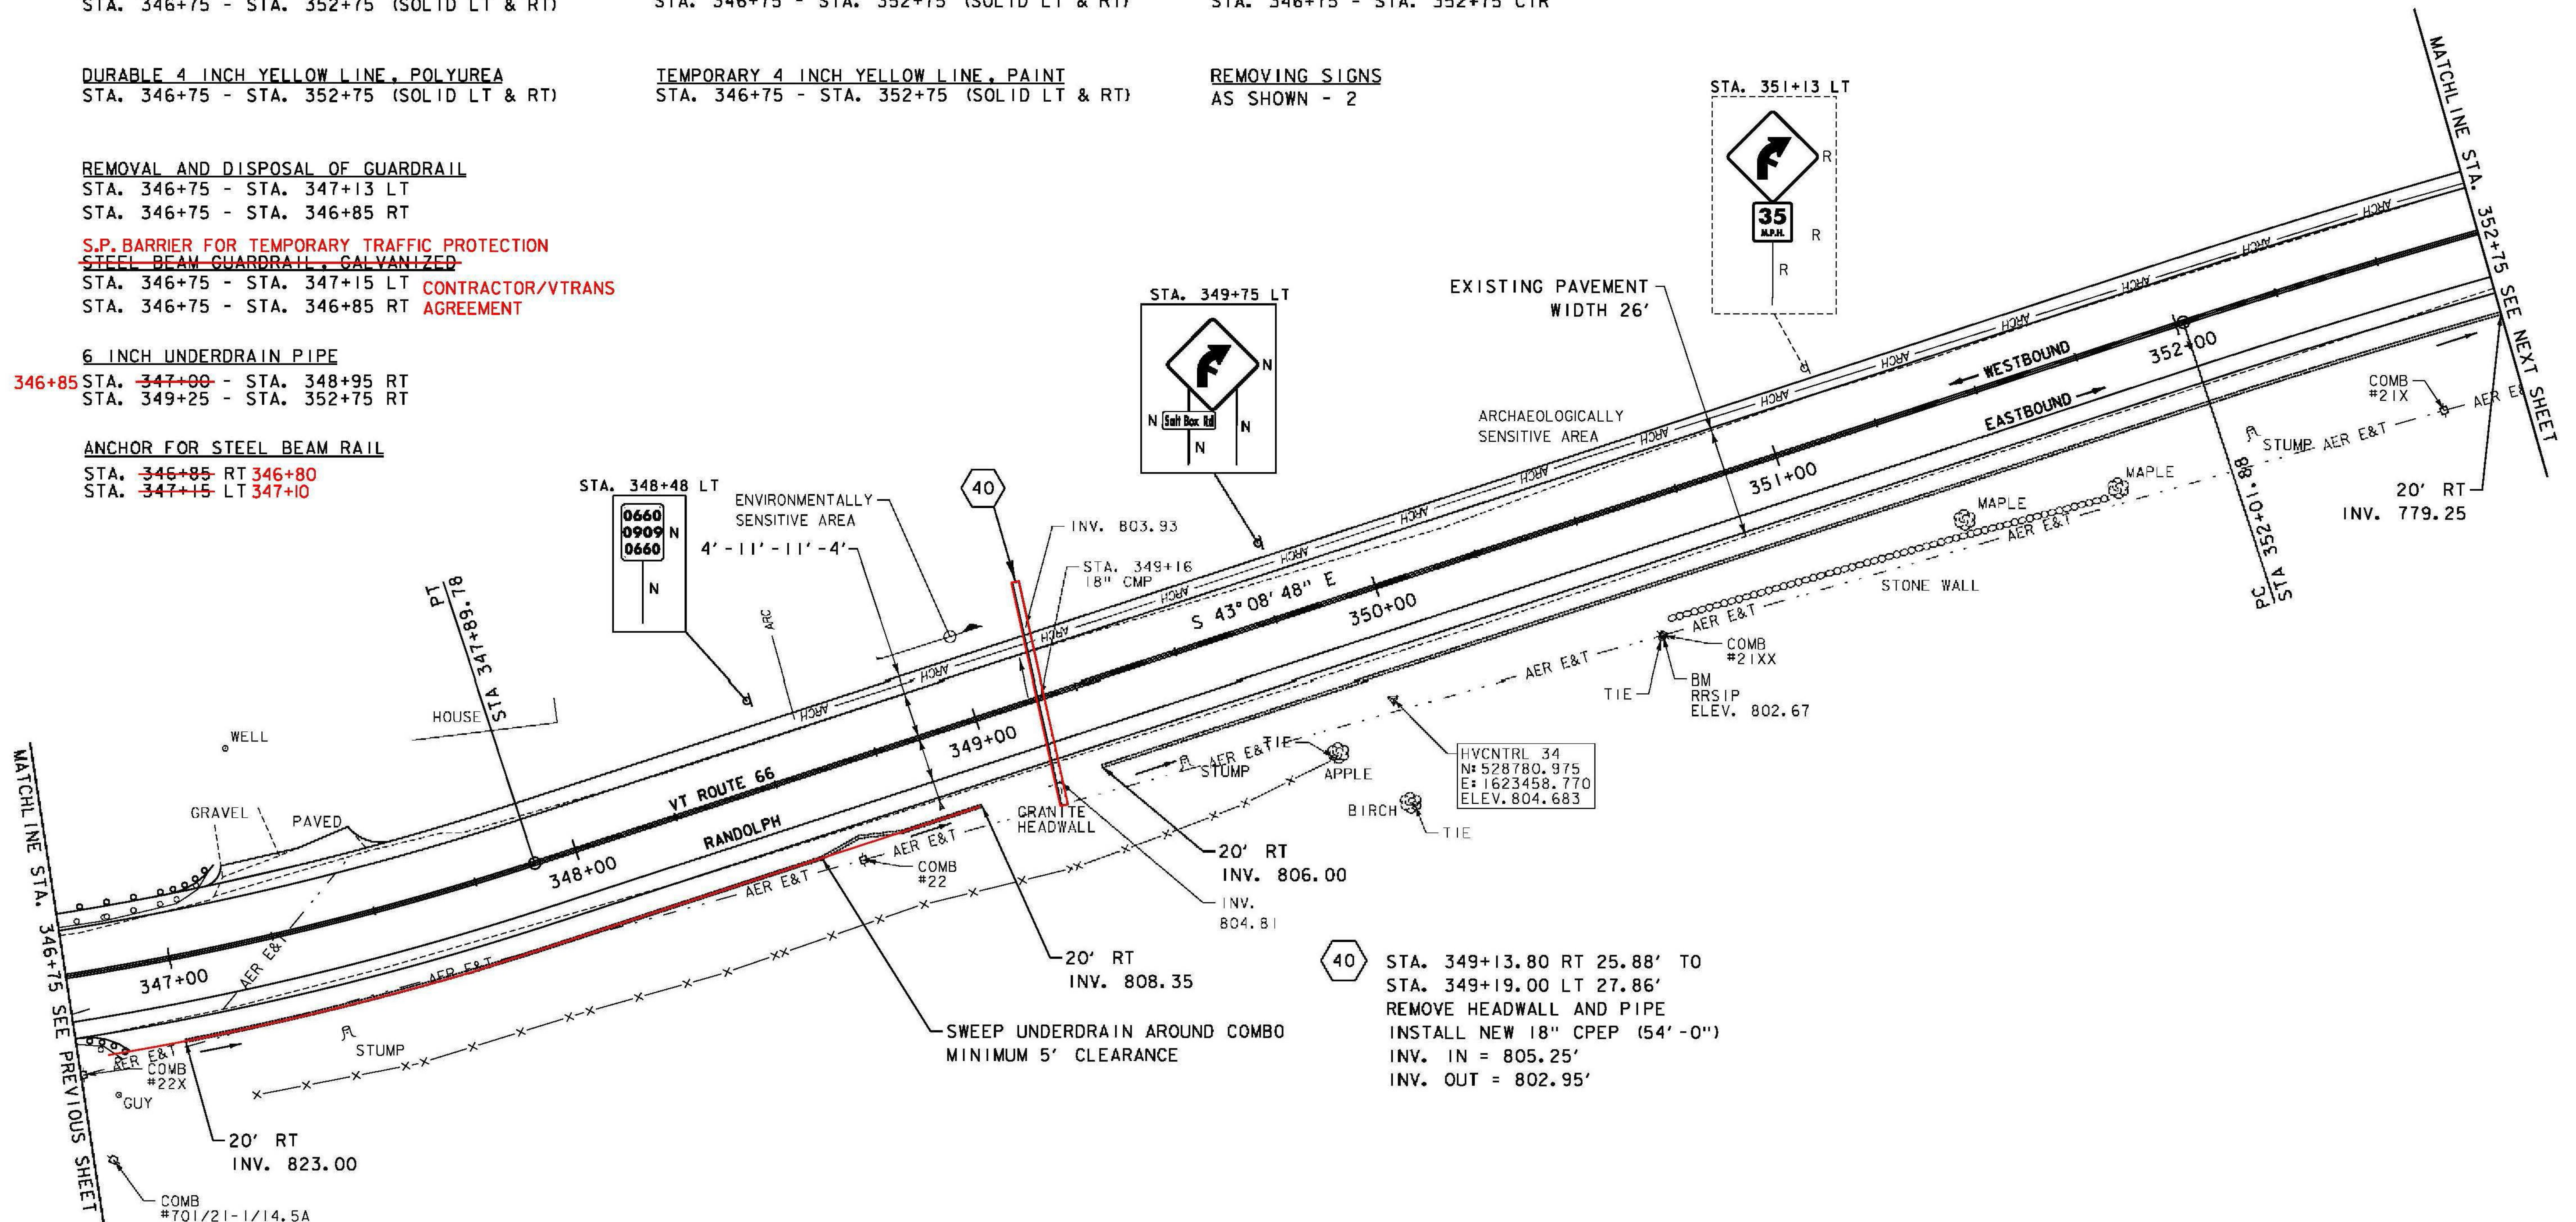

ENVIRONMENTALLY SENSITIVE LOCATIONS:

NO.	LIMITS	POS.	TYPE
11.	STA. 348+80 - STA. 349+07	LT	-

- SIGN LEGEND**
- R = REMOVE
 - R&S = REMOVE AND SALVAGE
 - RET = RETAIN
 - S = SALVAGE
 - N = NEW
 - B-B = BACK TO BACK
 - = EXISTING
 - = NEW



PROJECT NAME: RANDOLPH	PLOT DATE: 6/5/2014
PROJECT NUMBER: STP 2932 (1)	DRAWN BY: B. BRESLEND
FILE NAME: z10c270.dgn	CHECKED BY: C. LATHROP
PROJECT LEADER: C. LATHROP	PROJECT LAYOUT SHEET 59
DESIGNED BY: B. BRESLEND	SHEET 90 OF 276

