

DURABLE 4 INCH WHITE LINE (SEE OPTION ITEMS)  
STA. 381+50 - STA. 387+25 (SOLID LT & RT)

TEMPORARY 4 INCH WHITE LINE, PAINT  
STA. 381+50 - STA. 387+25 (SOLID LT & RT)

STONE FILL, TYPE I  
STA. 382+45 - STA. 385+50 LT

DURABLE 4 INCH YELLOW LINE, POLYUREA  
STA. 381+50 - STA. 387+25 (SOLID LT & RT)

TEMPORARY 4 INCH YELLOW LINE, PAINT  
STA. 381+50 - STA. 387+25 (SOLID LT & RT)






GEOTEXTILE FOR SILT FENCE  
STA. 382+45 - STA. 385+50 LT

6 INCH UNDERDRAIN PIPE  
STA. 381+50 - STA. 387+25 RT

REMOVING SIGNS  
AS SHOWN - 4

GRUBBING MATERIAL (6")  
STA. 382+45 - STA. 385+50 LT

RELOCATE MAILBOX, SINGLE SUPPORT  
STA. 382+42 LT

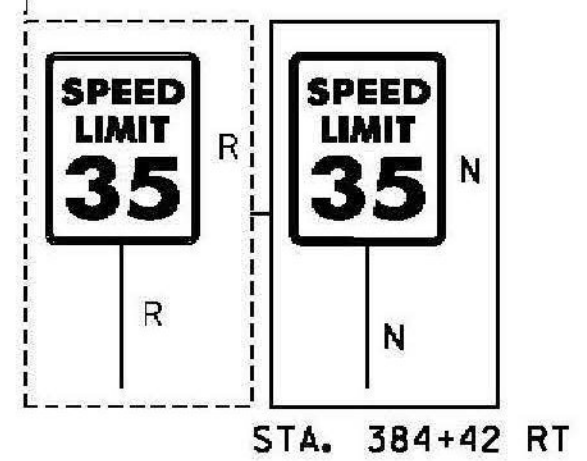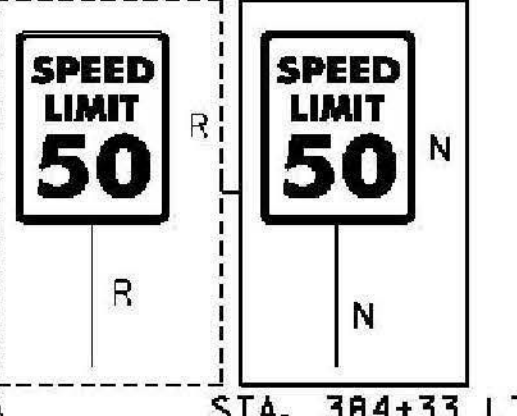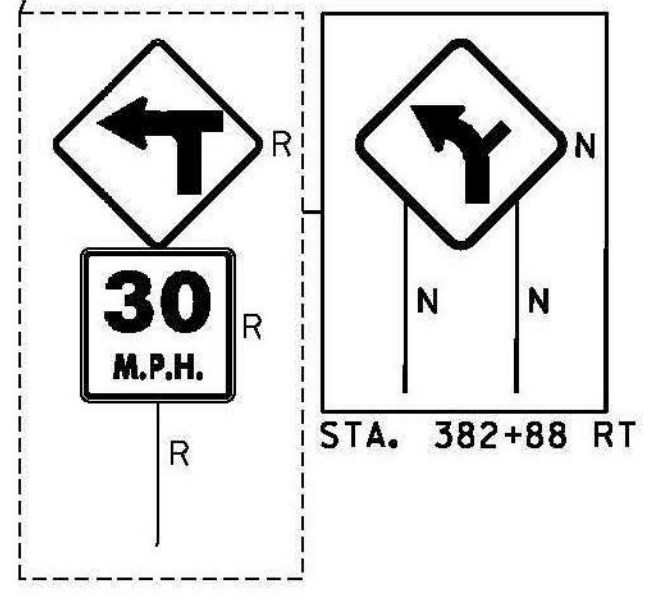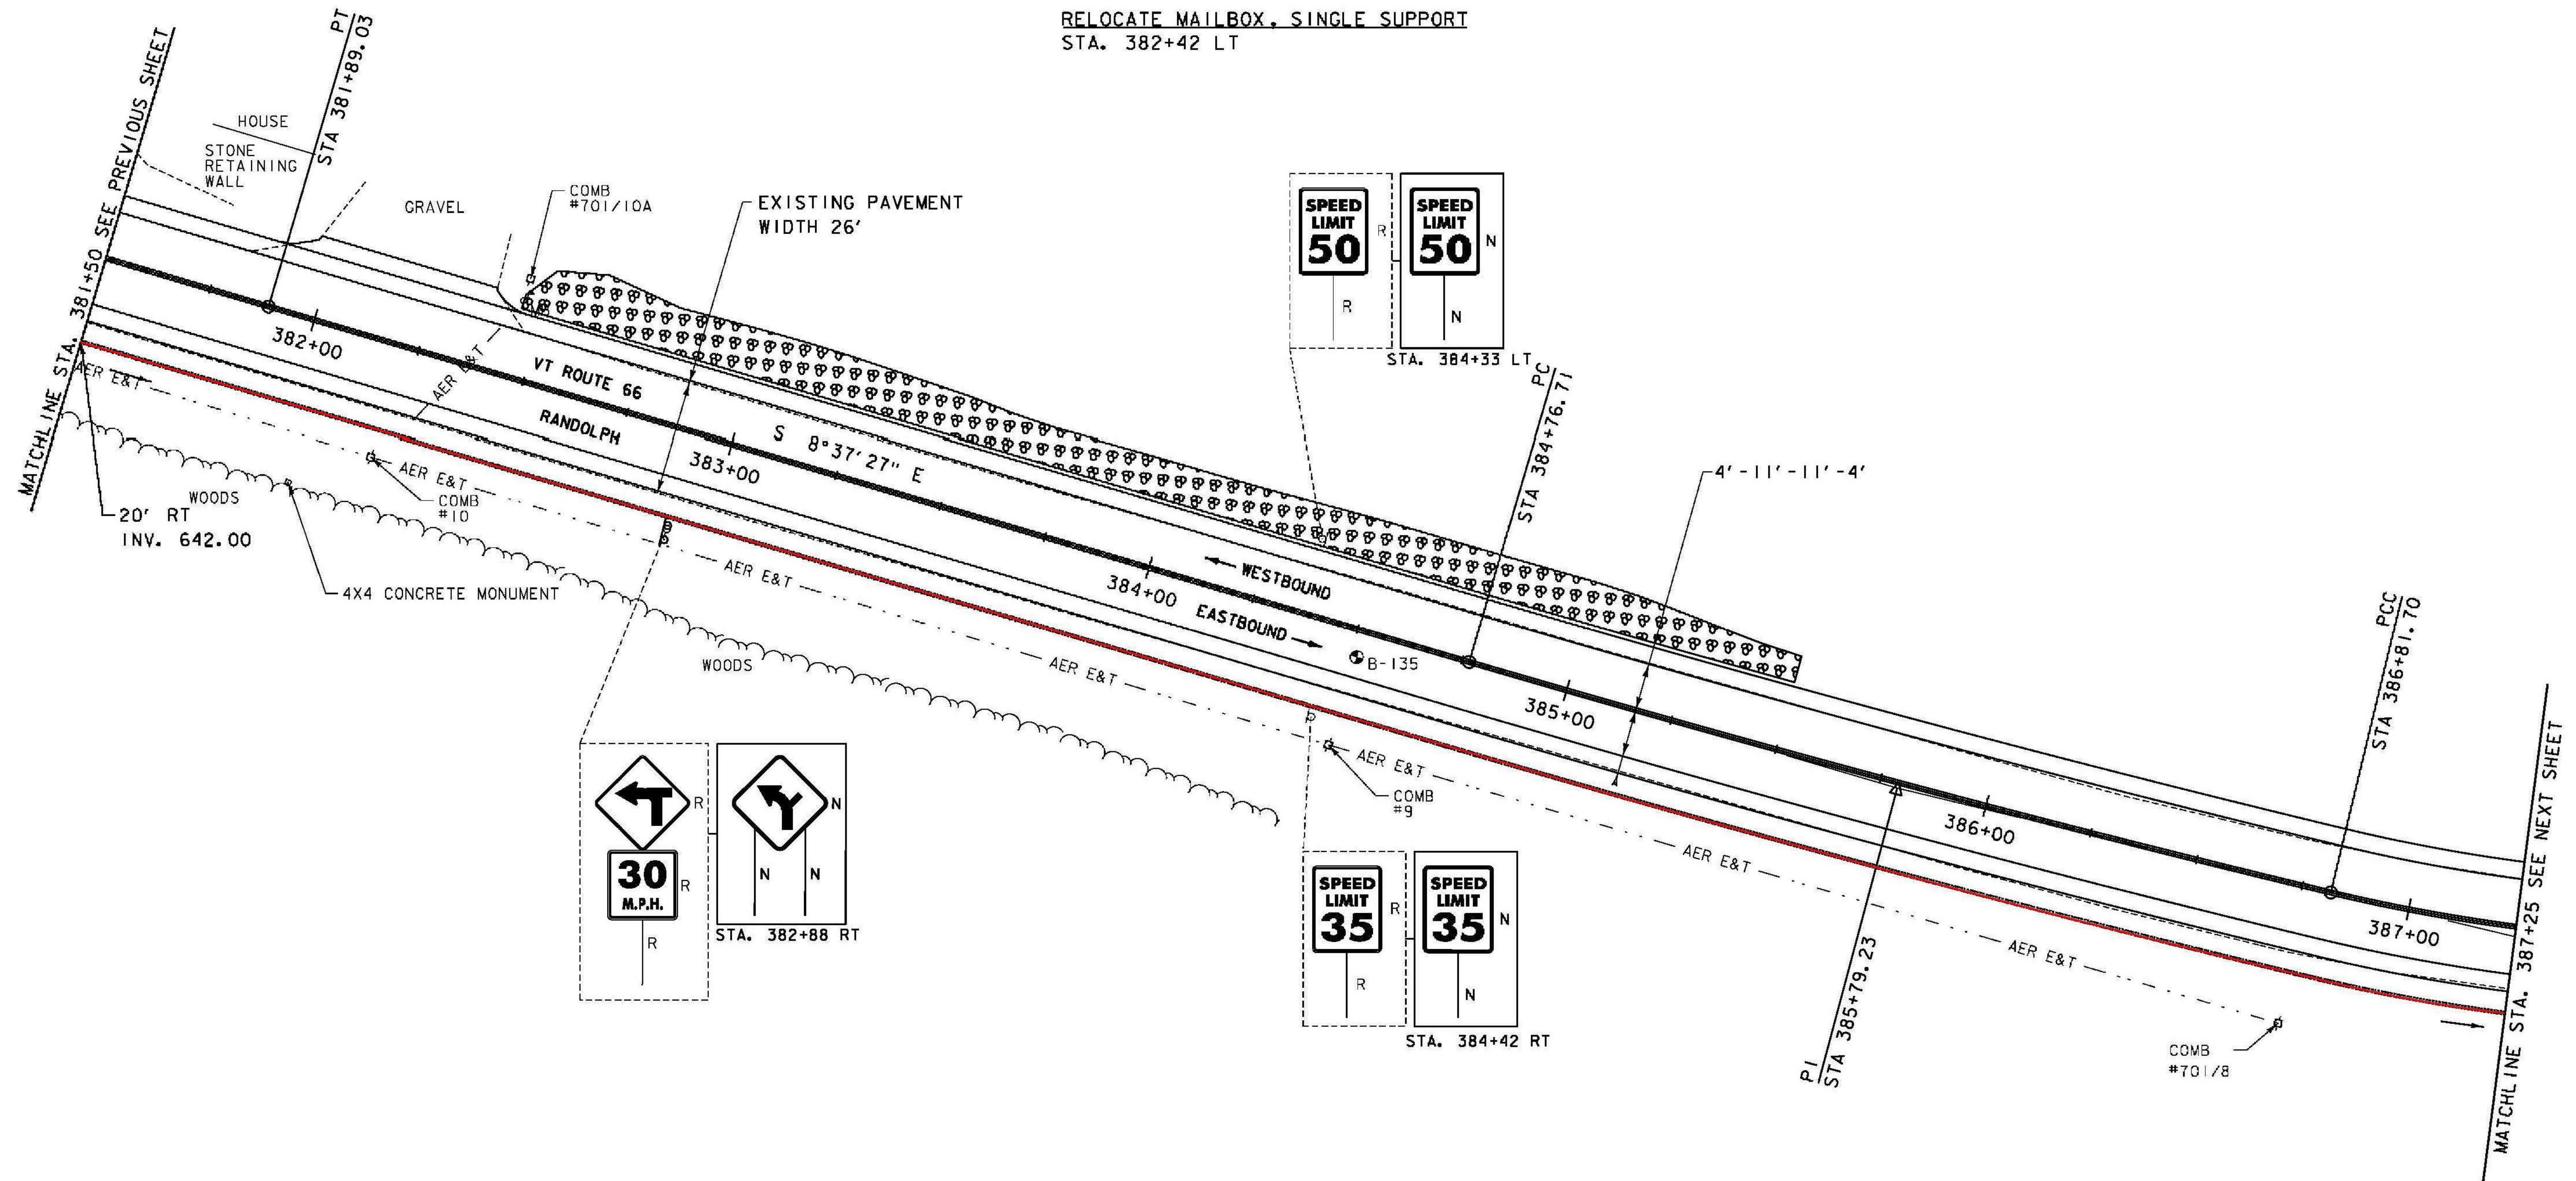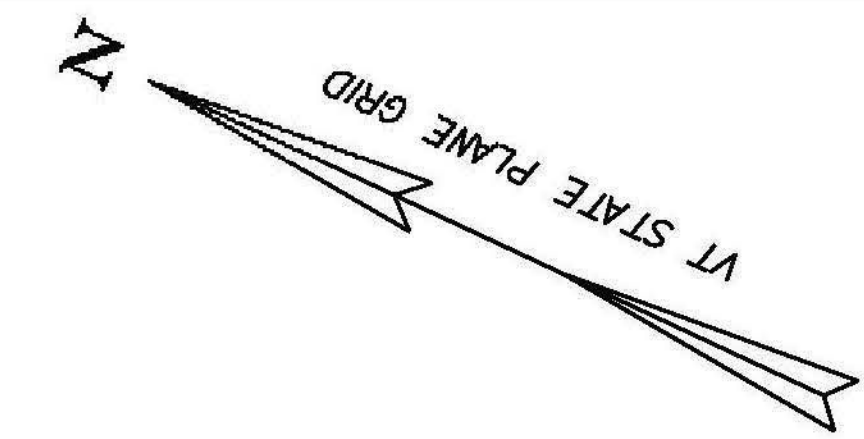

**SIGN LEGEND**

- R = REMOVE
- R&S = REMOVE AND SALVAGE
- RET = RETAIN
- S = SALVAGE
- N = NEW
- B-B = BACK TO BACK
- = EXISTING
- = NEW



PROJECT NAME: RANDOLPH  
PROJECT NUMBER: STP 2932 (1)

FILE NAME: z10c270.dgn  
PROJECT LEADER: C. LATHROP  
DESIGNED BY: B. BRESLEND  
PROJECT LAYOUT SHEET 65

PLOT DATE: 6/5/2014  
DRAWN BY: B. BRESLEND  
CHECKED BY: C. LATHROP  
SHEET 96 OF 276