




BEGIN PROJECT / MATCH EXISTING
22+60

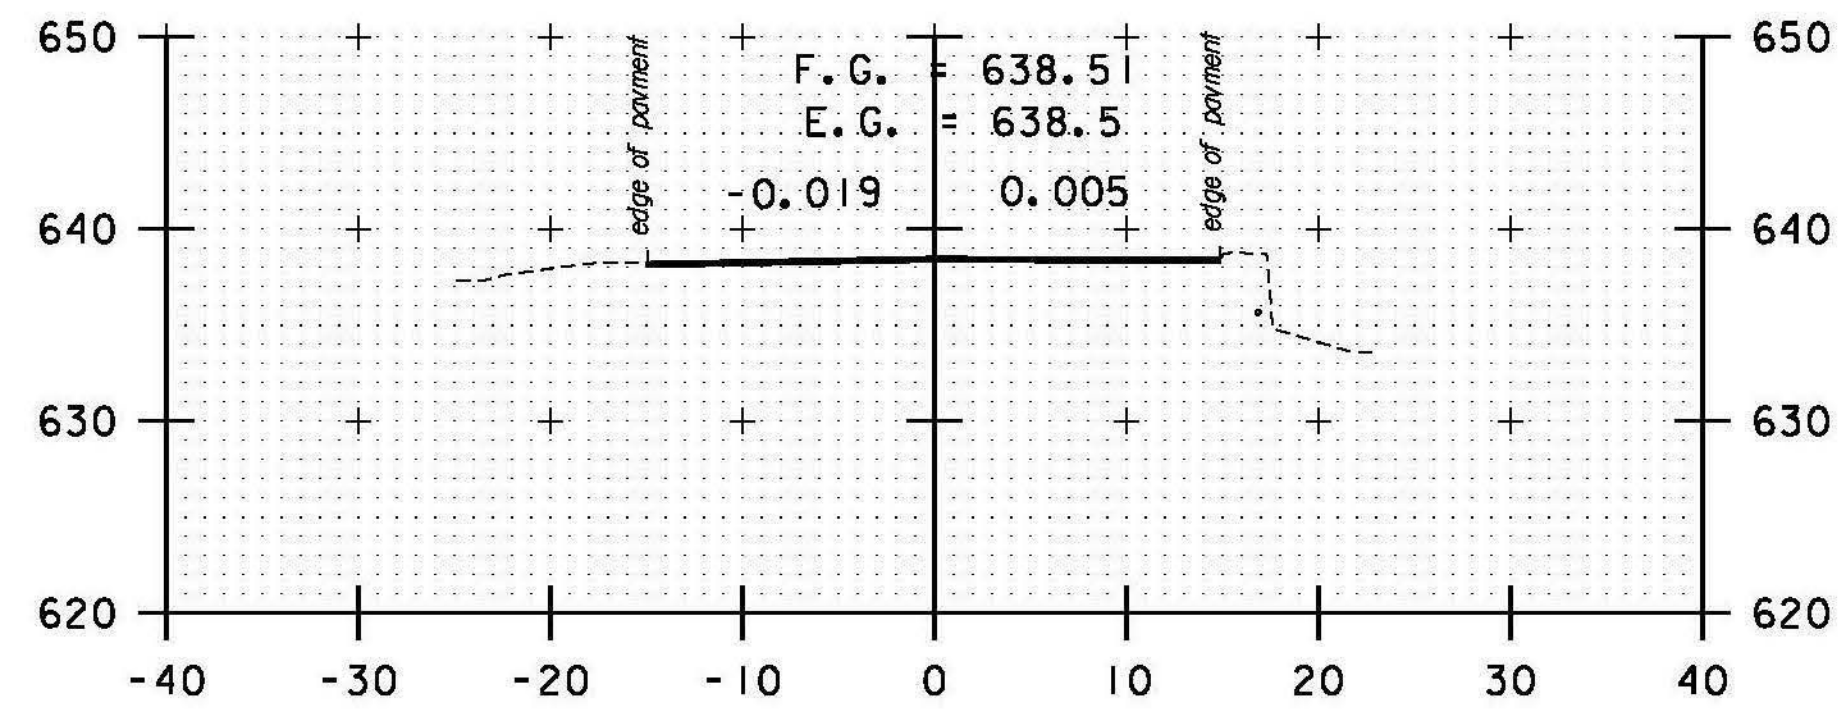


END BRIDGE #1
23+28

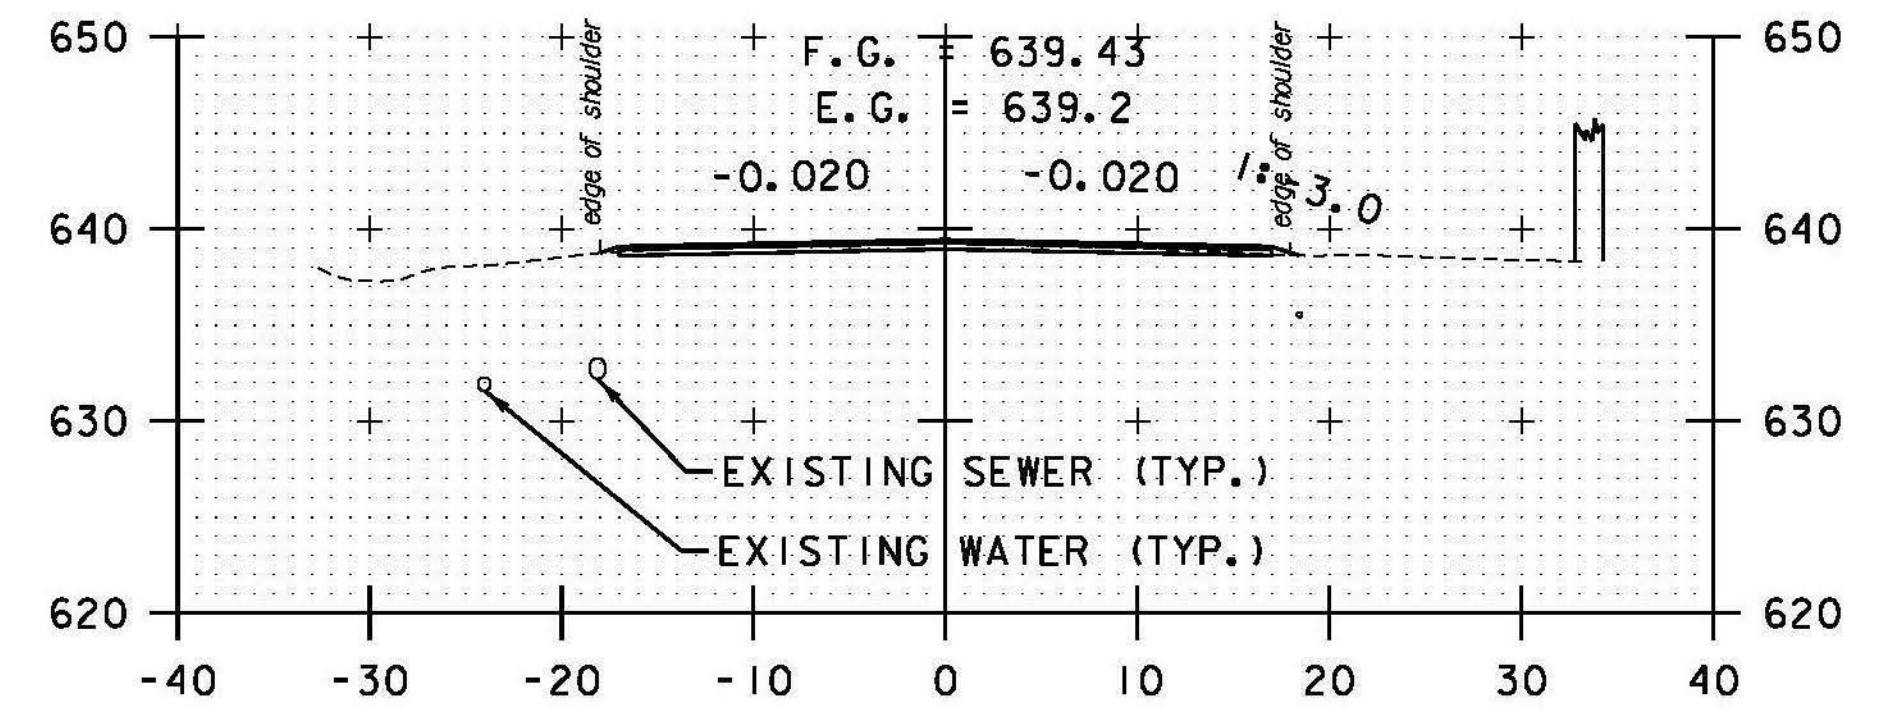


24+50

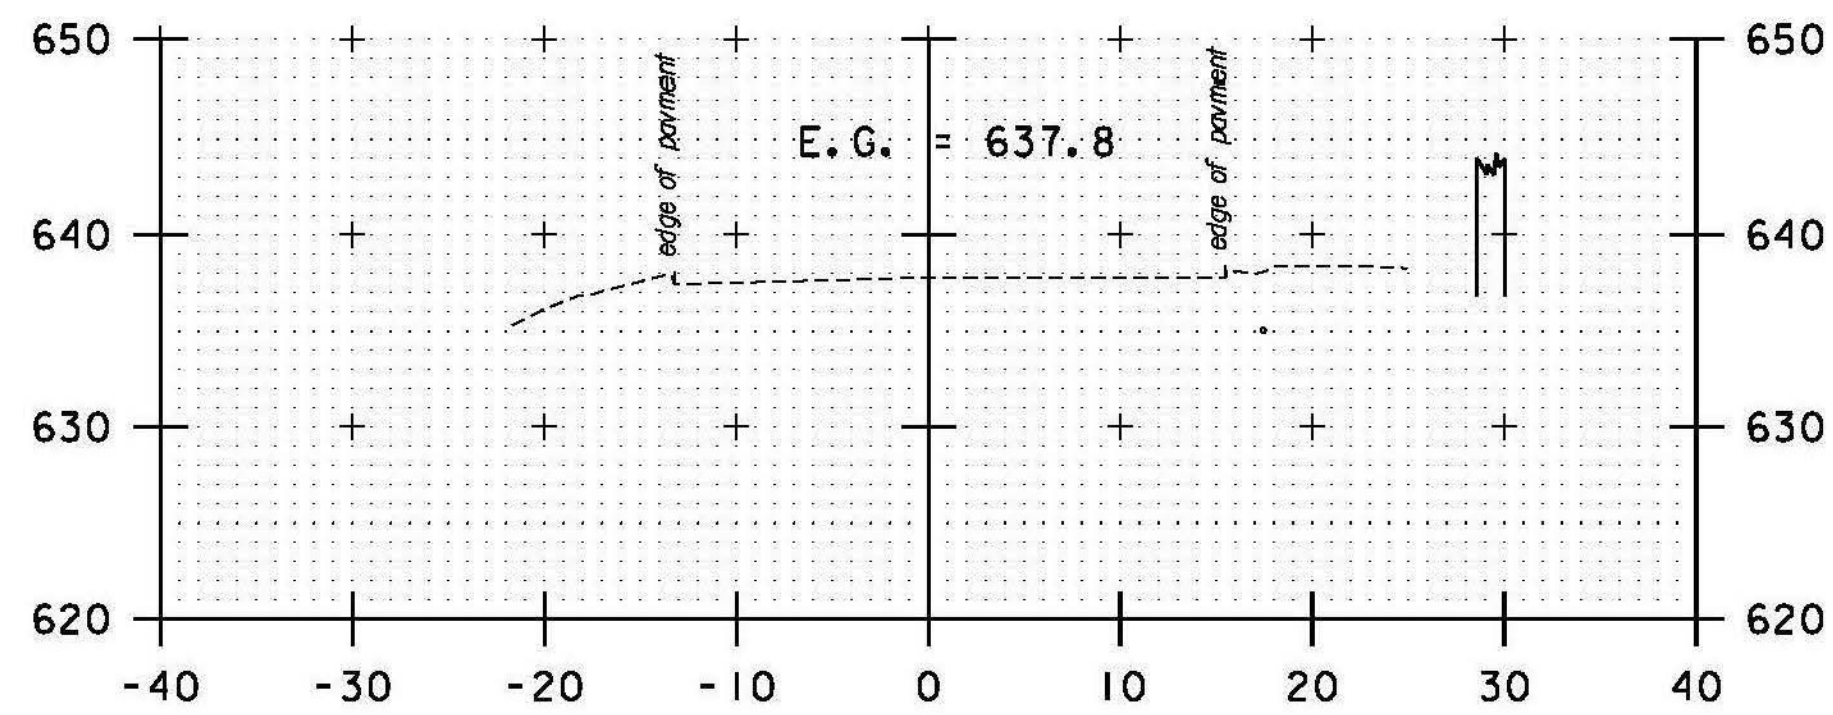


22+50

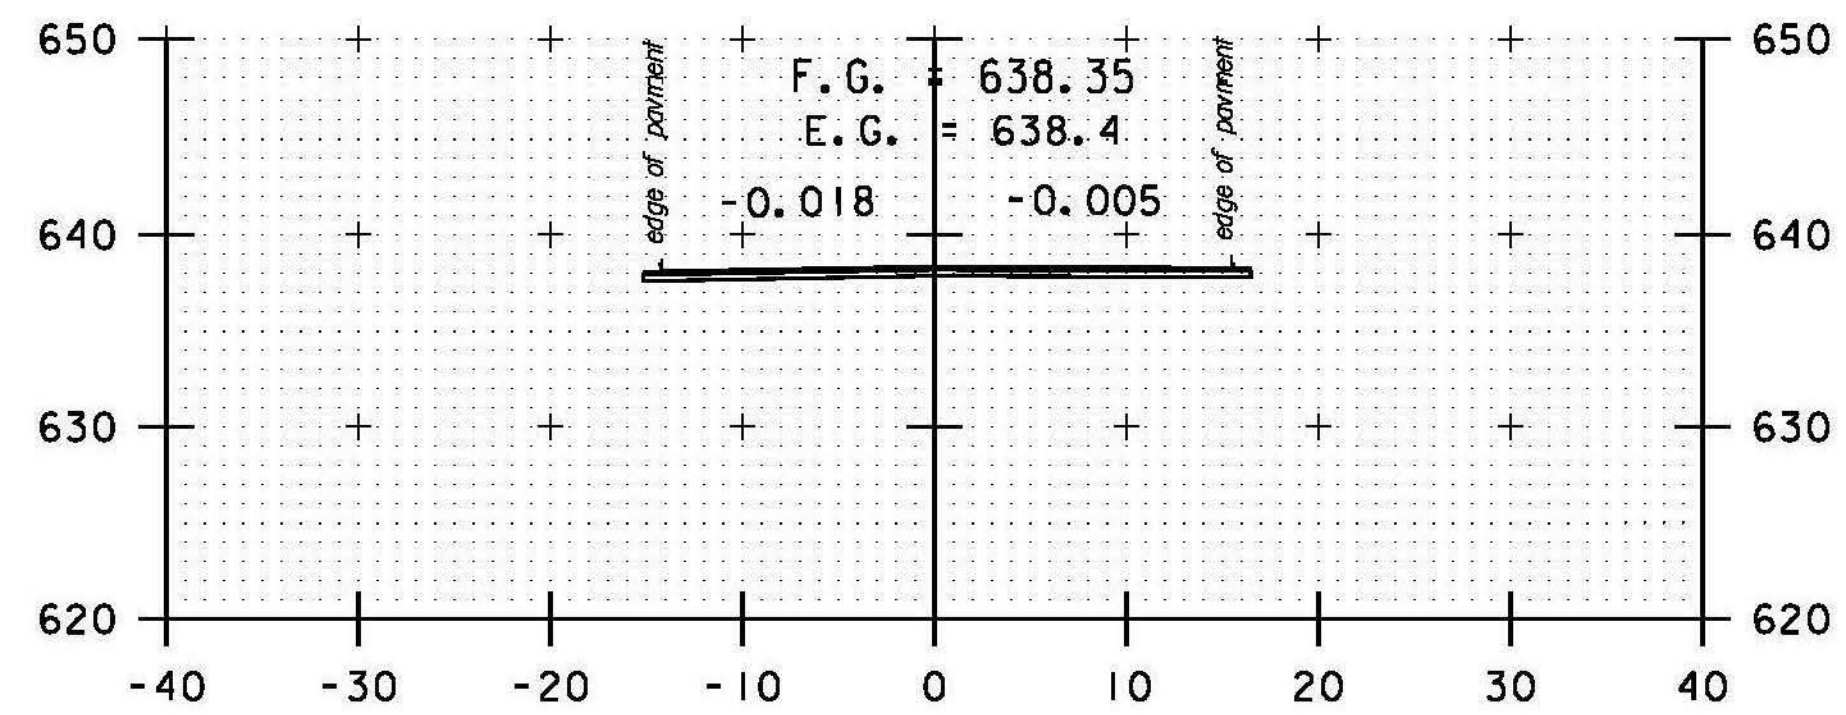


23+00

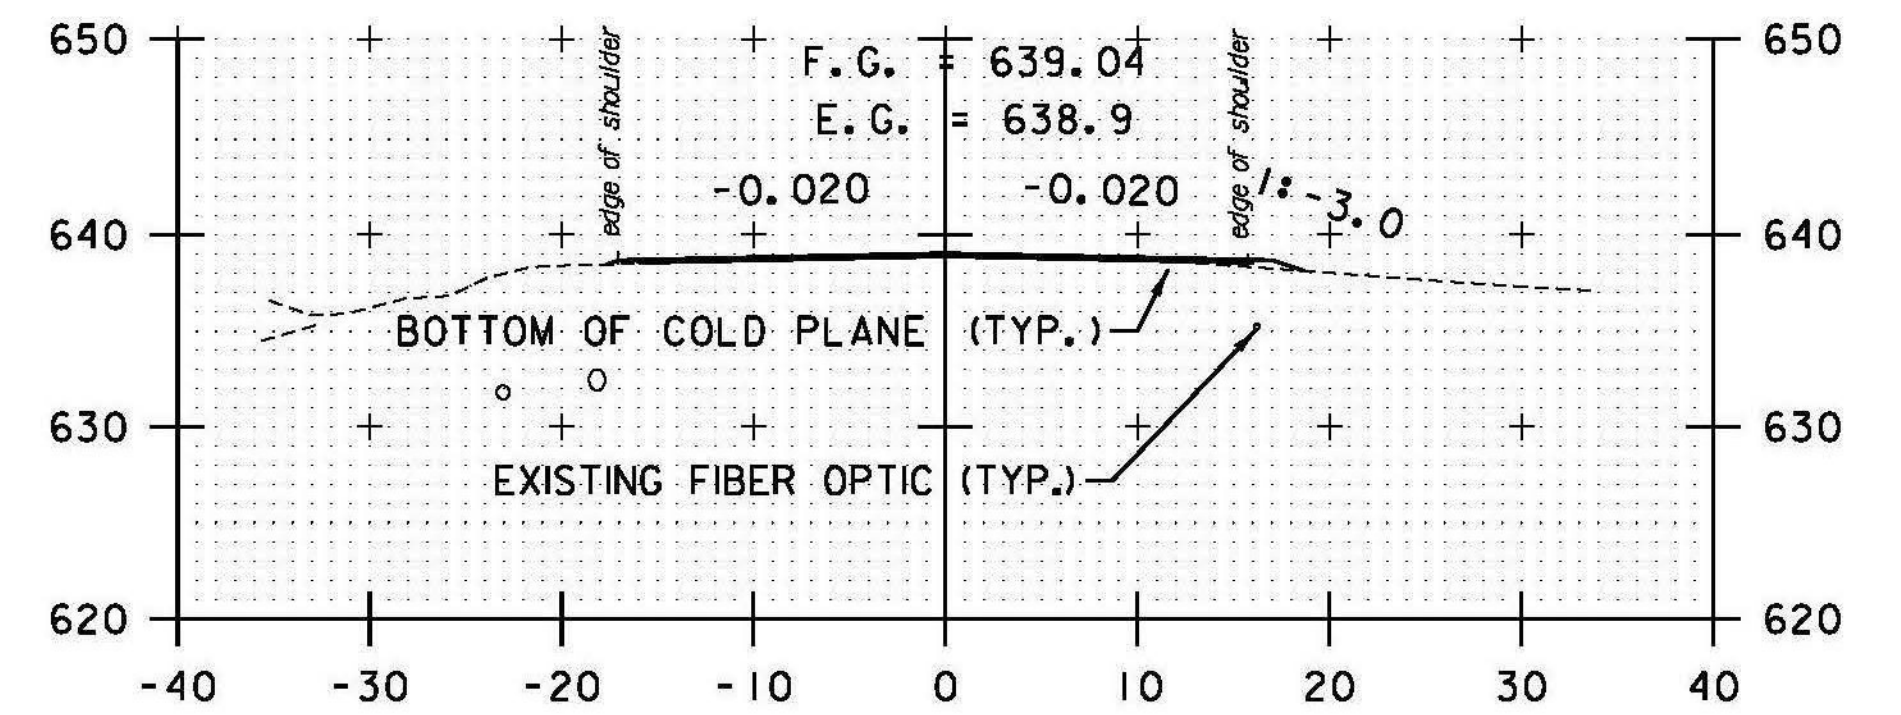


DRIVE RT
24+00

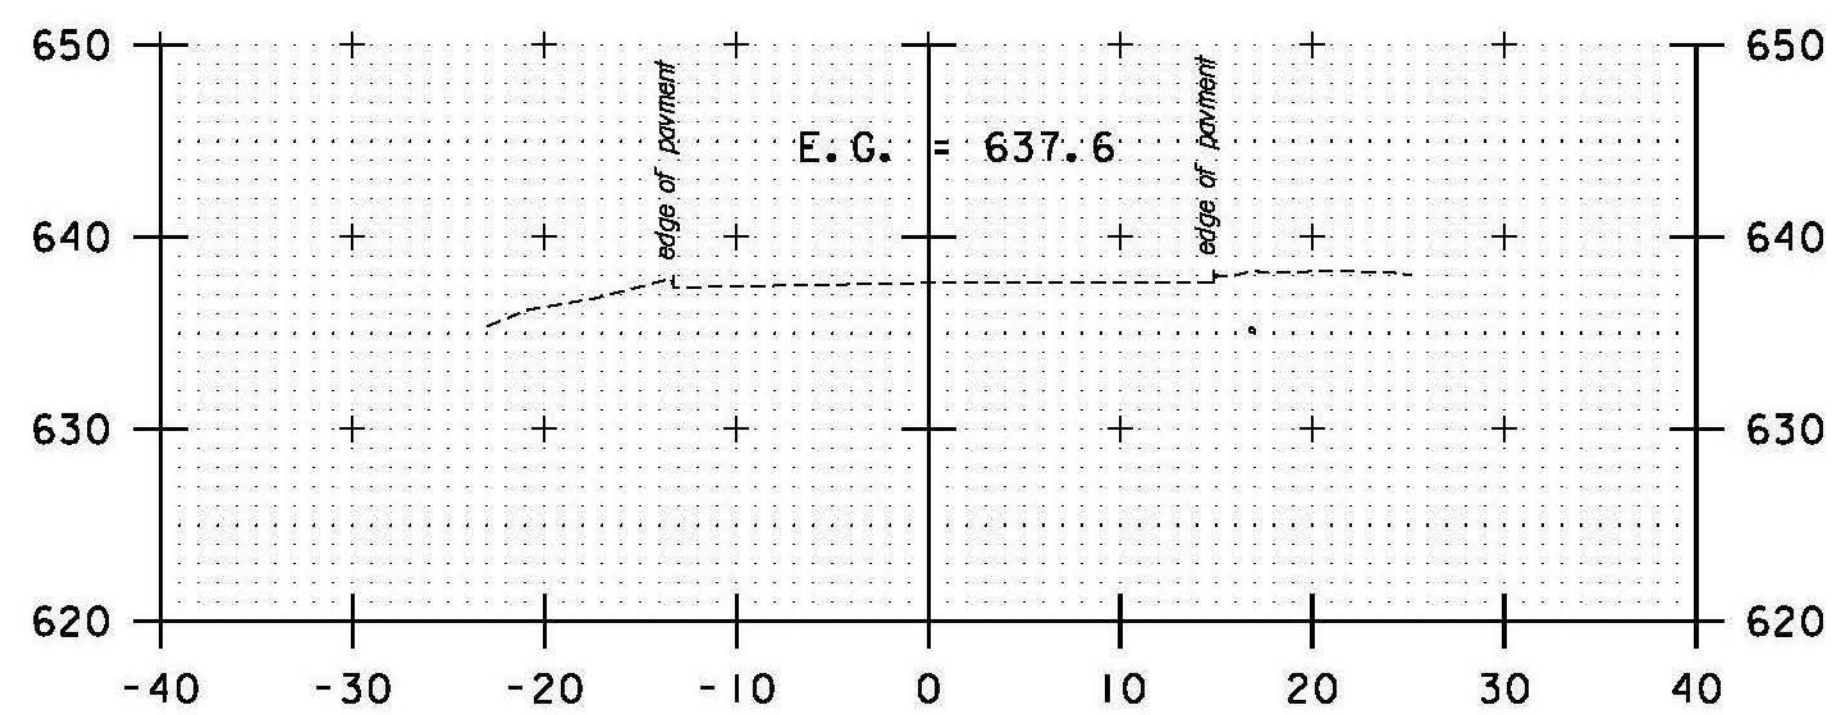

22+36

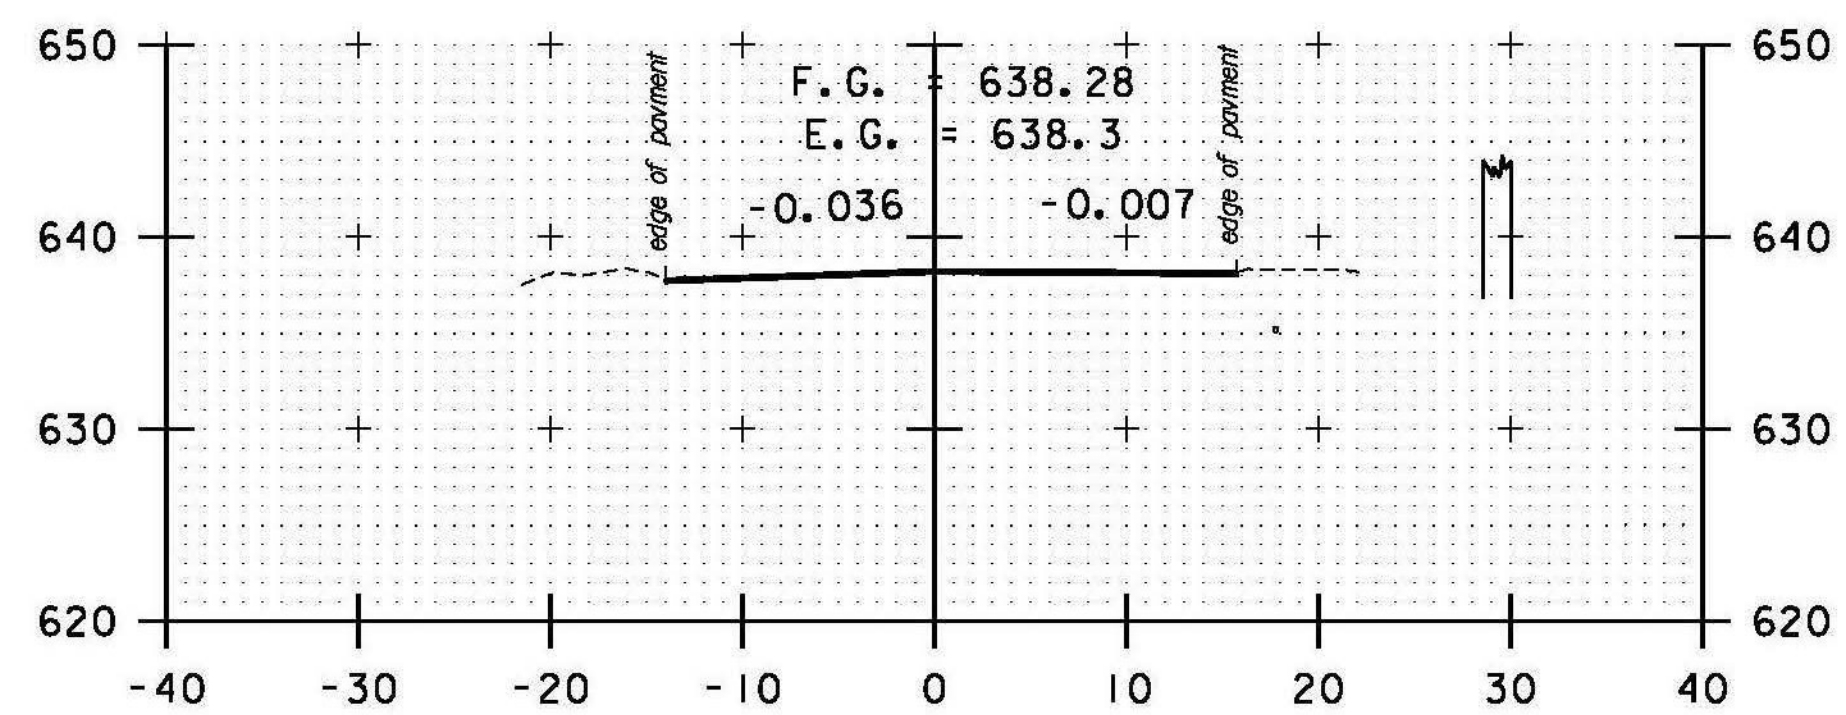


BEGIN BRIDGE #1
22+87

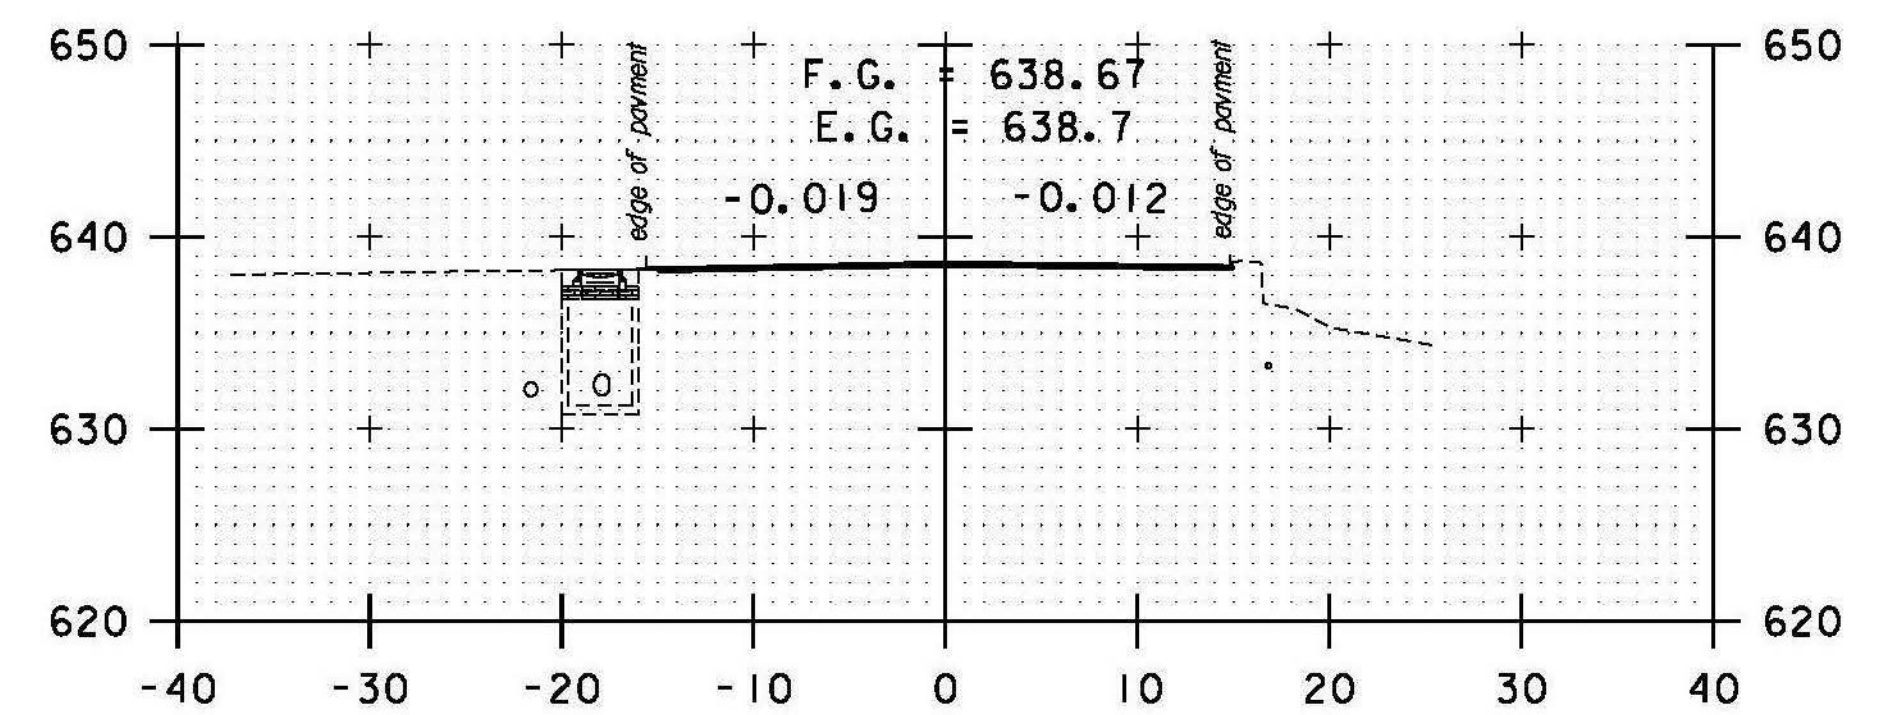

DRIVE LT
23+50

STA. 22+36 TO STA. 24+50

DATUM
VERTICAL NAVD 88
HORIZONTAL NAD 83 (07)

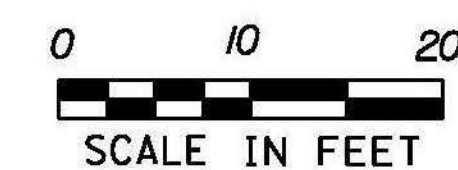

PROJECT NAME: RANDOLPH
PROJECT NUMBER: STP 2932 (1)

FILE NAME: z10c270.dgn
PROJECT LEADER: C. LATHROP
DESIGNED BY: B. BRESLEND
VT 66 CROSS SECTION SHEET 1

PLOT DATE: 6/5/2014
DRAWN BY: B. BRESLEND
CHECKED BY: C. LATHROP
SHEET 157 OF 276