




30+50

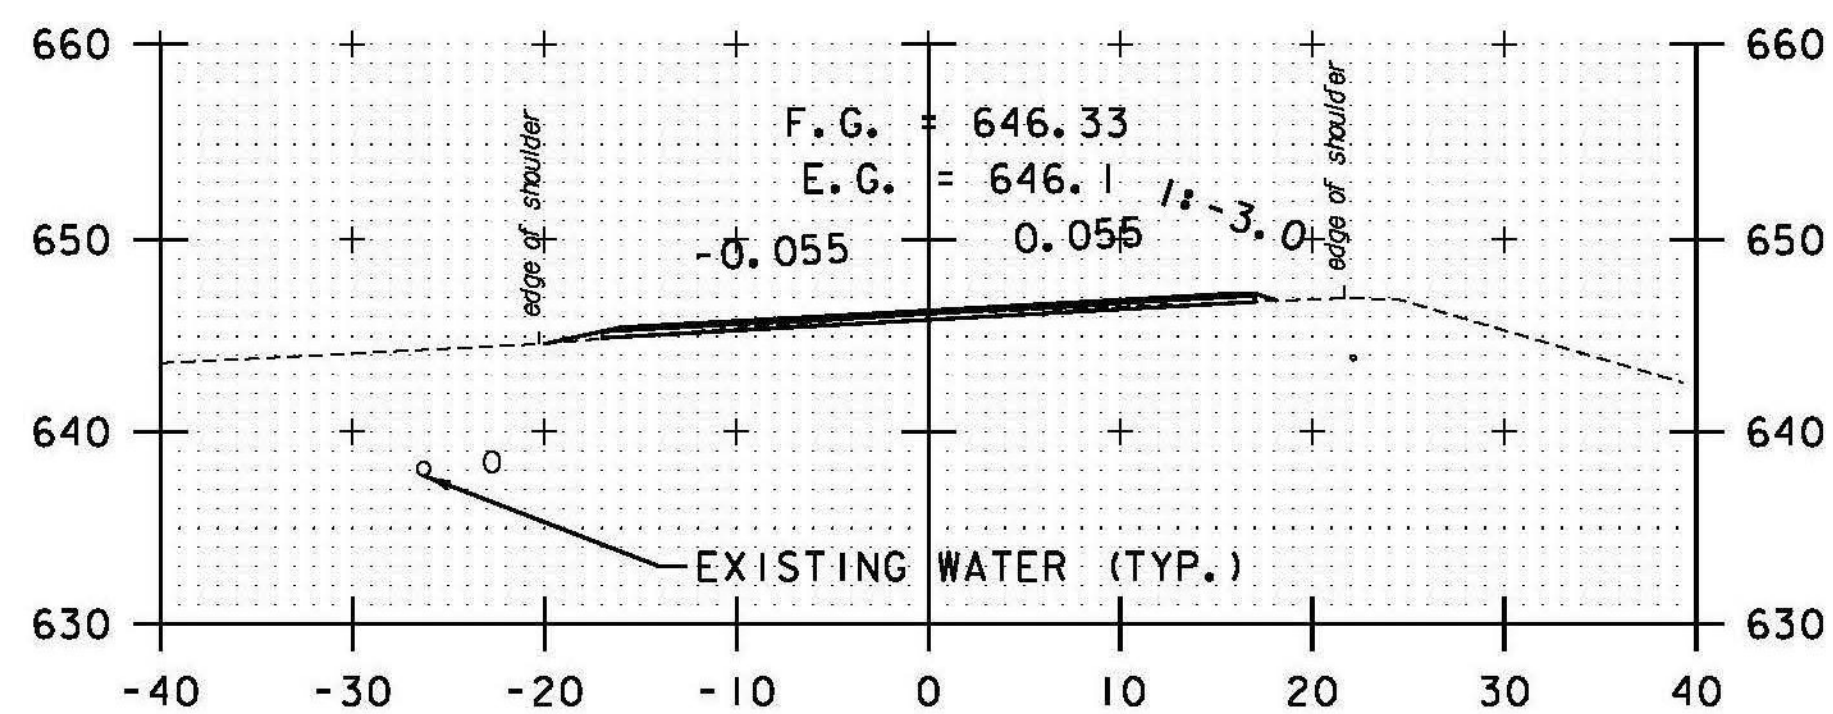


DRIVE LT
30+00

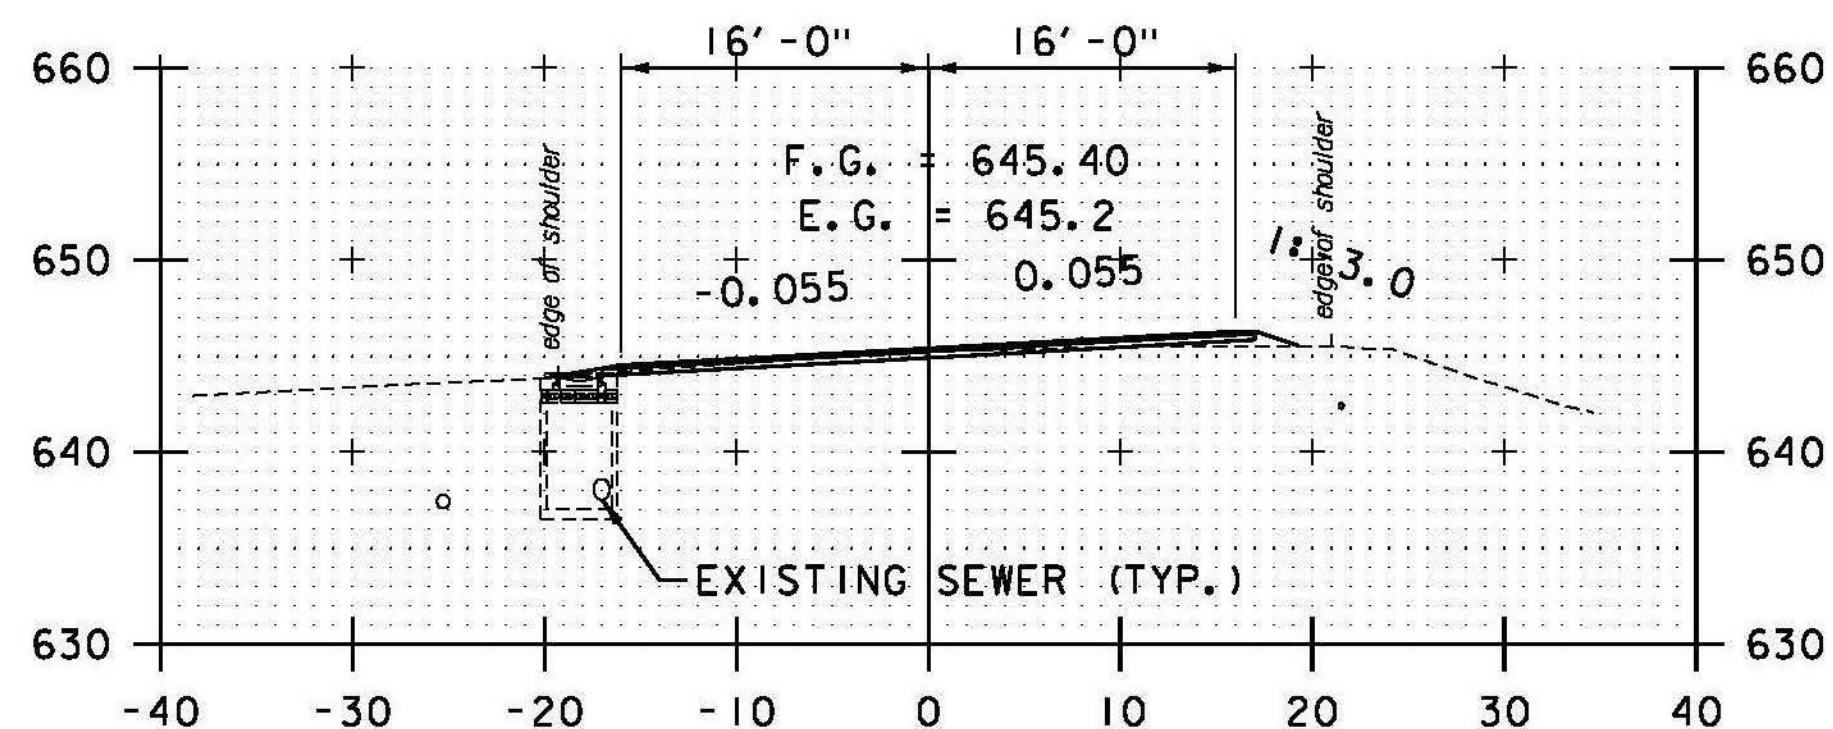


DRIVE LT
29+50

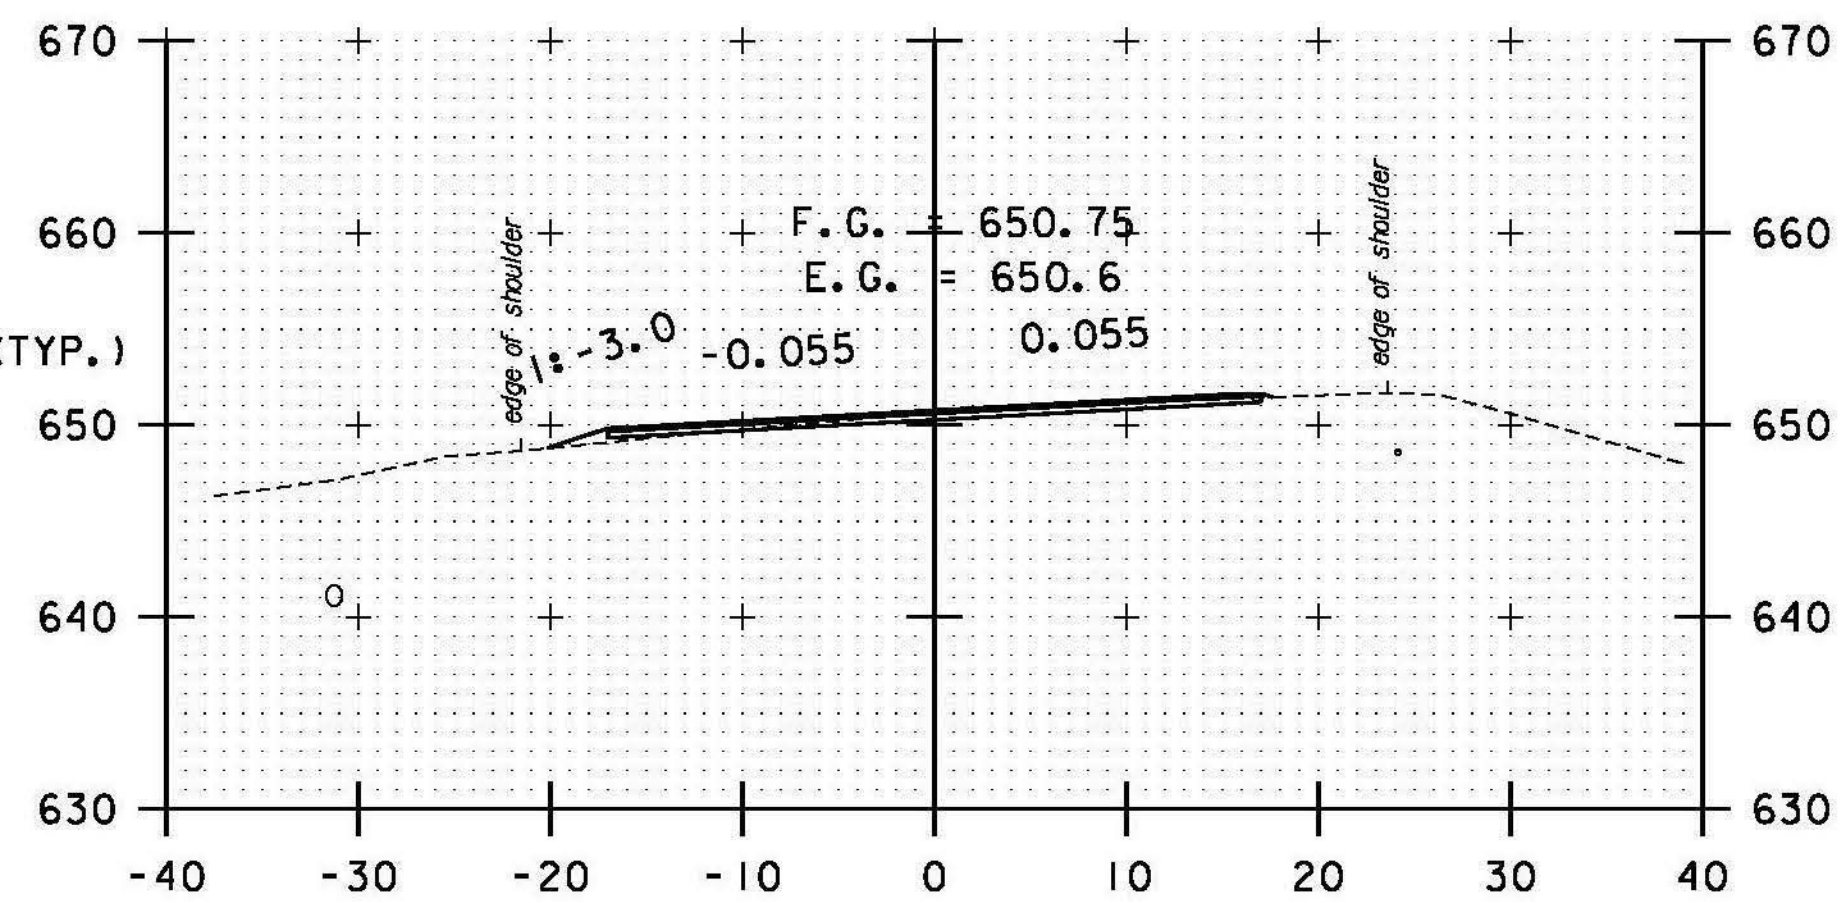


32+00

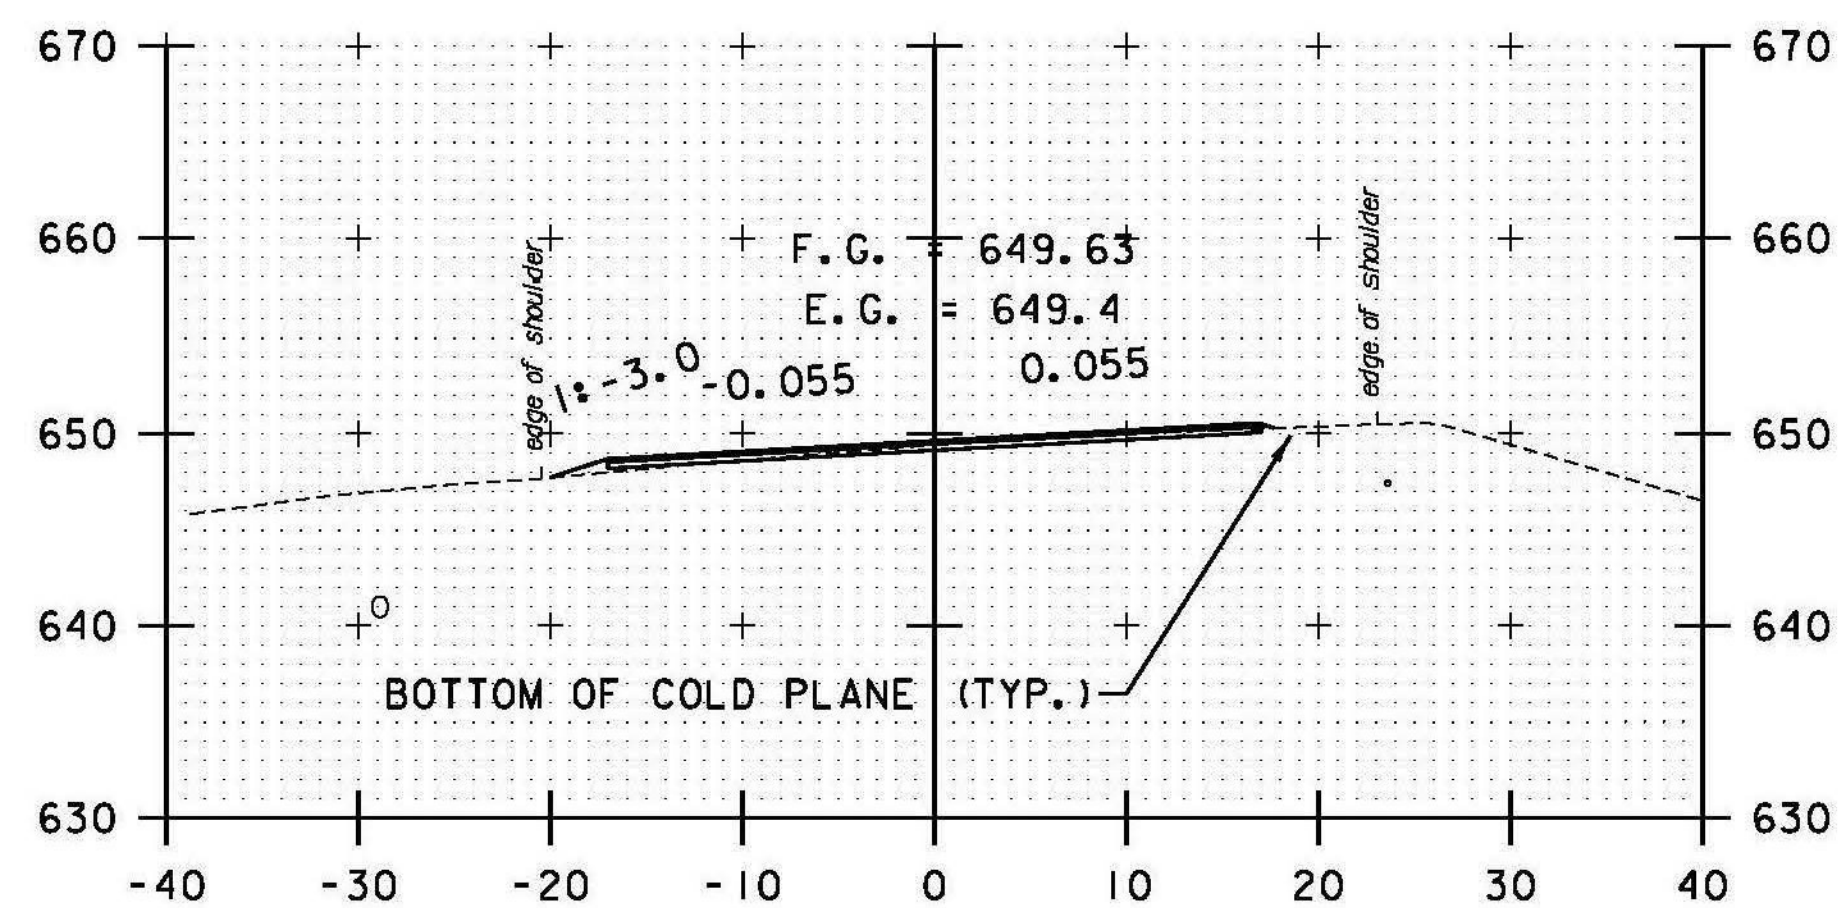


31+50

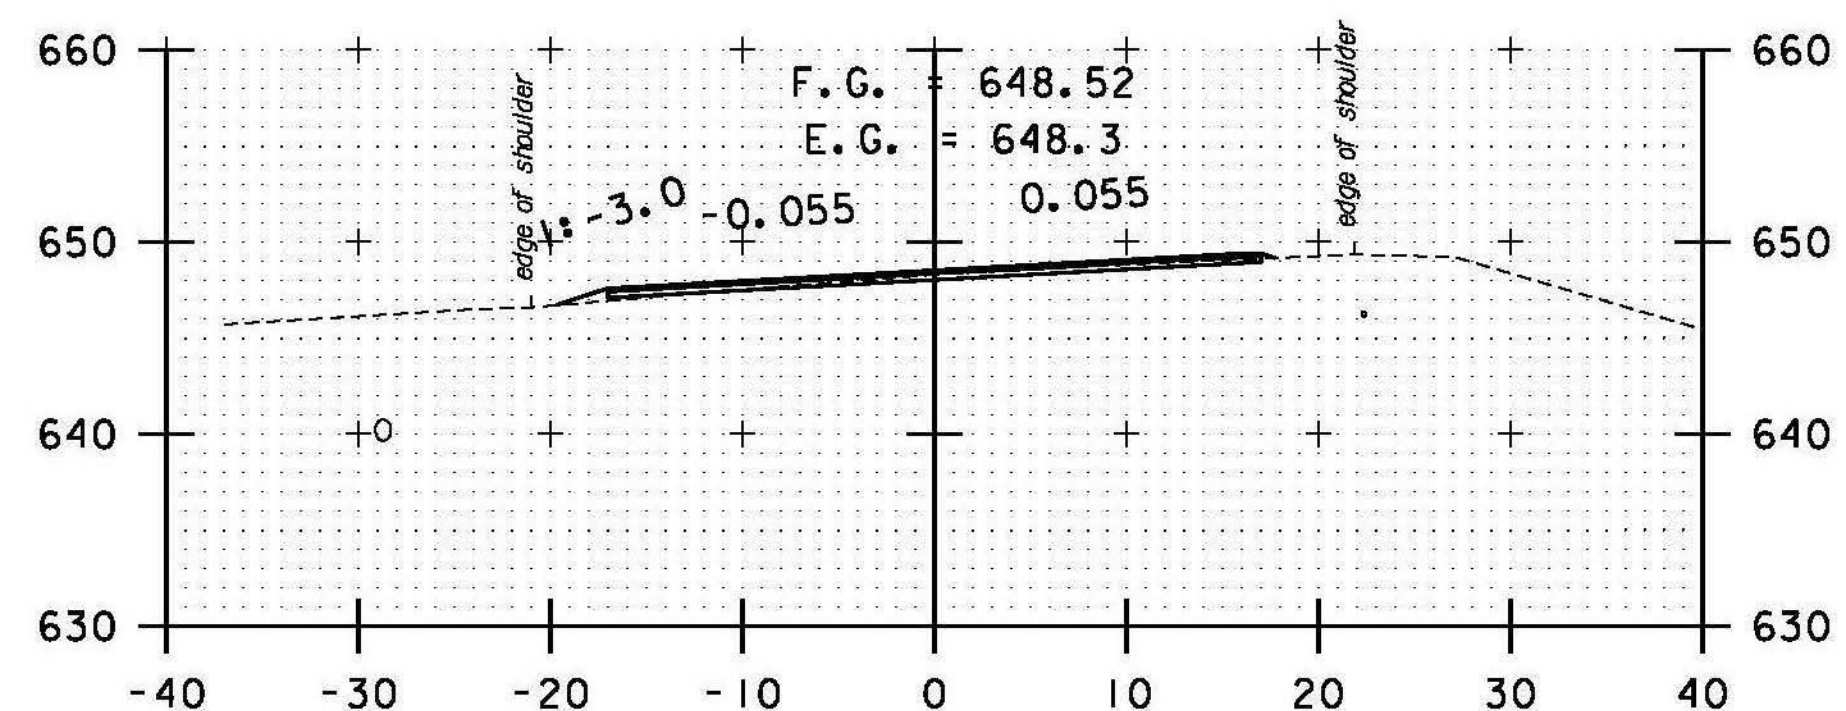


31+00

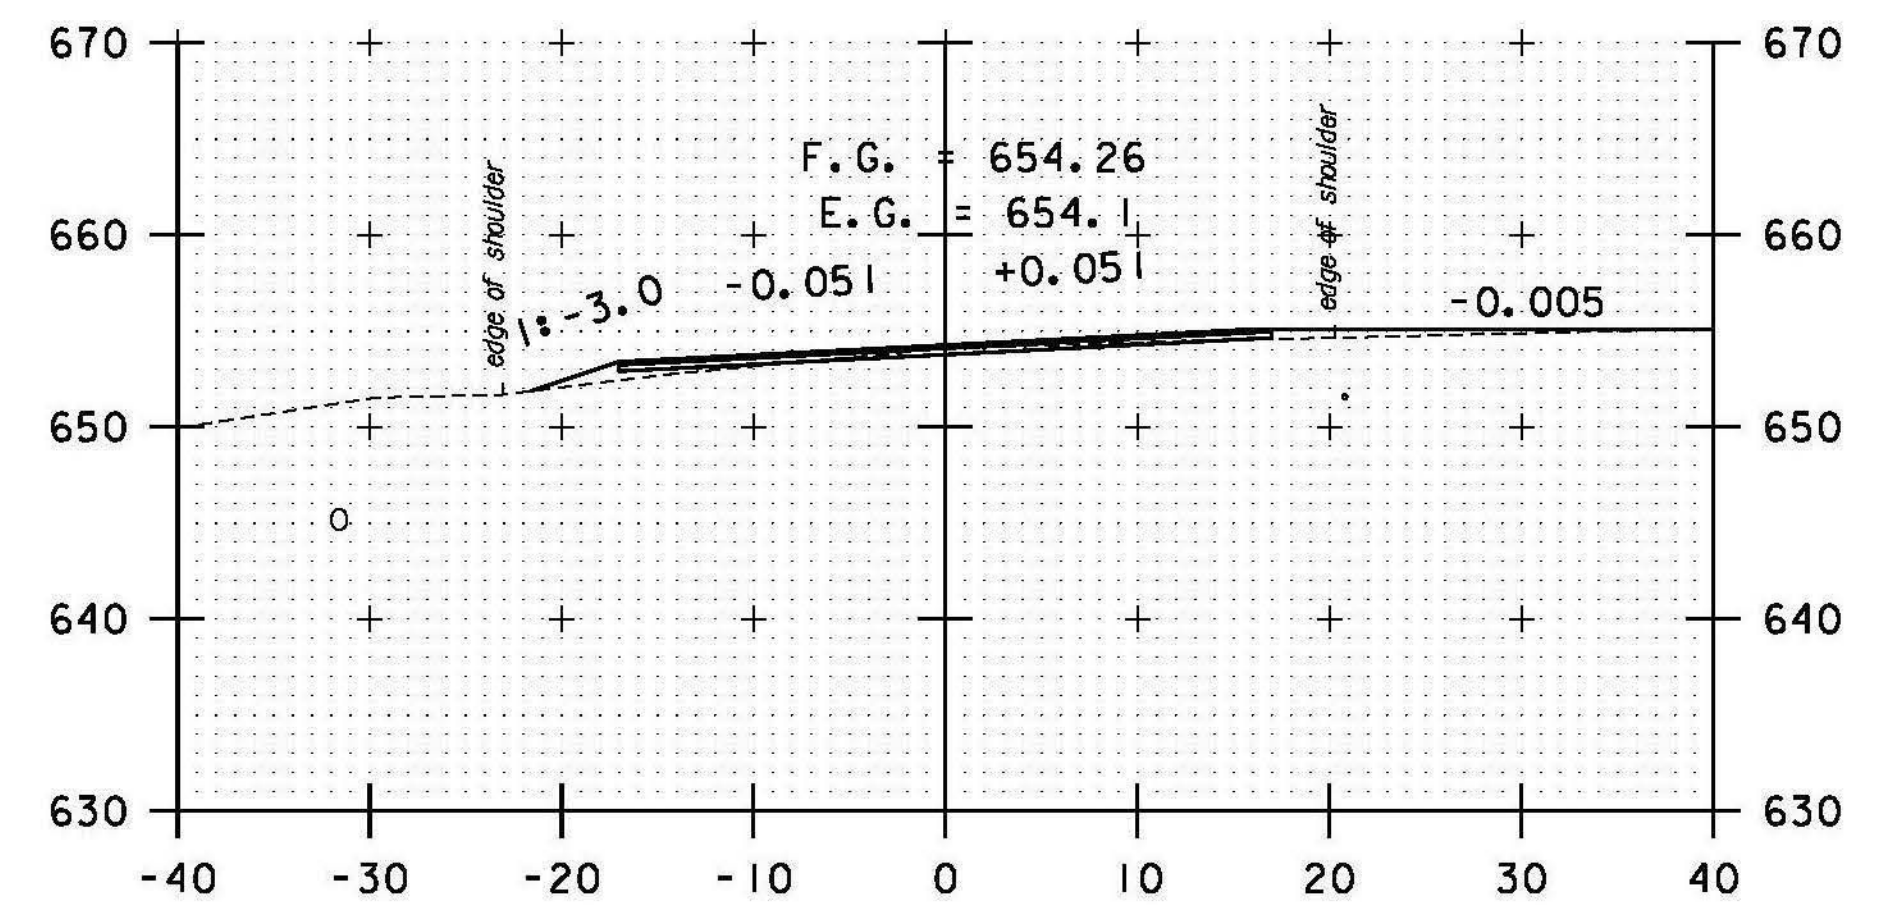

TH#68 RT
33+48

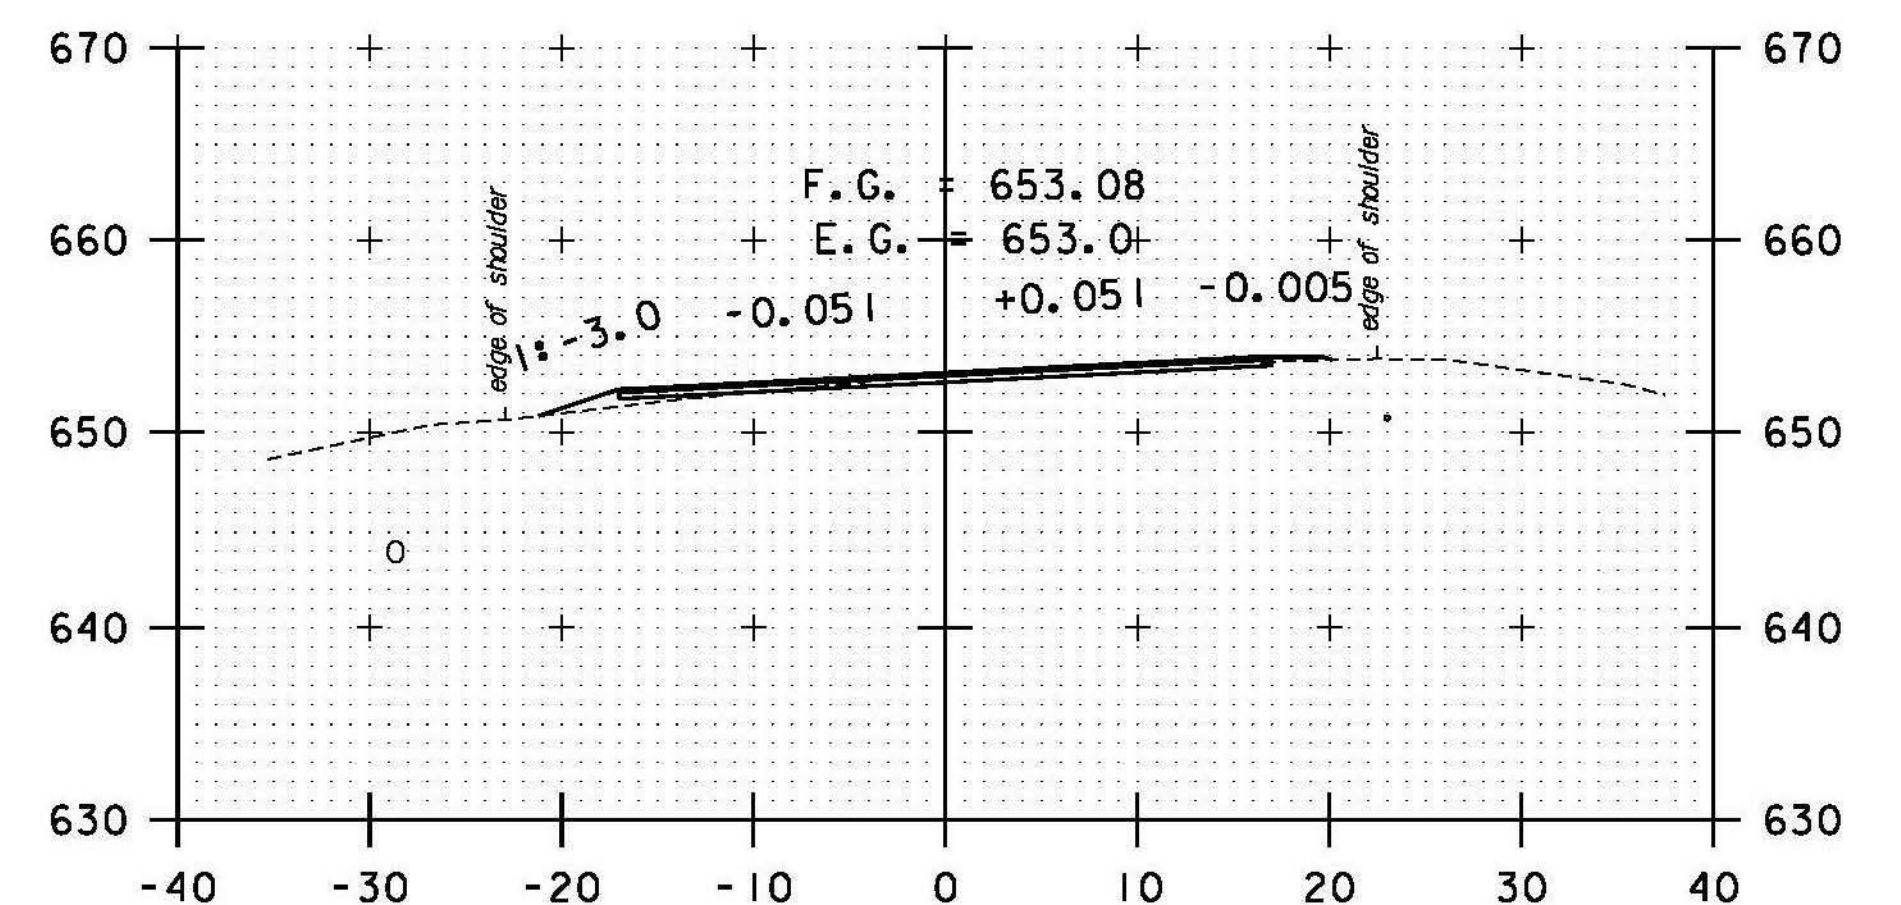

TH#68 RT
33+00

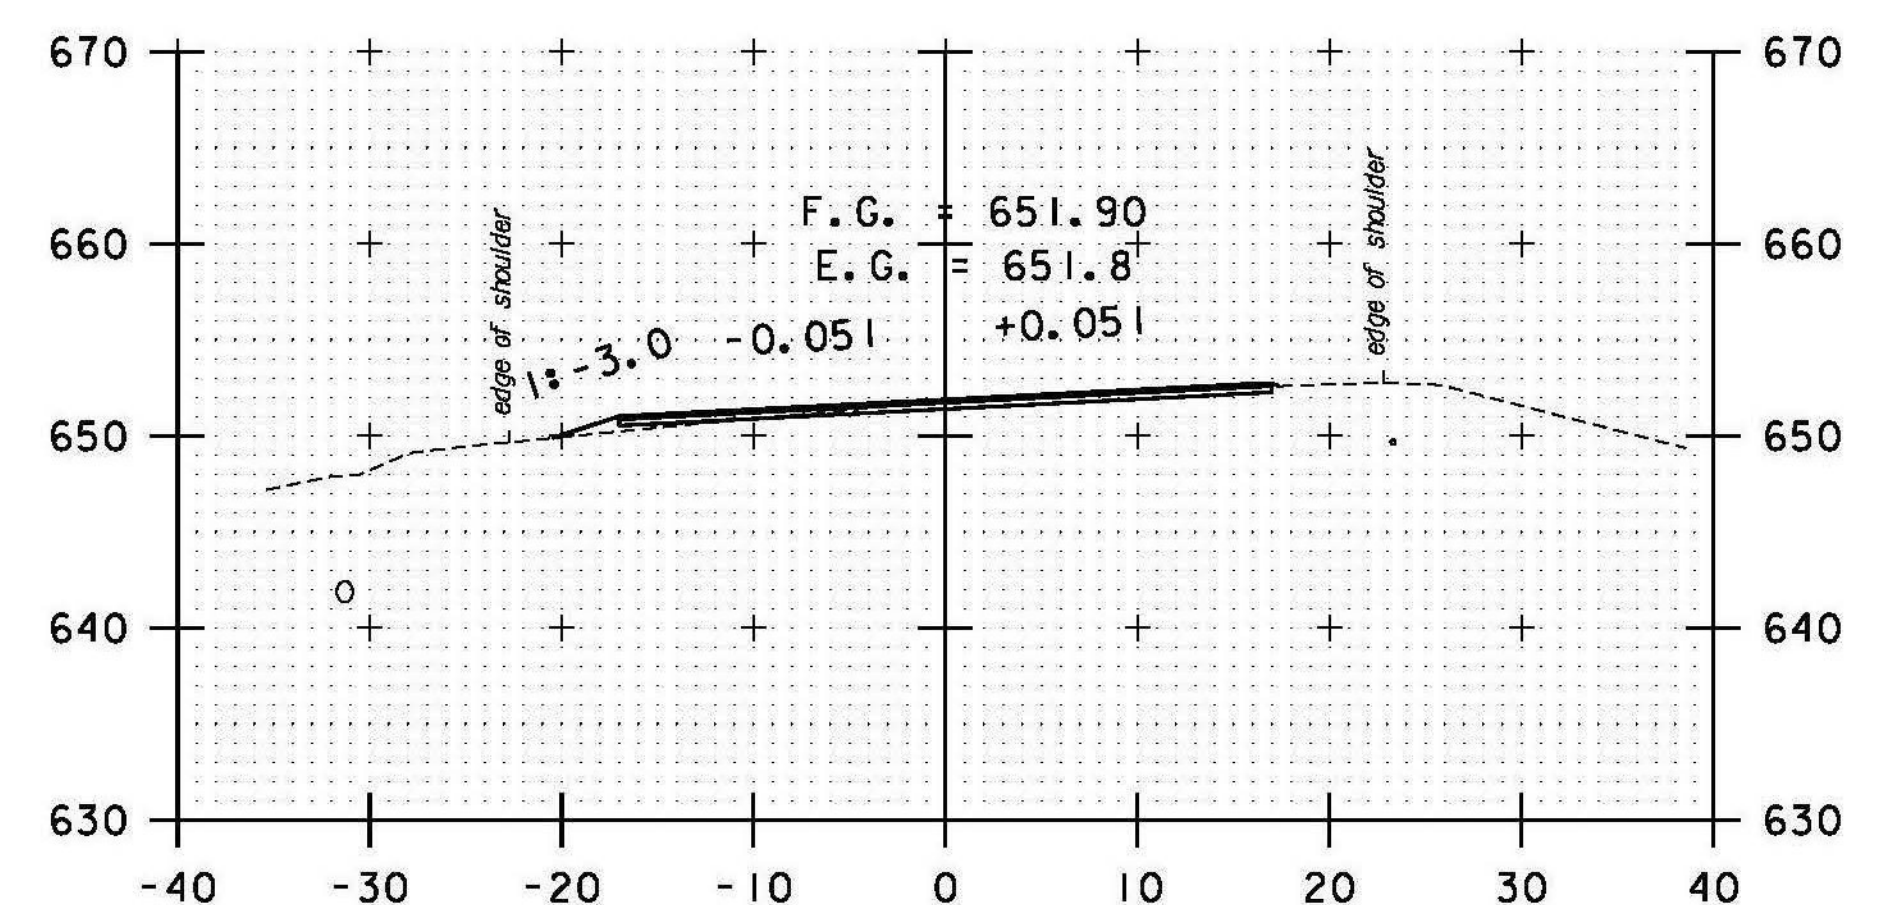

32+50

STA. 29+50 TO STA. 33+48

DATUM
VERTICAL NAVD 88
HORIZONTAL NAD 83 (07)

0 10 20
SCALE IN FEET

PROJECT NAME: RANDOLPH
PROJECT NUMBER: STP 2932 (1)

FILE NAME: z10c270.dgn
PROJECT LEADER: C. LATHROP
DESIGNED BY: B. BRESLEND
VT 66 CROSS SECTION SHEET 3

PLOT DATE: 6/5/2014
DRAWN BY: B. BRESLEND
CHECKED BY: C. LATHROP
SHEET 159 OF 276