




34+50

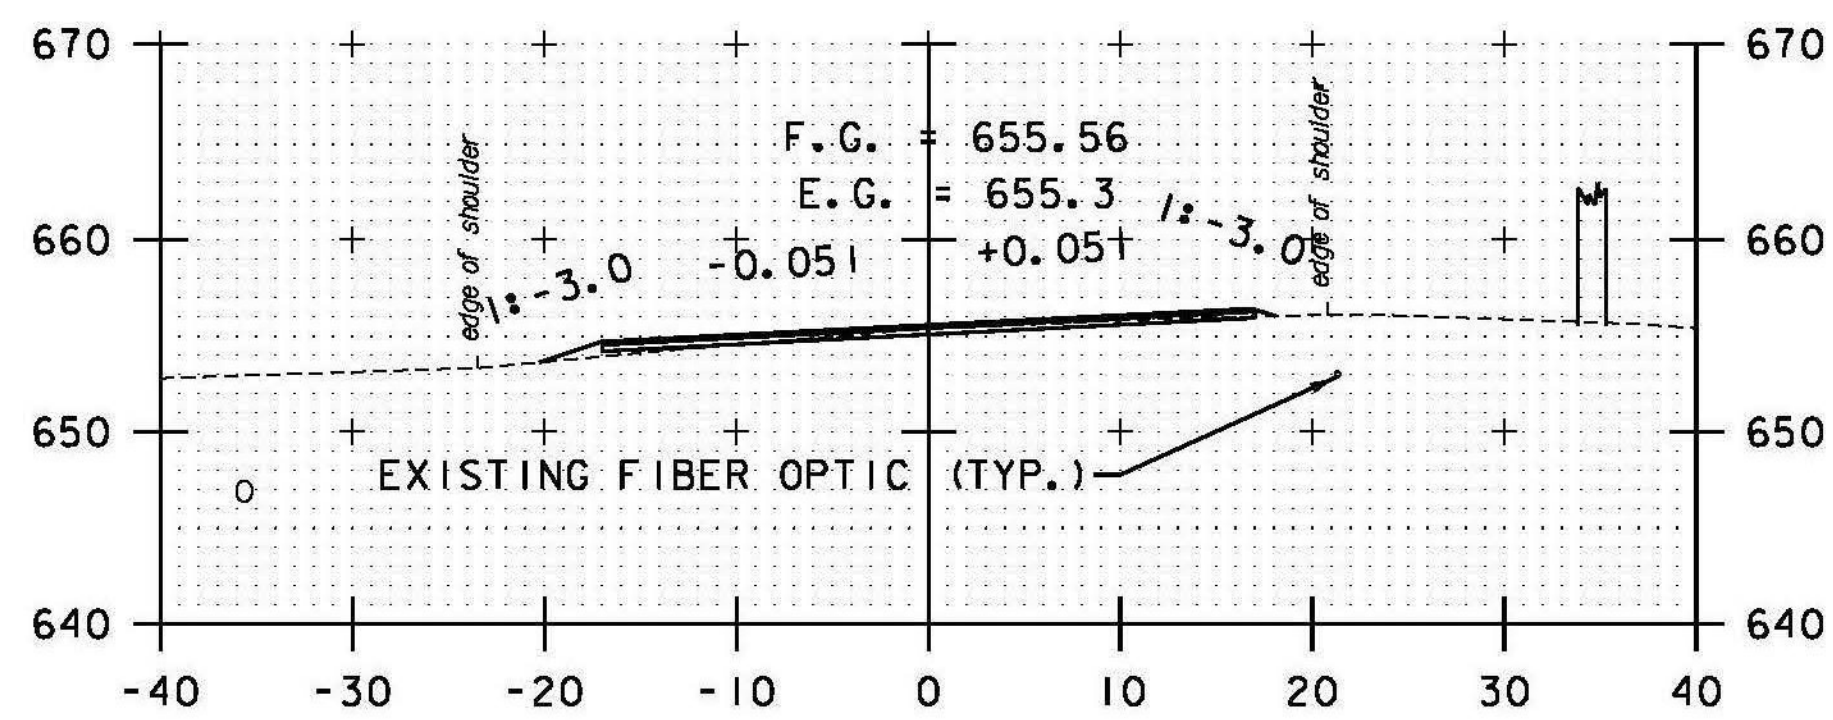


TH#68 RT  
34+00

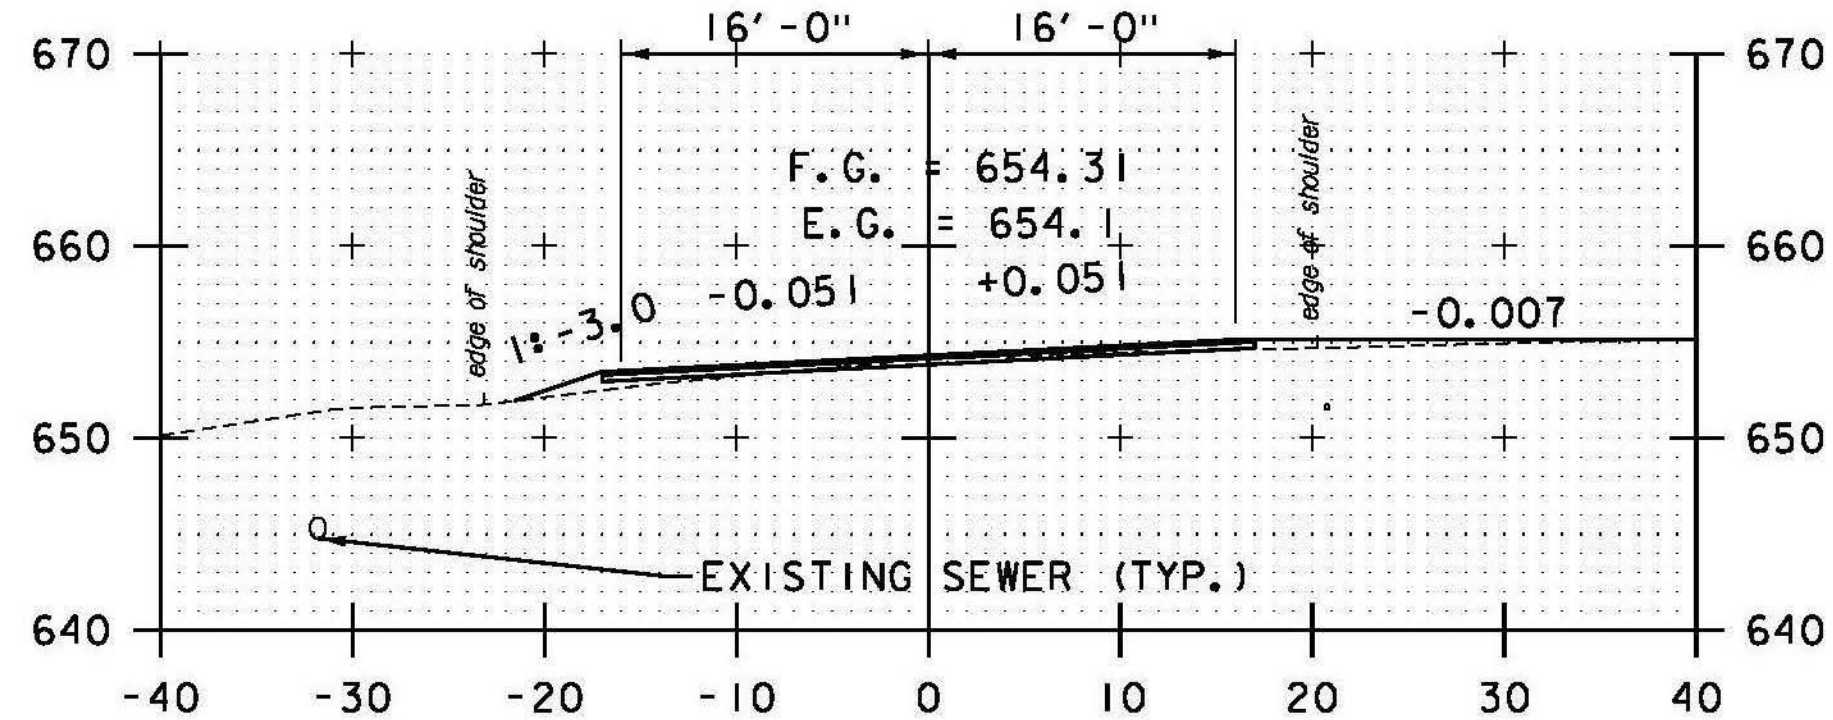


TH#68 RT  
33+50

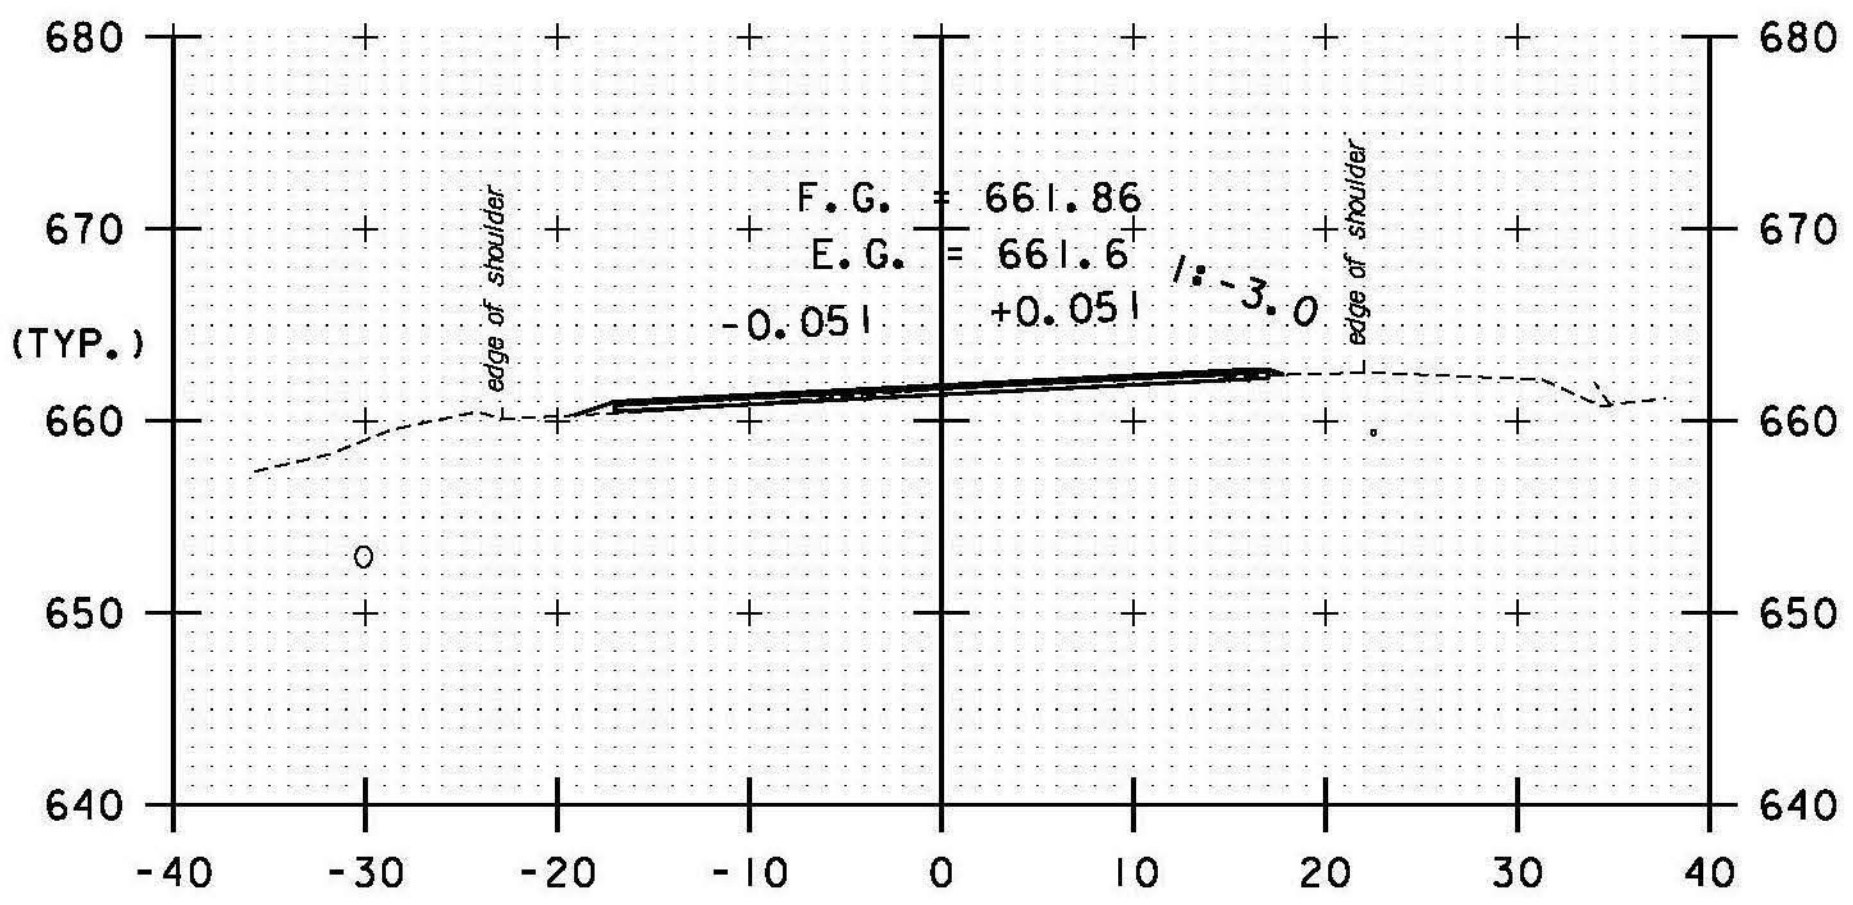


36+00

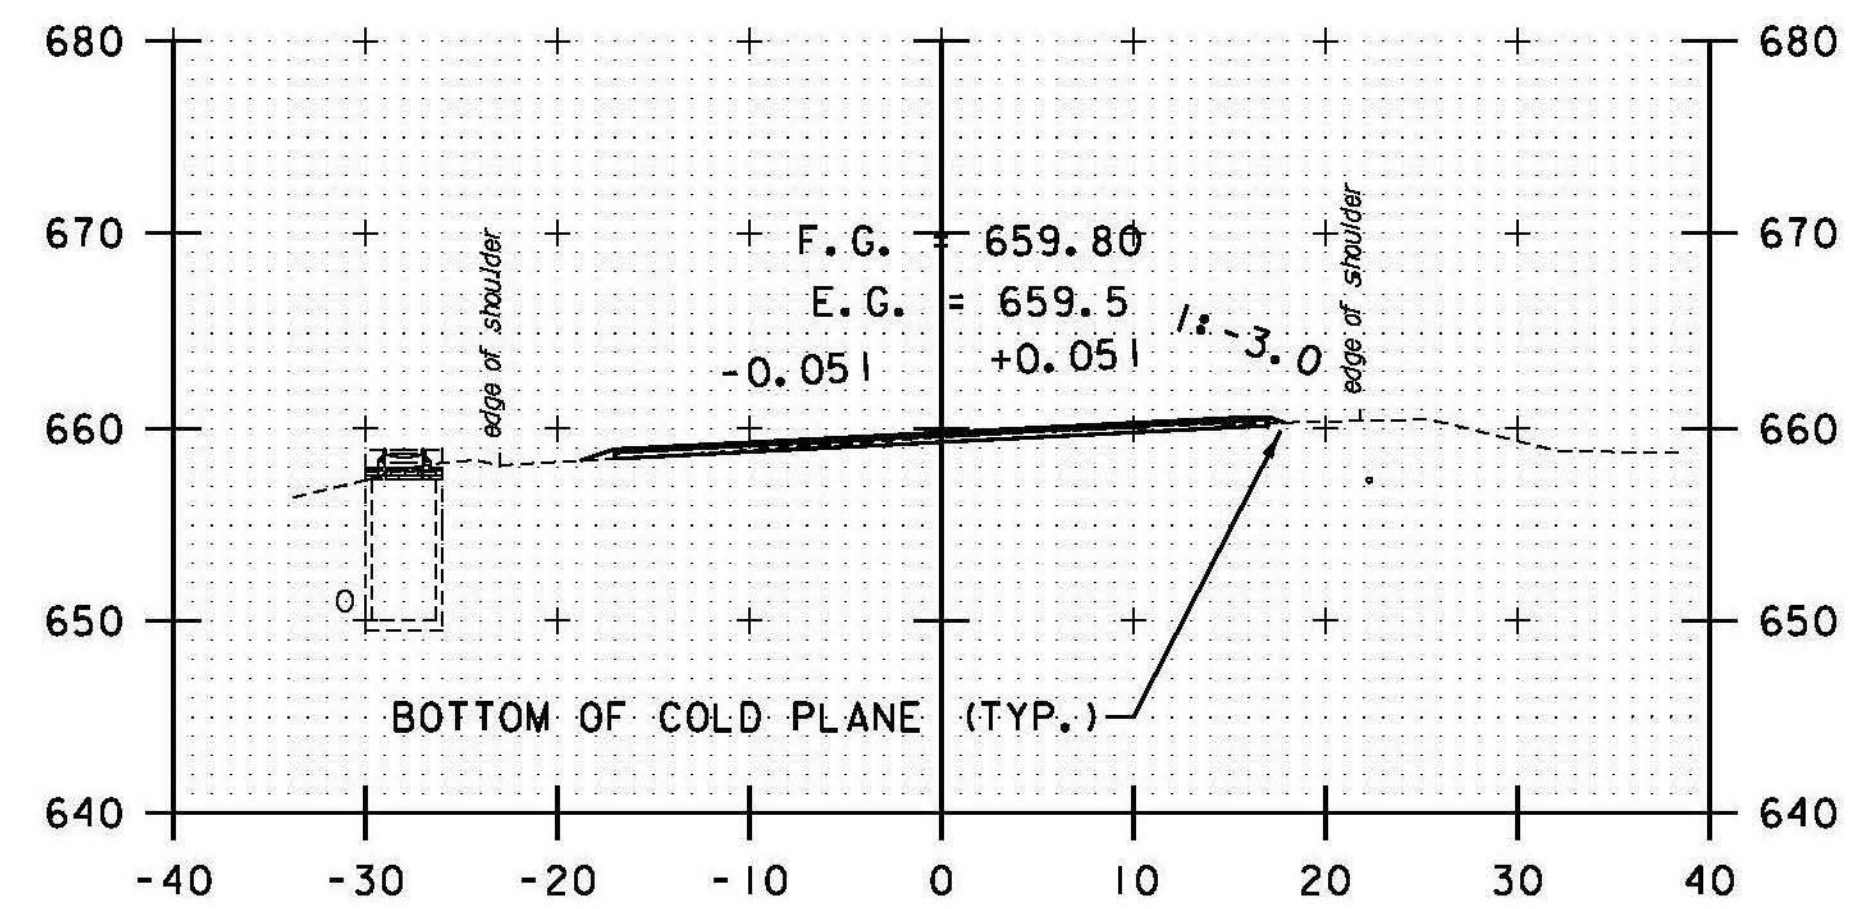


35+50

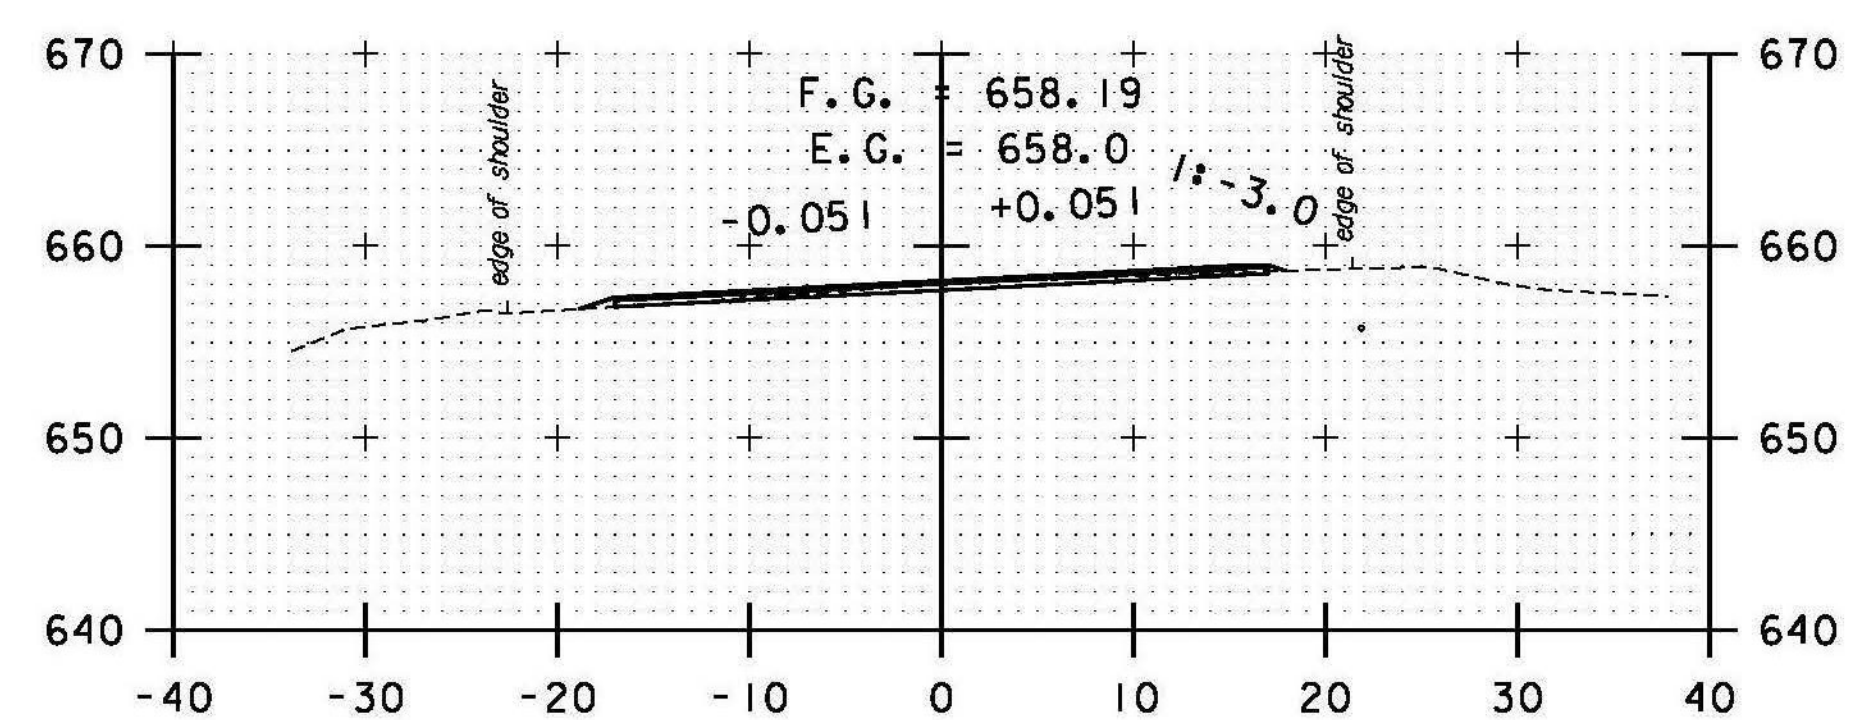


35+00

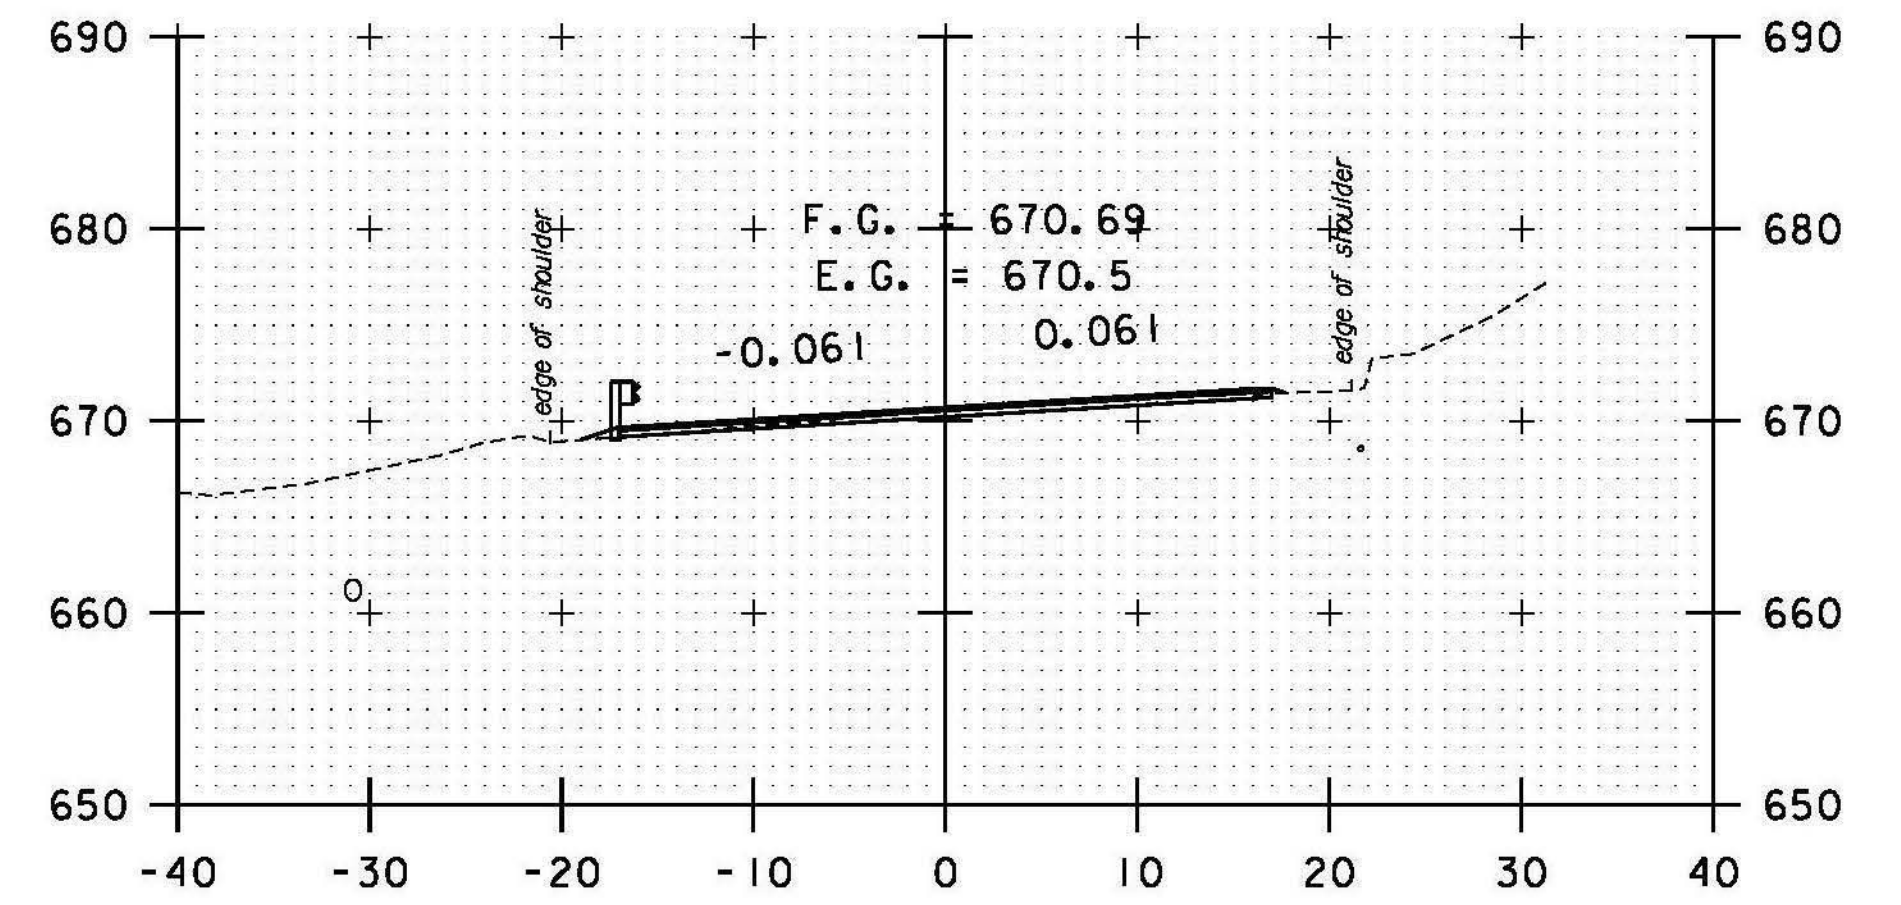

37+50

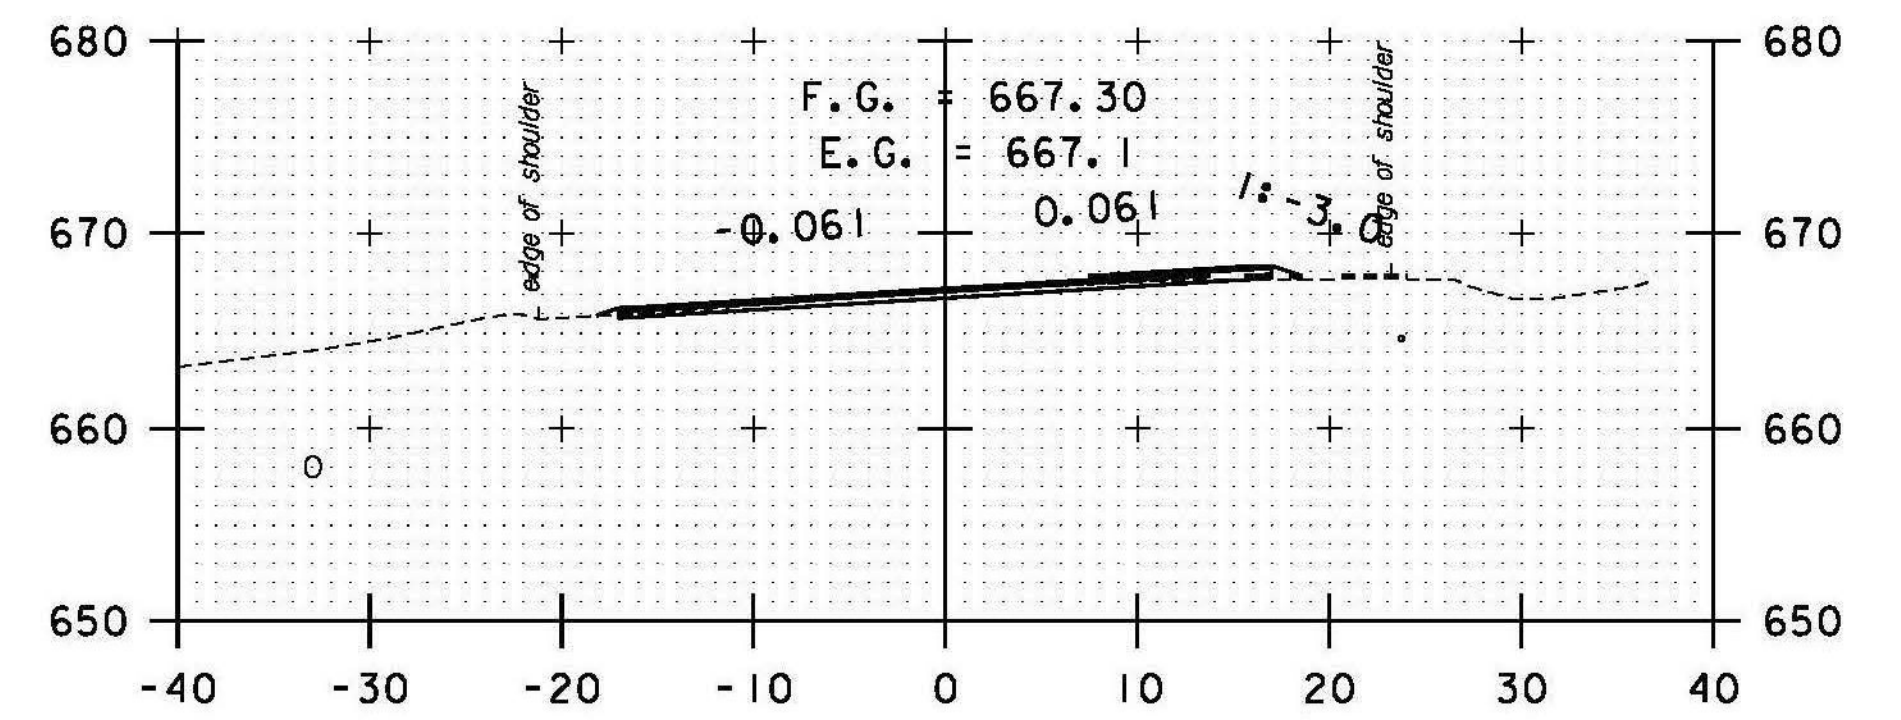


37+00

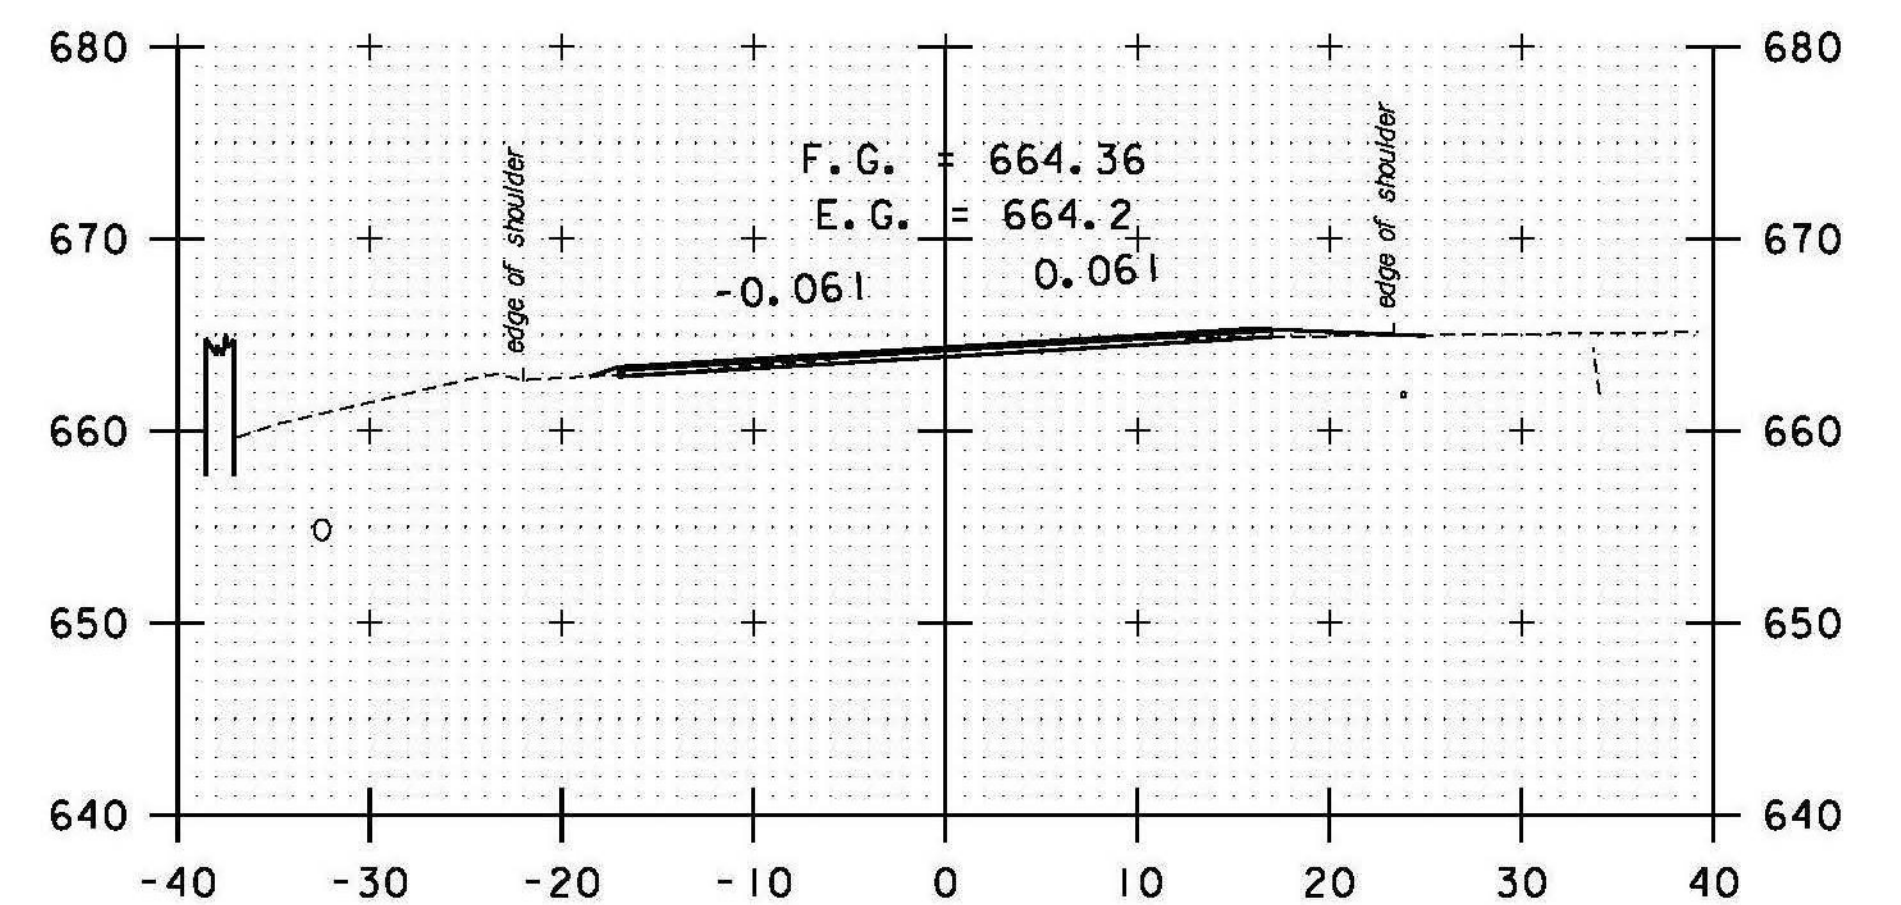

DRIVE RT  
36+50

STA. 33+50 TO STA. 37+50

DATUM  
VERTICAL NAVD 88  
HORIZONTAL NAD 83 (07)

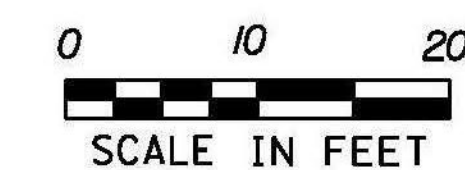

PROJECT NAME: RANDOLPH  
PROJECT NUMBER: STP 2932 (1)

FILE NAME: z10c270.dgn  
PROJECT LEADER: C. LATHROP  
DESIGNED BY: B. BRESLEND  
VT 66 CROSS SECTION SHEET 4

PLOT DATE: 6/5/2014  
DRAWN BY: B. BRESLEND  
CHECKED BY: C. LATHROP  
SHEET 160 OF 276