




DRIVE LT  
43+50

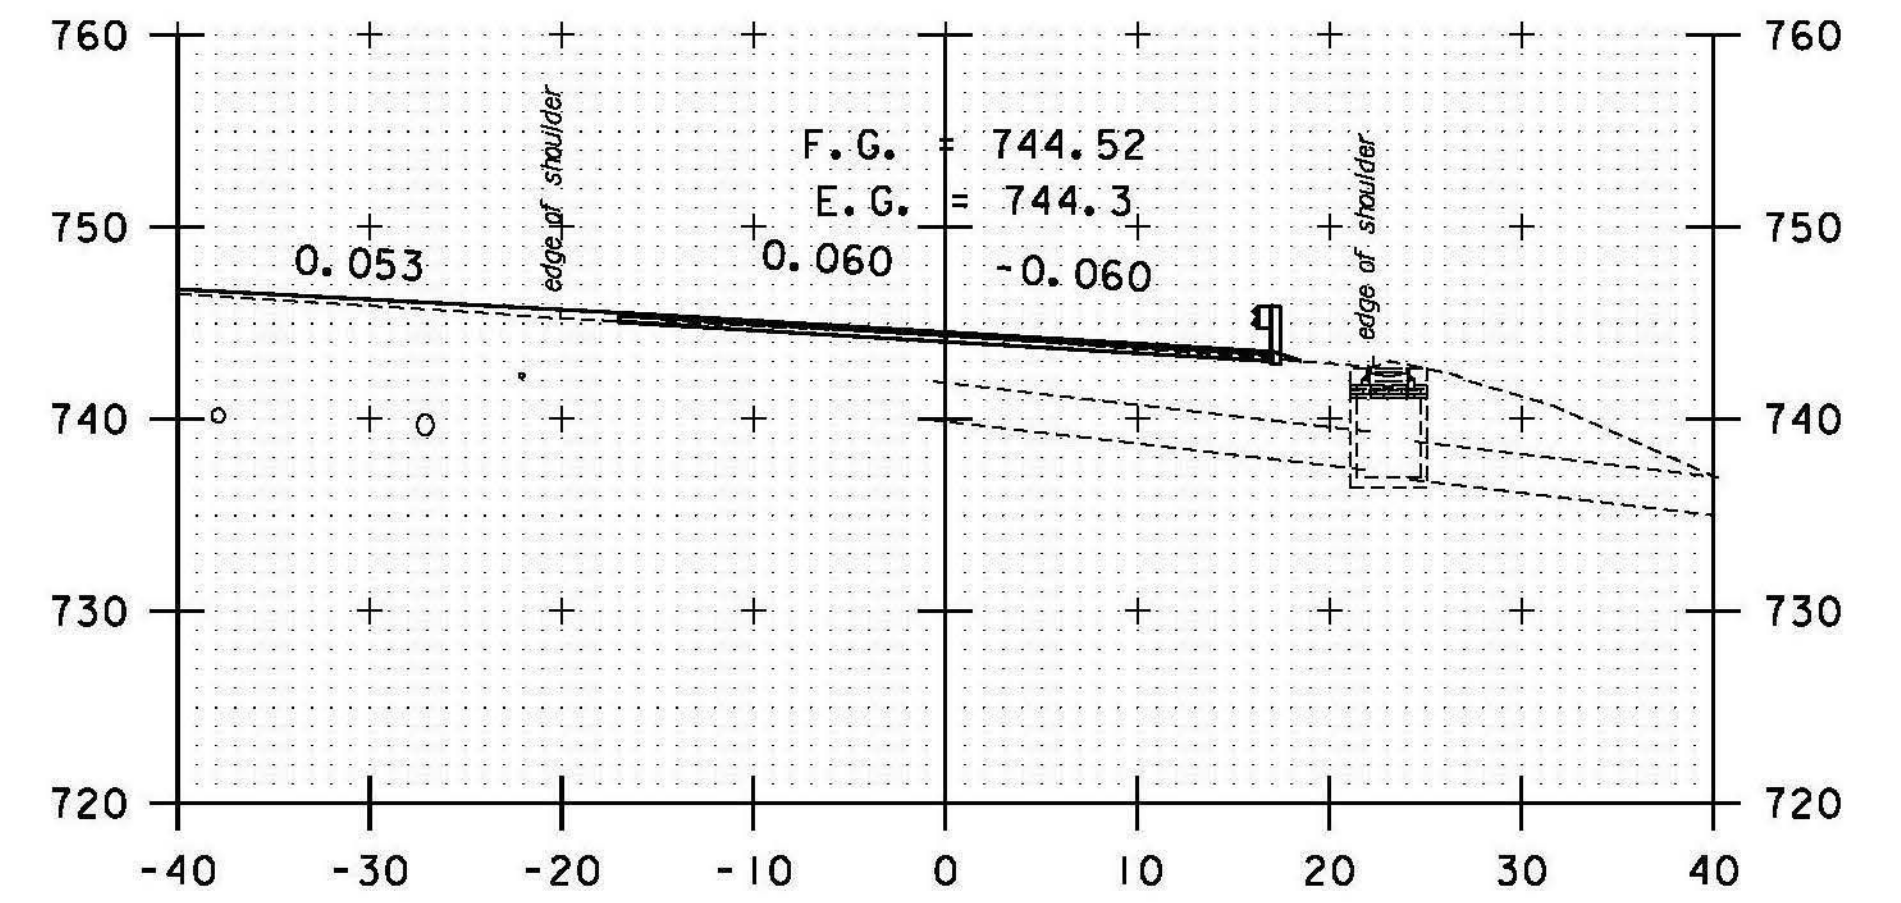


TH#6 LT  
45+58

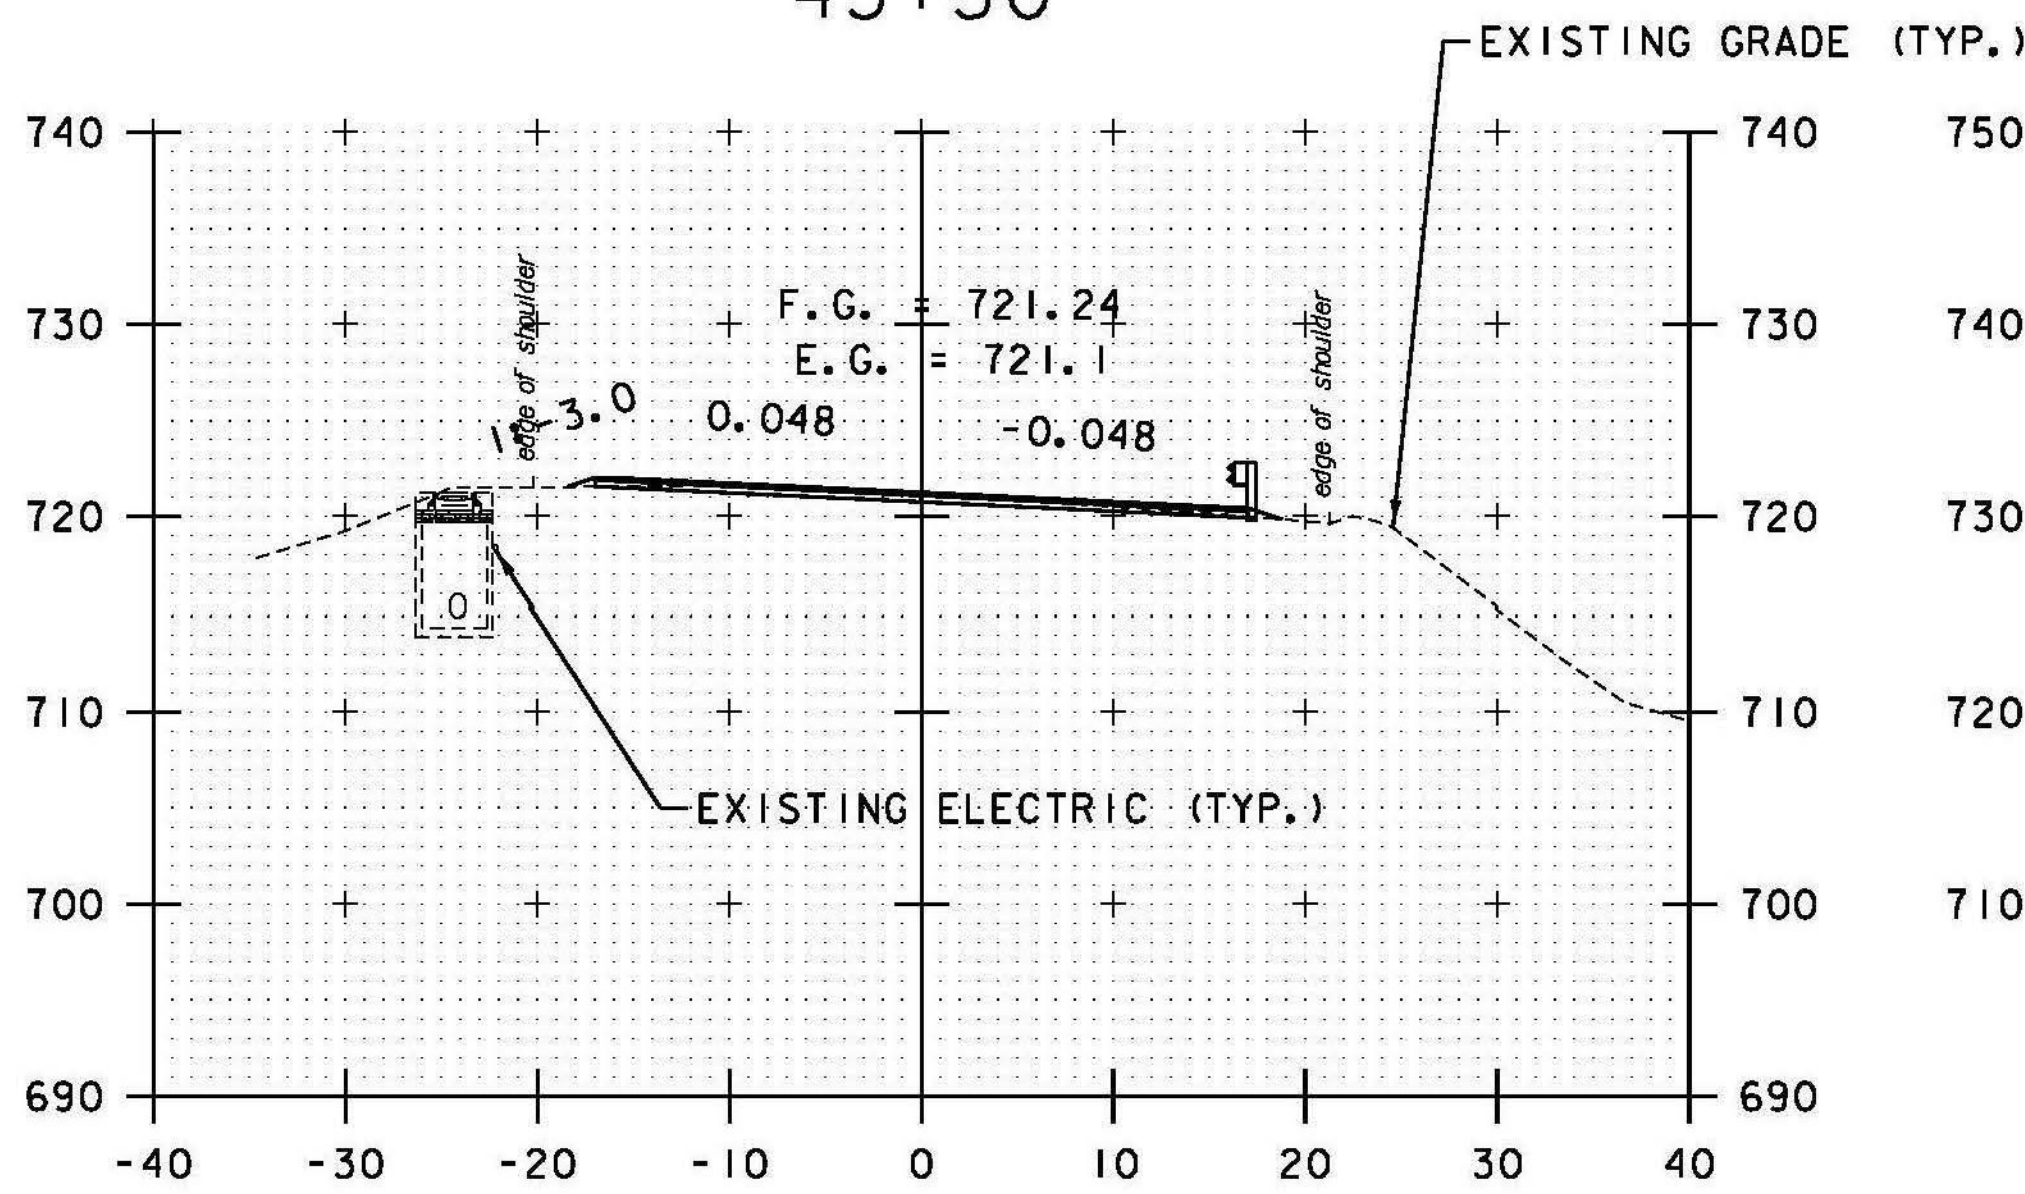


43+00

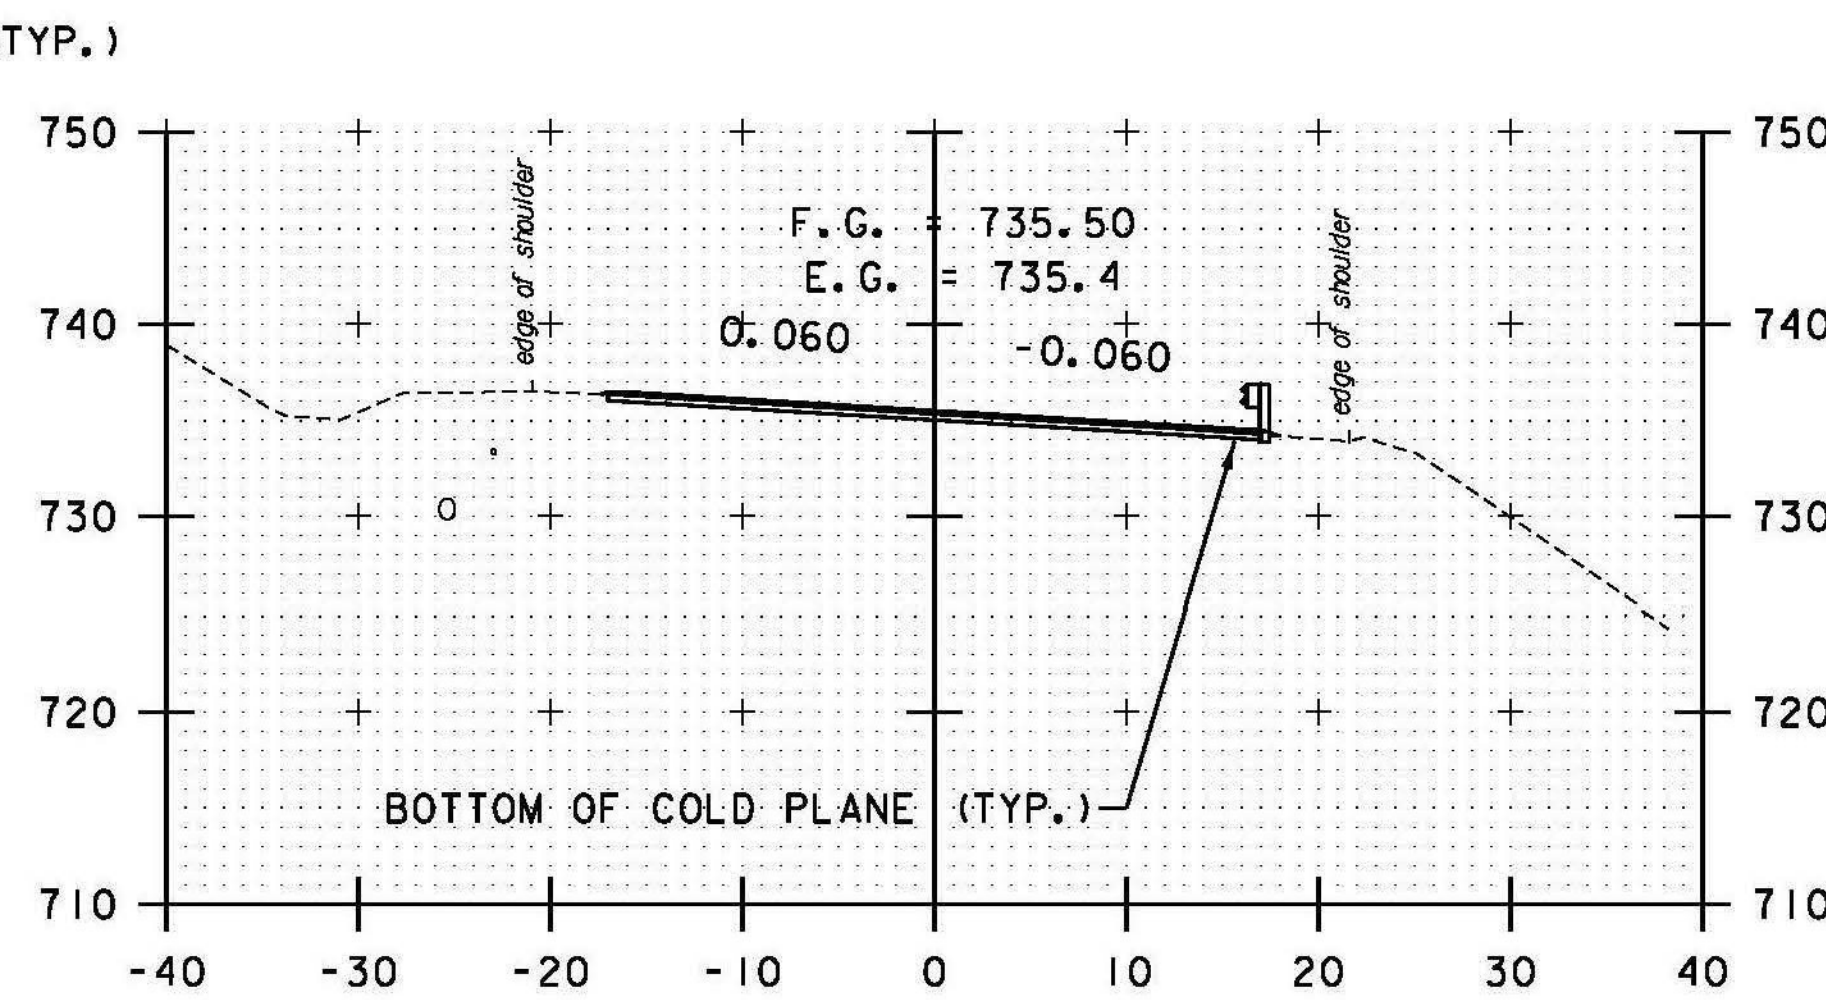


44+50

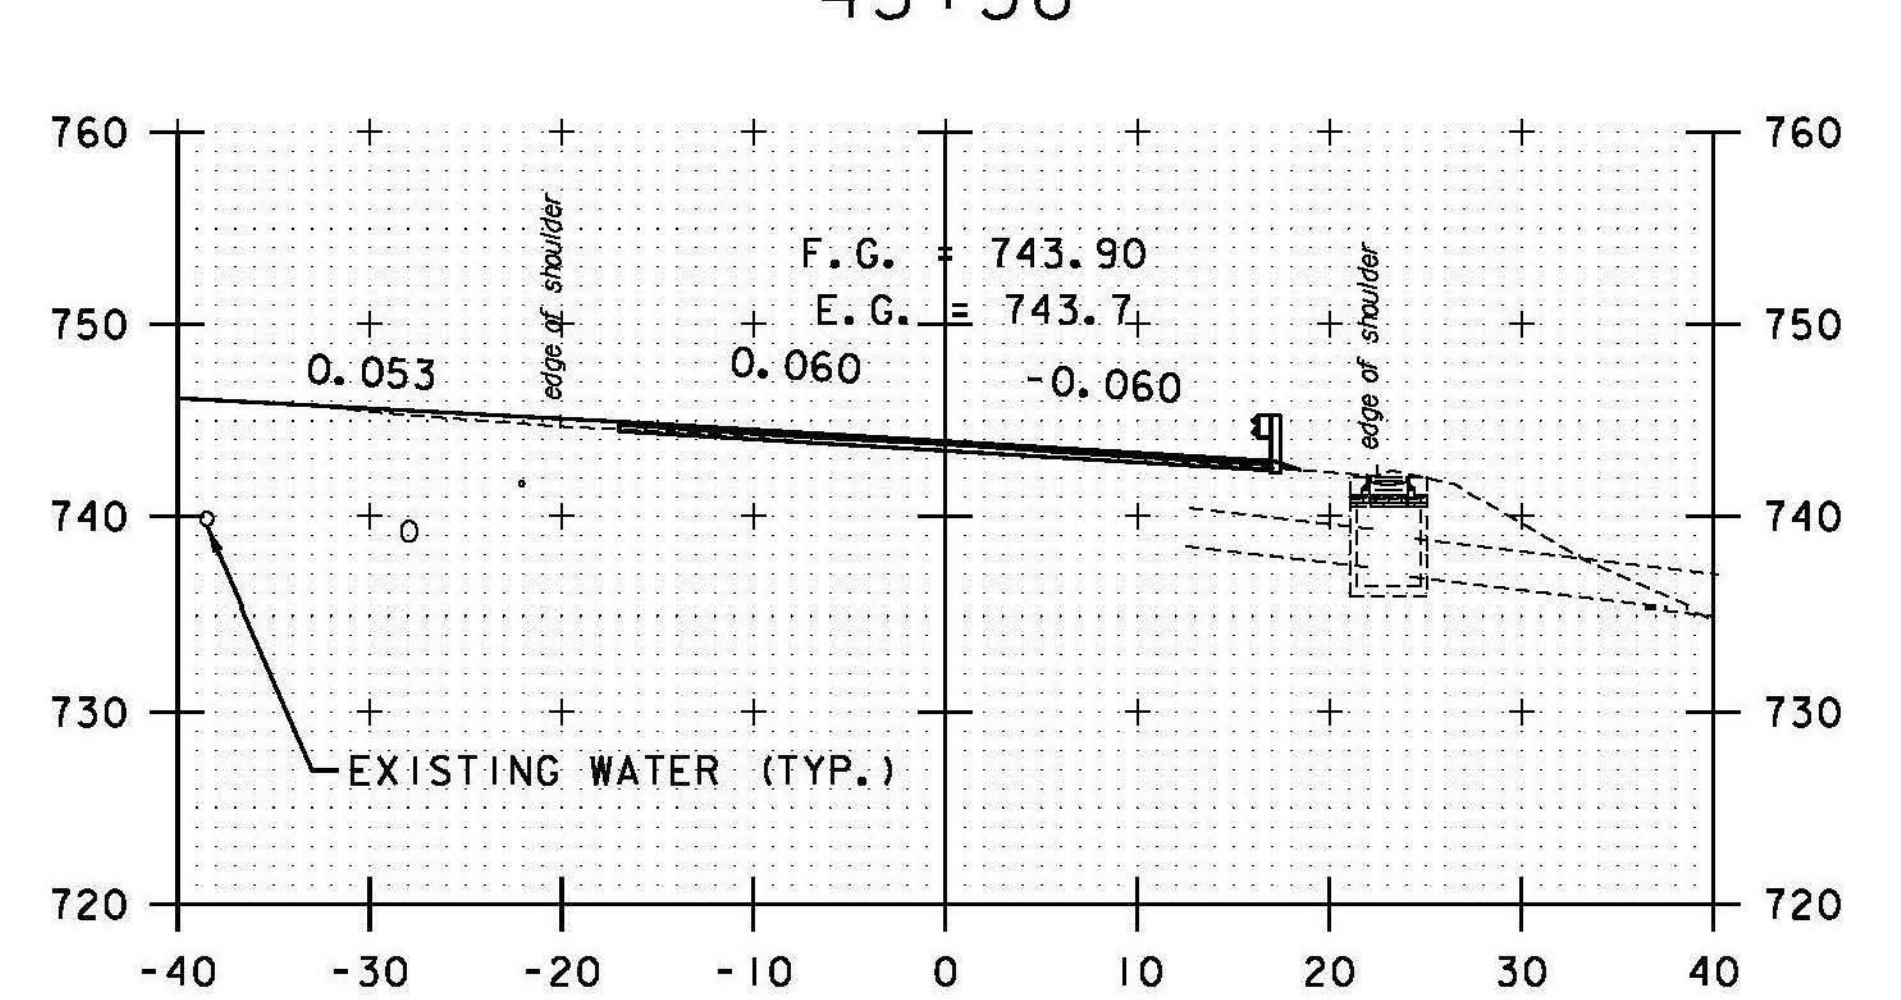


TH#6 LT  
45+50

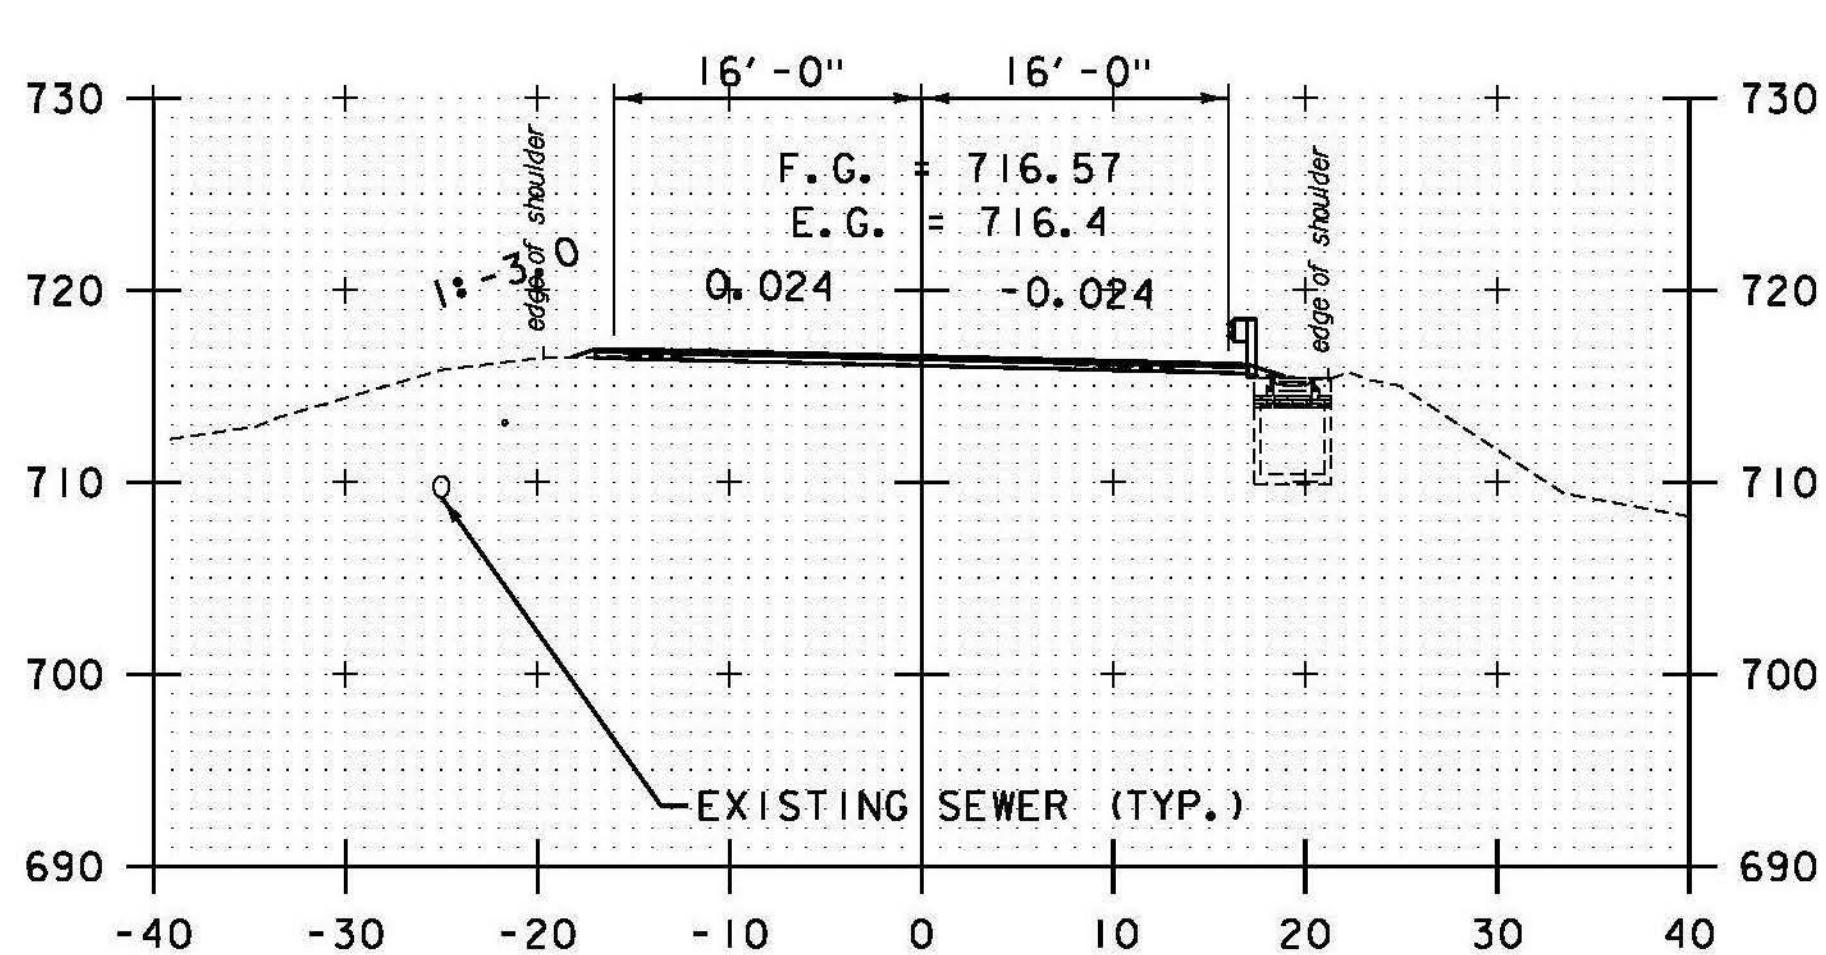

42+50

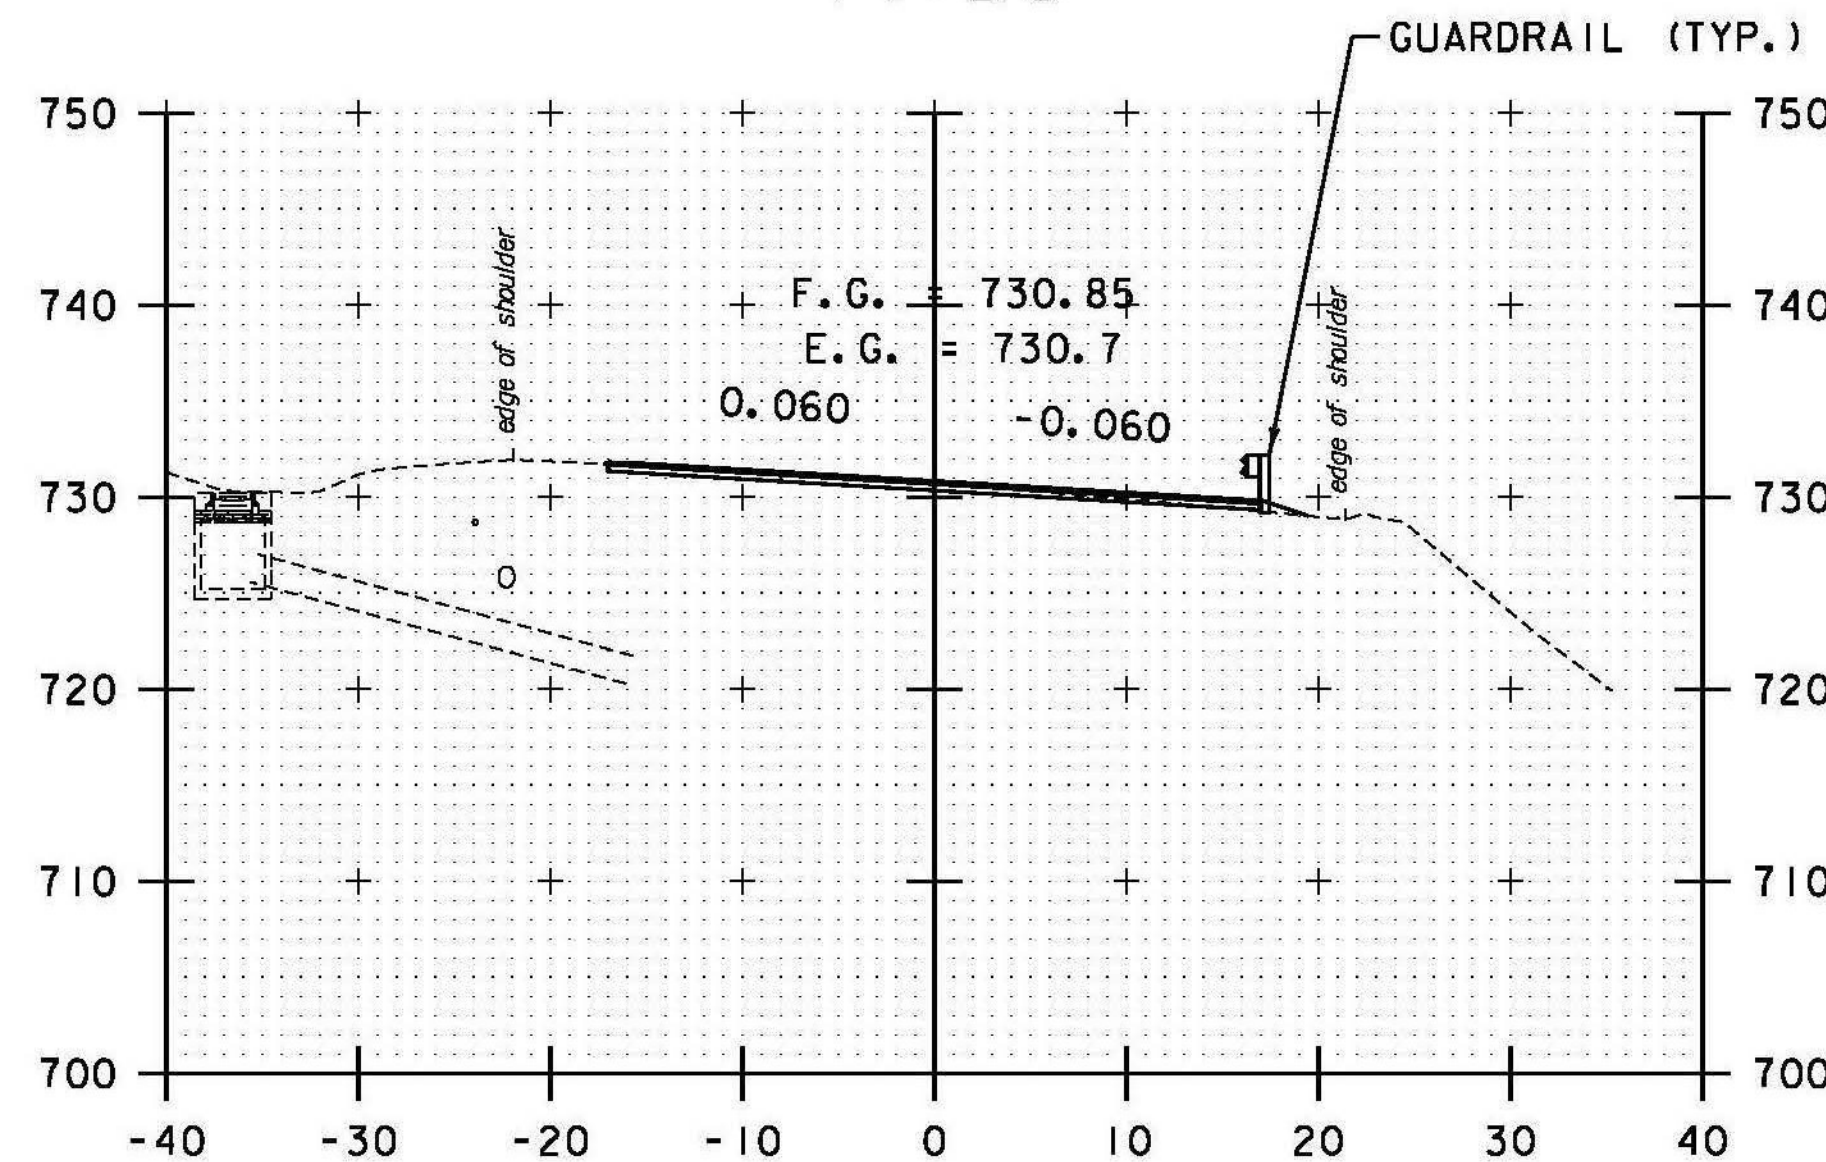


44+00

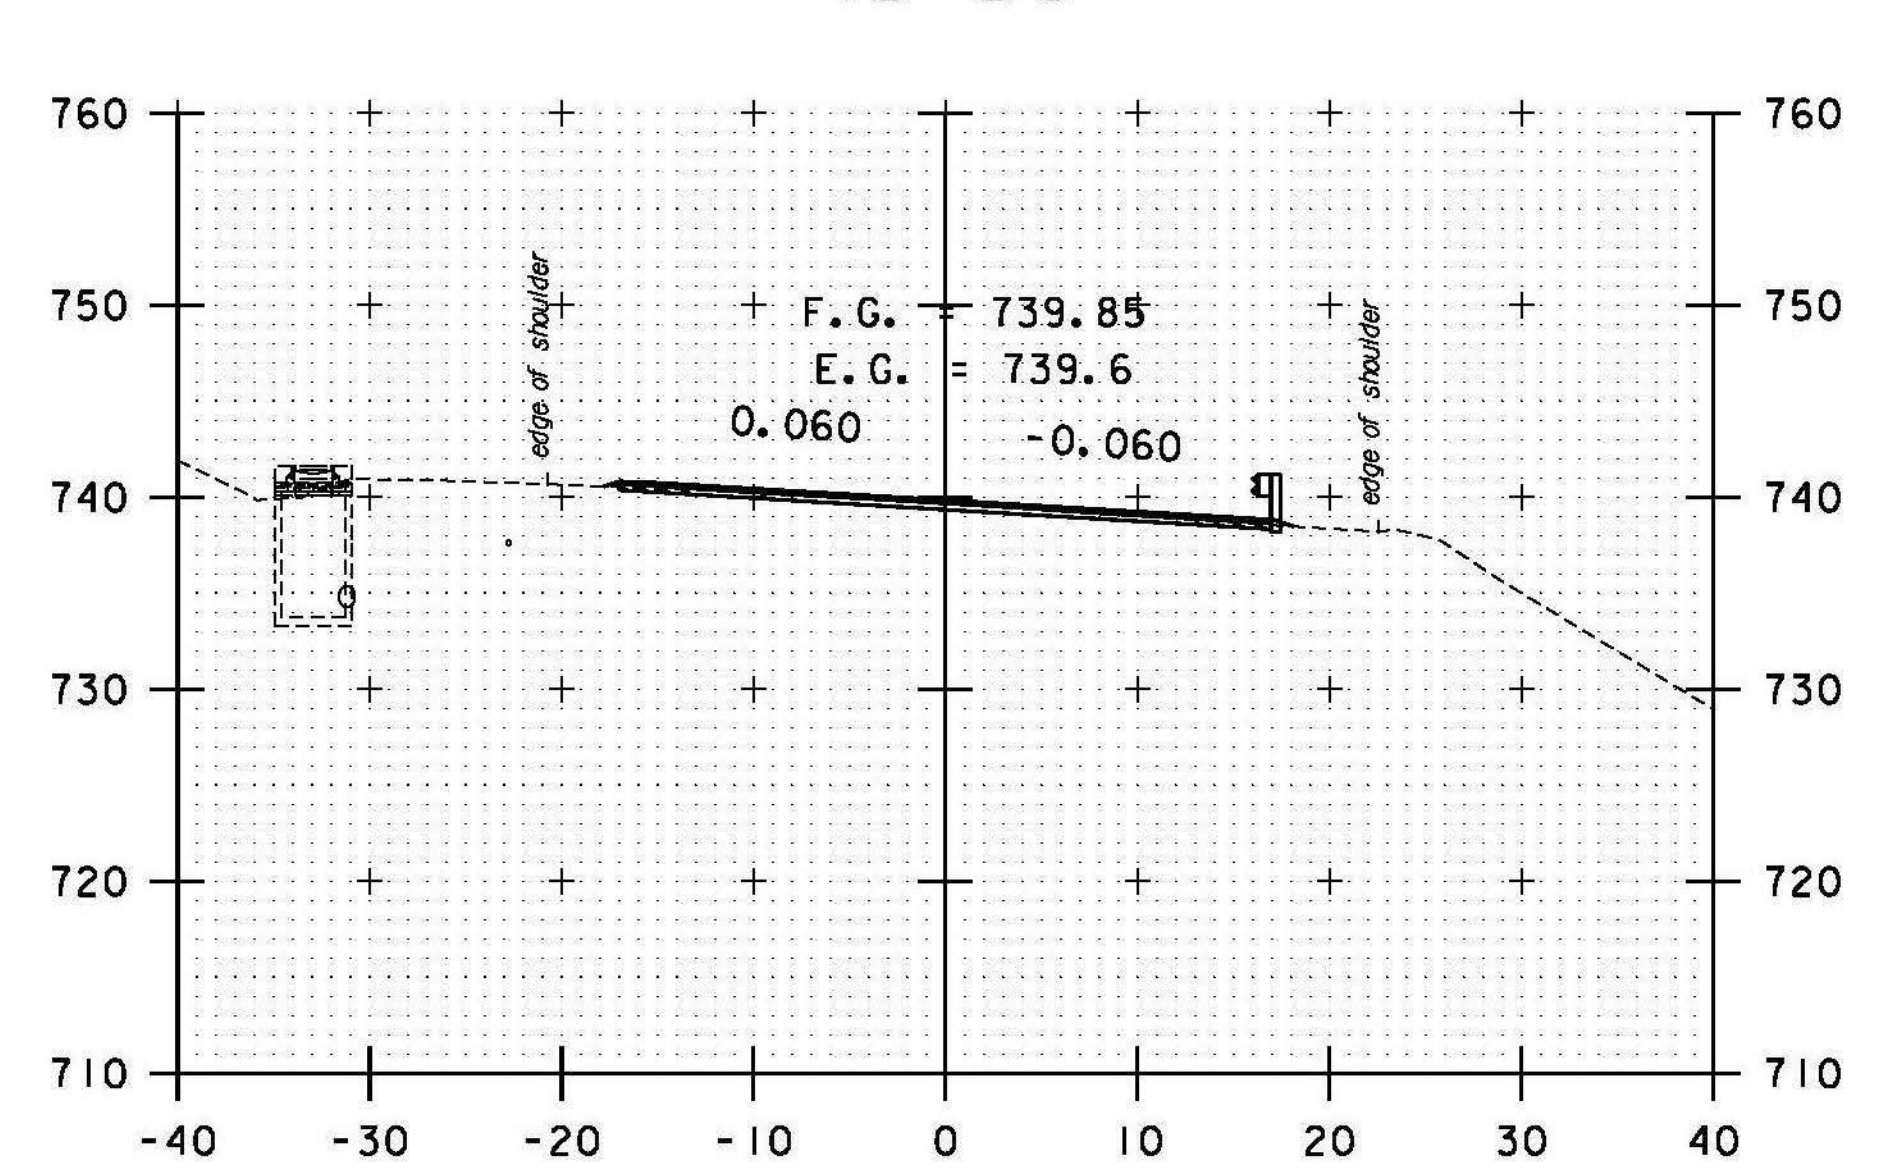

45+00

STA. 42+50 TO STA. 45+58

DATUM  
VERTICAL NAVD 88  
HORIZONTAL NAD 83 (07)

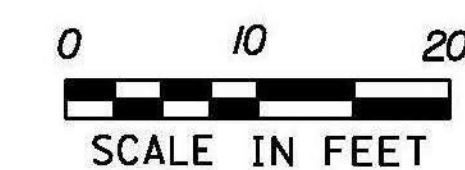

PROJECT NAME: RANDOLPH  
PROJECT NUMBER: STP 2932 (1)

FILE NAME: z10c270.dgn  
PROJECT LEADER: C. LATHROP  
DESIGNED BY: B. BRESLEND  
VT 66 CROSS SECTION SHEET 6

PLOT DATE: 6/5/2014  
DRAWN BY: B. BRESLEND  
CHECKED BY: C. LATHROP  
SHEET 162 OF 276