




DRIVE RT
51+50

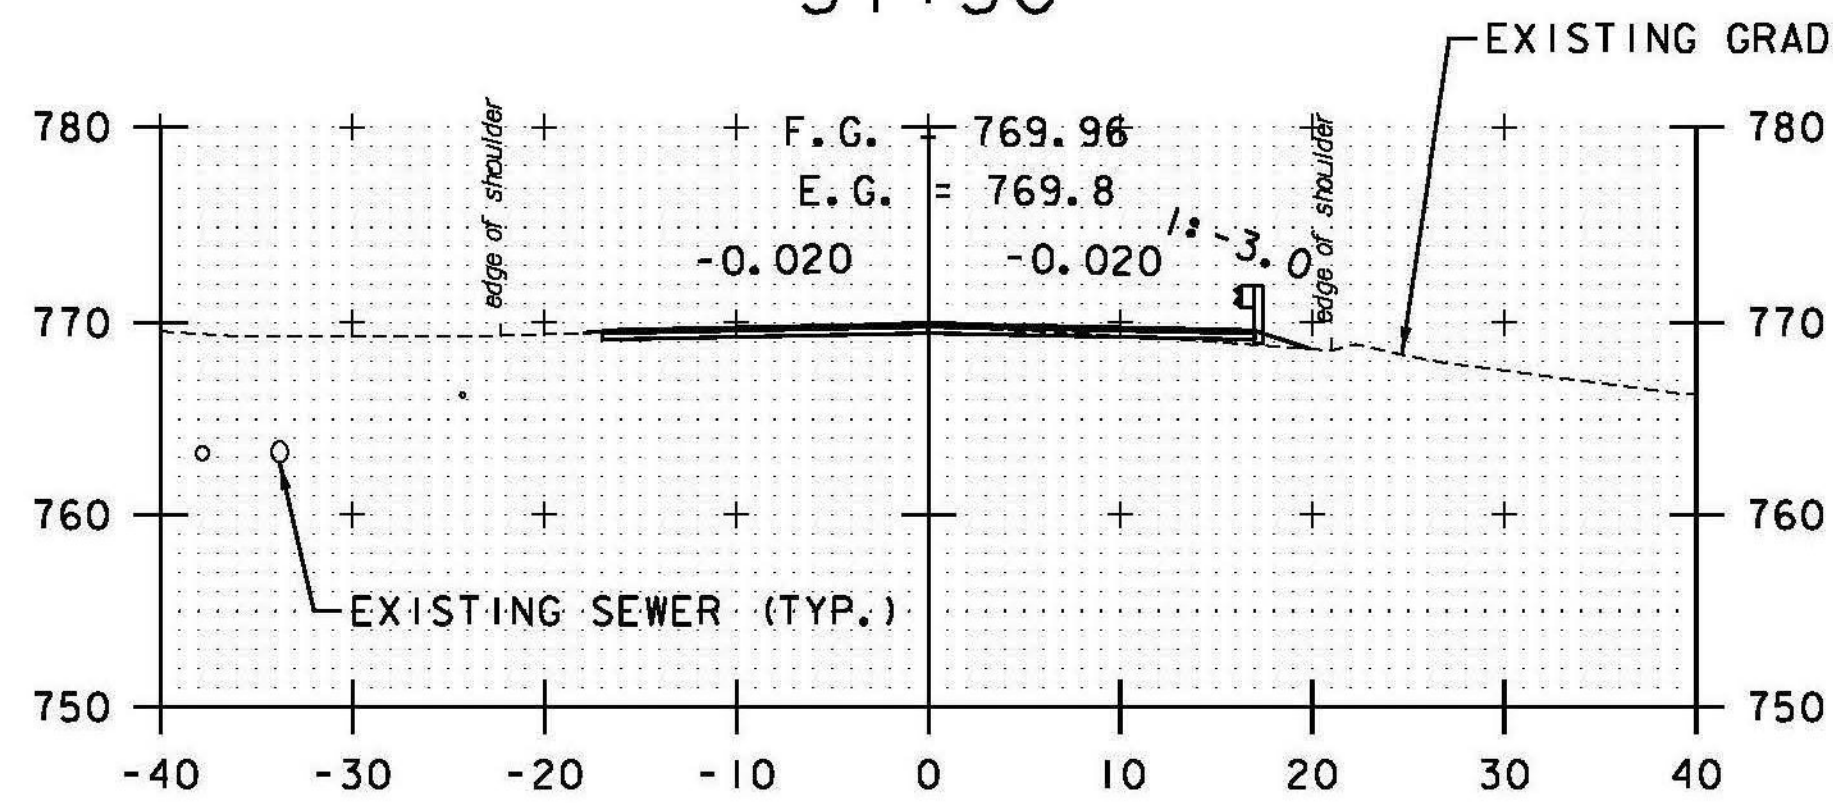


DRIVE LT
51+00

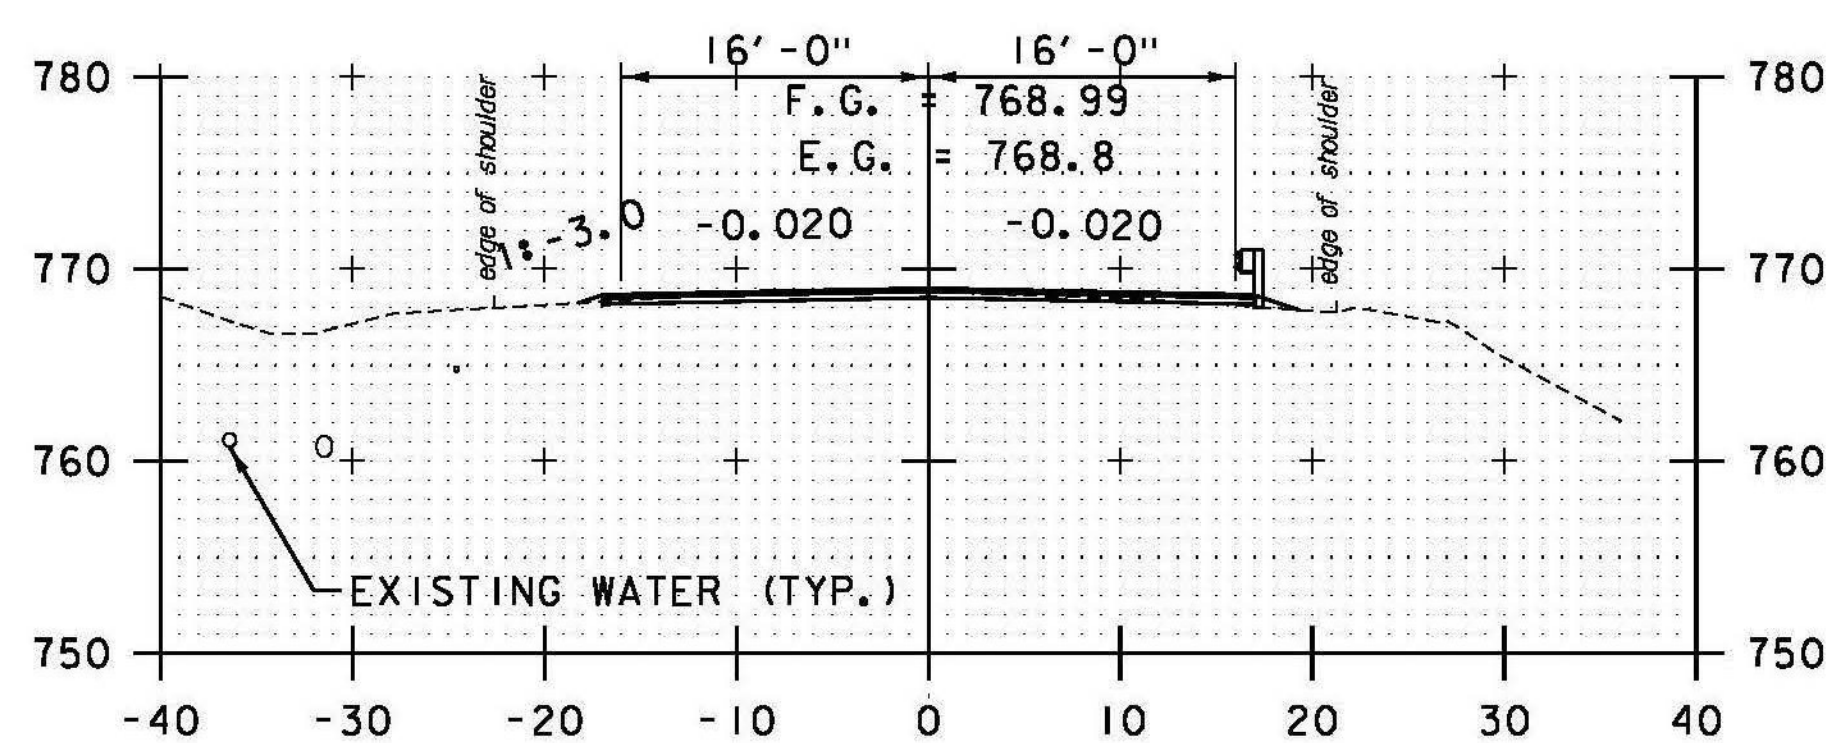


50+50

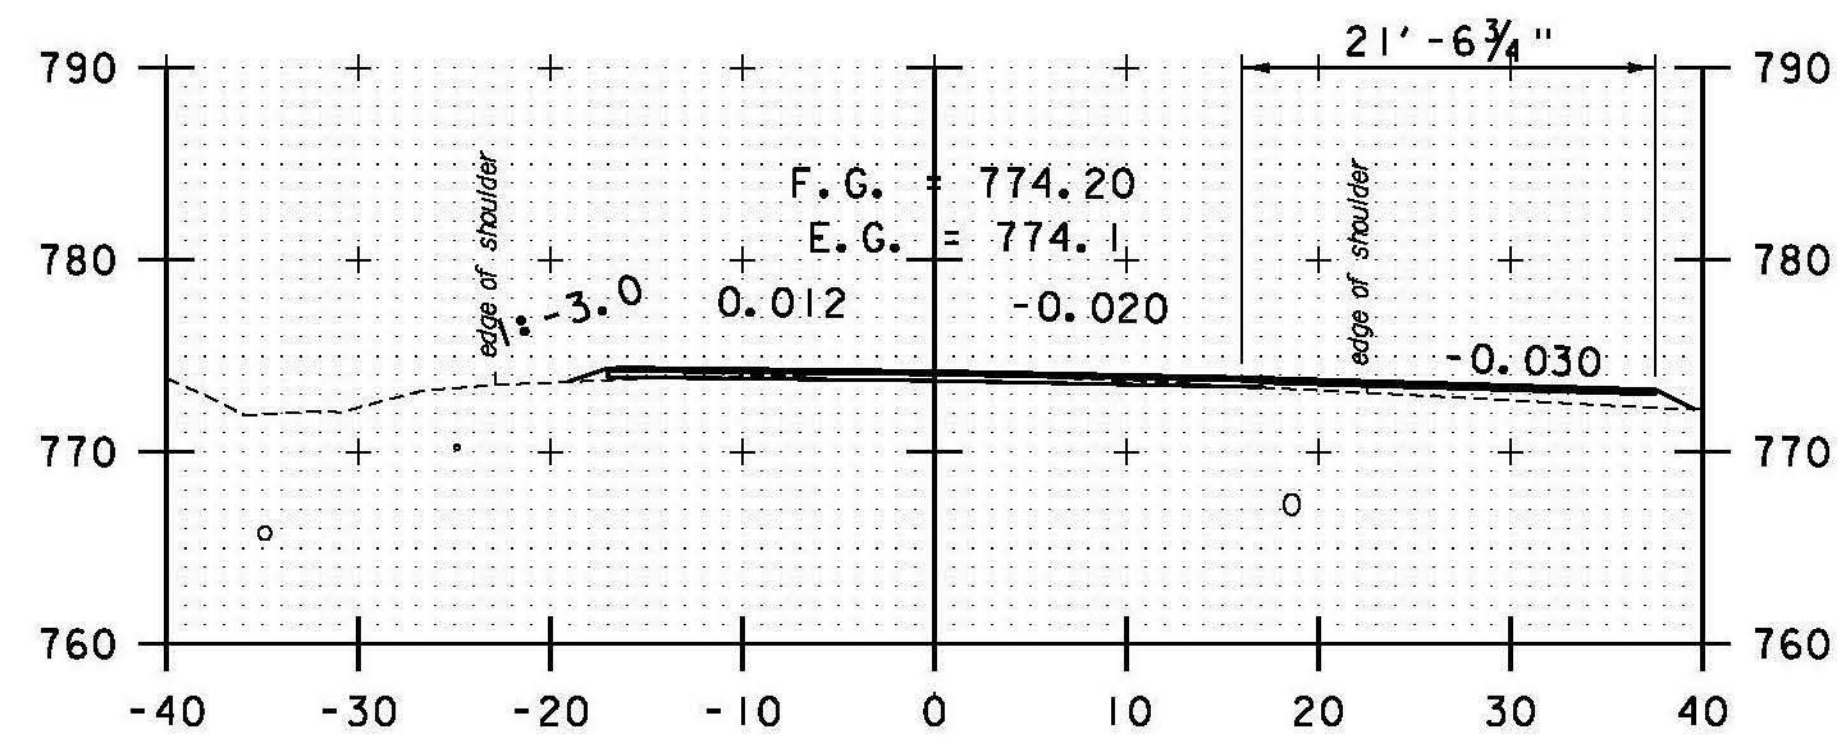


PULL OFF RT
53+00

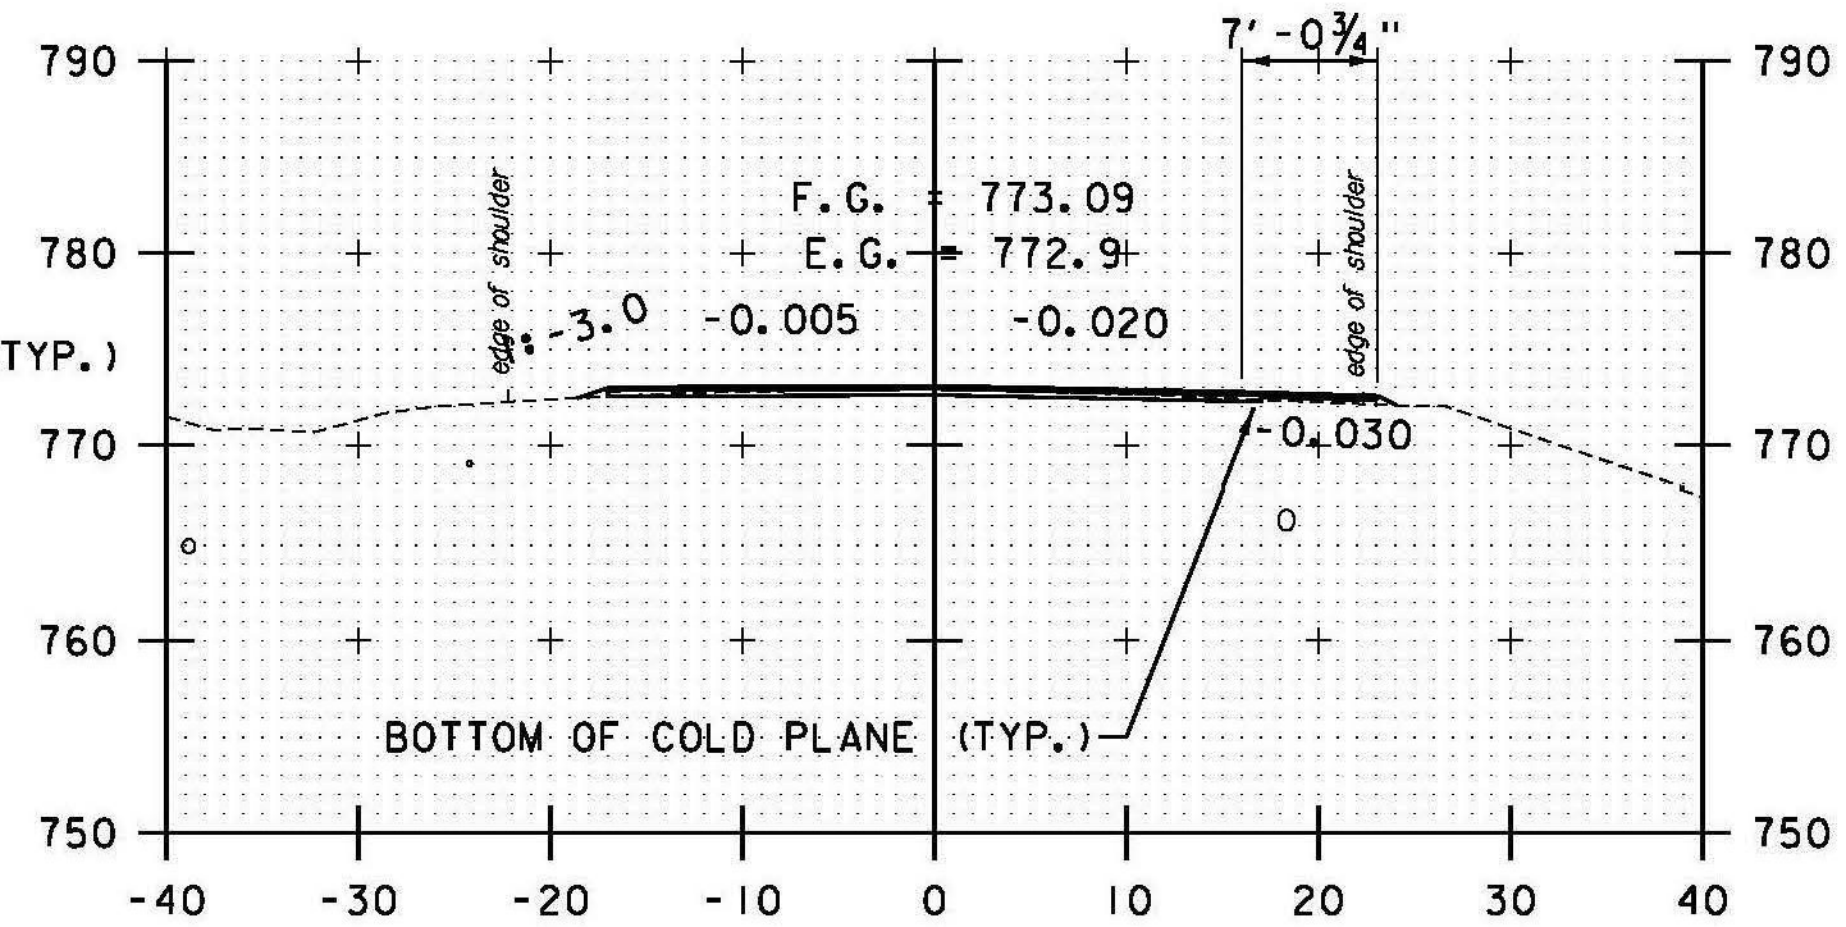


PULL OFF RT
52+50

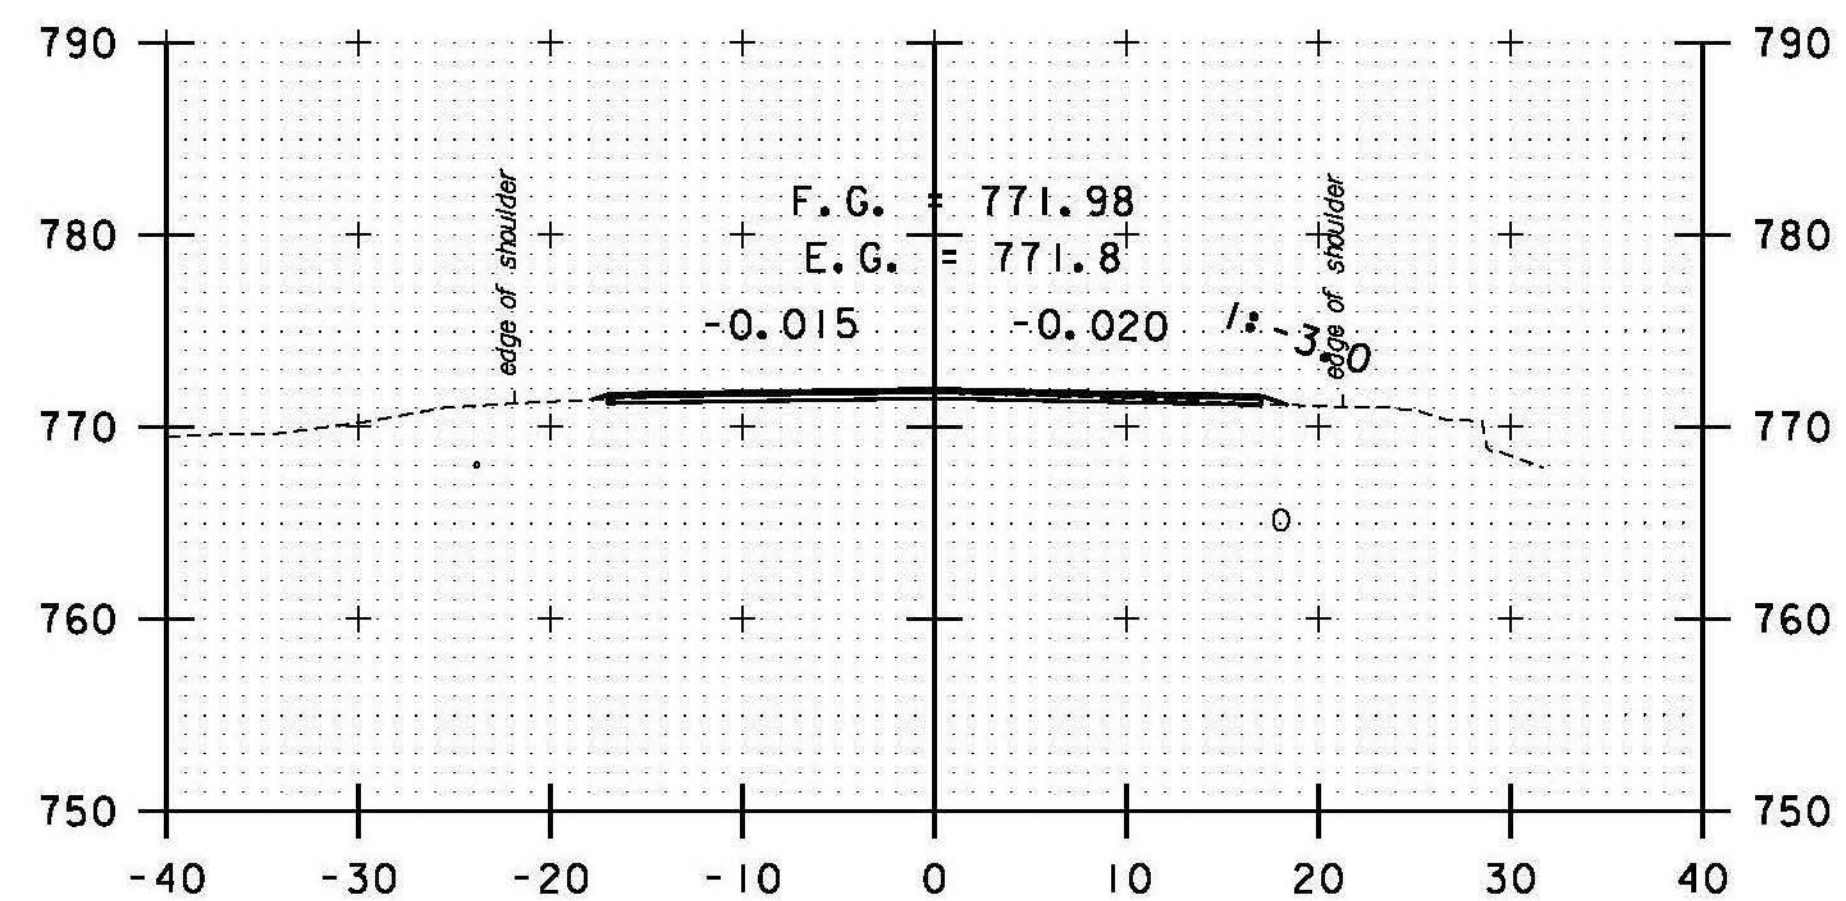


52+00

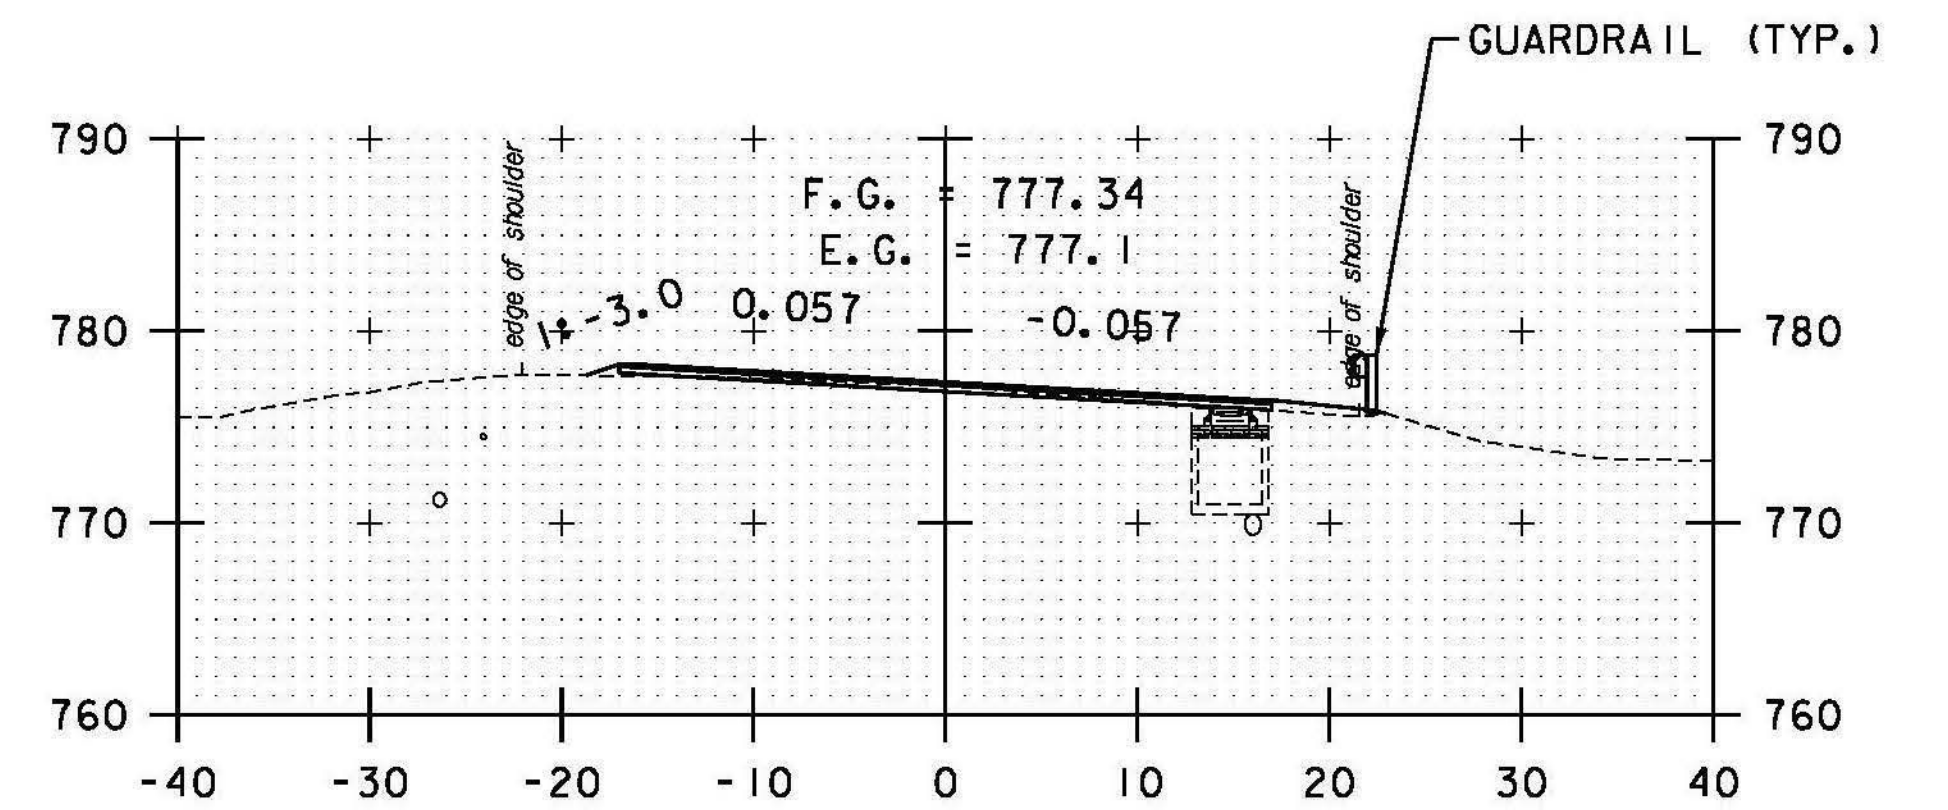

54+50

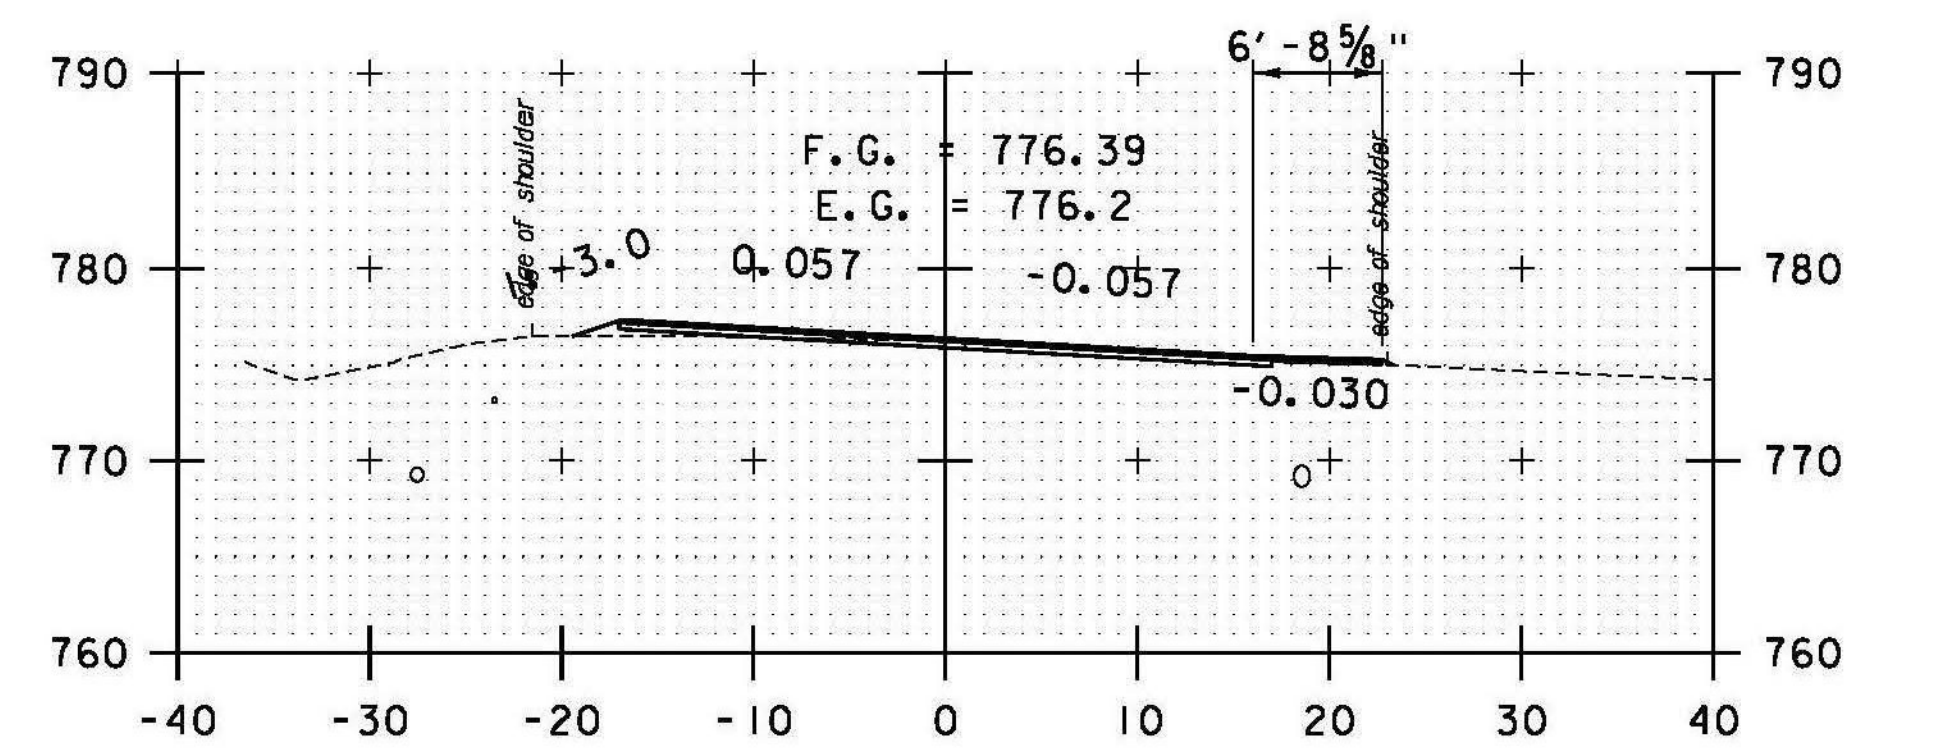


PULL OFF RT
54+00

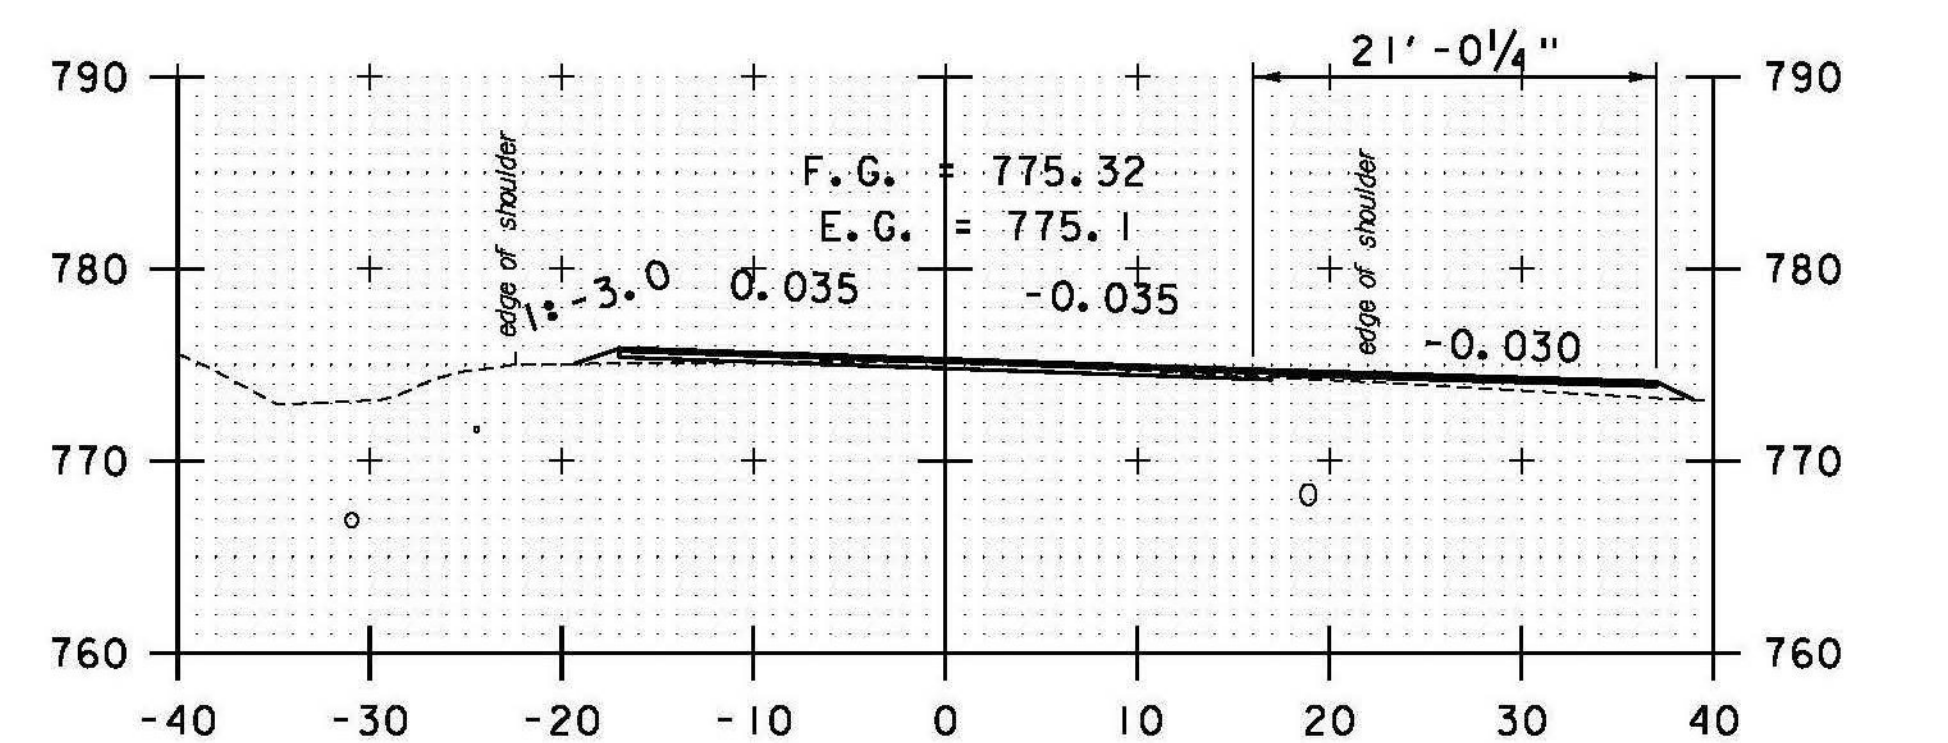

PULL OFF RT
53+50

STA. 50+50 TO STA. 54+50

DATUM
VERTICAL NAVD 88
HORIZONTAL NAD 83 (07)

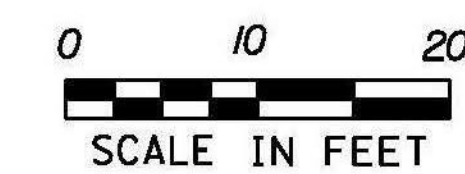

PROJECT NAME: RANDOLPH
PROJECT NUMBER: STP 2932 (1)

FILE NAME: z10c270.dgn
PROJECT LEADER: C. LATHROP
DESIGNED BY: B. BRESLEND
VT 66 CROSS SECTION SHEET 8

PLOT DATE: 6/5/2014
DRAWN BY: B. BRESLEND
CHECKED BY: C. LATHROP
SHEET 164 OF 276