




78+00

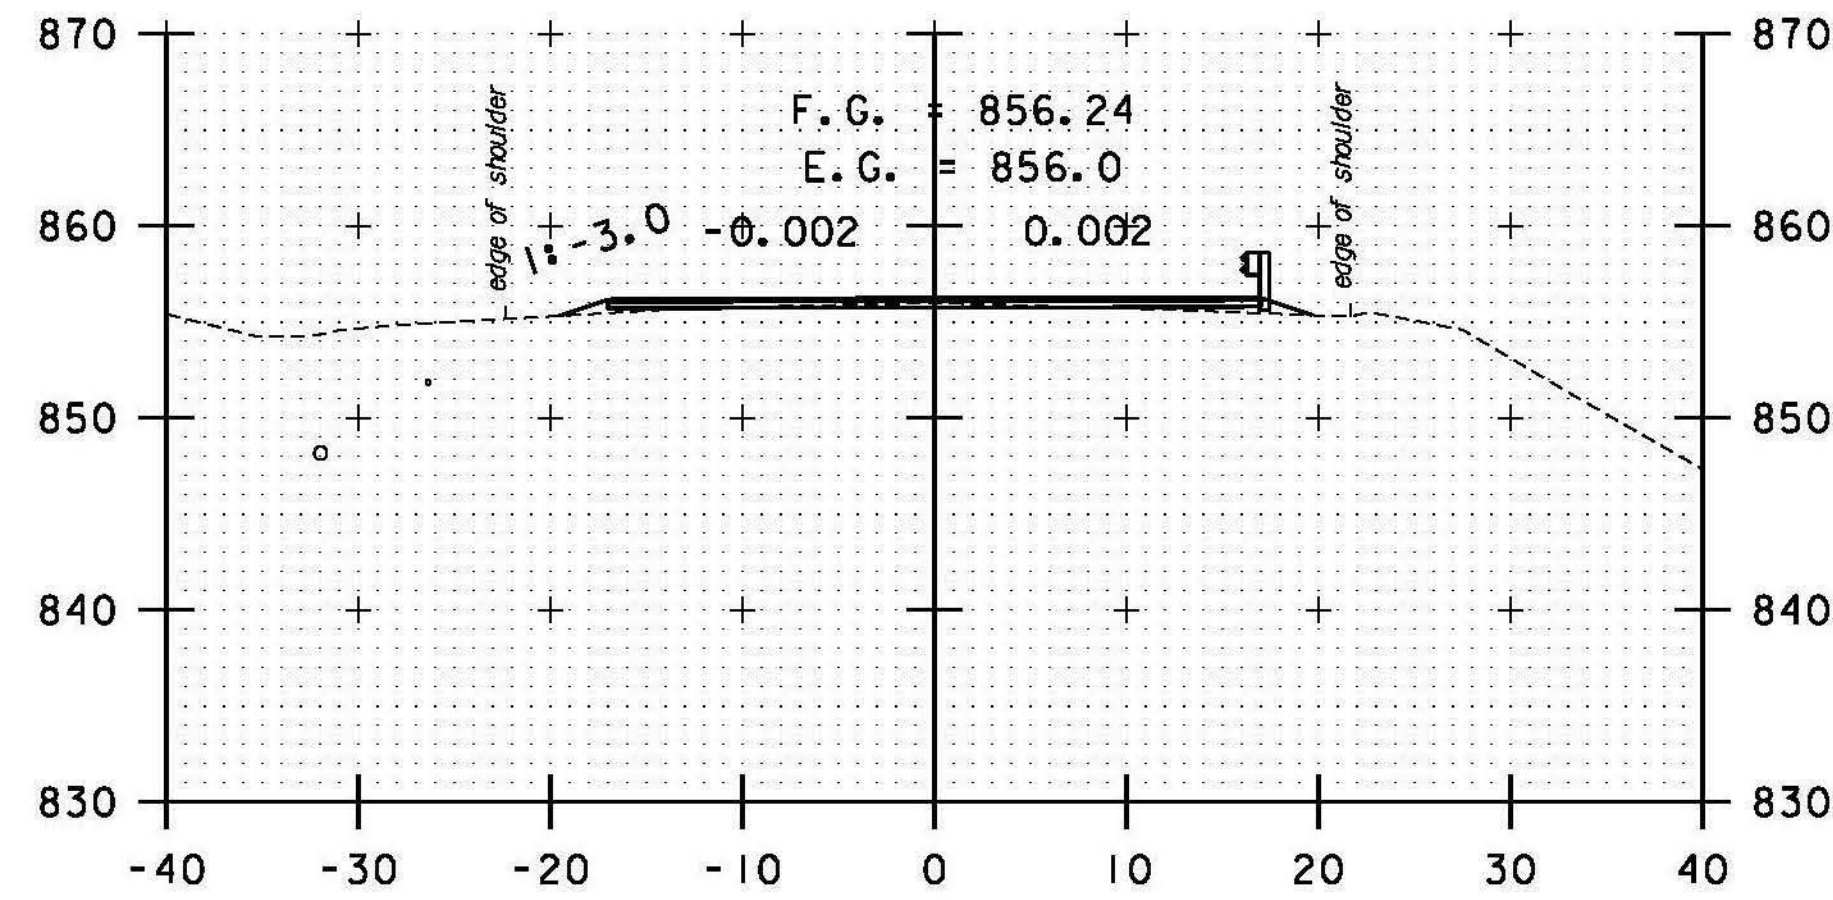


79+50

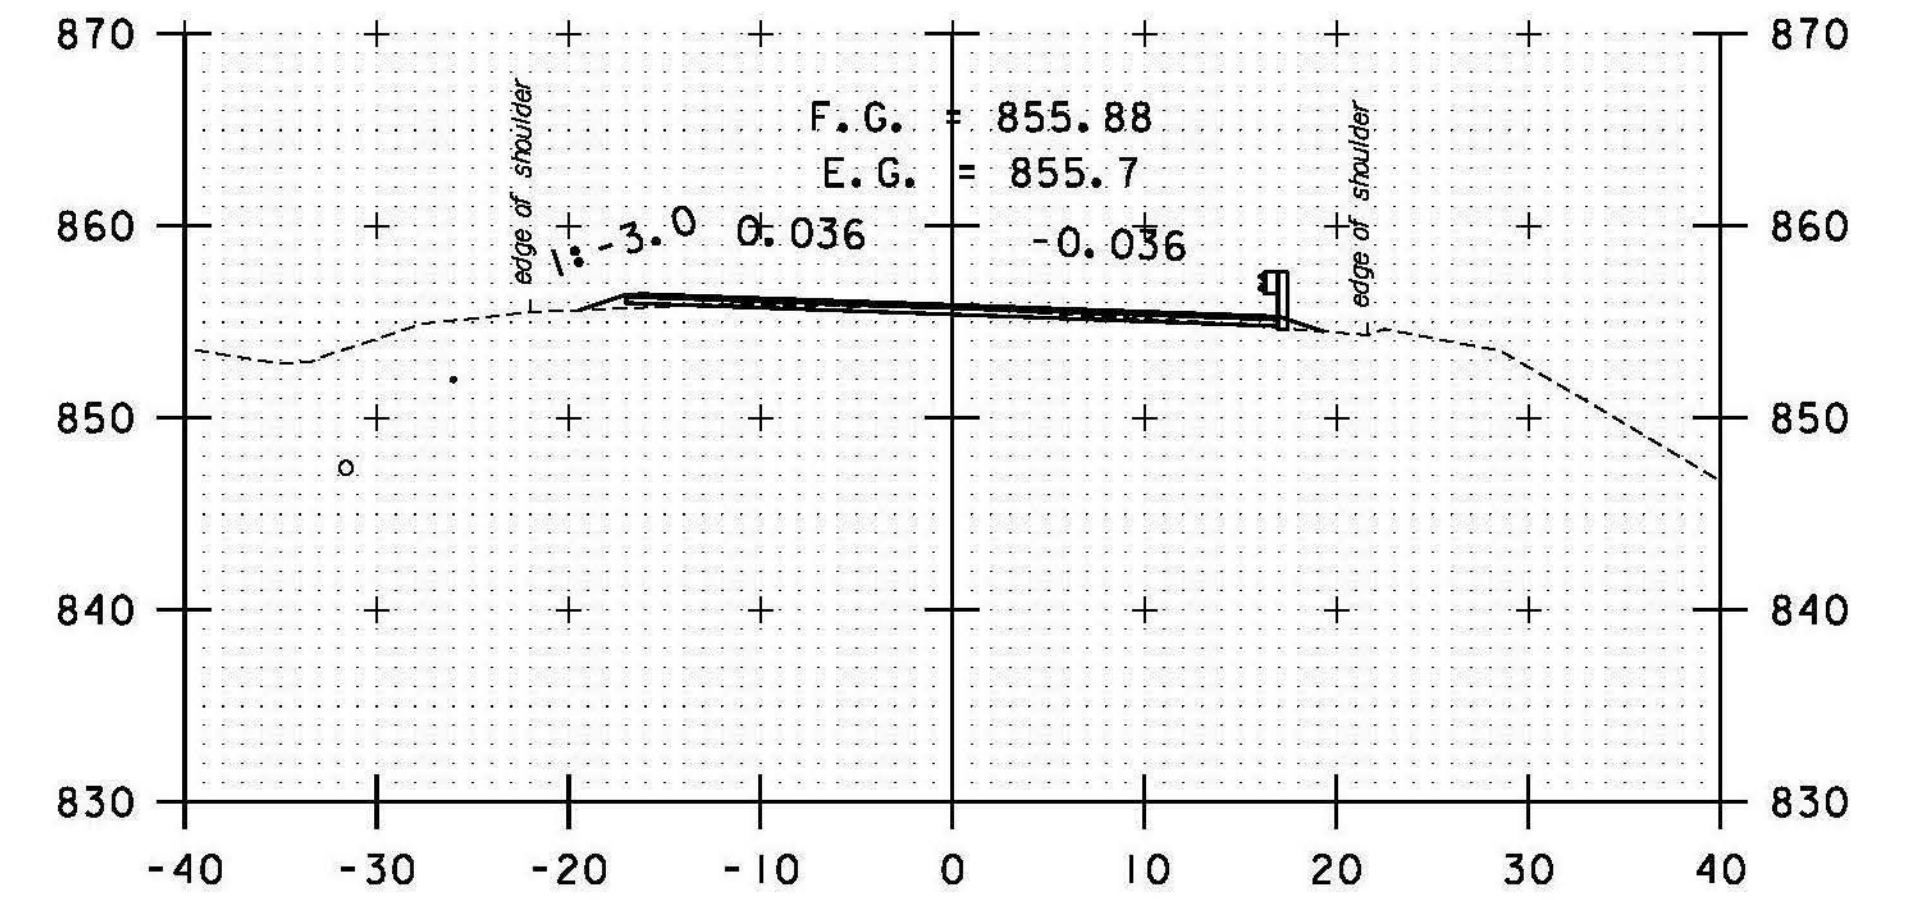


81+00

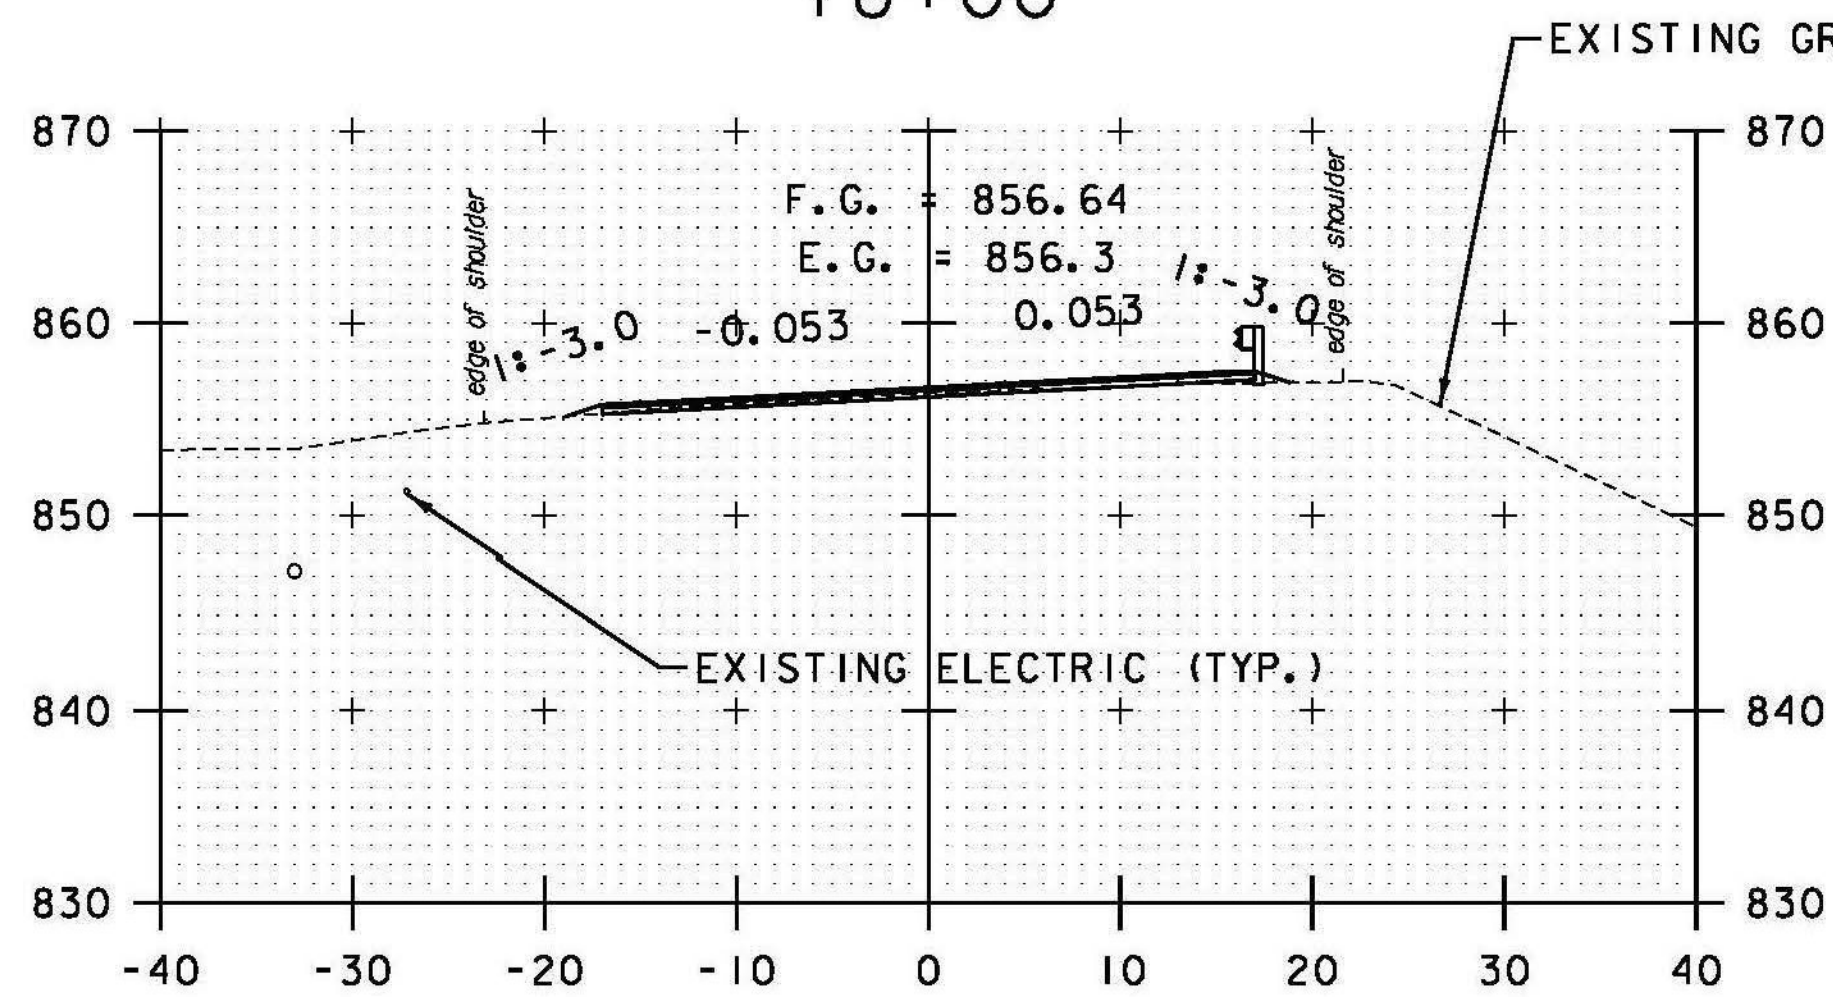


77+50

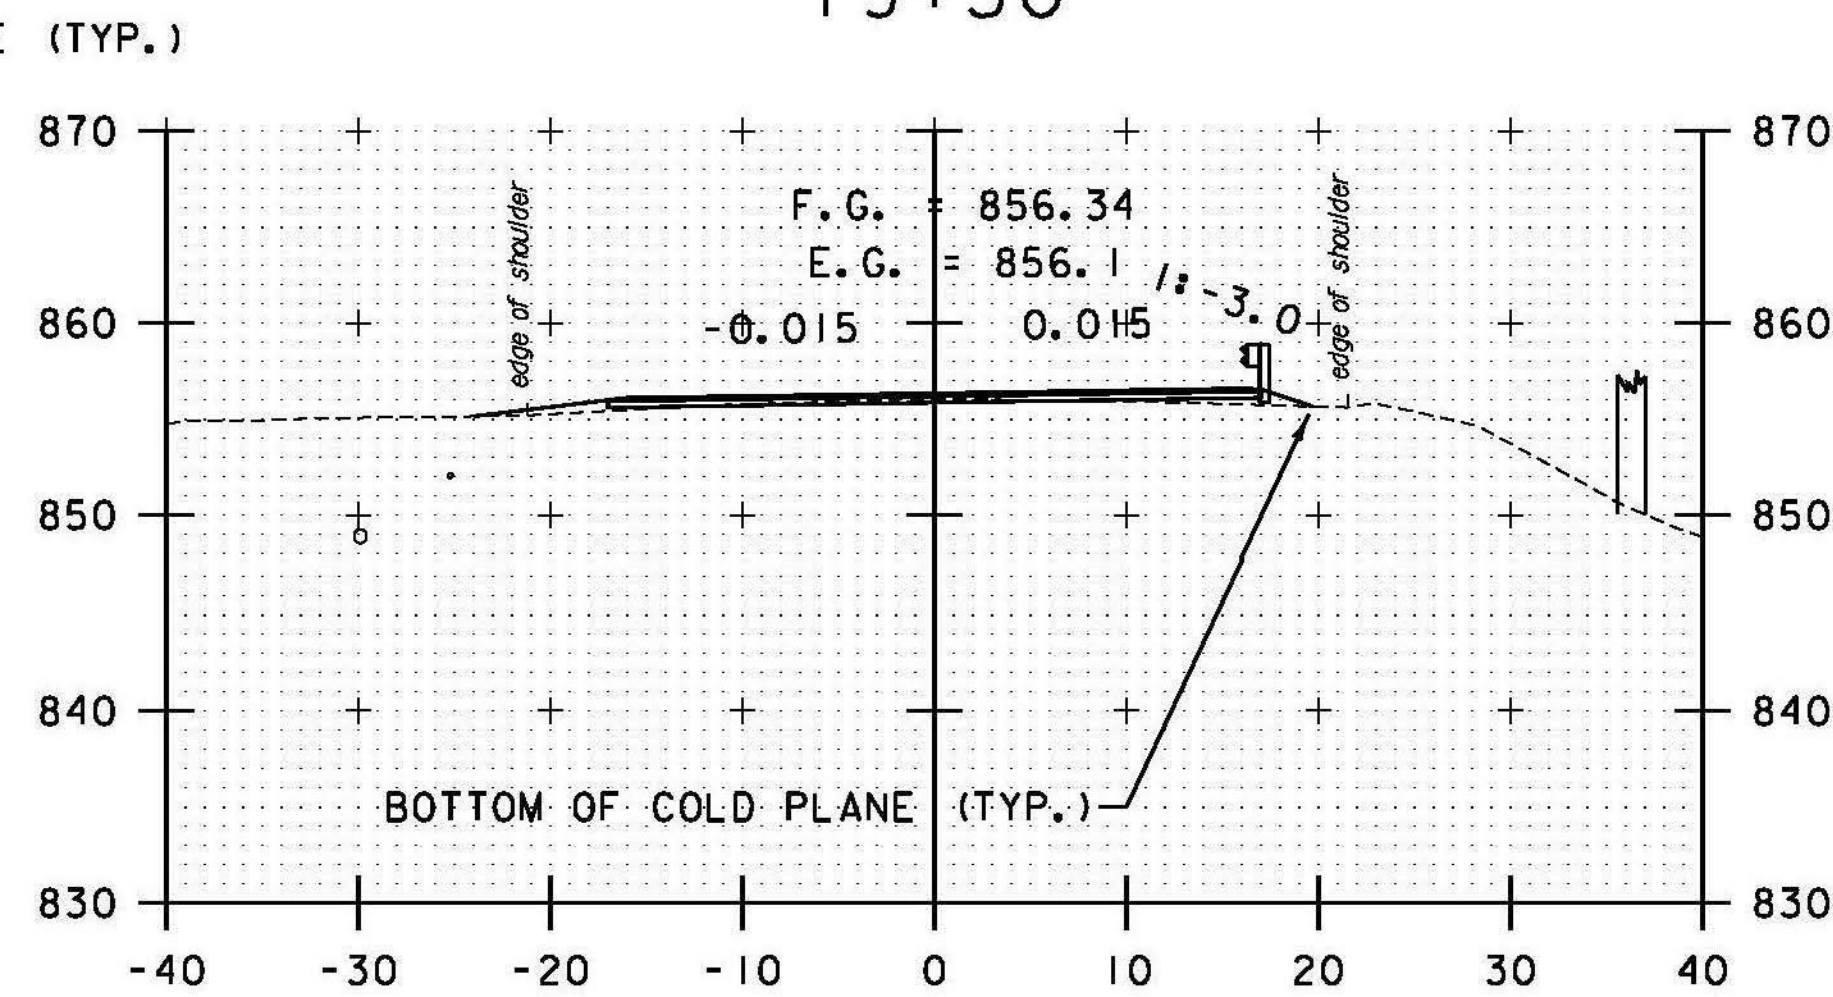


DRIVE LT  
79+00

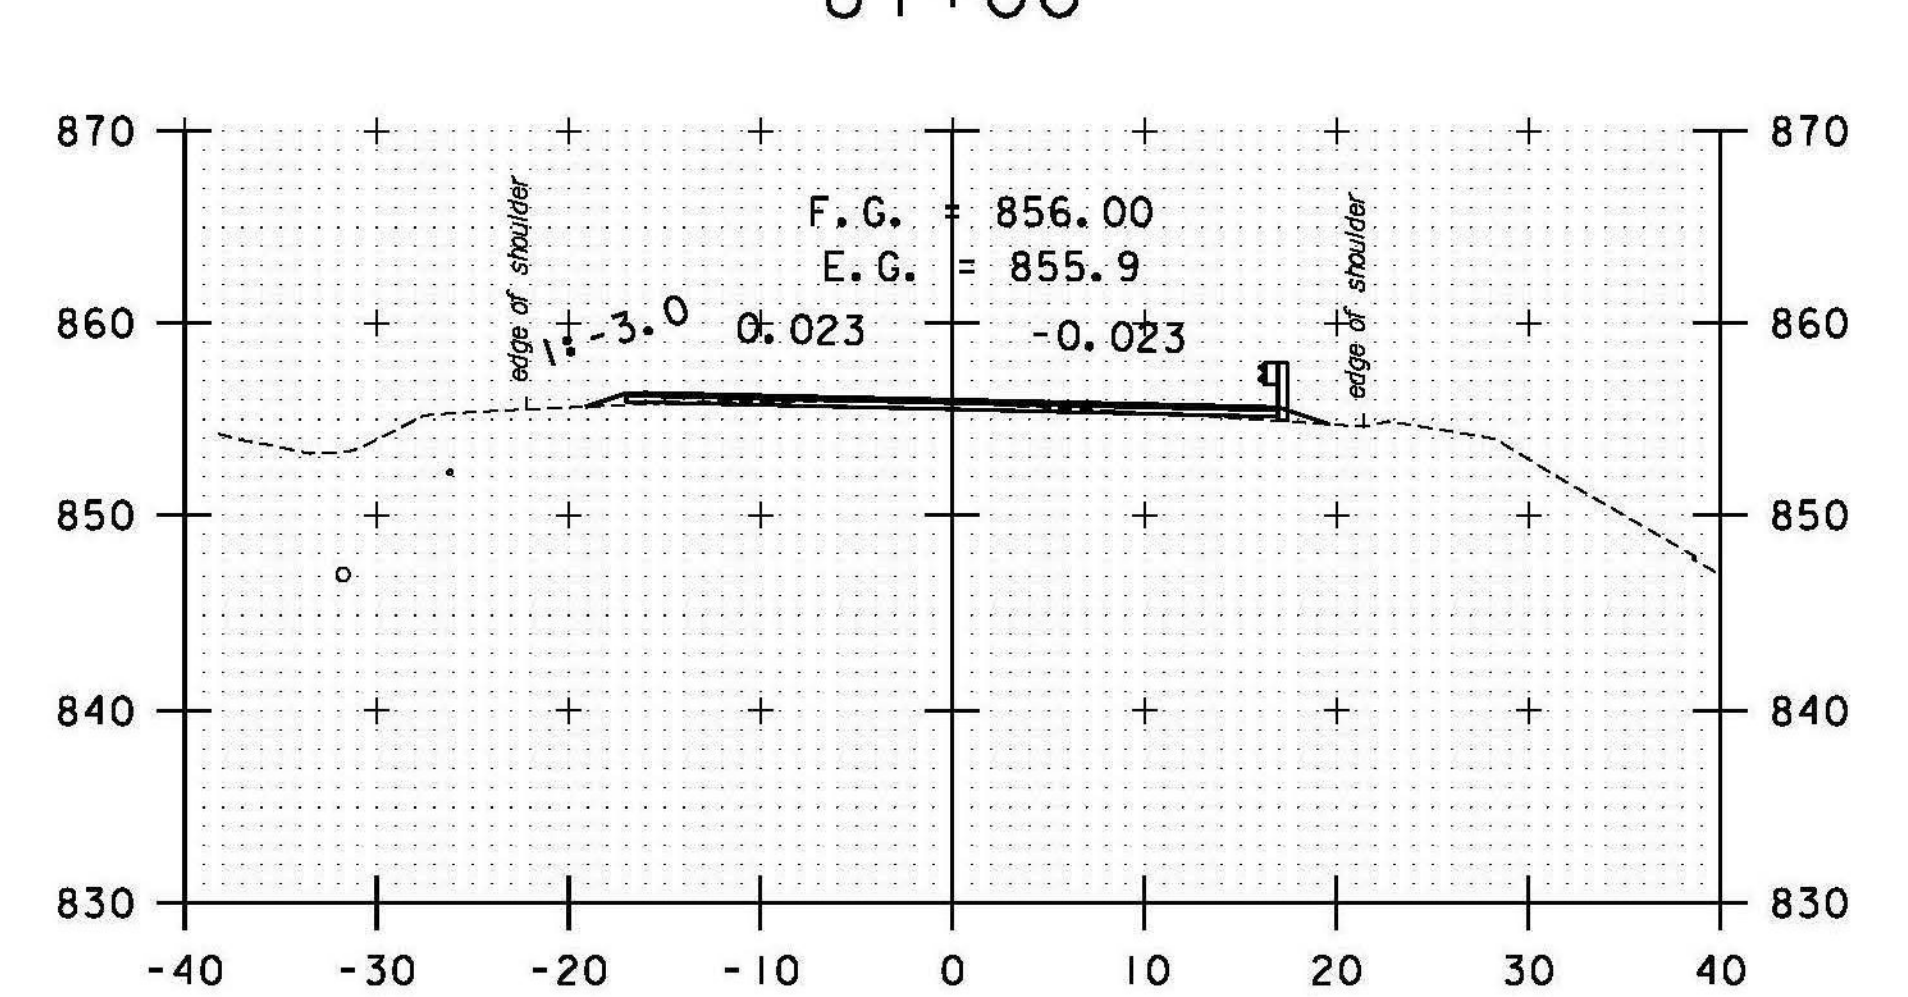


80+50

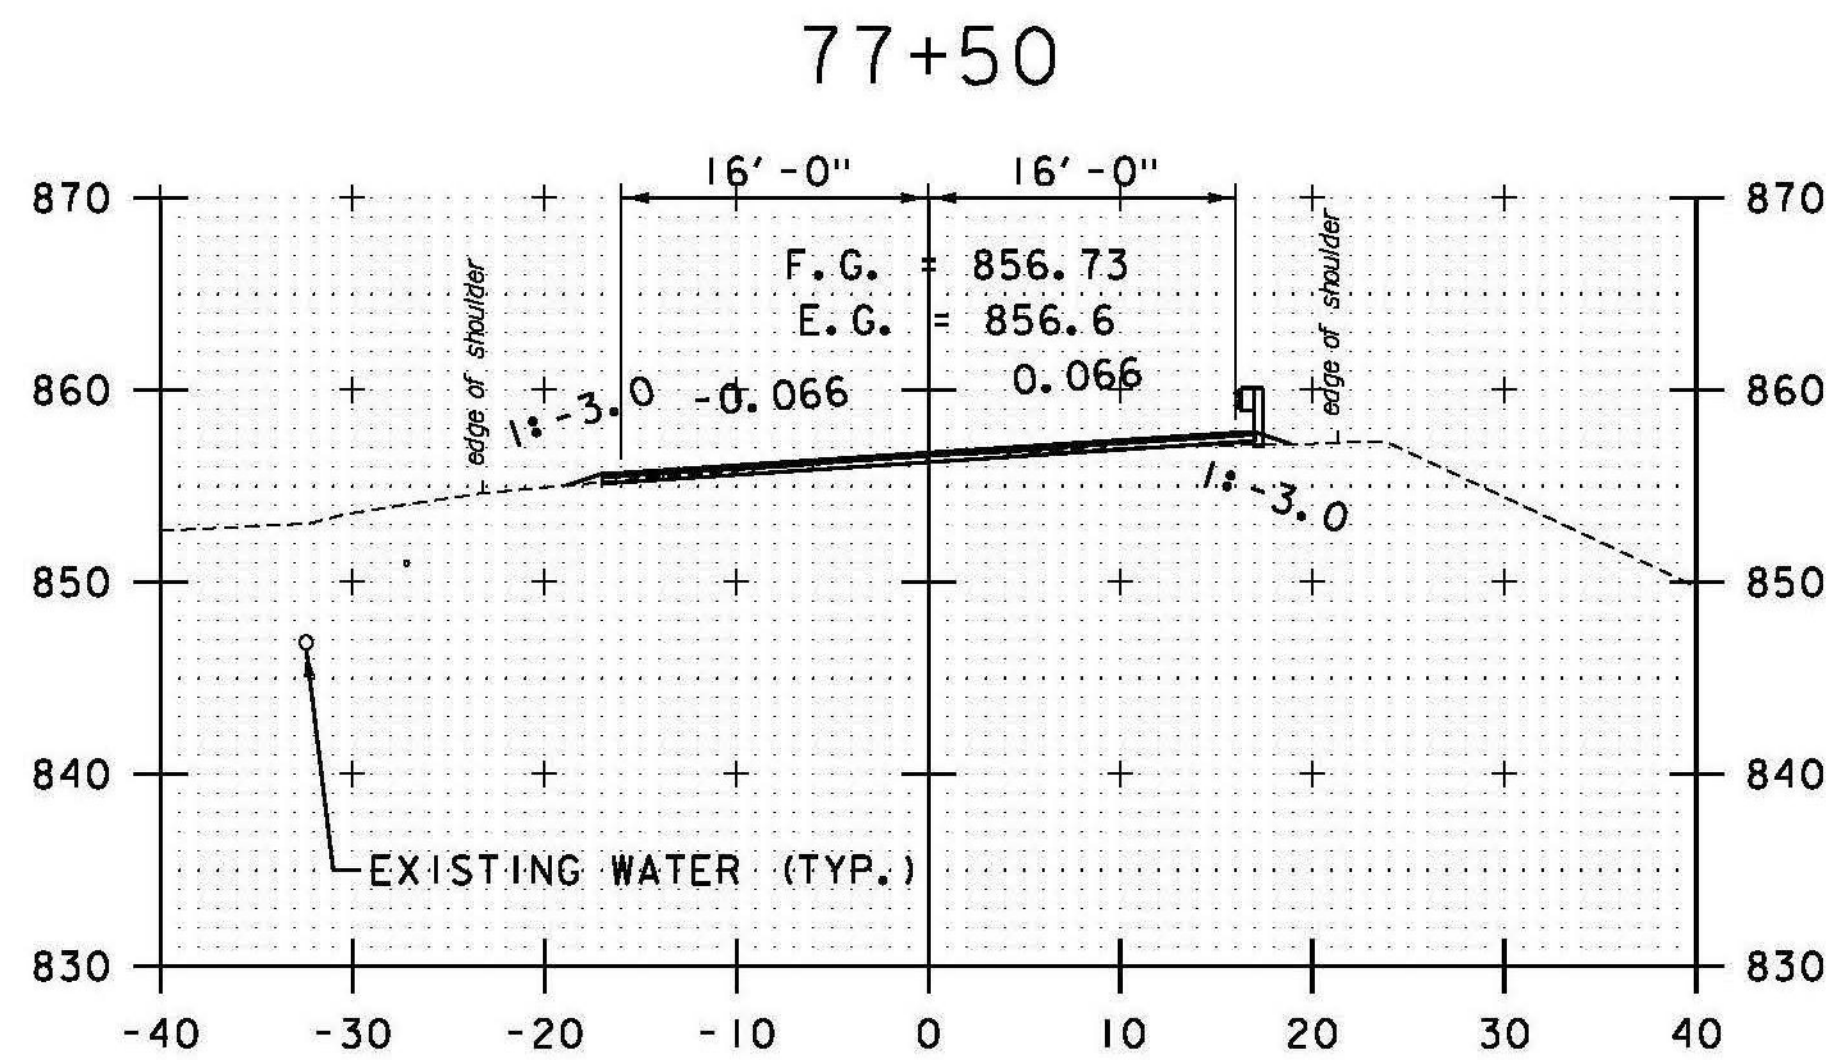

77+00

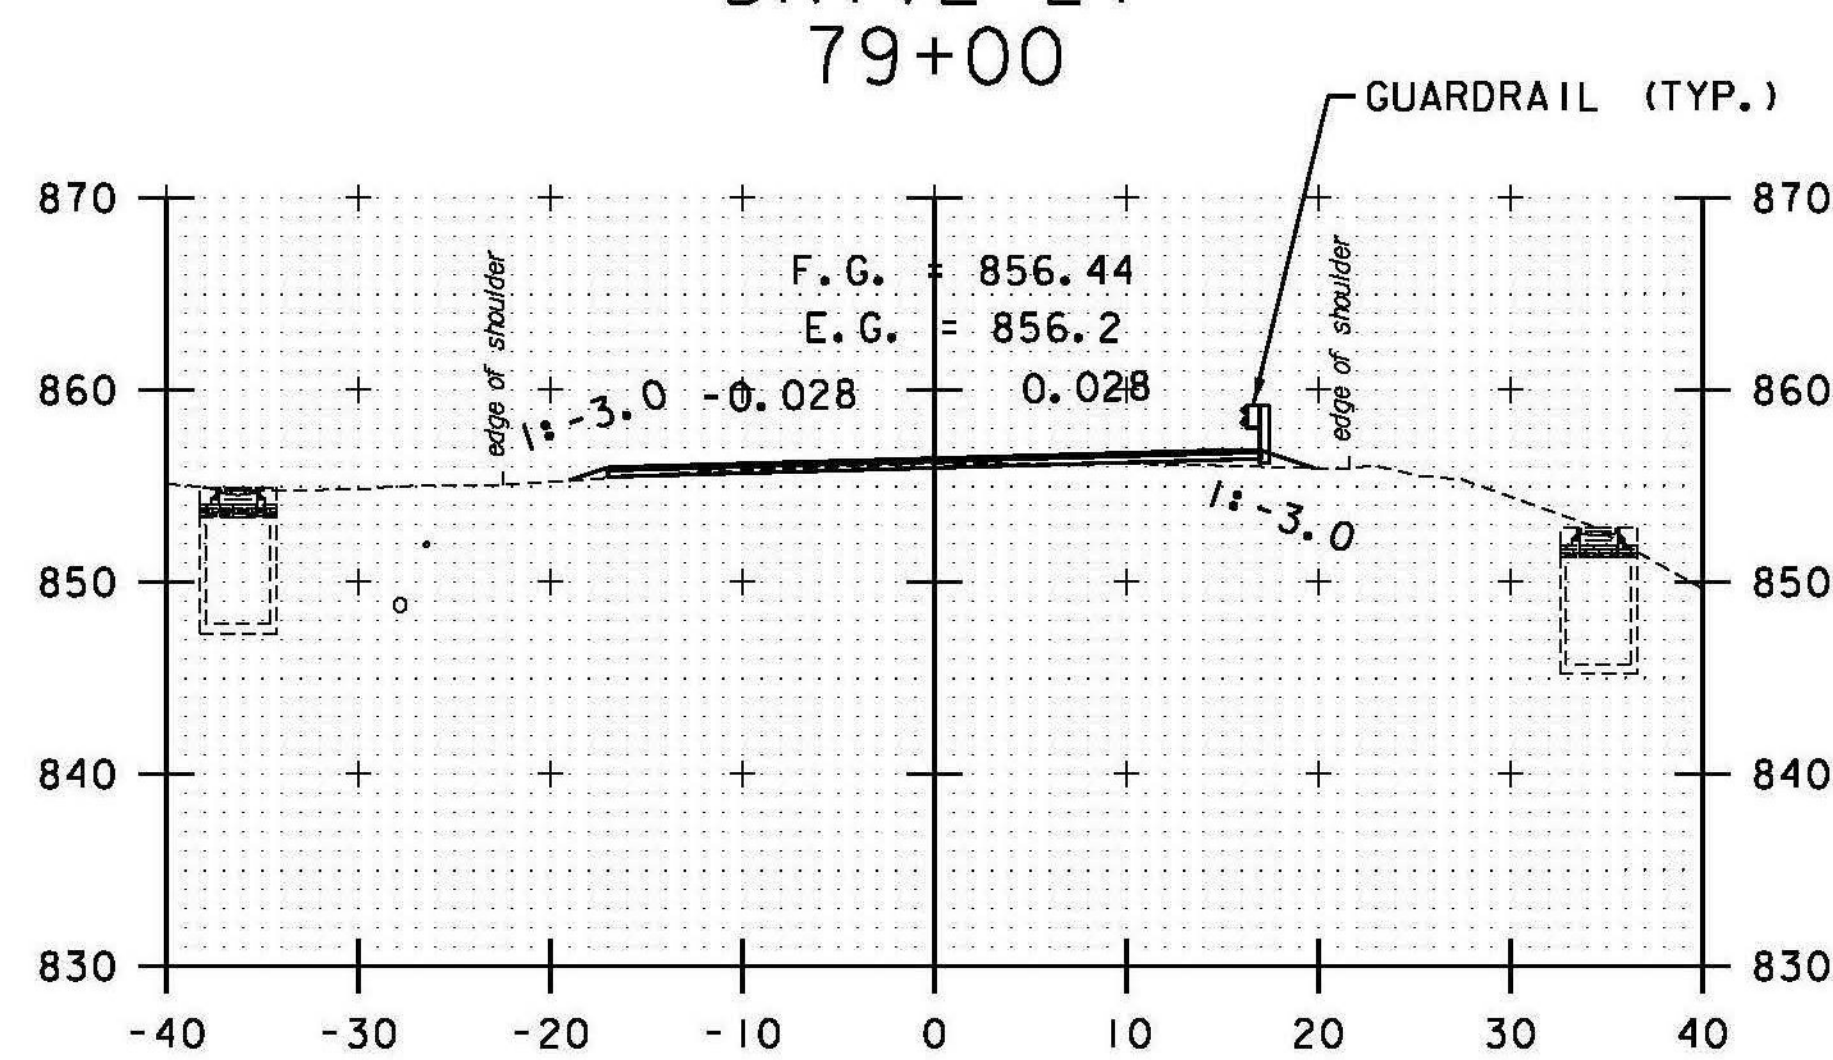


DRIVE LT  
78+50

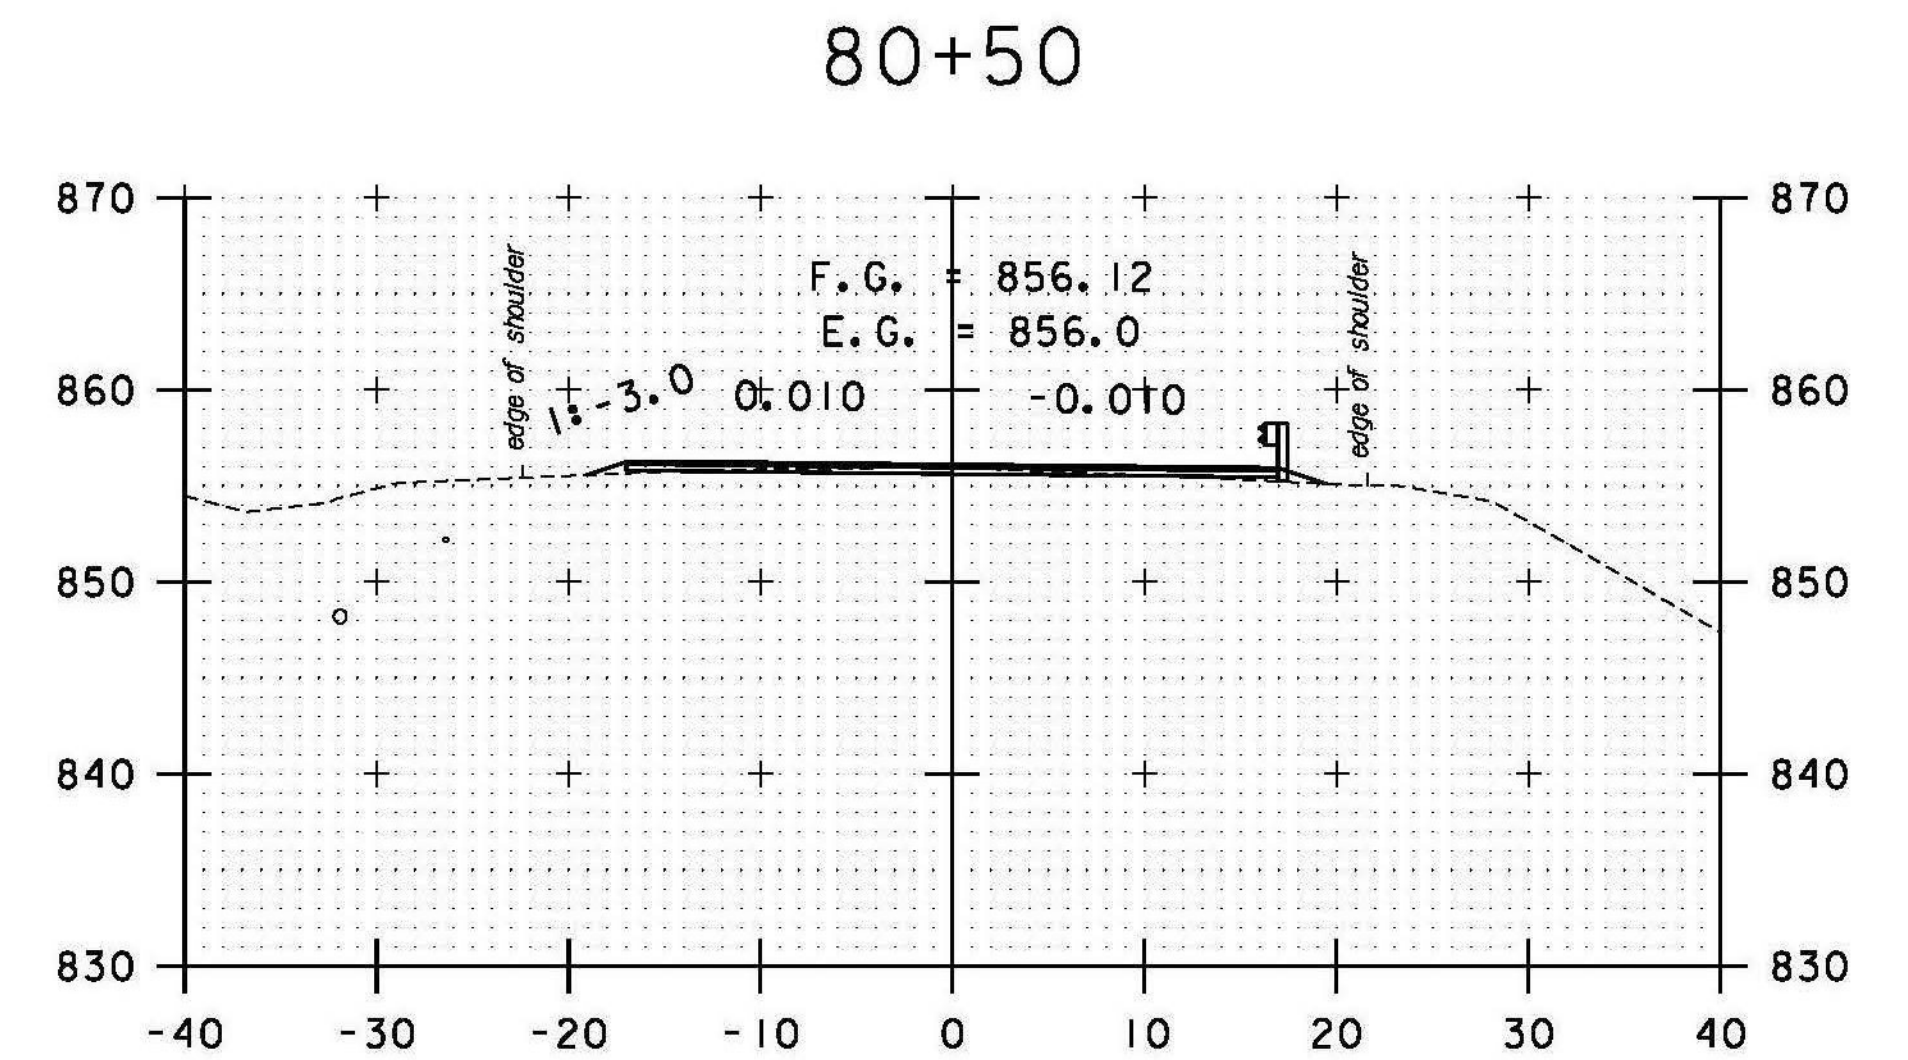

80+00

STA. 77+00 TO STA. 81+00

DATUM  
VERTICAL NAVD 88  
HORIZONTAL NAD 83 (07)

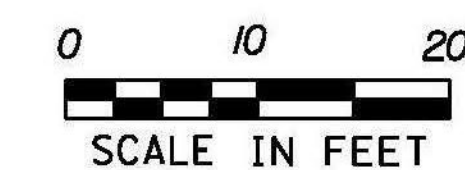

PROJECT NAME: RANDOLPH  
PROJECT NUMBER: STP 2932 (1)

FILE NAME: z10c270.dgn  
PROJECT LEADER: C. LATHROP  
DESIGNED BY: B. BRESLEND  
VT 66 CROSS SECTION SHEET 14

PLOT DATE: 6/5/2014  
DRAWN BY: B. BRESLEND  
CHECKED BY: C. LATHROP  
SHEET 170 OF 276