




82+50

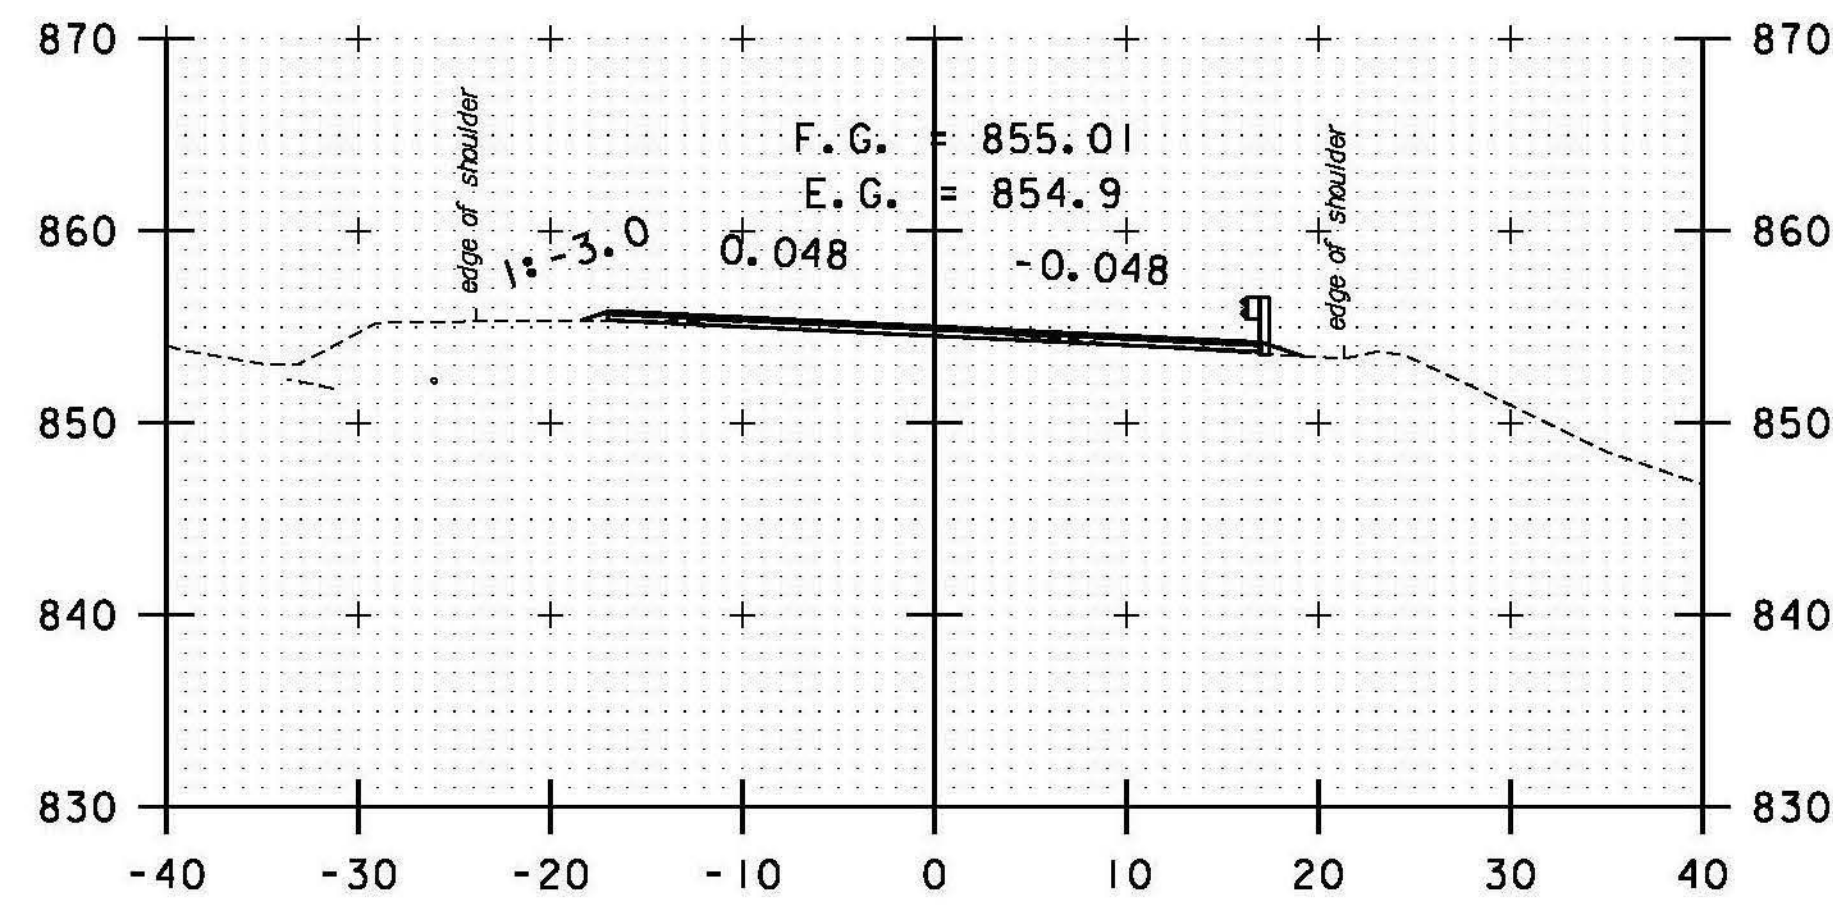


DRIVE LT
84+00

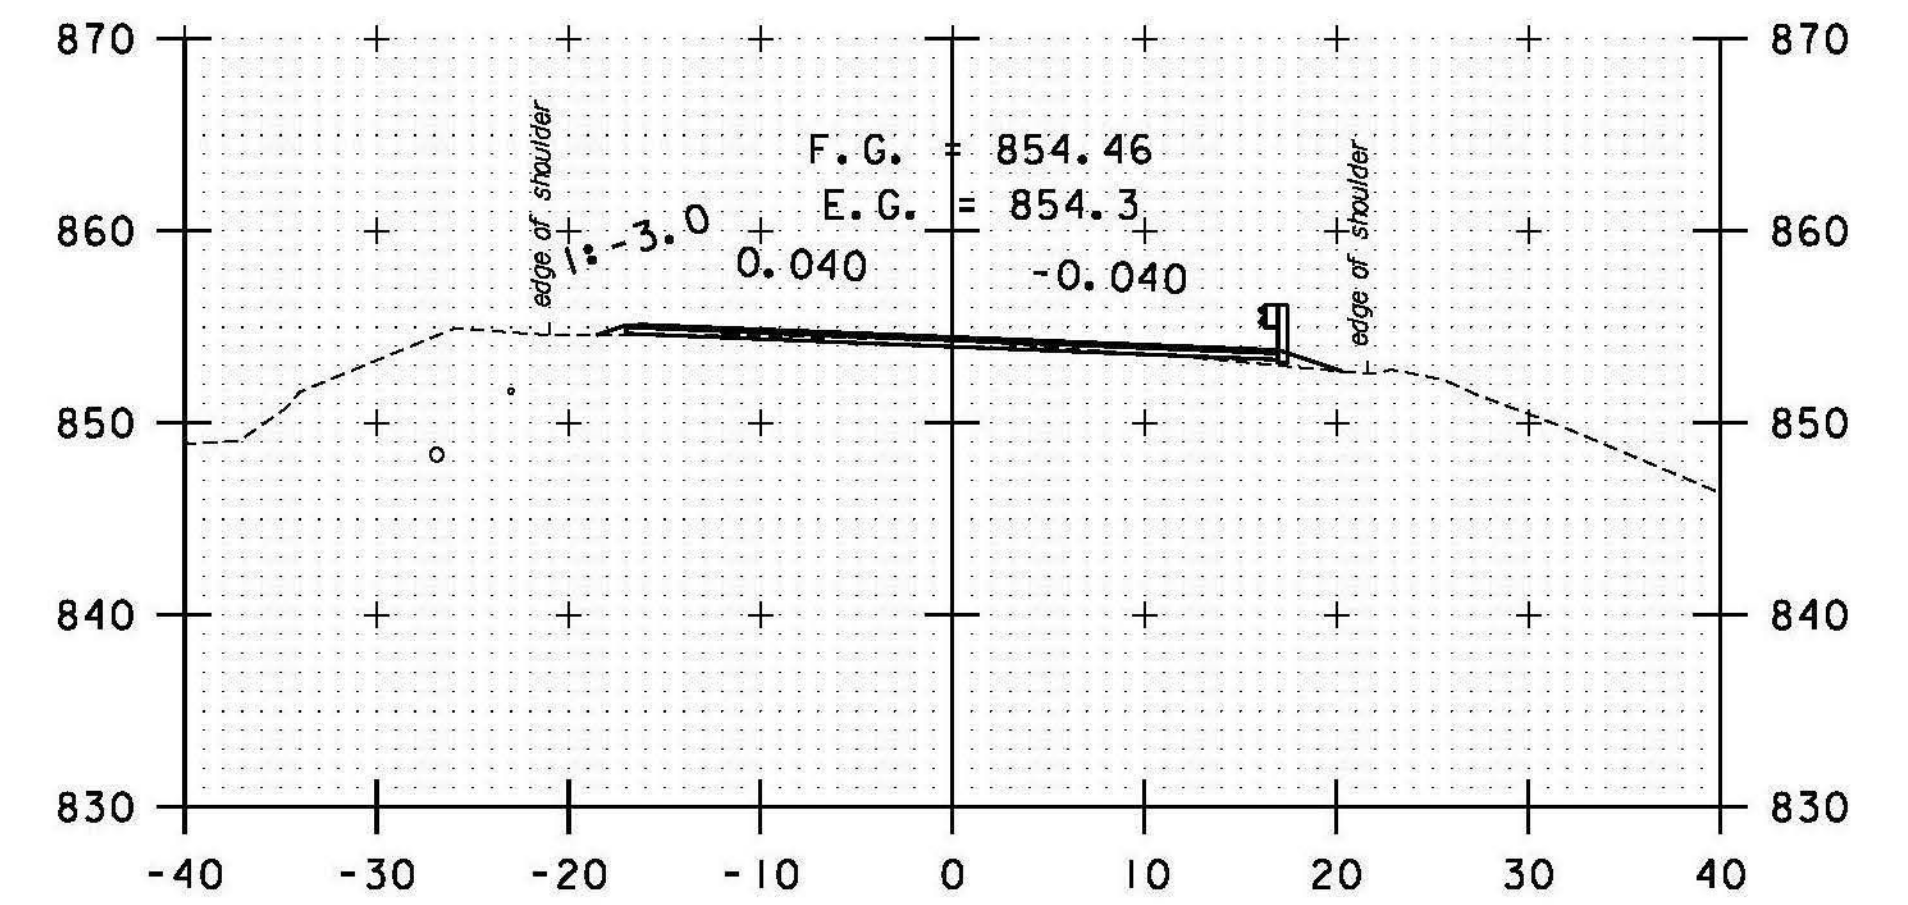


85+50

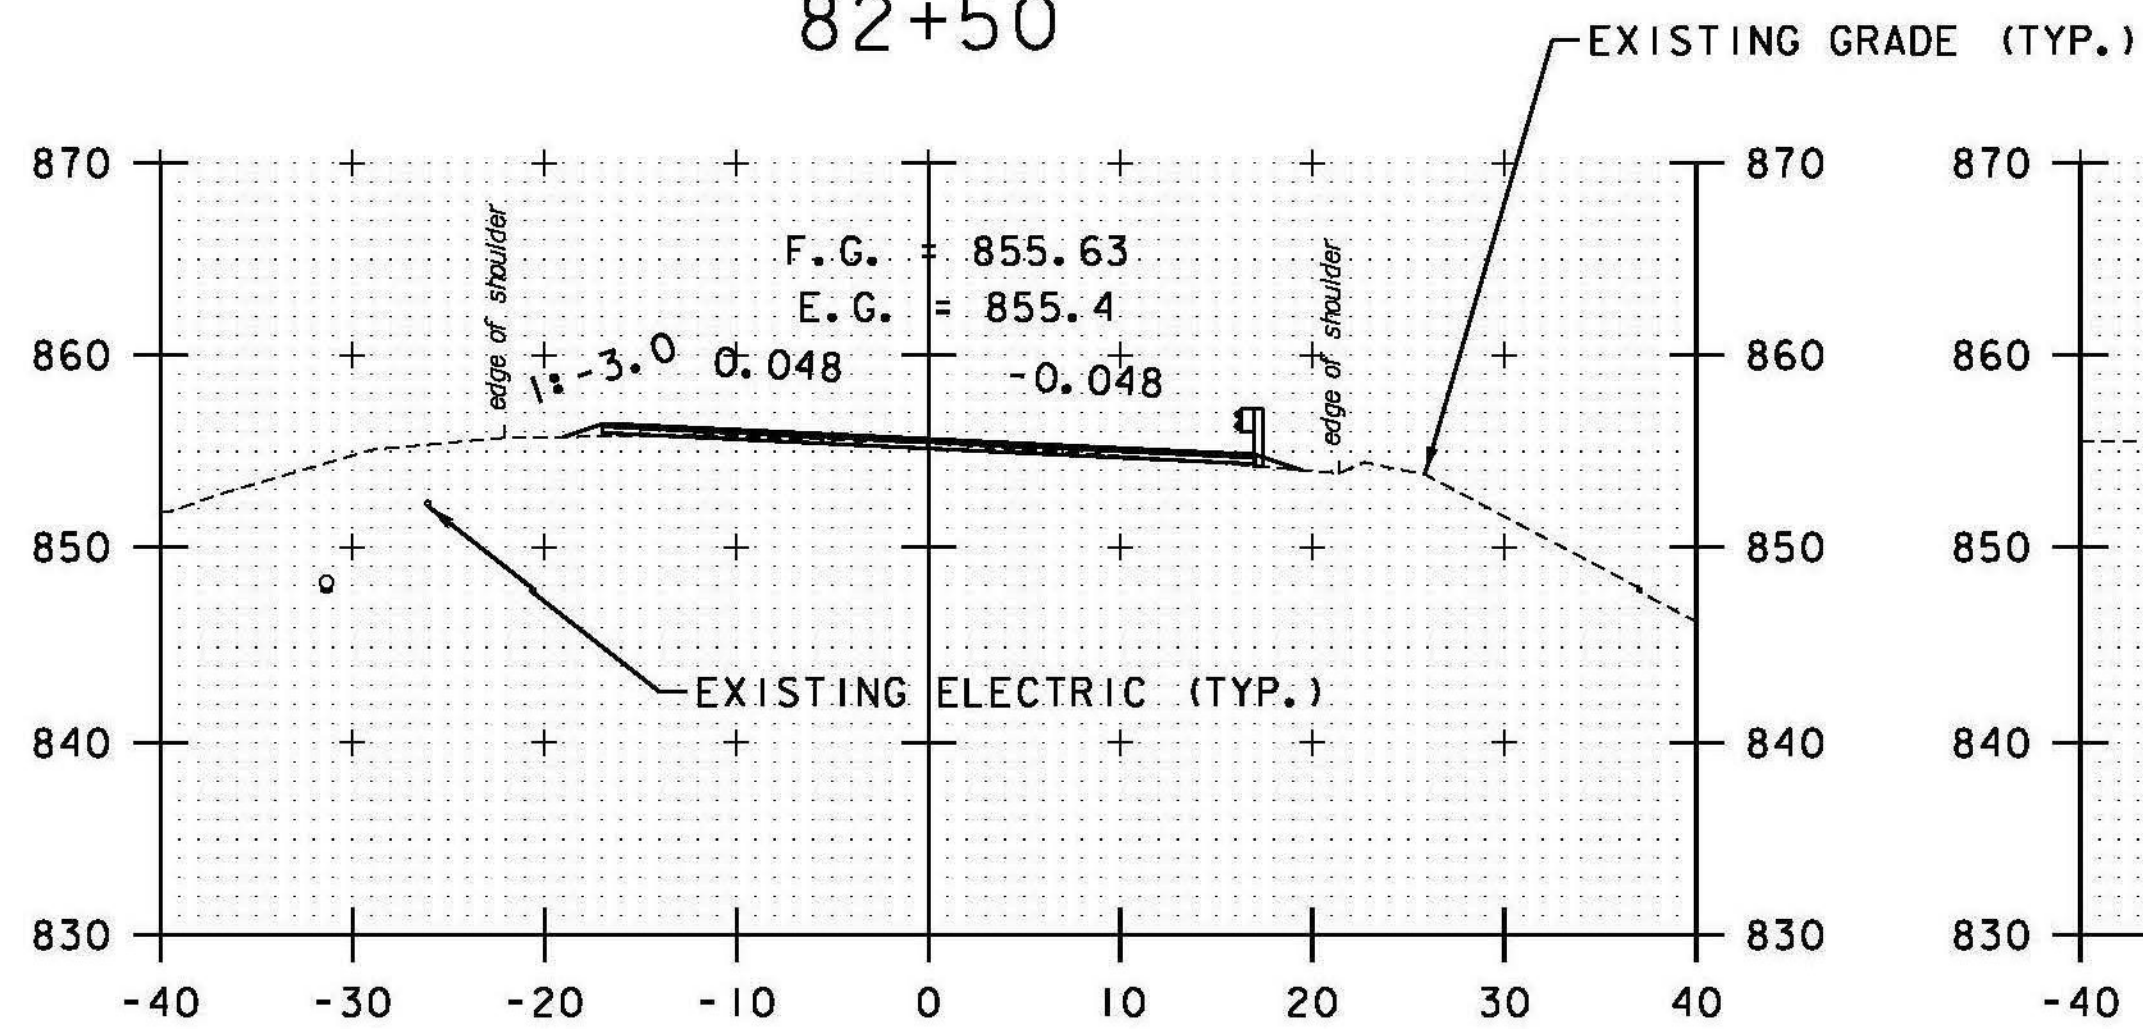


82+00

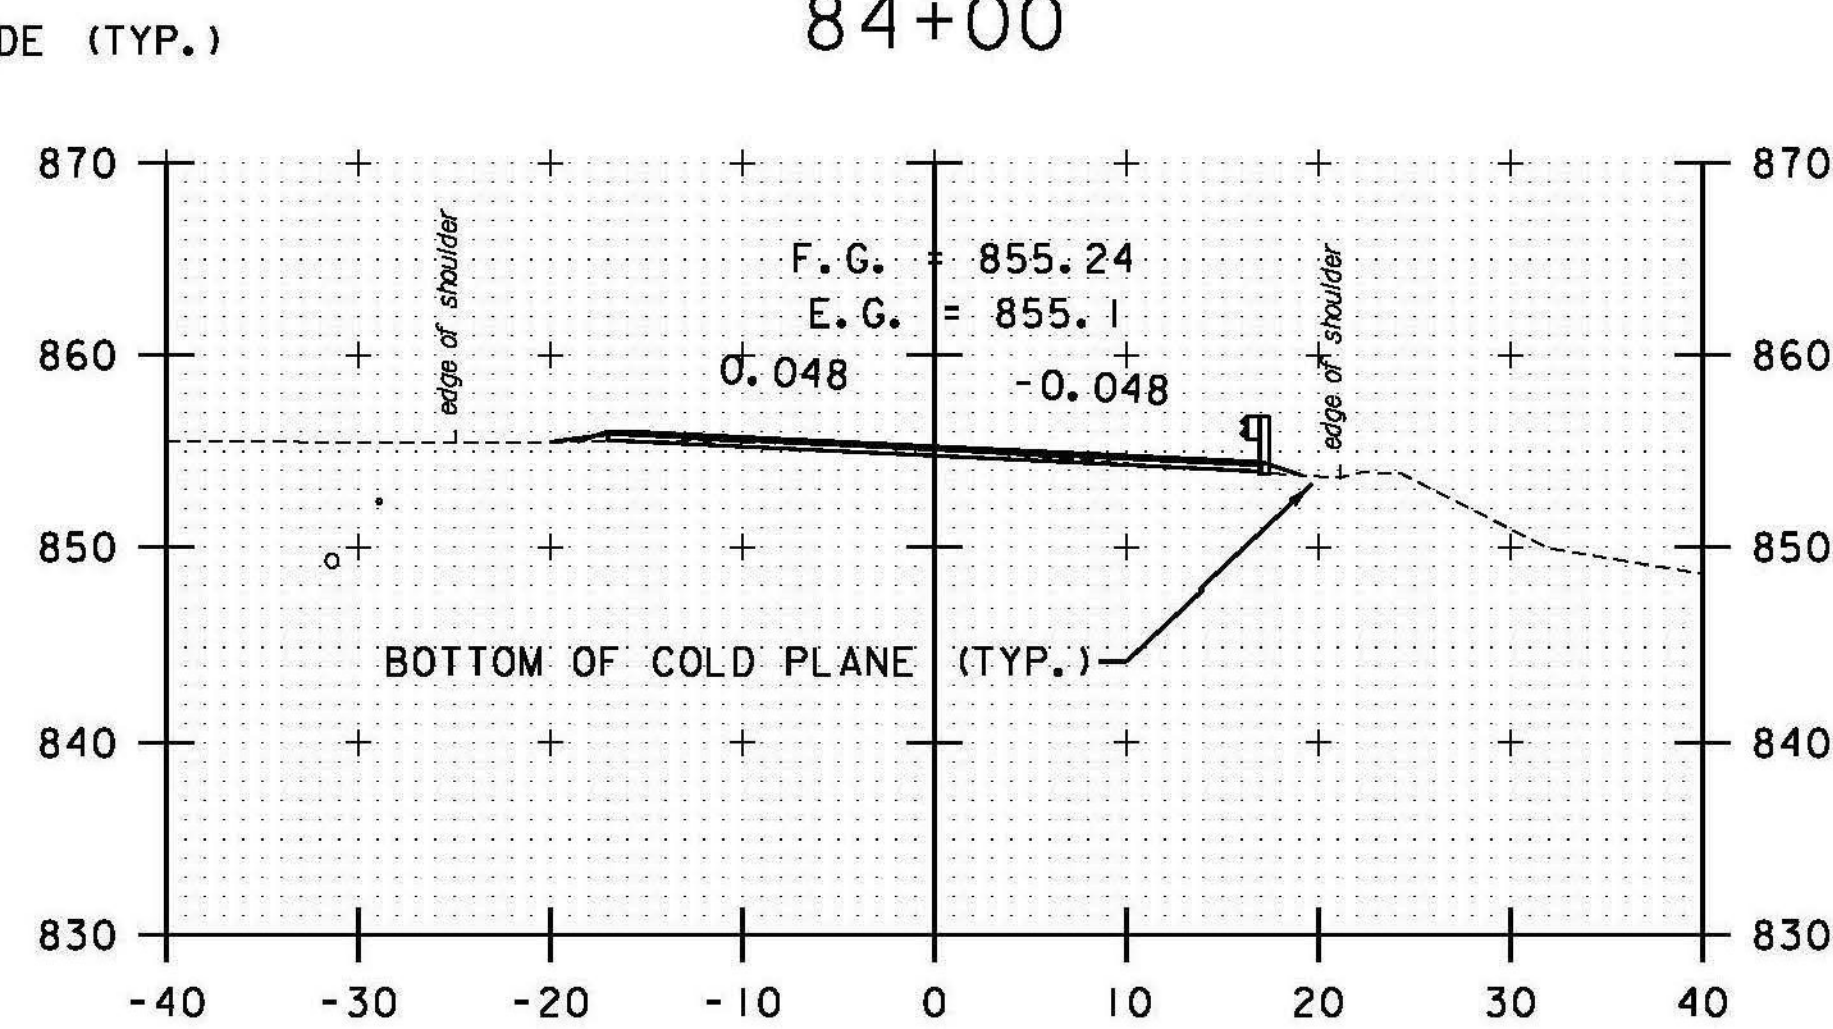


DRIVE LT
83+50

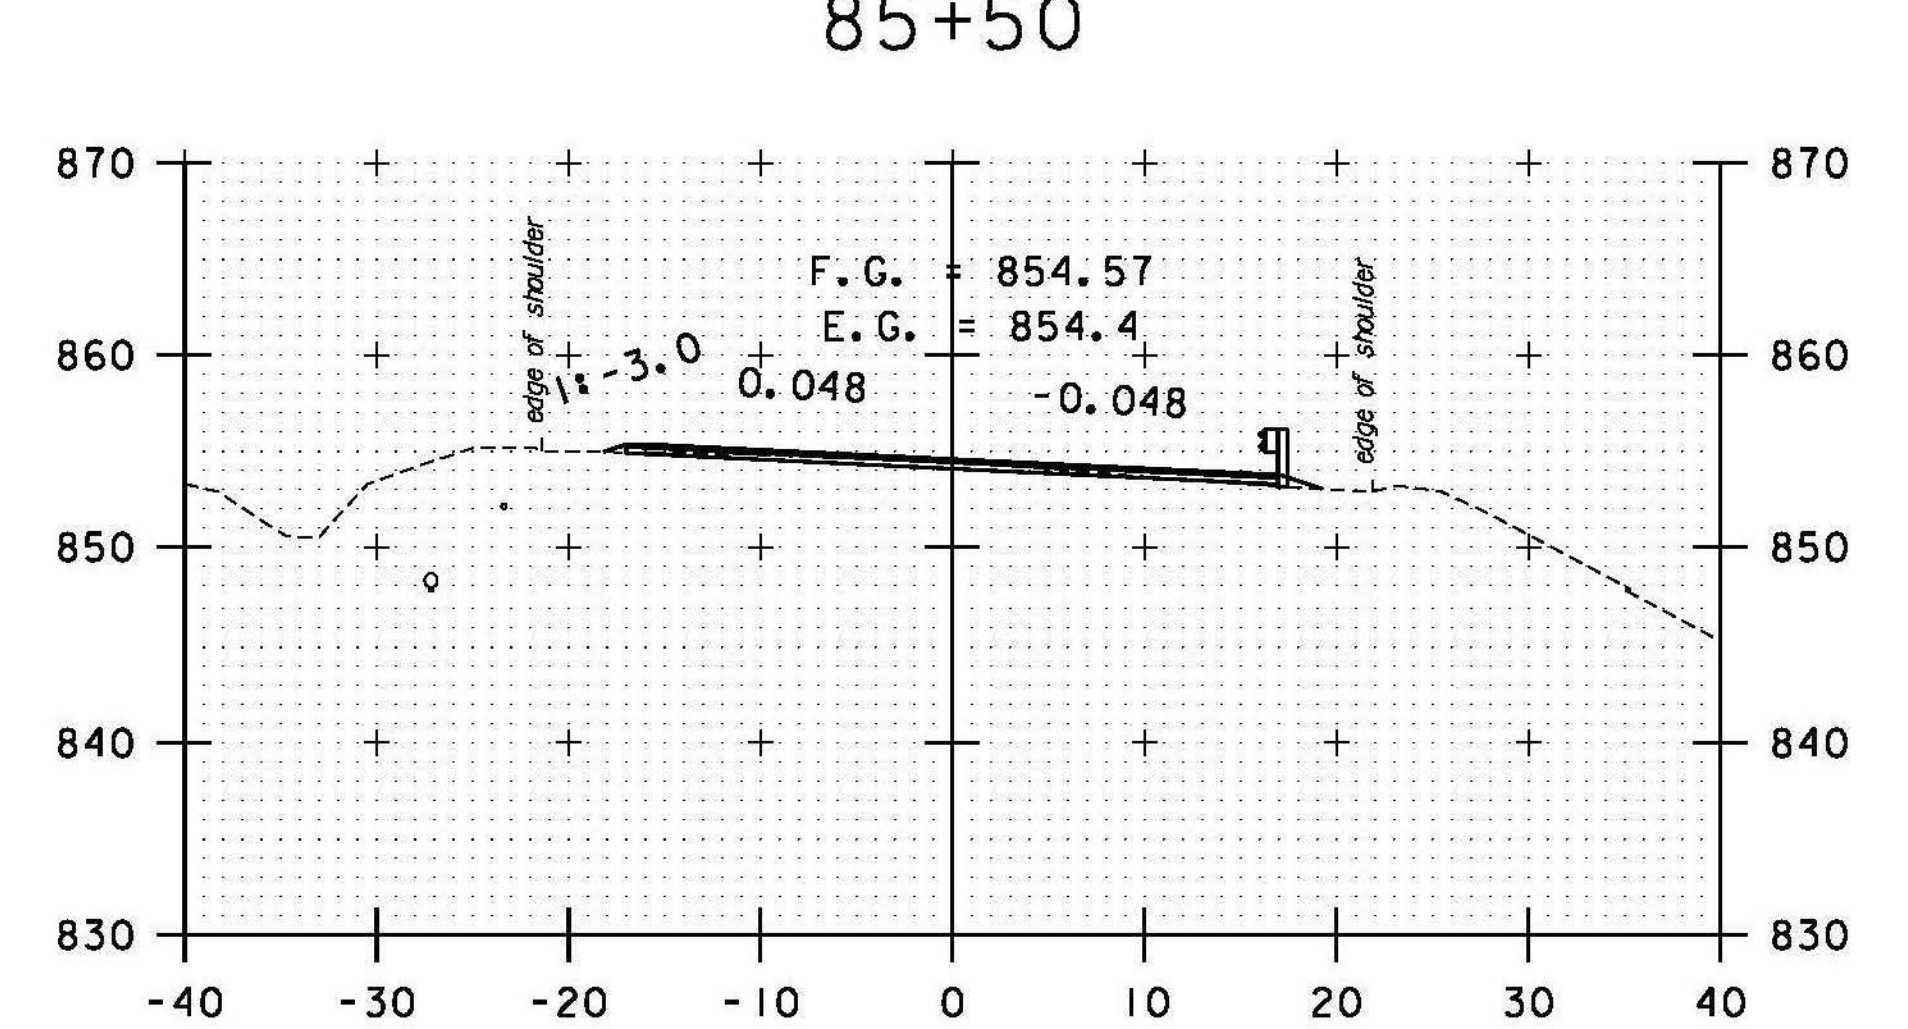


85+00

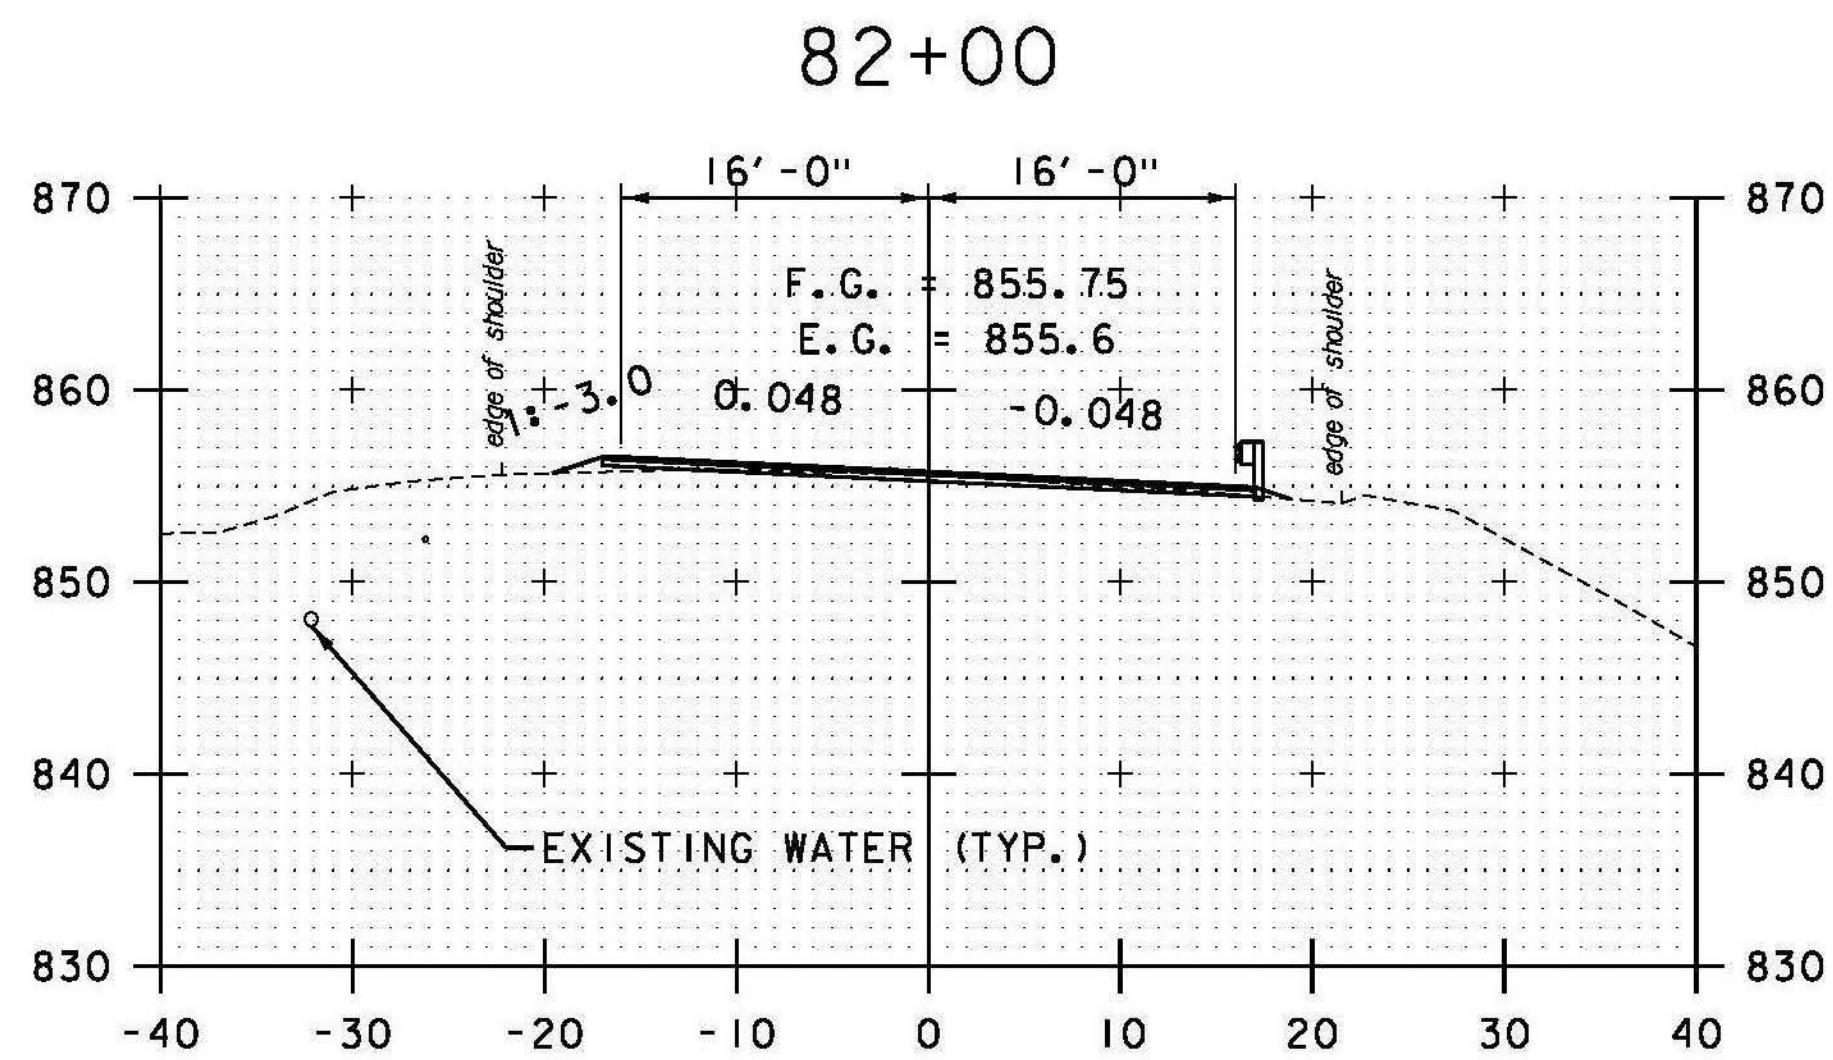

81+50

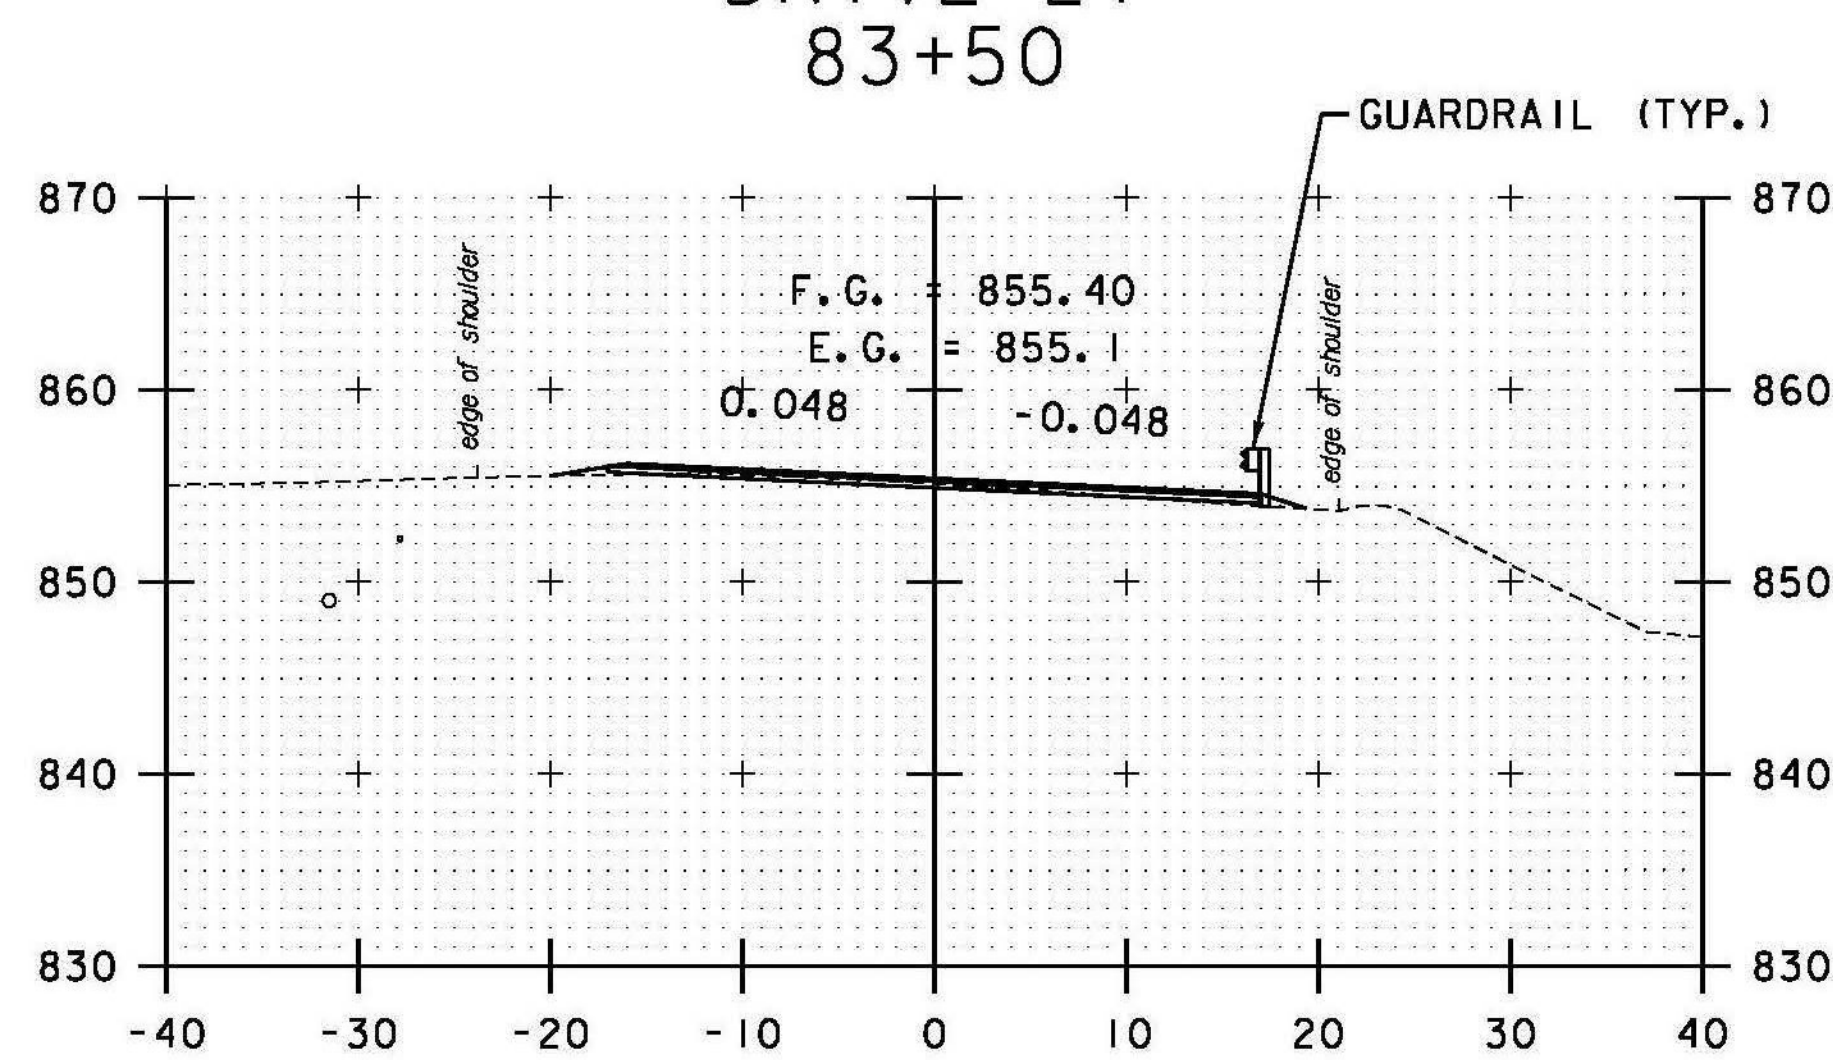


DRIVE LT
83+00

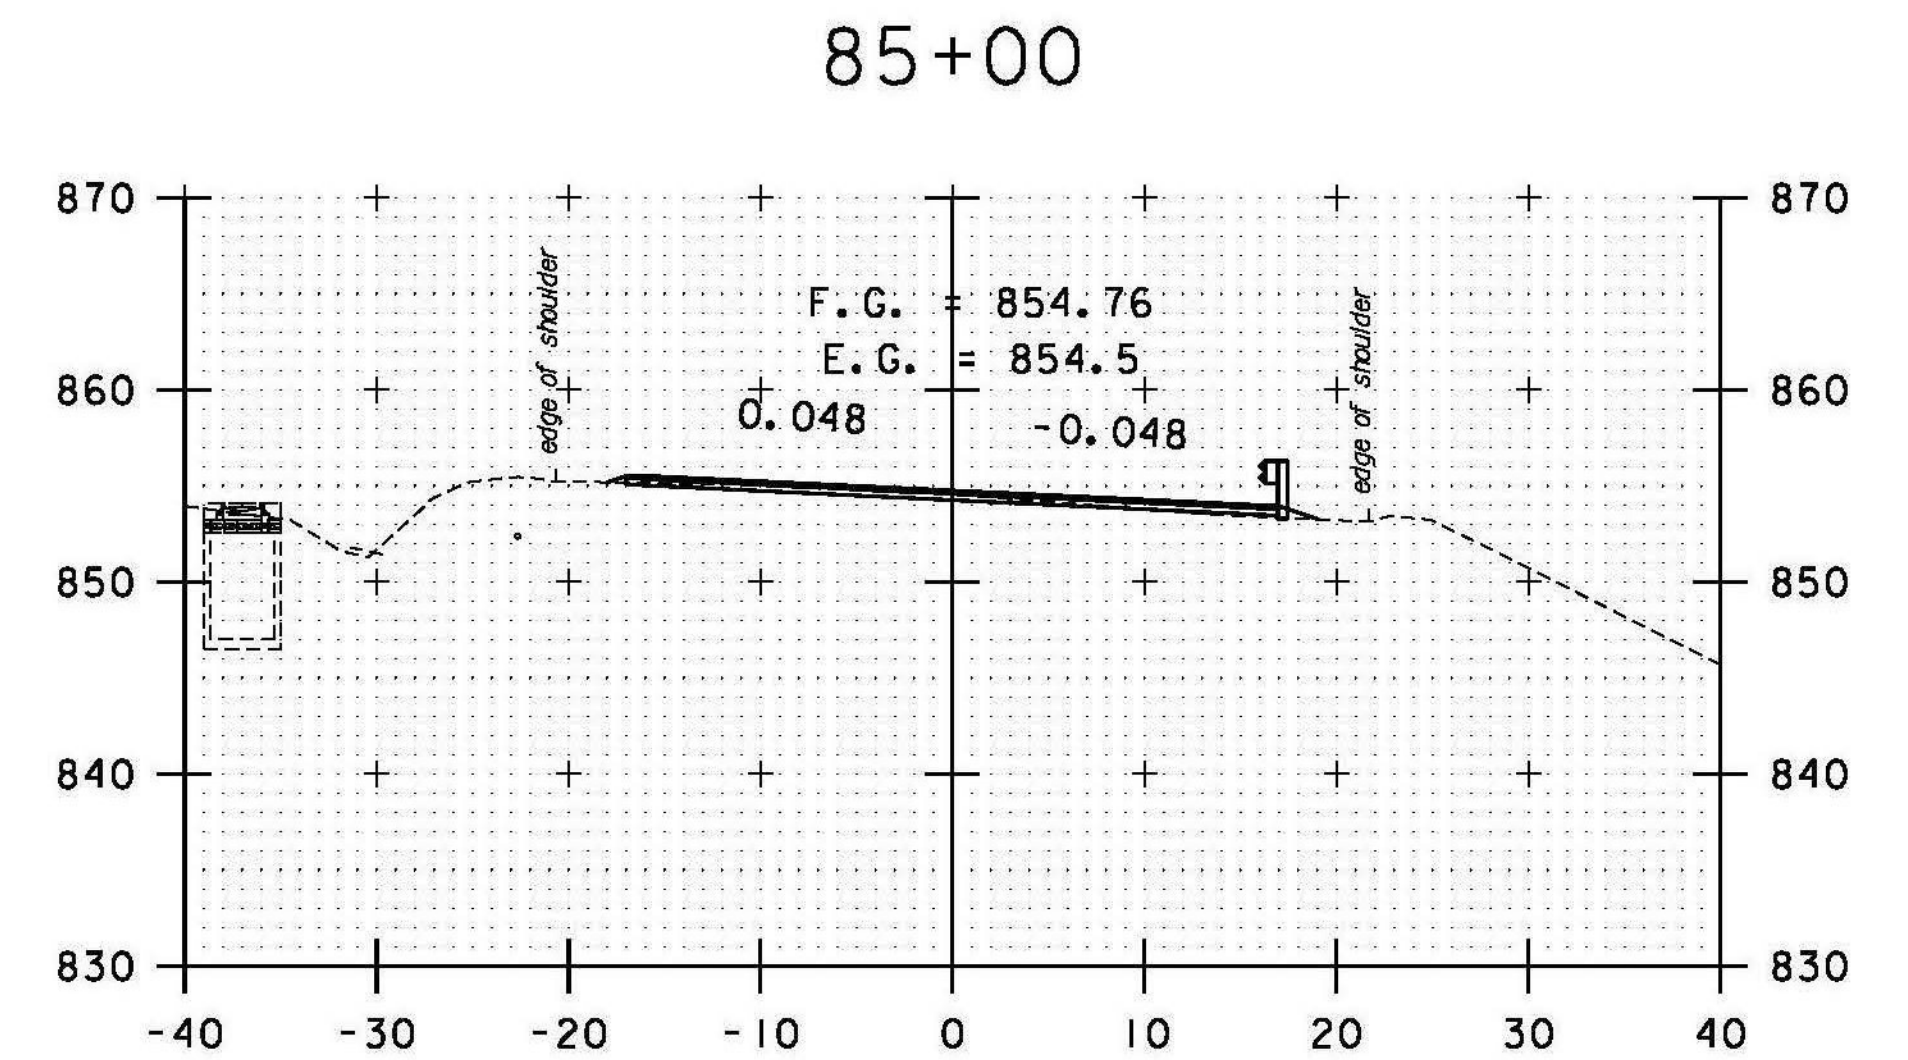

84+50

STA. 81+50 TO STA. 85+50

DATUM
VERTICAL NAVD 88
HORIZONTAL NAD 83 (07)

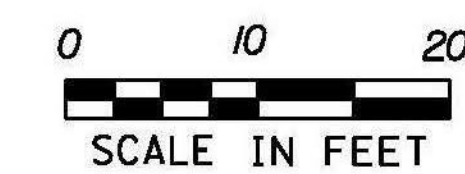

PROJECT NAME: RANDOLPH
PROJECT NUMBER: STP 2932 (1)

FILE NAME: z10c270.dgn
PROJECT LEADER: C. LATHROP
DESIGNED BY: B. BRESLEND
VT 66 CROSS SECTION SHEET 15

PLOT DATE: 6/5/2014
DRAWN BY: B. BRESLEND
CHECKED BY: C. LATHROP
SHEET 171 OF 276