




91+50

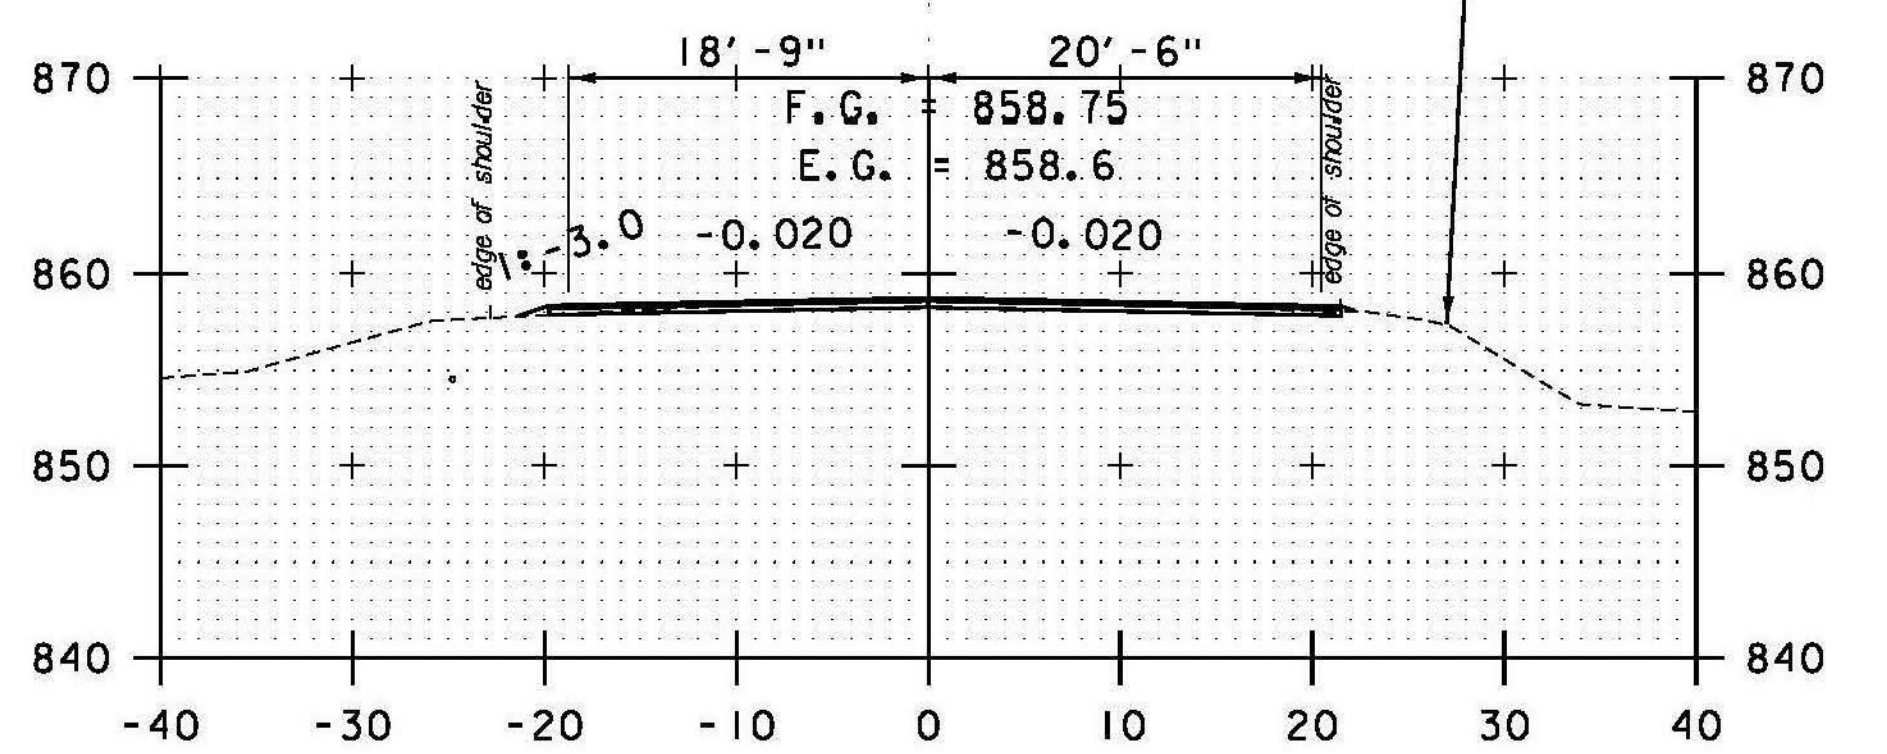


91+00

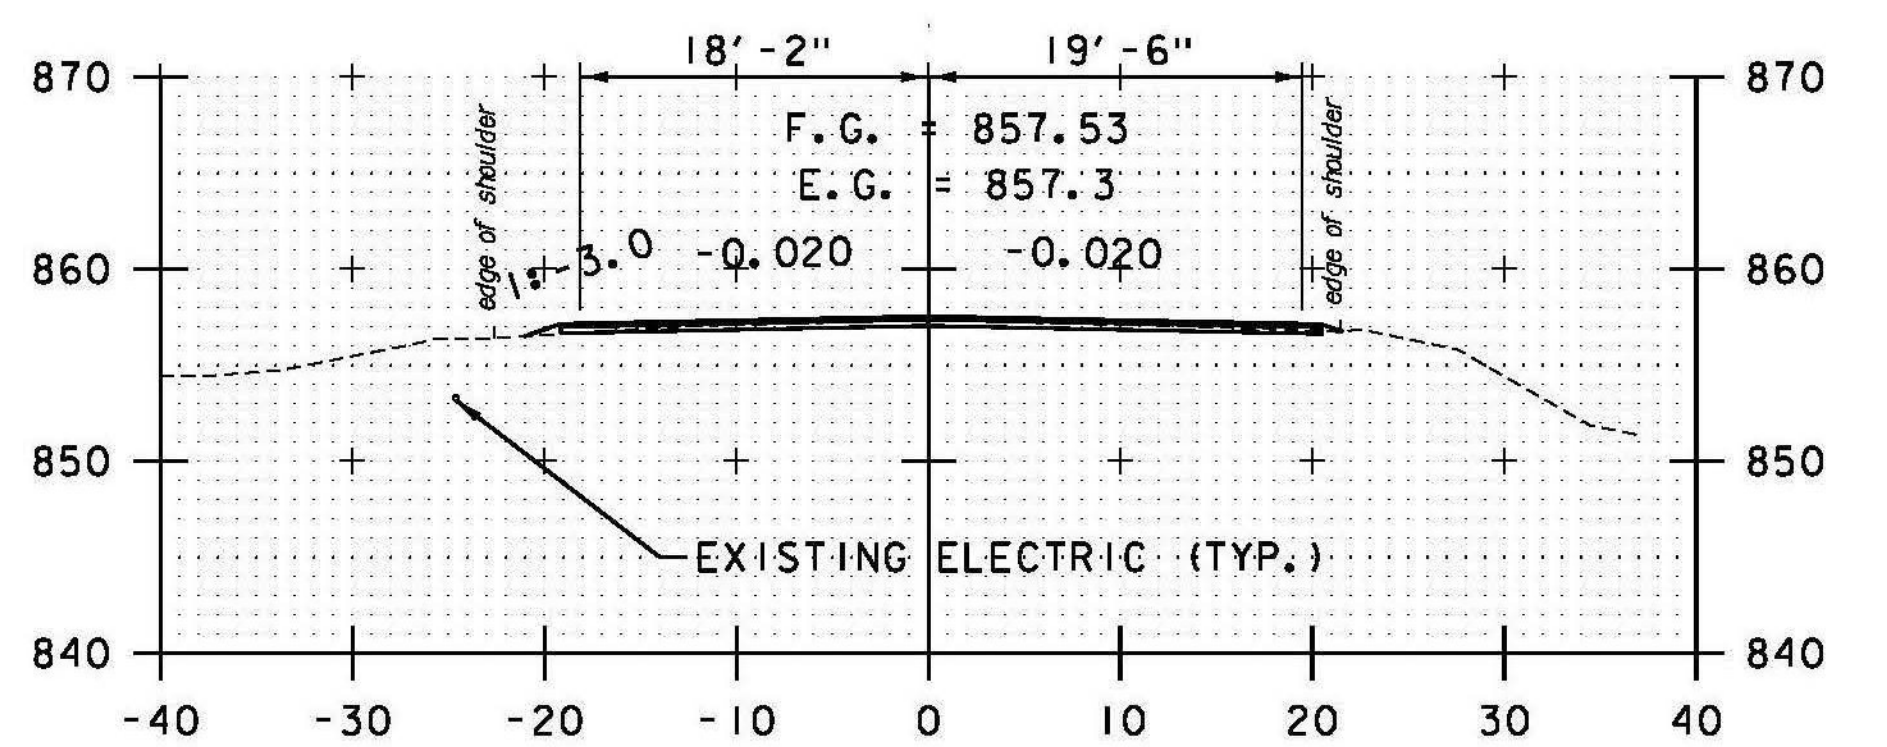


90+50

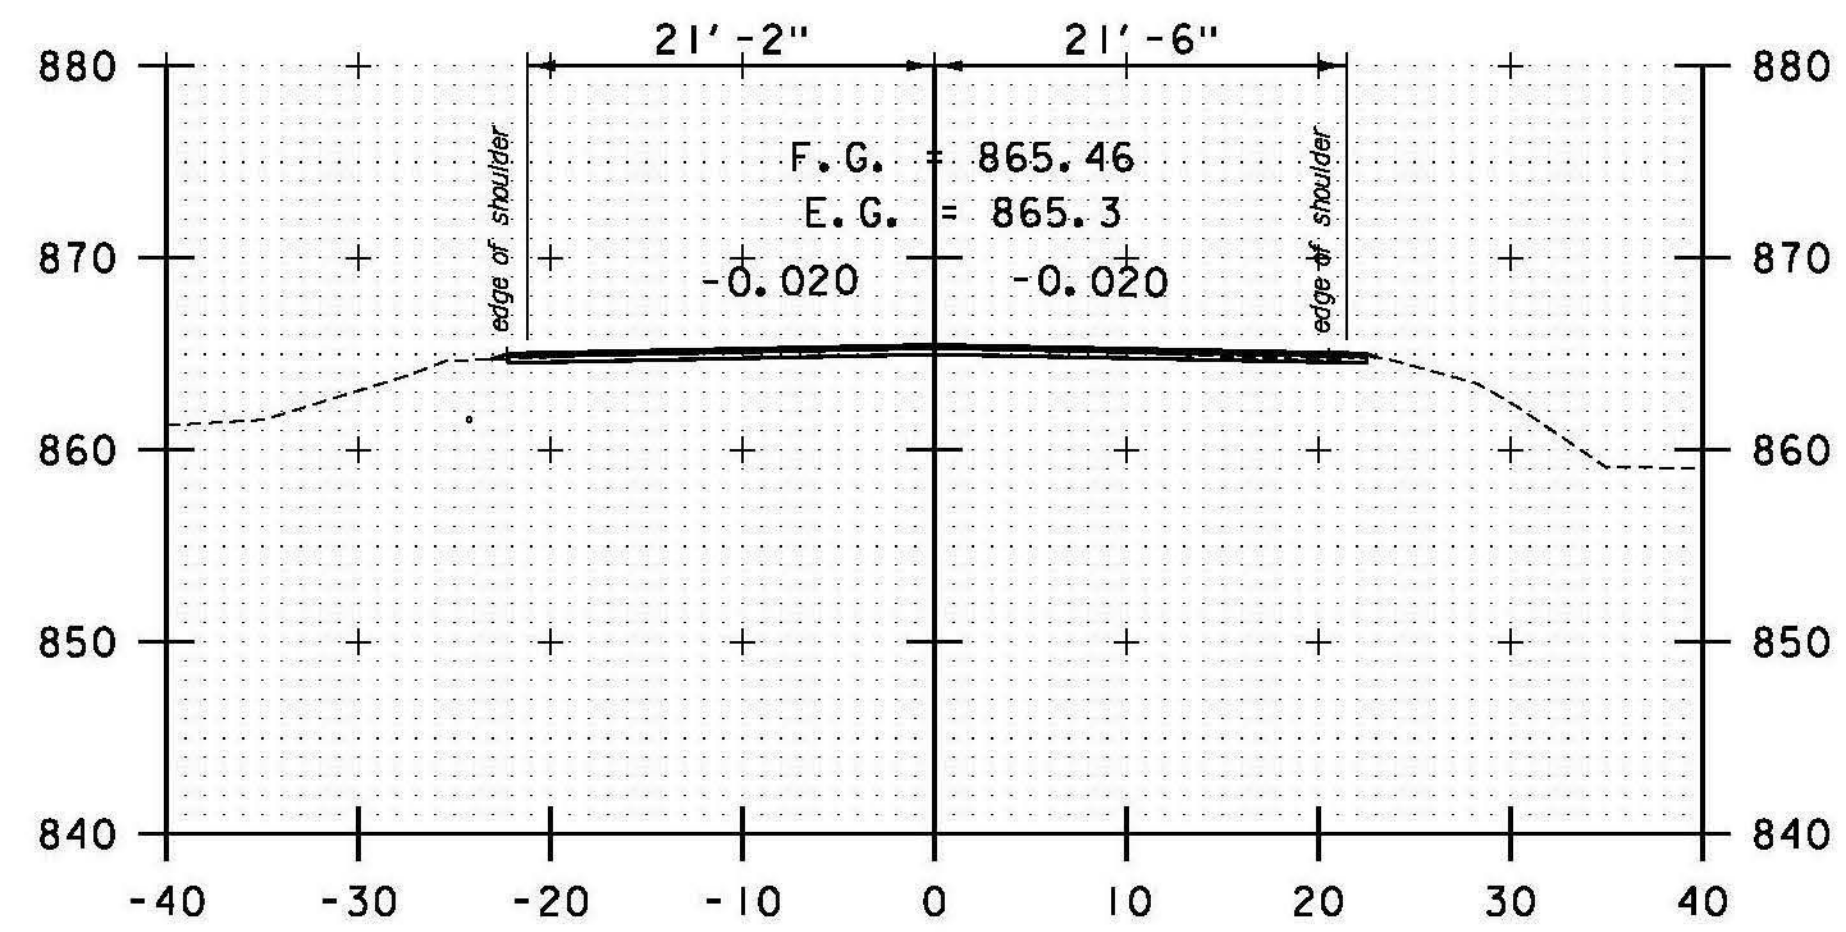


93+00

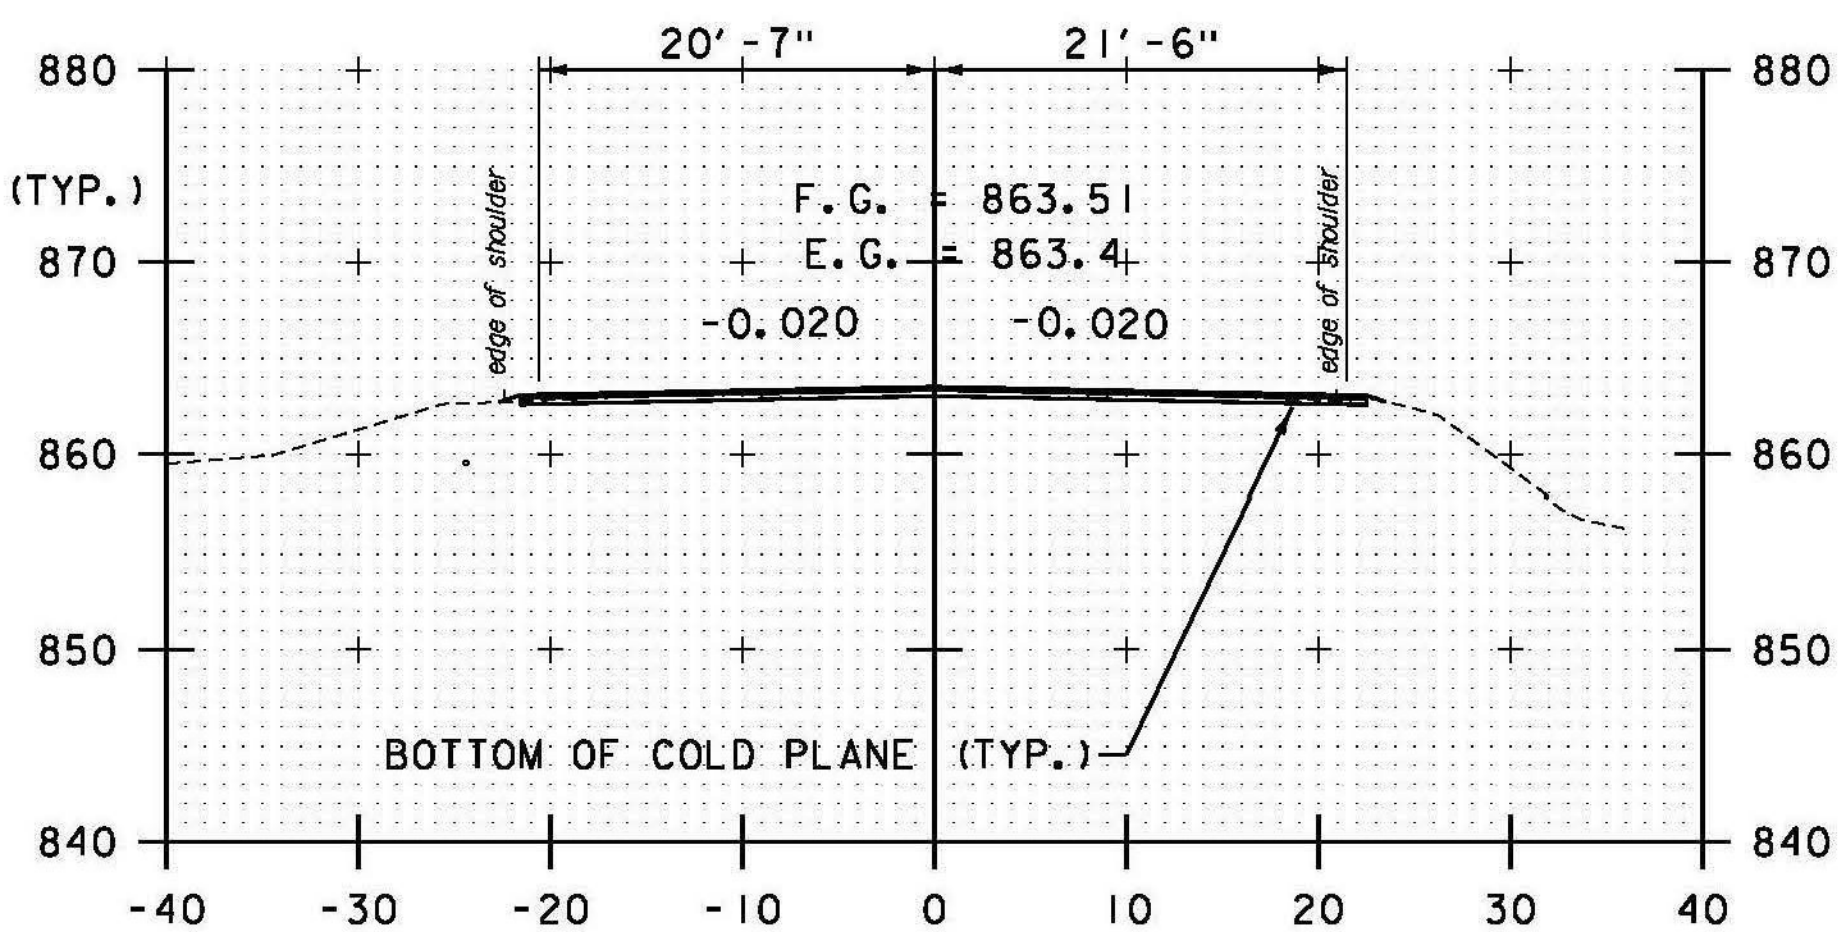


92+50

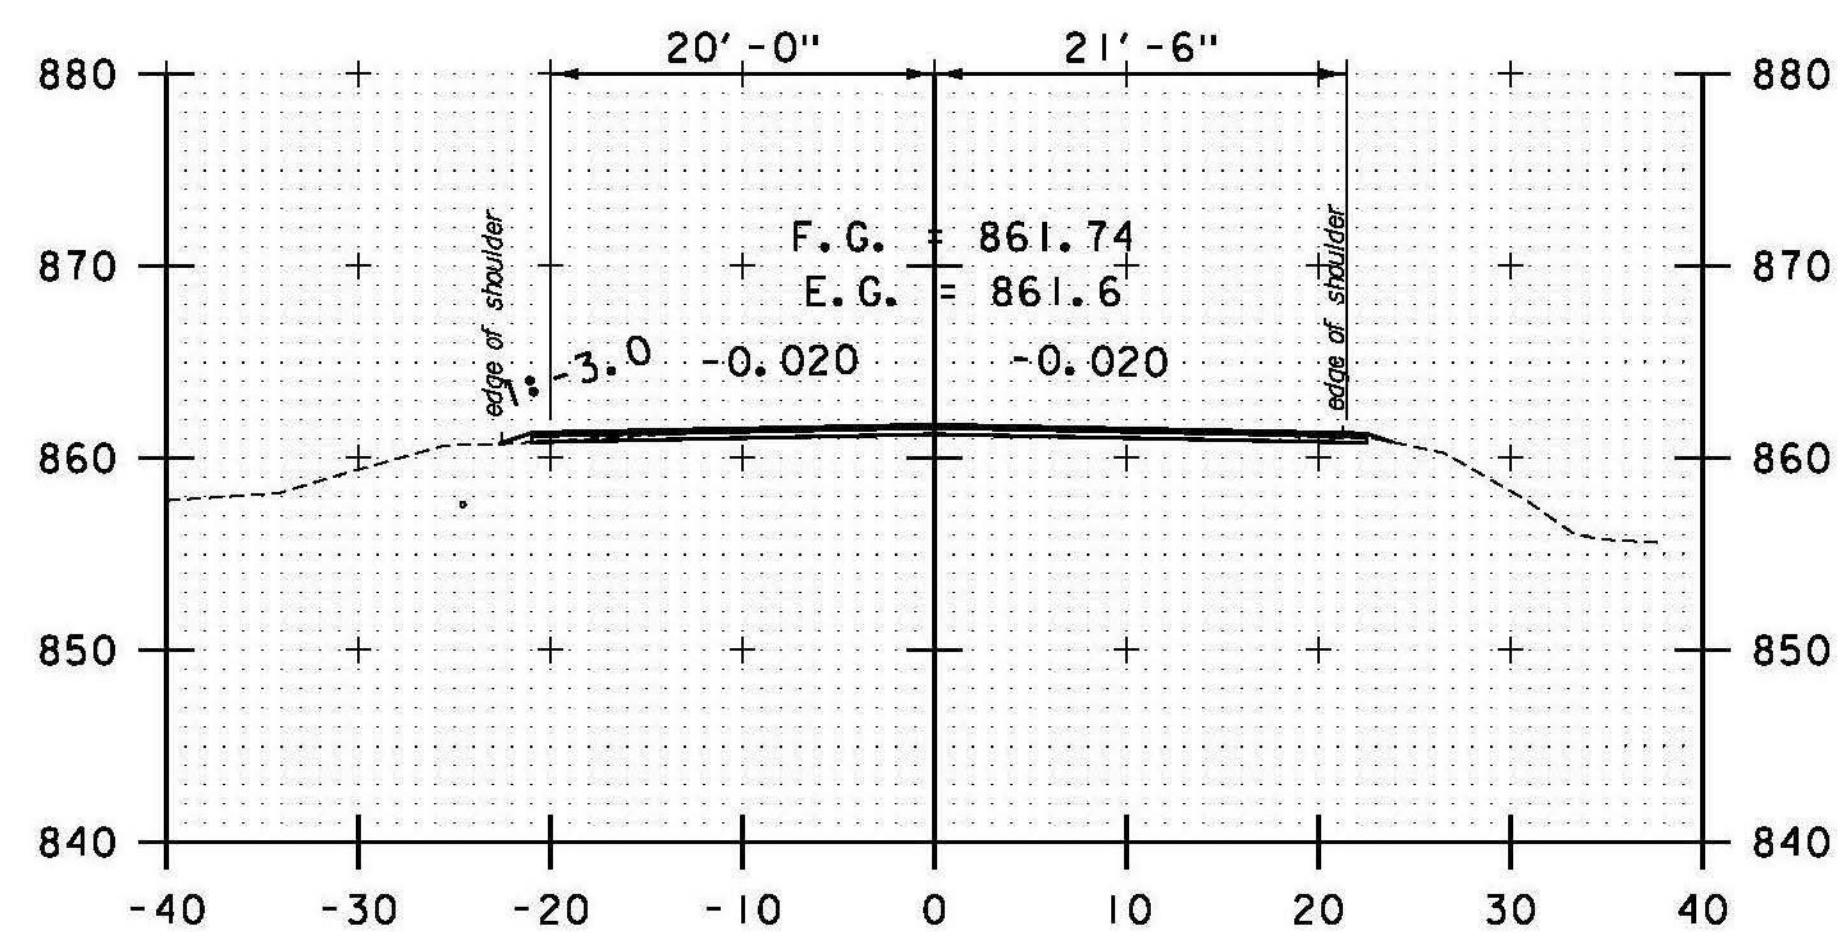


92+00

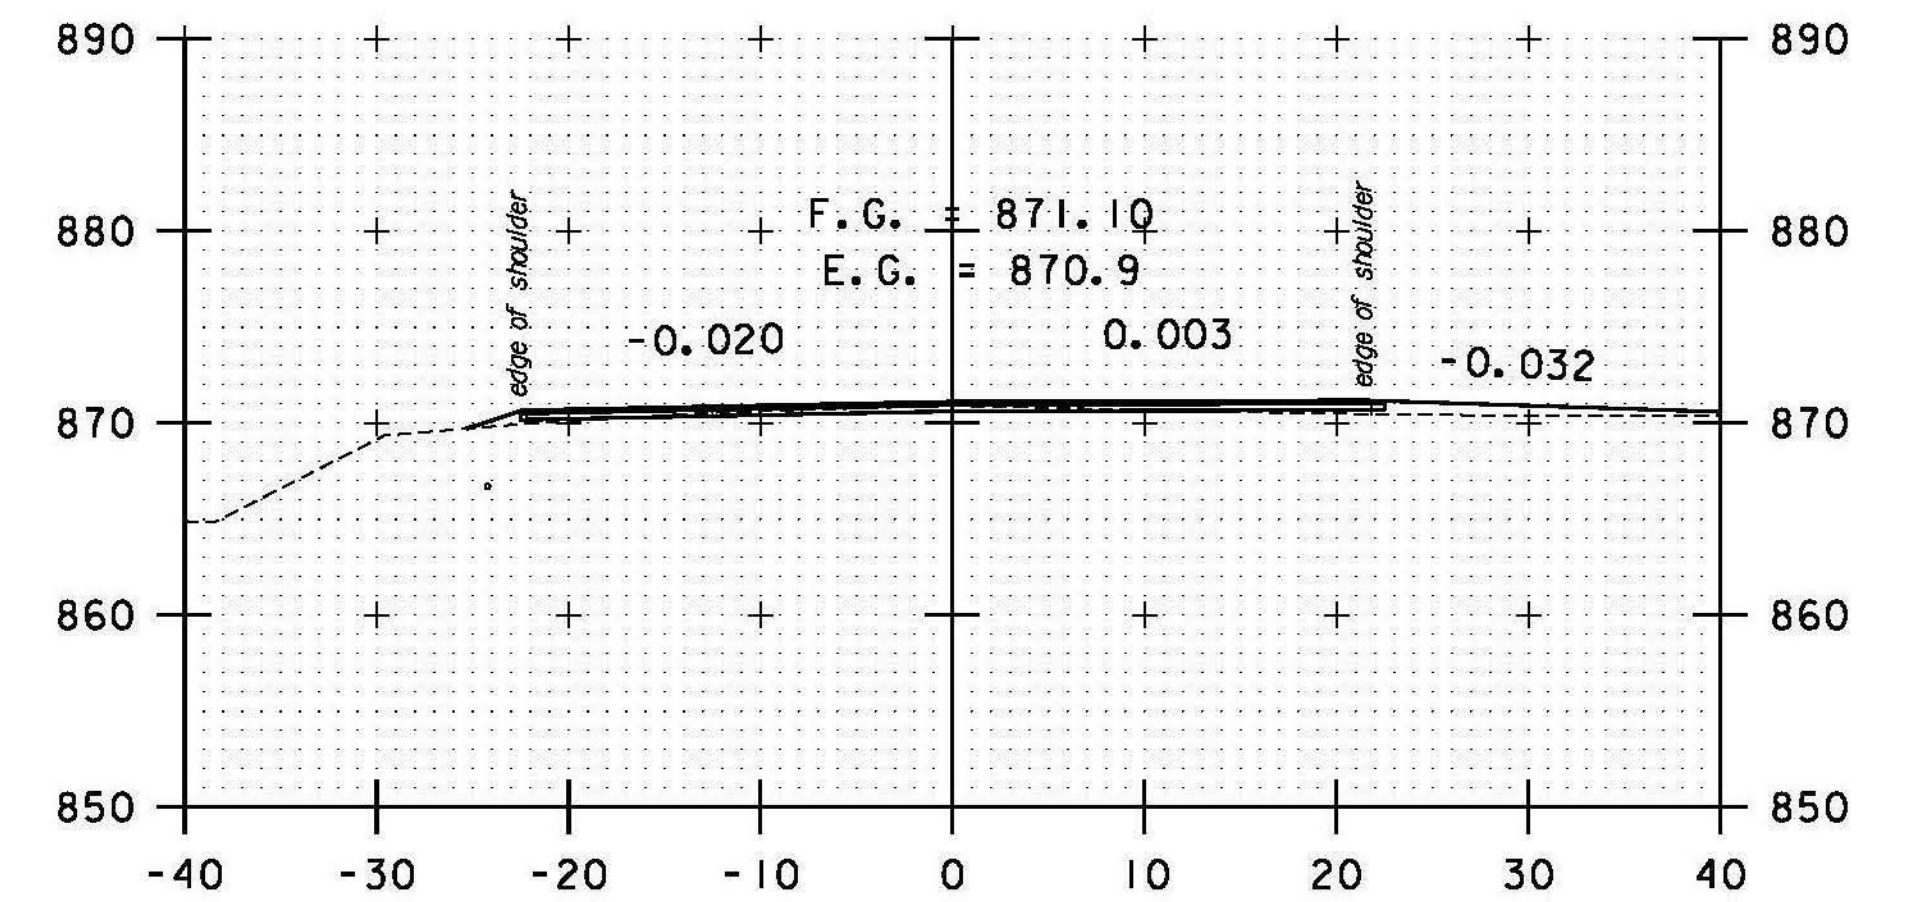

TH#26 LT / TH#59 RT
94+24

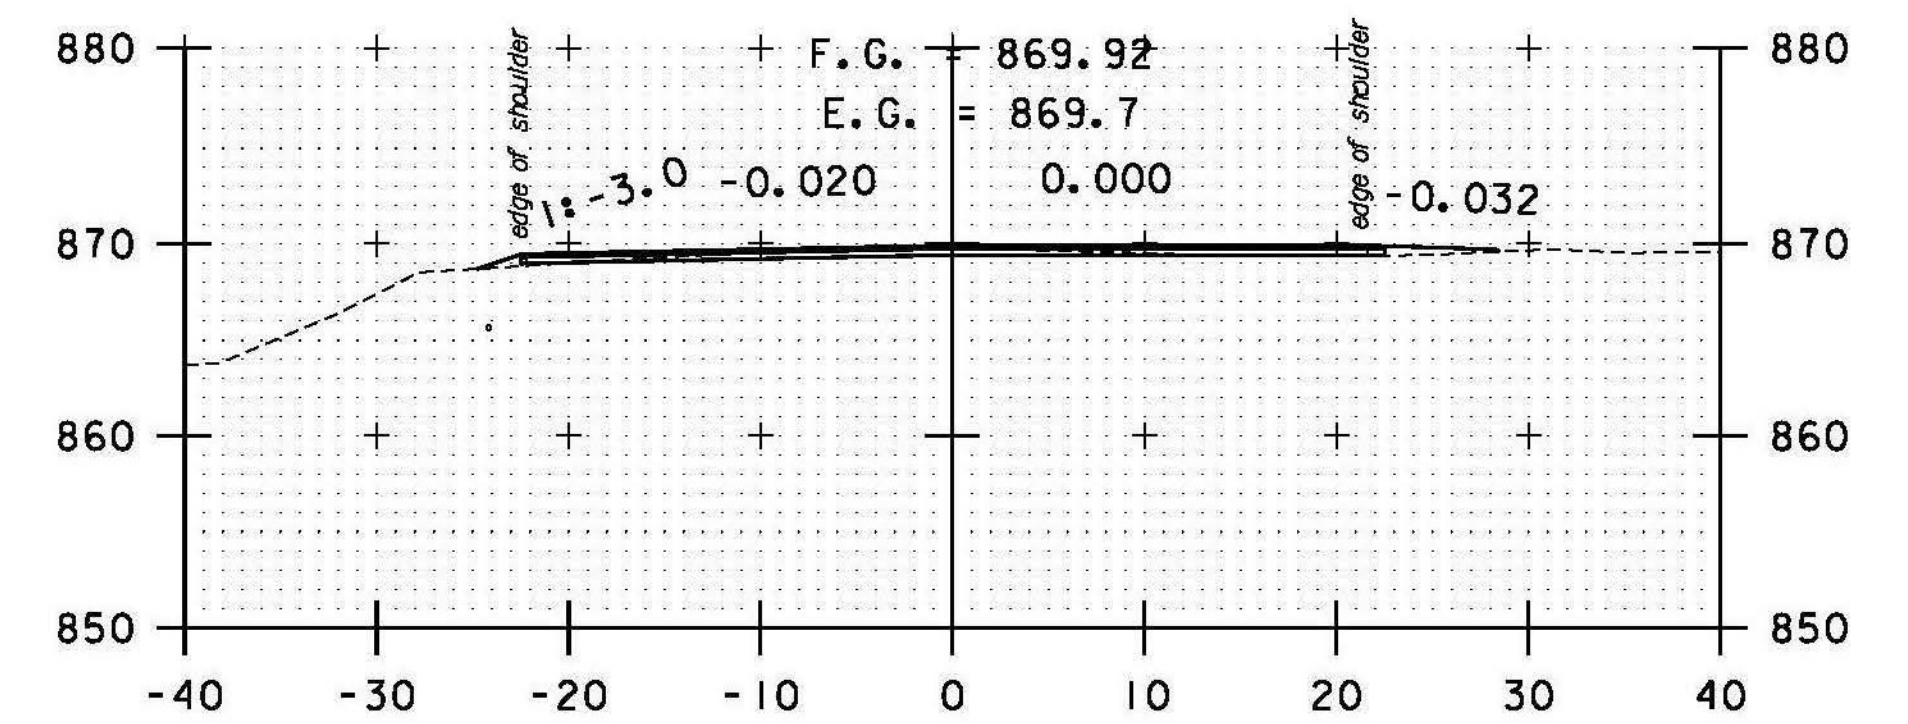


TH#59 RT
94+00

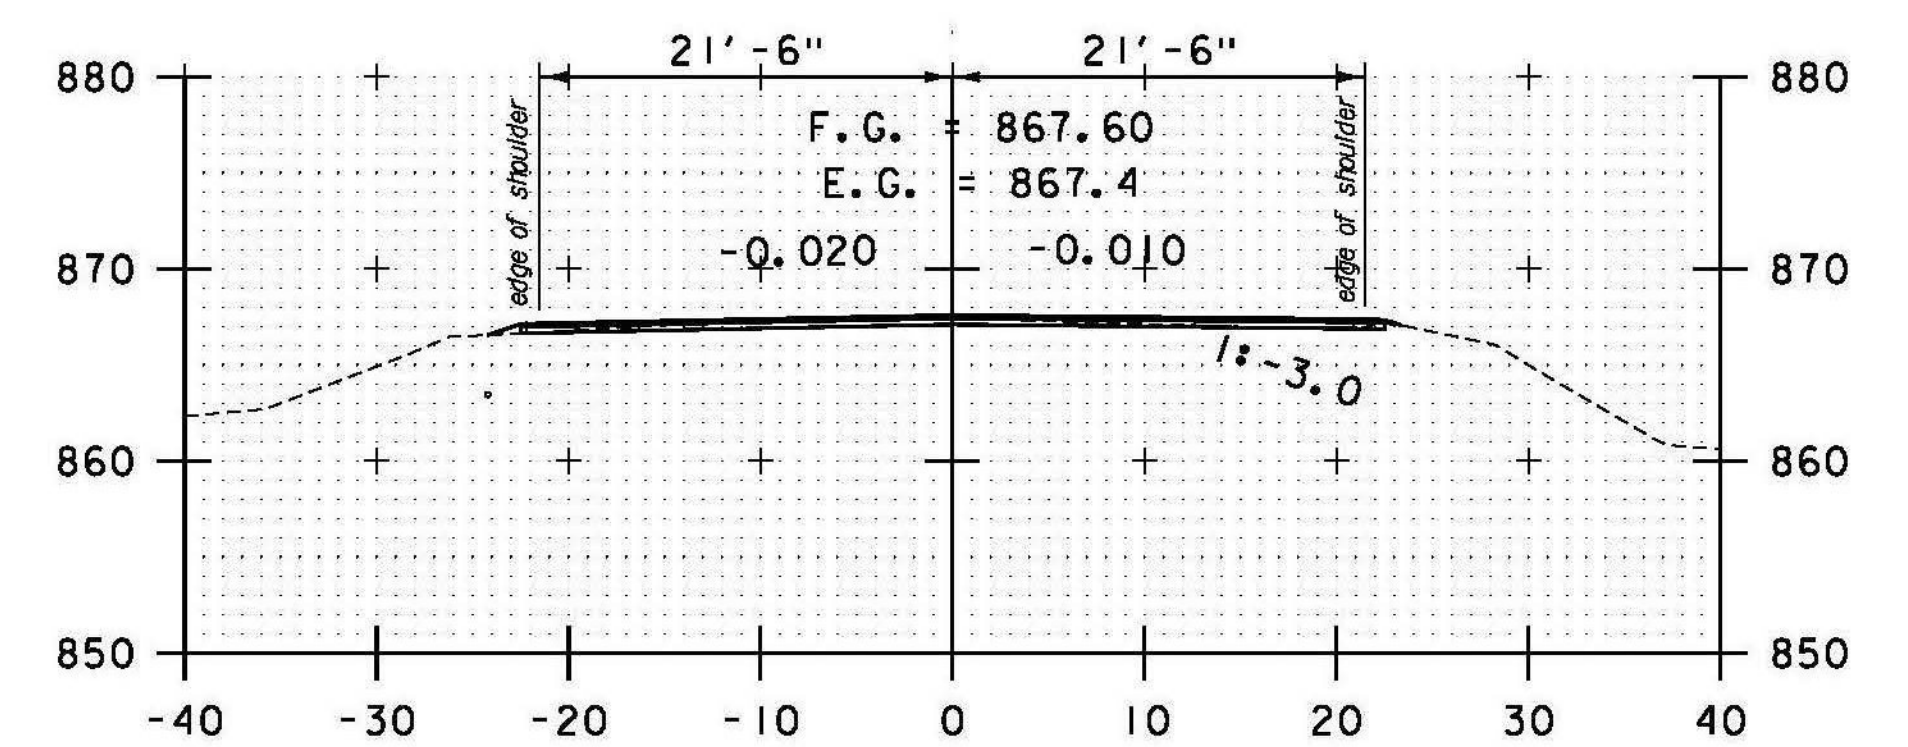

93+50

STA. 90+50 TO STA. 94+24

DATUM
VERTICAL NAVD 88
HORIZONTAL NAD 83 (07)

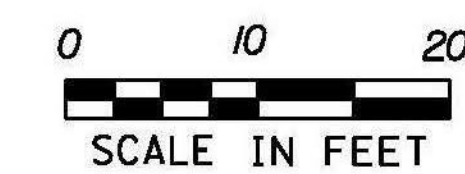

PROJECT NAME: RANDOLPH
PROJECT NUMBER: STP 2932 (1)

FILE NAME: z10c270.dgn
PROJECT LEADER: C. LATHROP
DESIGNED BY: B. BRESLEND
VT 66 CROSS SECTION SHEET 17

PLOT DATE: 6/5/2014
DRAWN BY: B. BRESLEND
CHECKED BY: C. LATHROP
SHEET 173 OF 276