




TH#26 LT
95+00

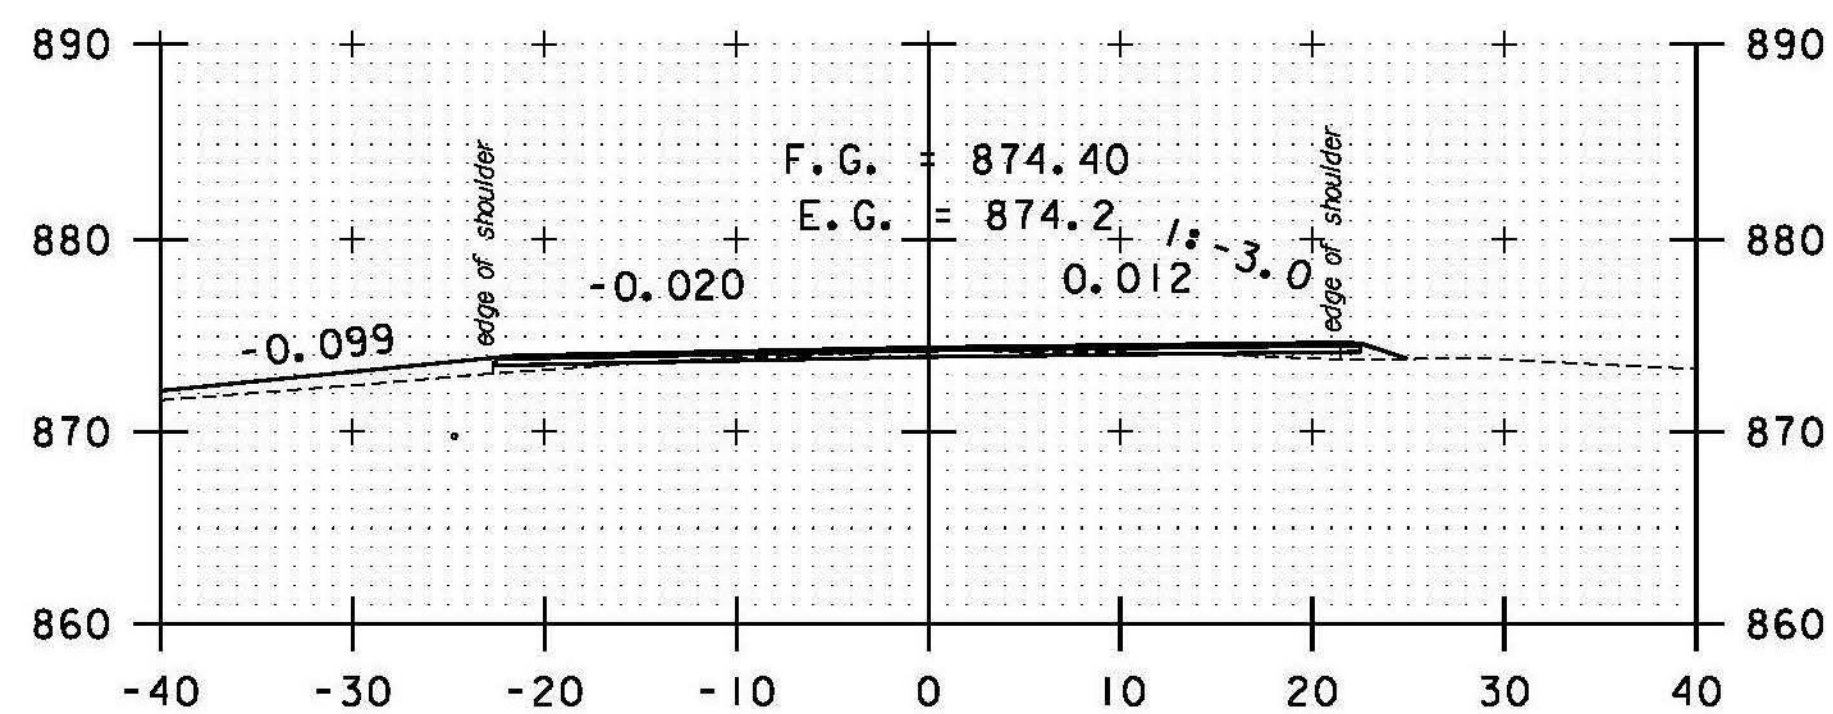


TH#26 LT
94+87

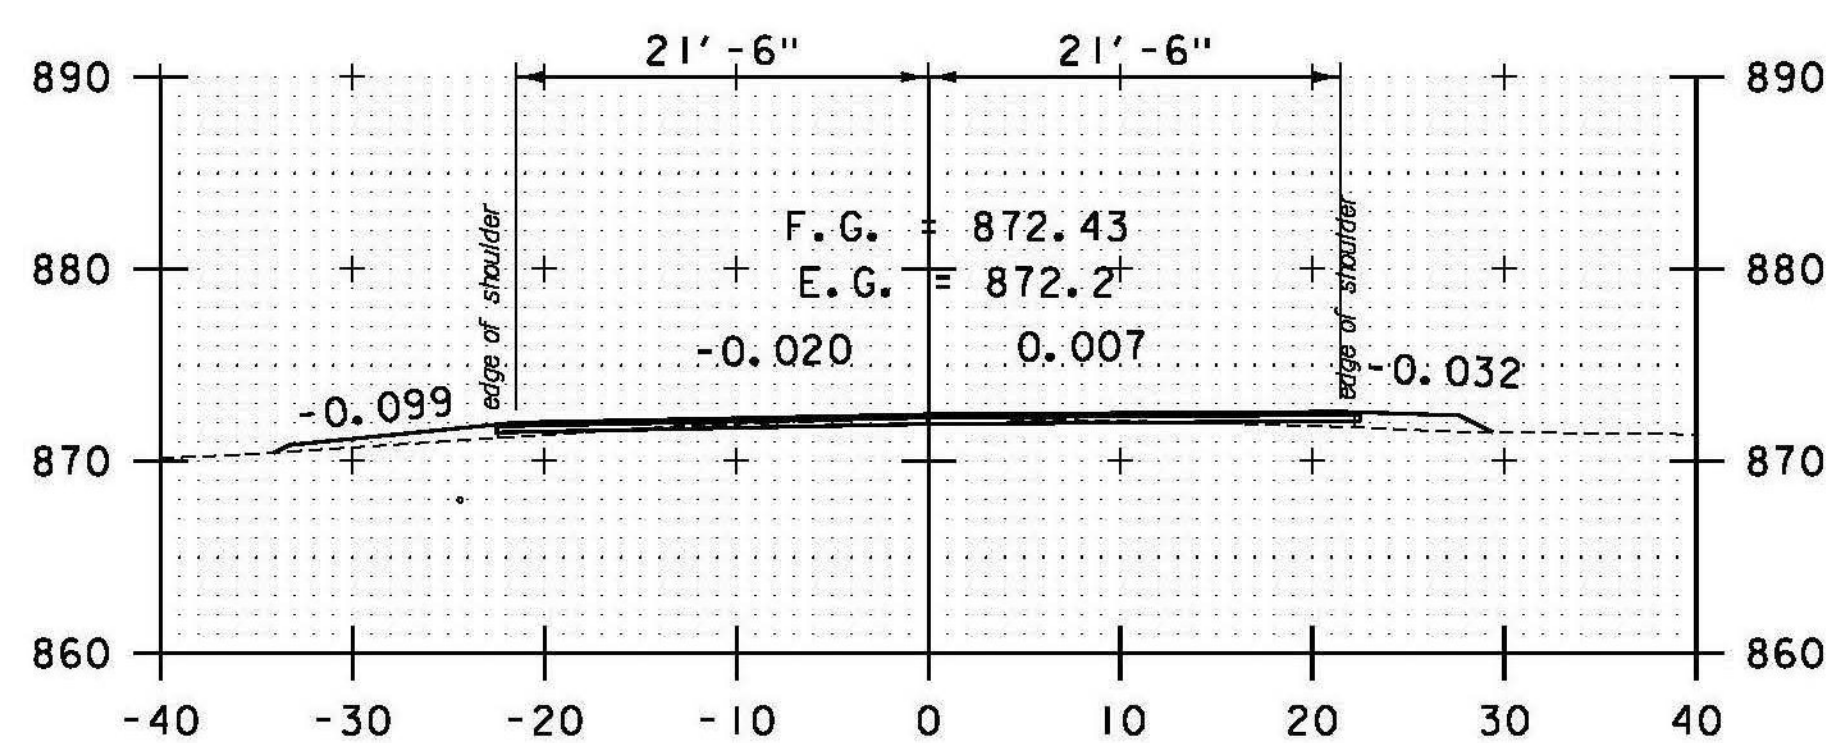


TH#26 LT / TH#59 RT
94+50

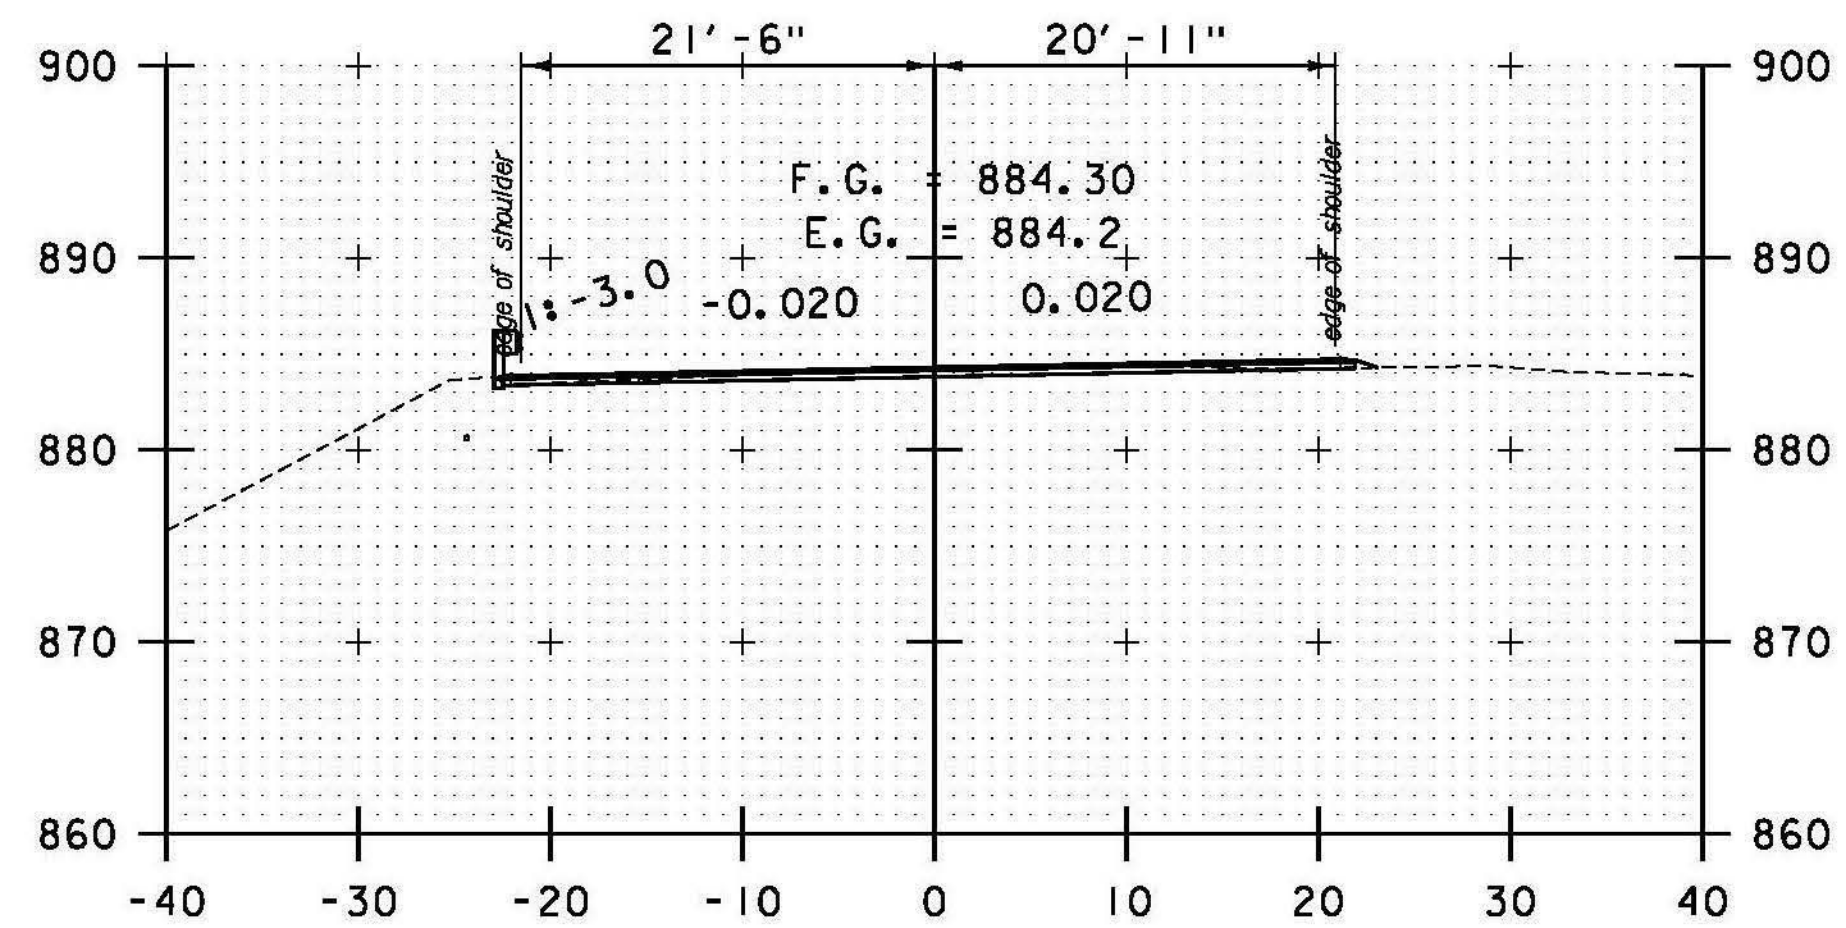


96+50

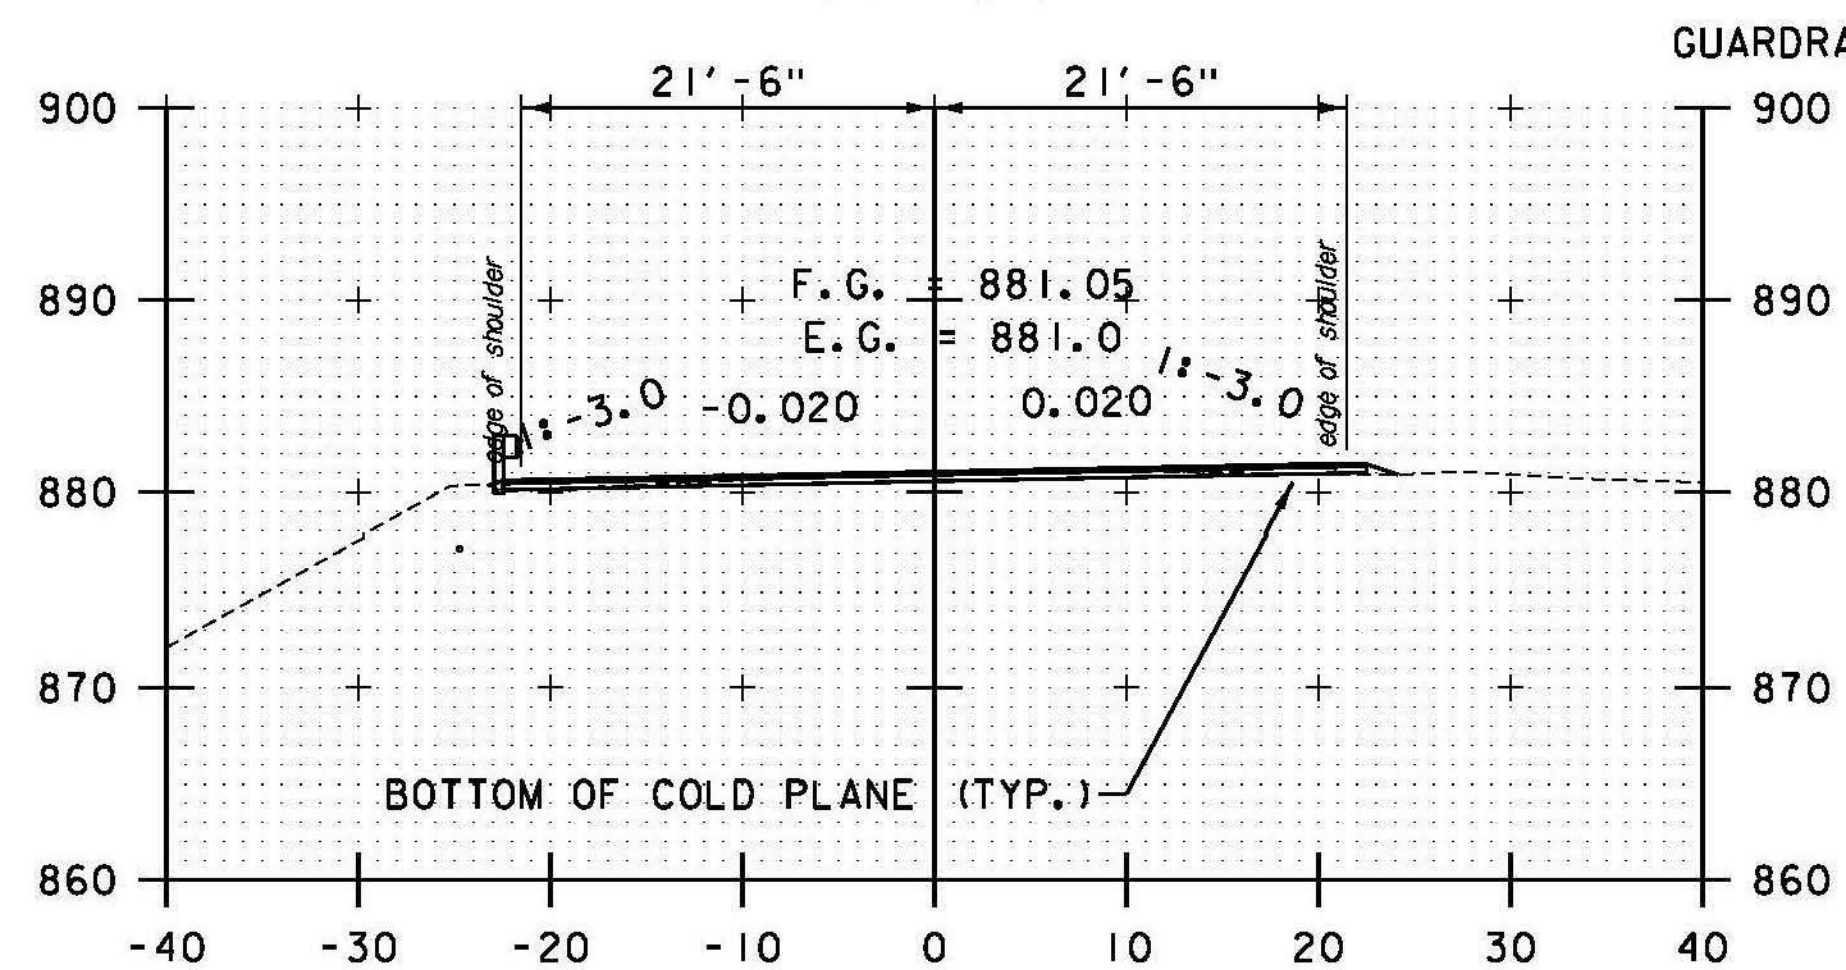


96+00

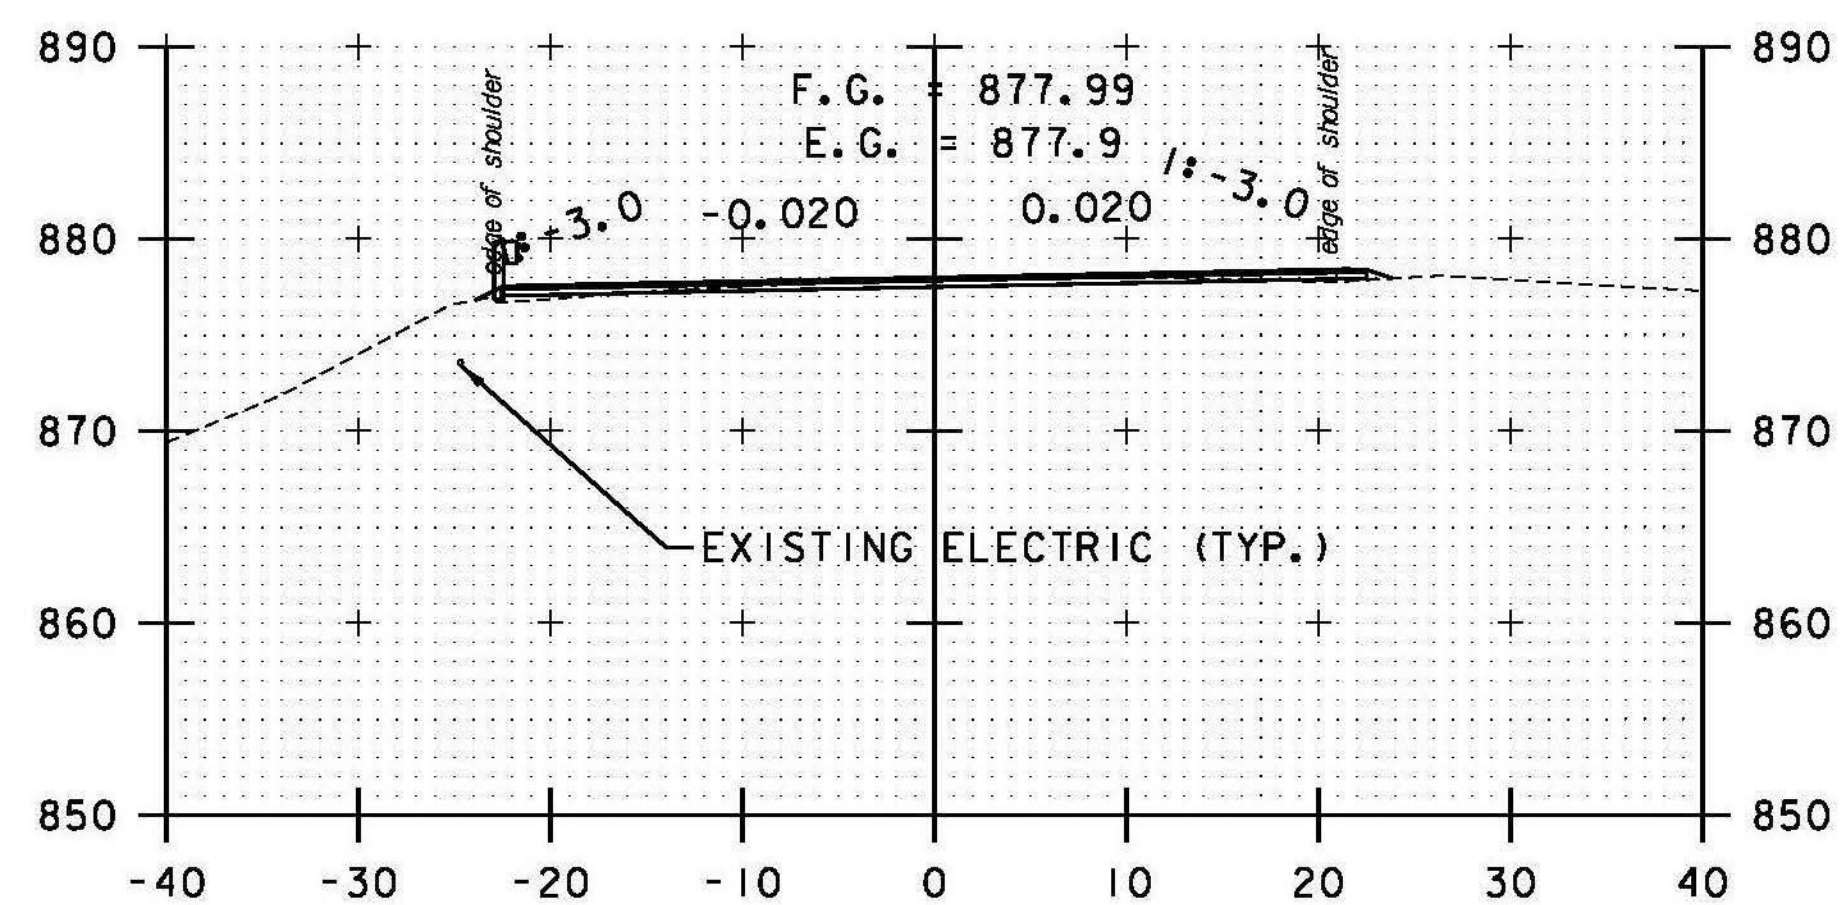


95+50

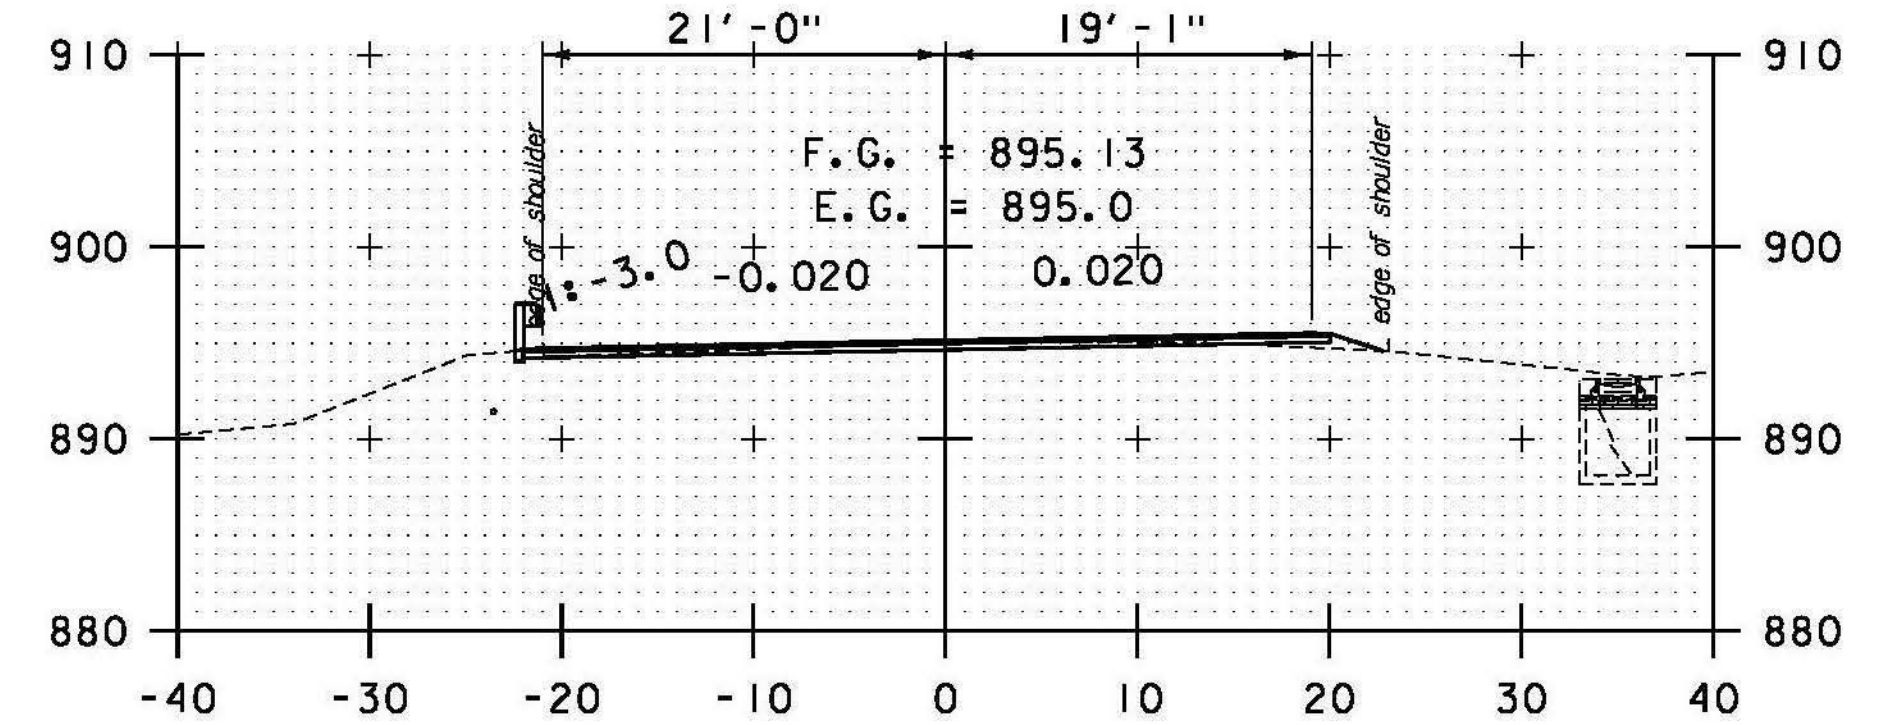

DRIVE RT
98+00

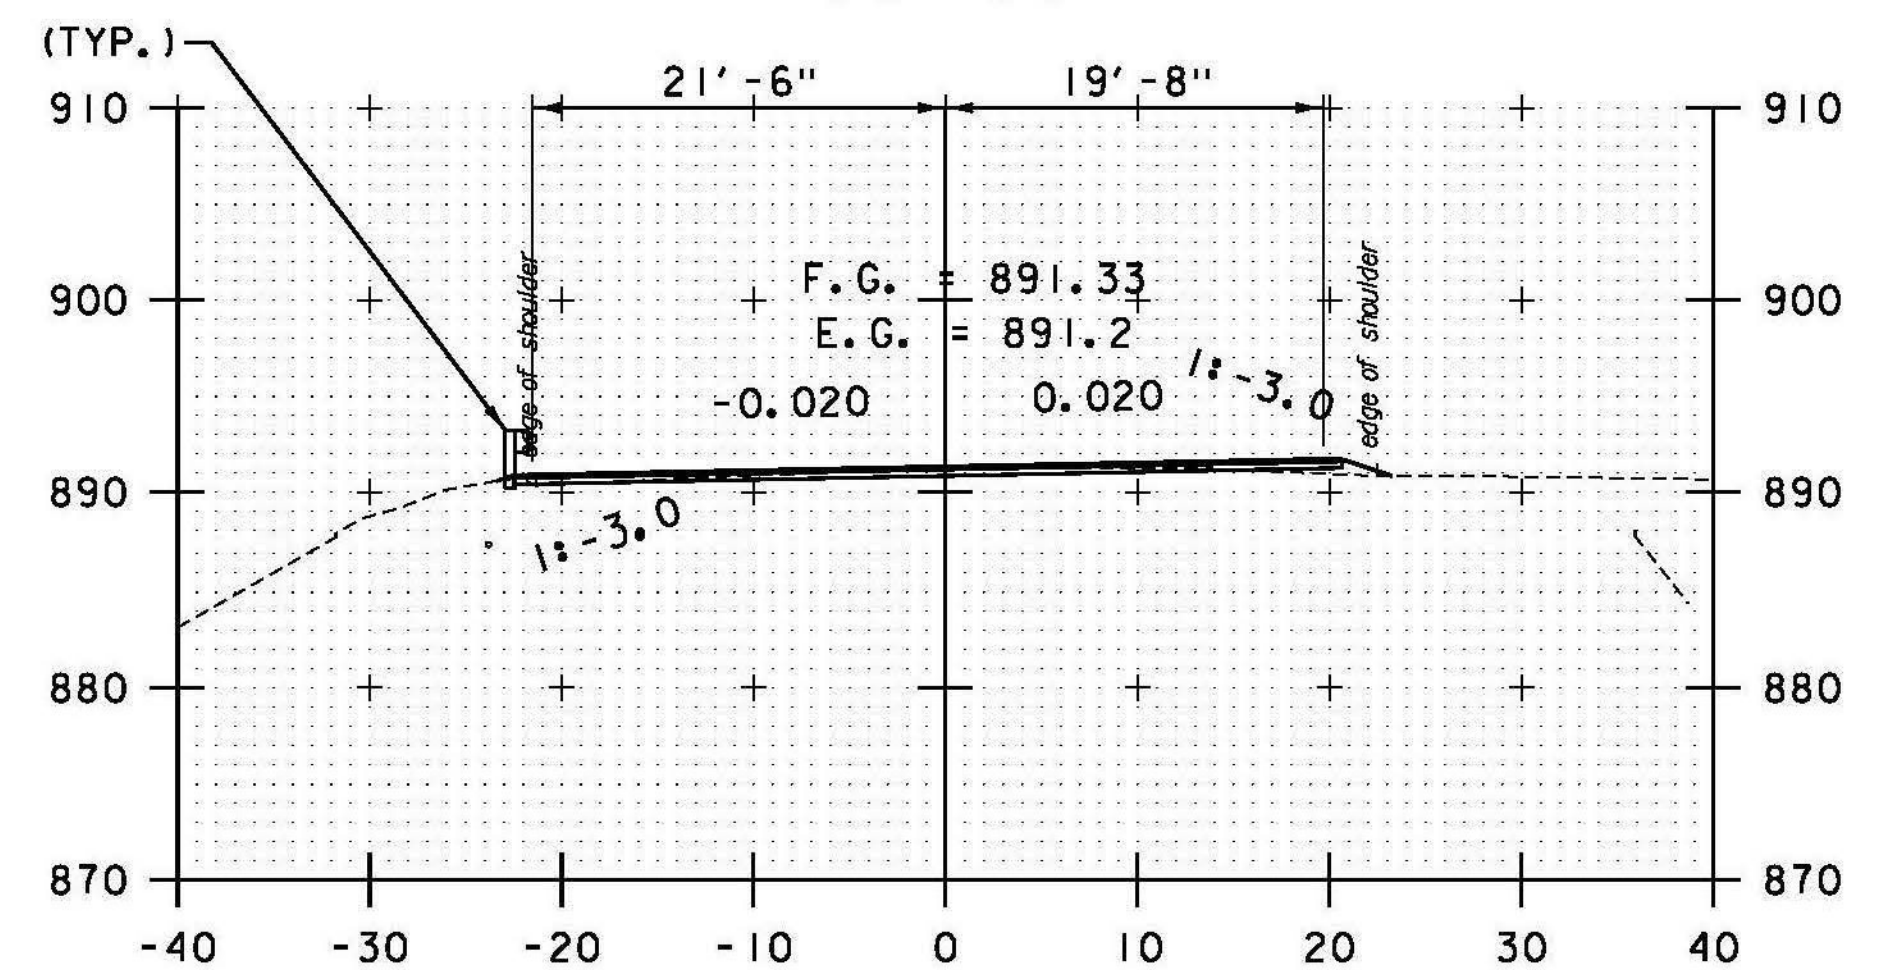


97+50

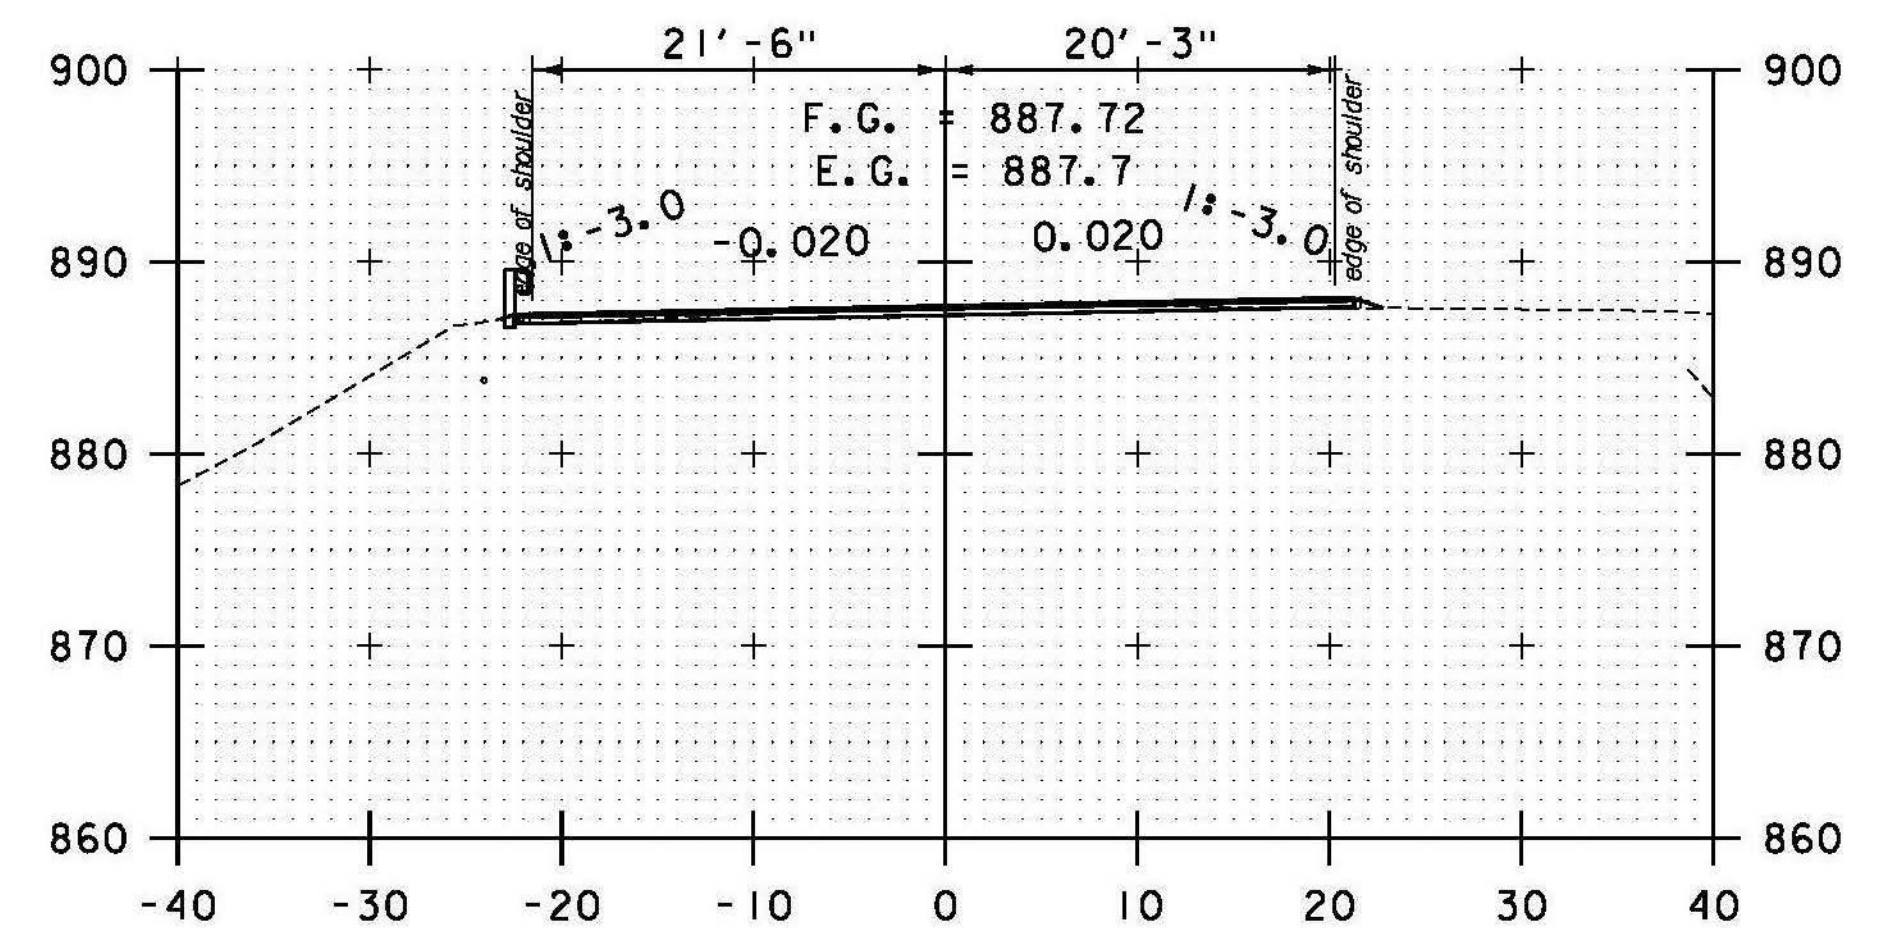

97+00

STA. 94+50 TO STA. 98+00

DATUM
VERTICAL NAVD 88
HORIZONTAL NAD 83 (07)

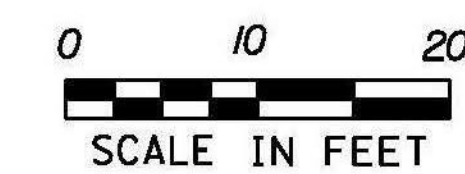

PROJECT NAME: RANDOLPH
PROJECT NUMBER: STP 2932 (1)

FILE NAME: z10c270.dgn
PROJECT LEADER: C. LATHROP
DESIGNED BY: B. BRESLEND
VT 66 CROSS SECTION SHEET 18

PLOT DATE: 6/5/2014
DRAWN BY: B. BRESLEND
CHECKED BY: C. LATHROP
SHEET 174 OF 276