




DRIVE RT
99+50

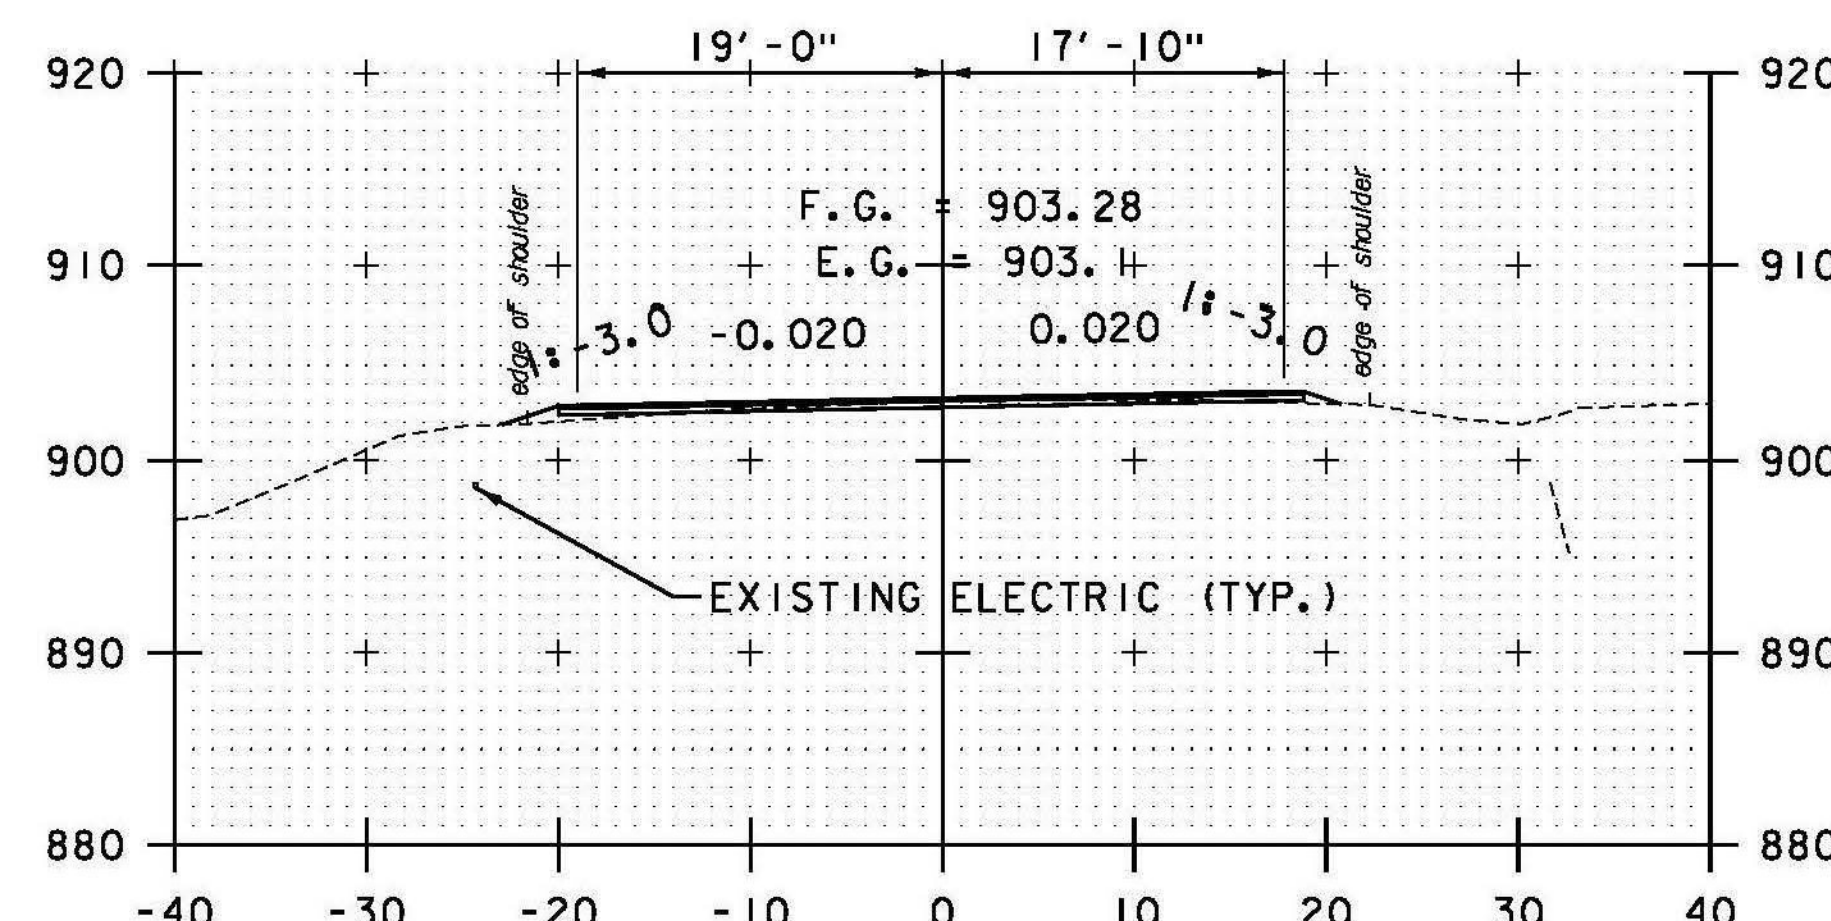


99+00

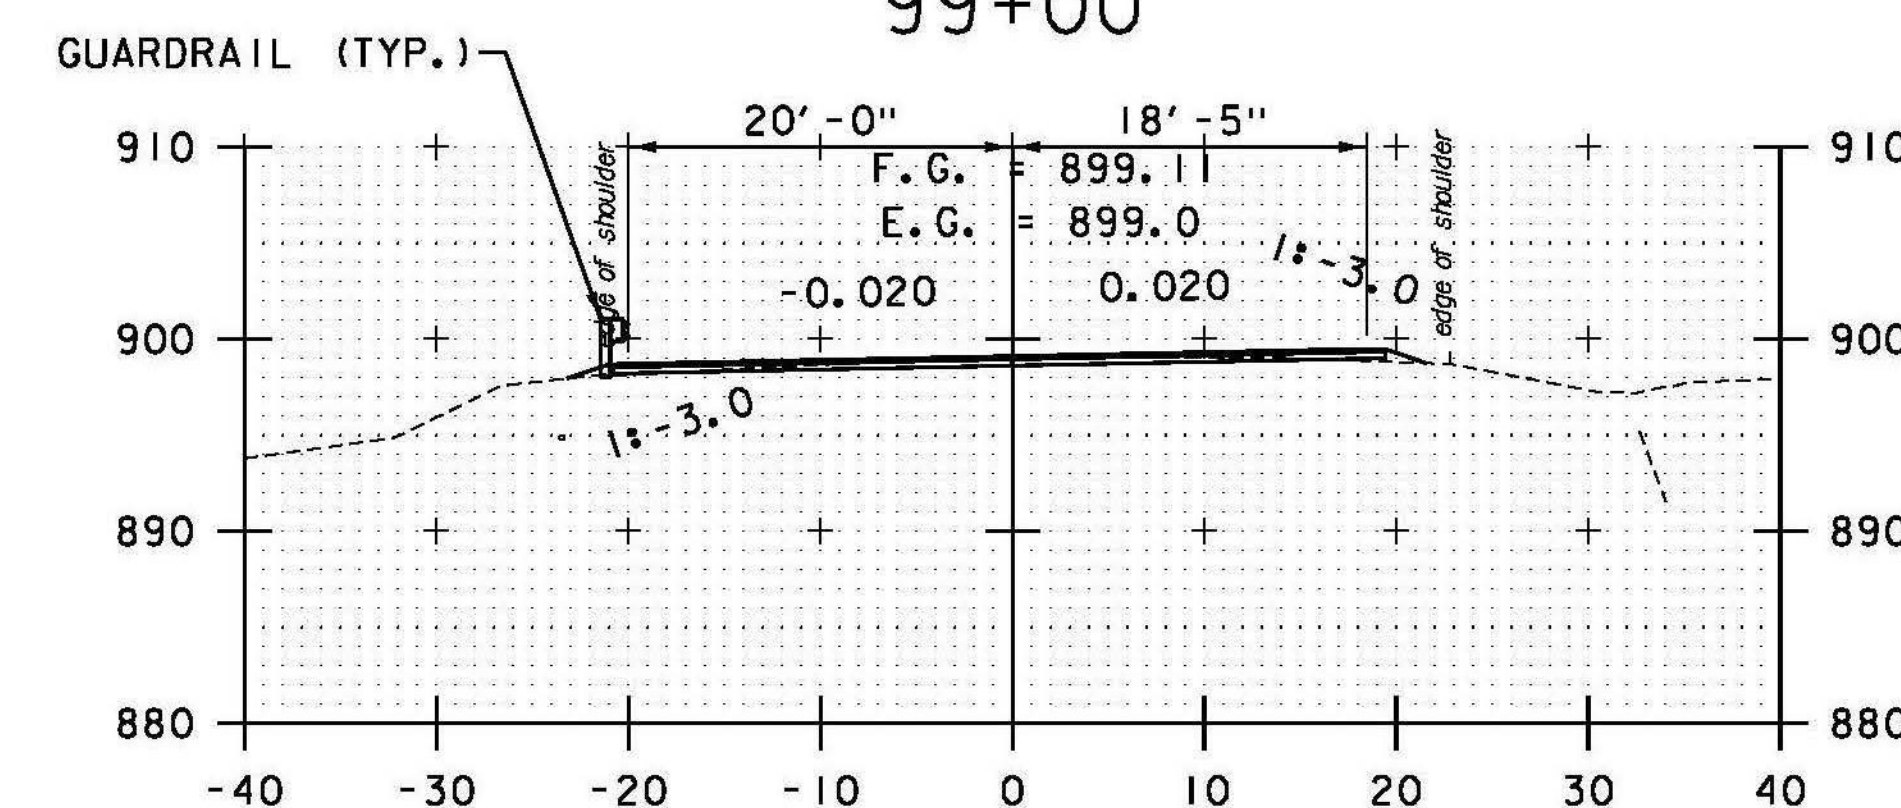


98+50

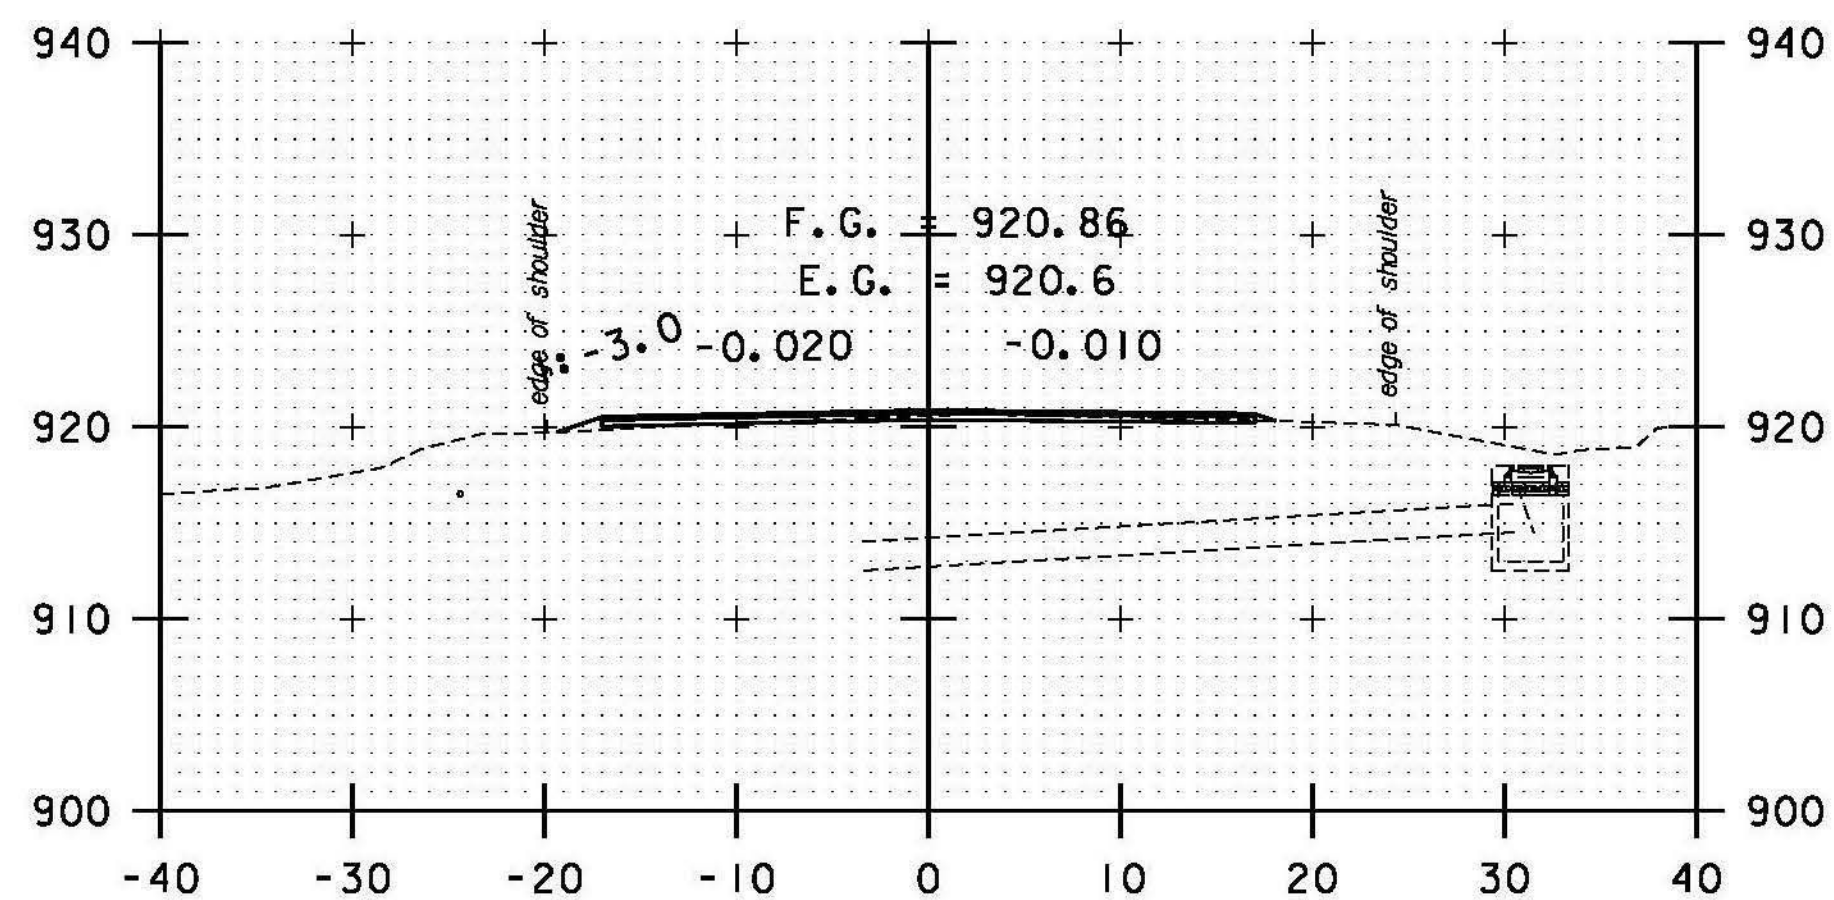


101+00

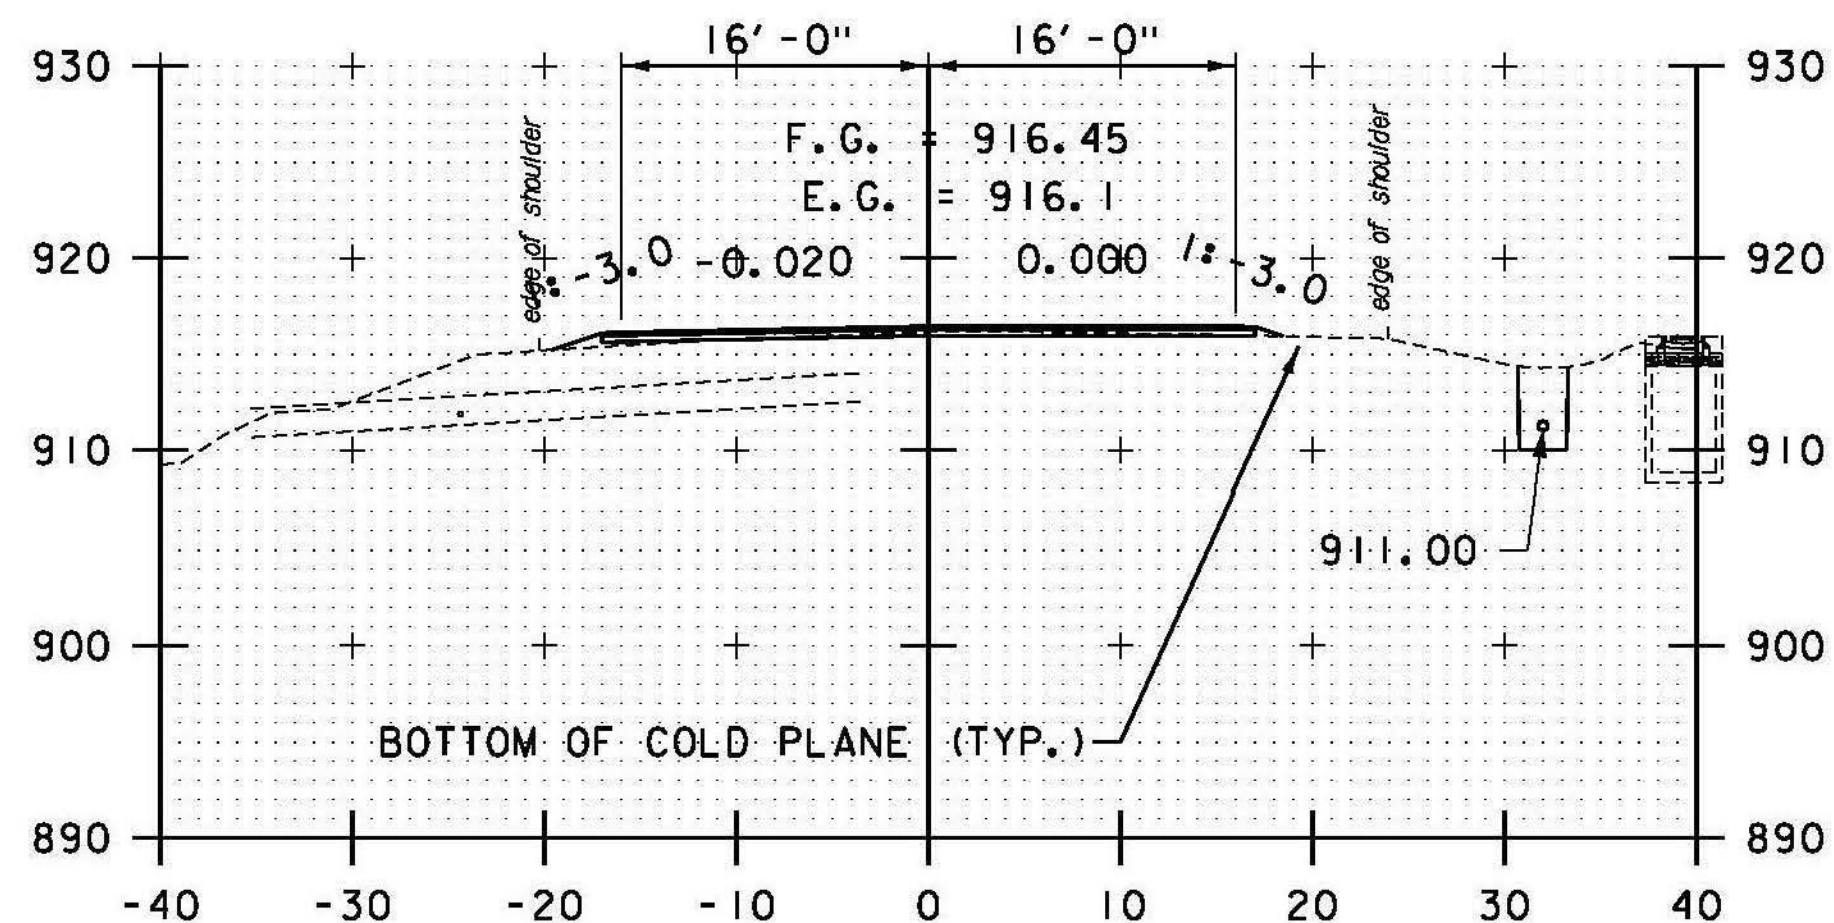


100+50

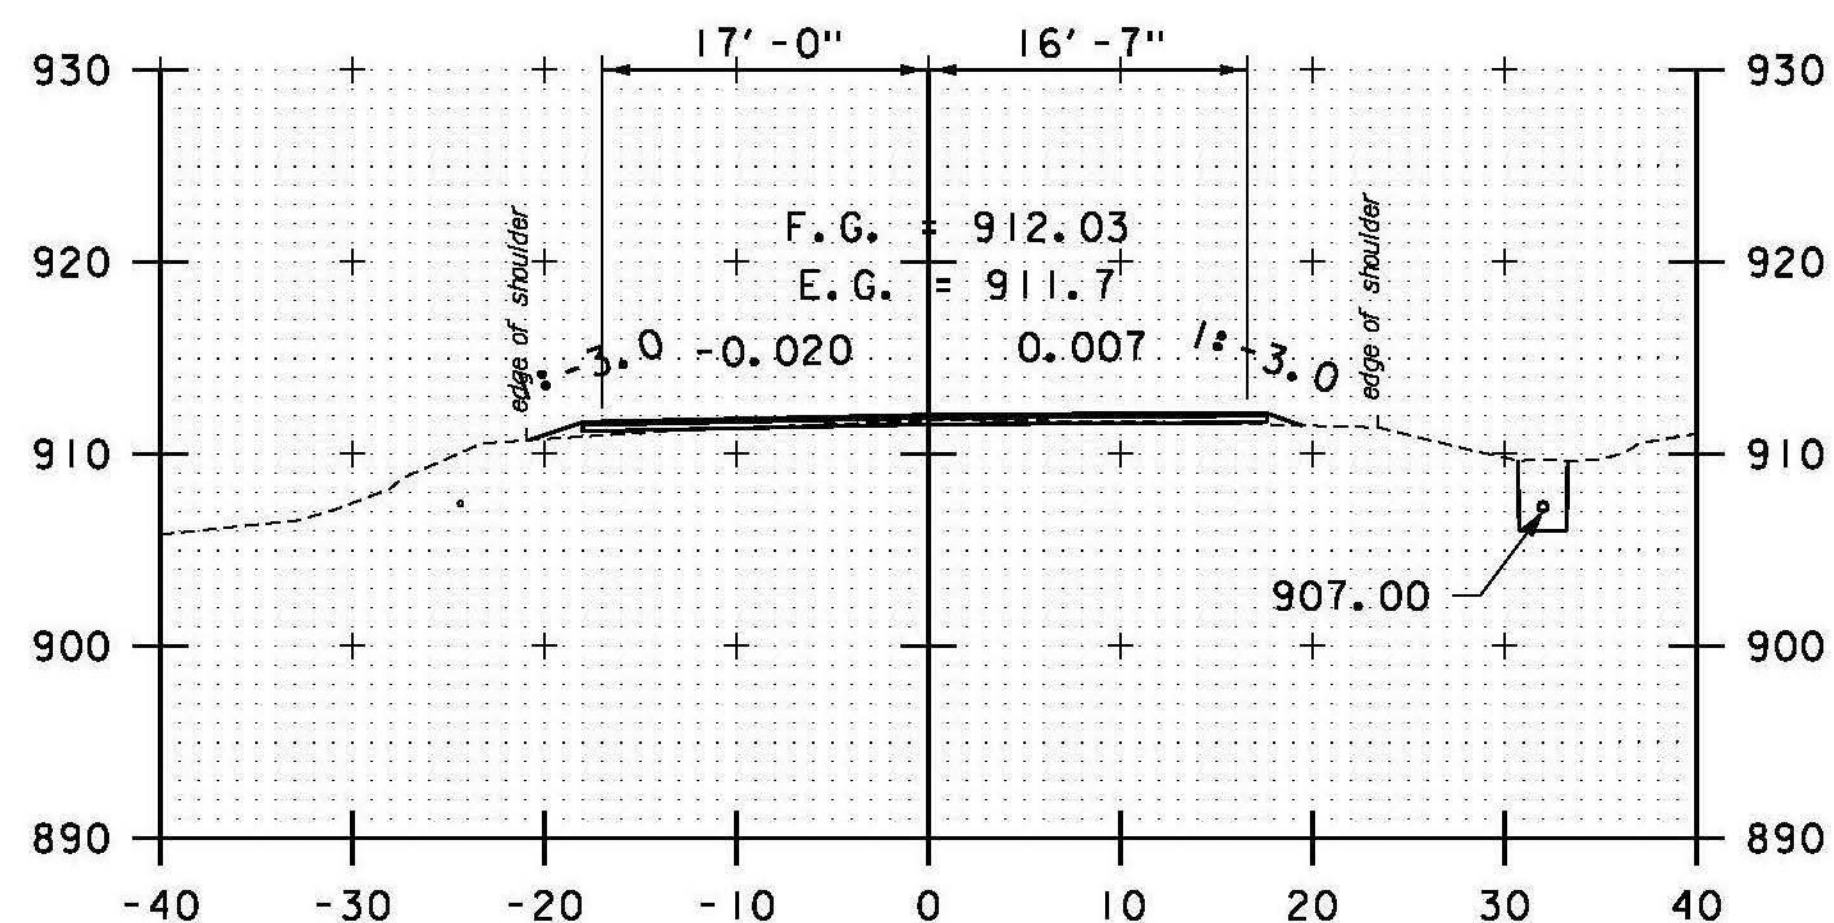


100+00

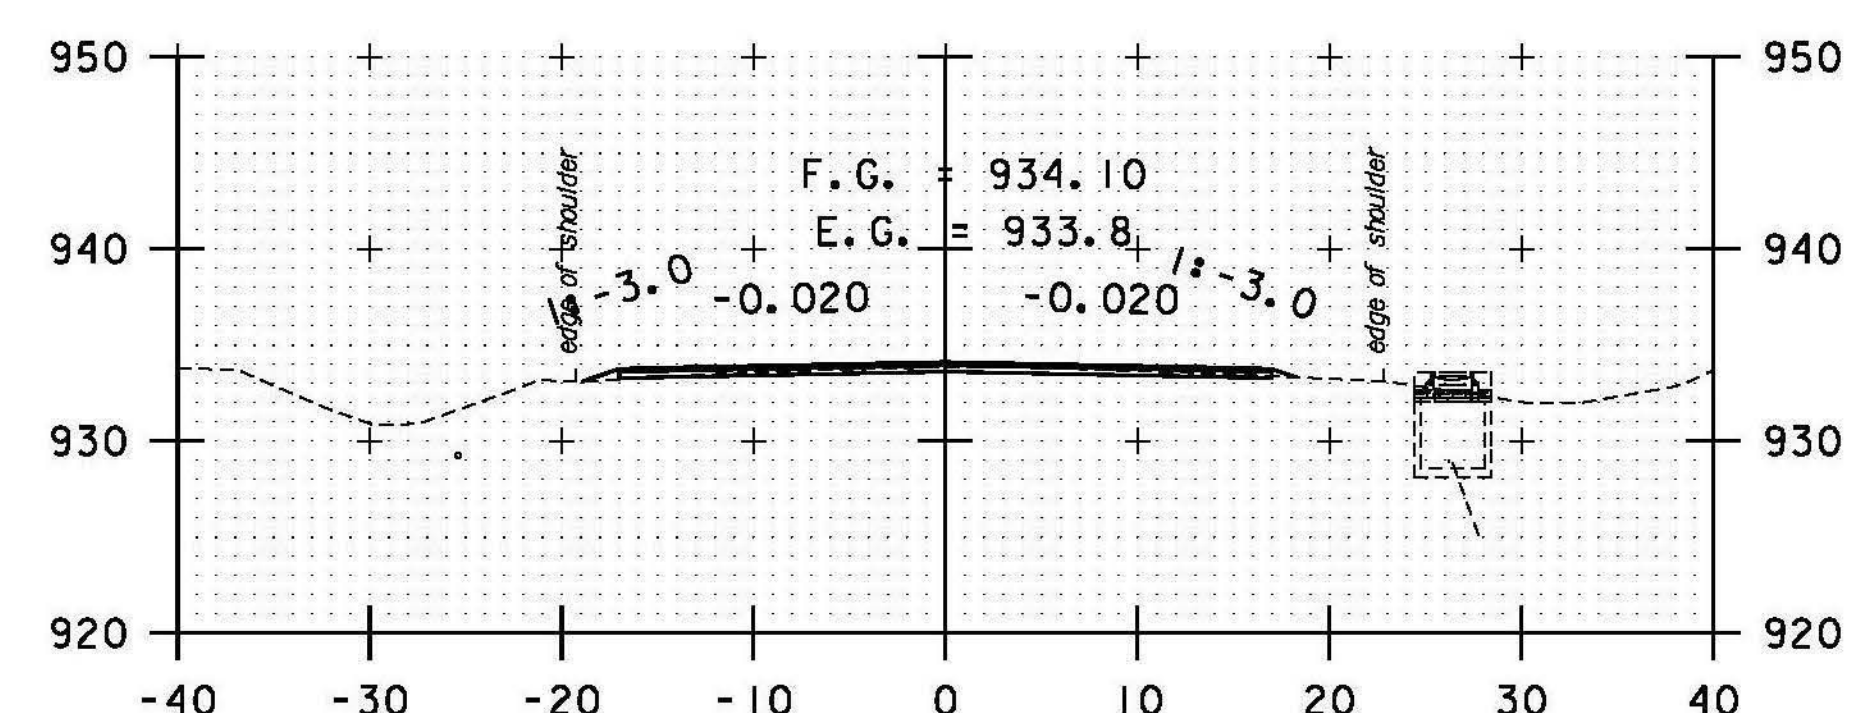

102+50

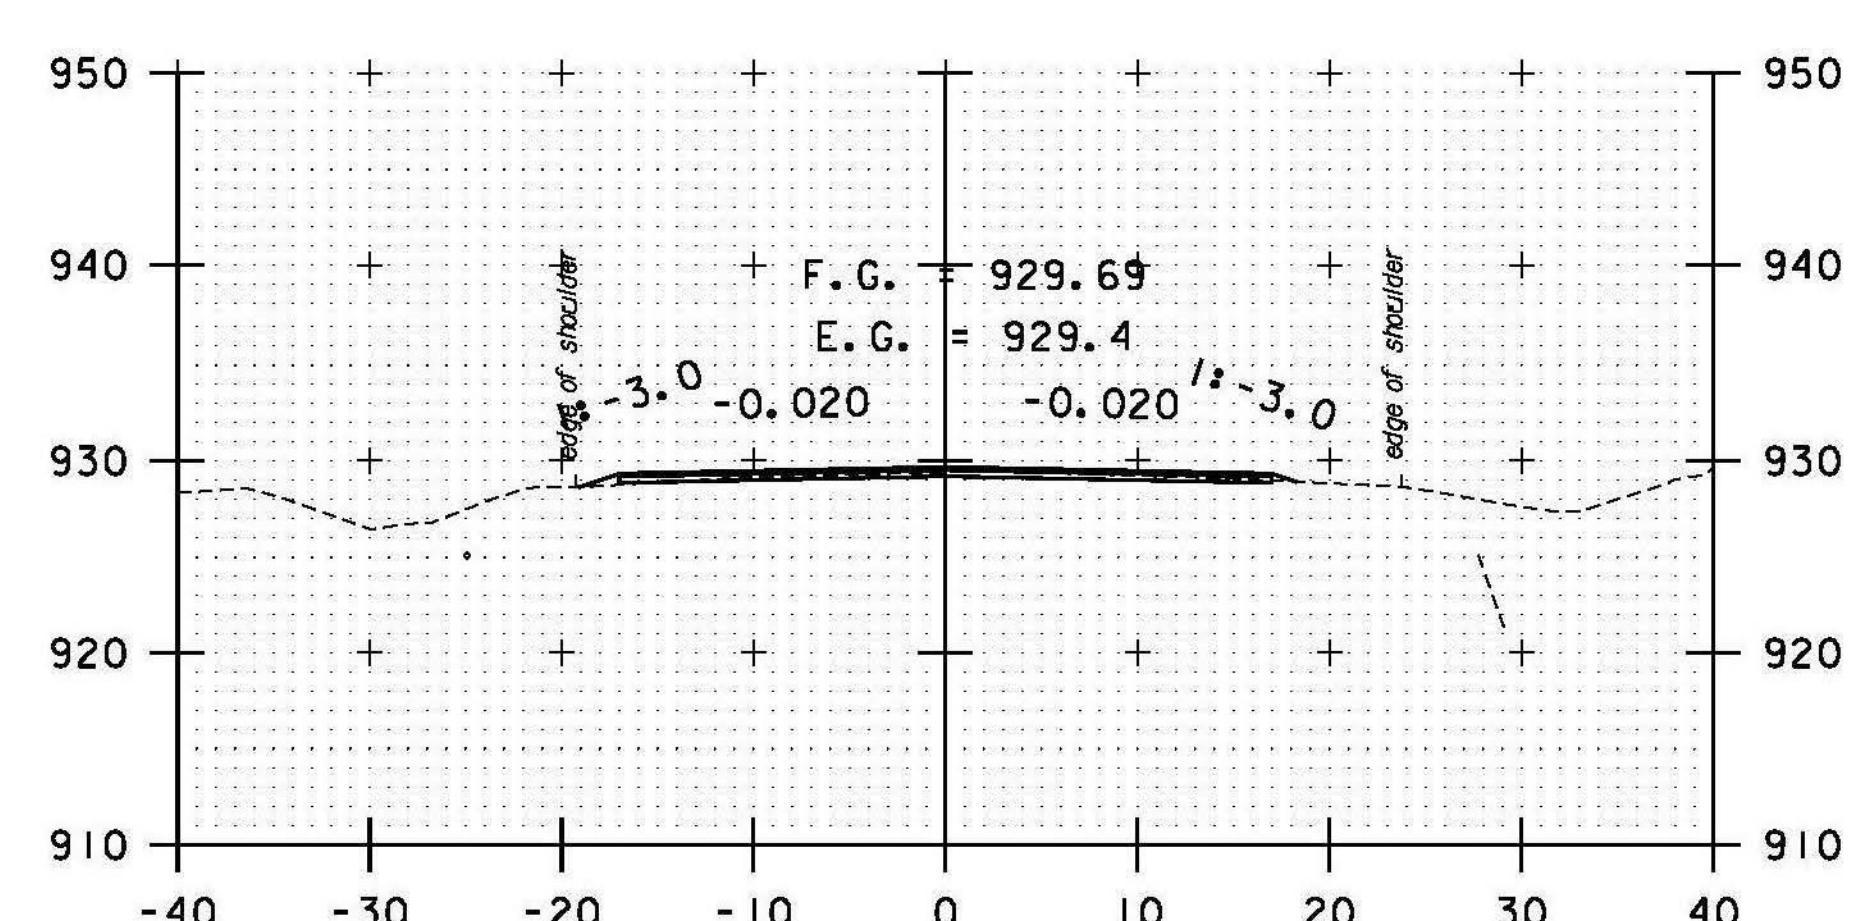


102+00

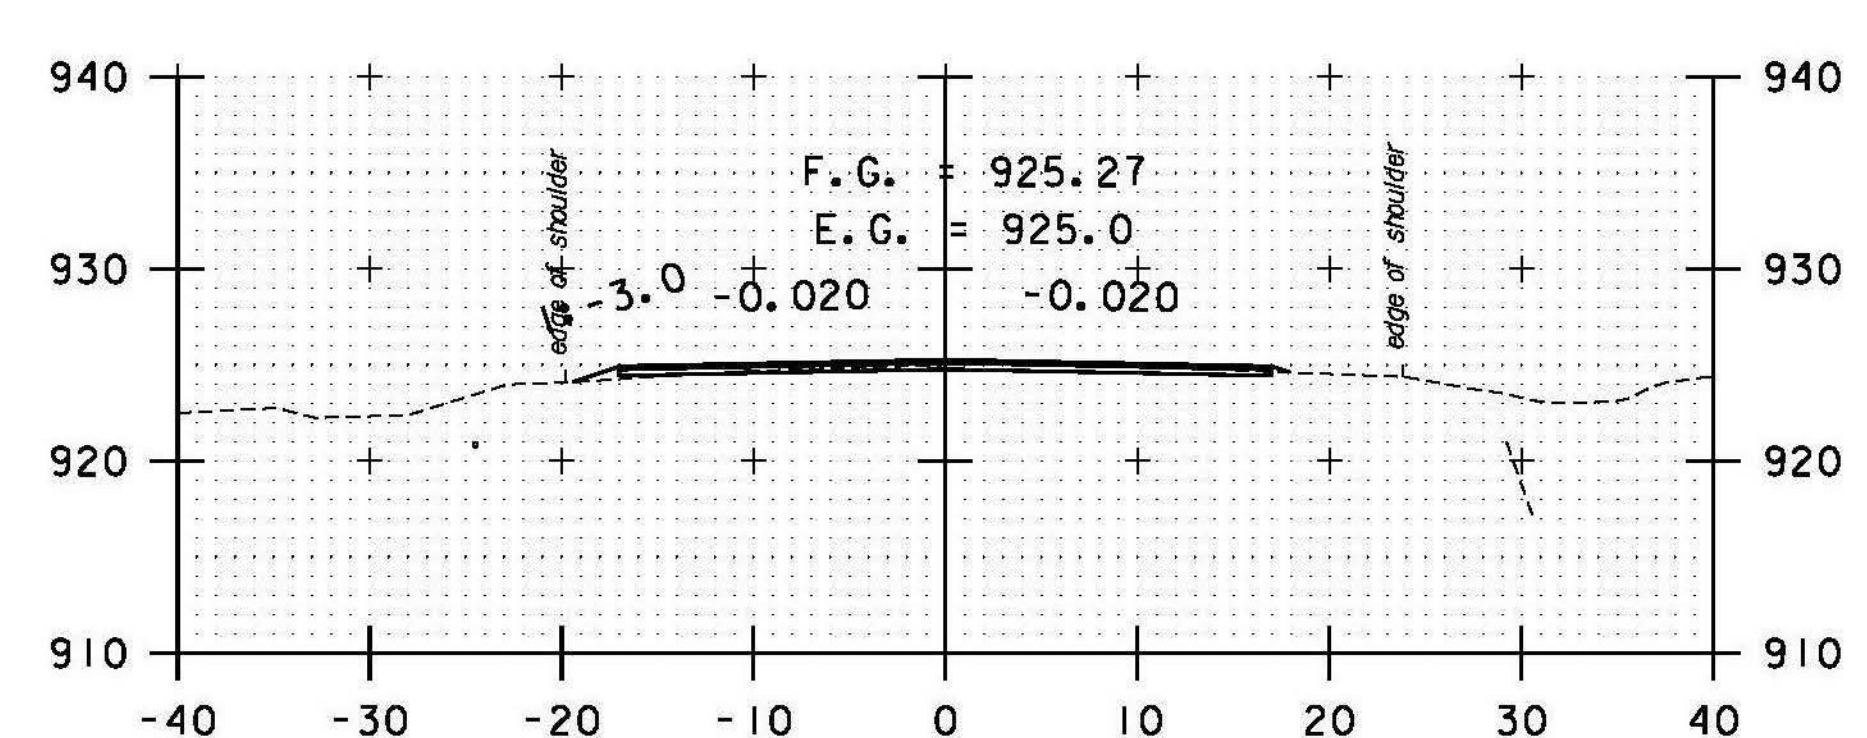

101+50

STA. 98+50 TO STA. 102+50

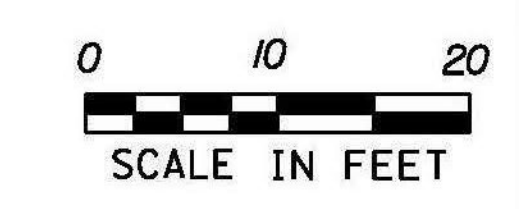

DATUM
VERTICAL NAVD 88
HORIZONTAL NAD 83 (07)

PROJECT NAME: RANDOLPH
PROJECT NUMBER: STP 2932 (1)
FILE NAME: z10c270.dgn
PROJECT LEADER: C. LATHROP
DESIGNED BY: B. BRESLEND
VT 66 CROSS SECTION SHEET 19
PLOT DATE: 6/5/2014
DRAWN BY: B. BRESLEND
CHECKED BY: C. LATHROP
SHEET 175 OF 276