




117+50

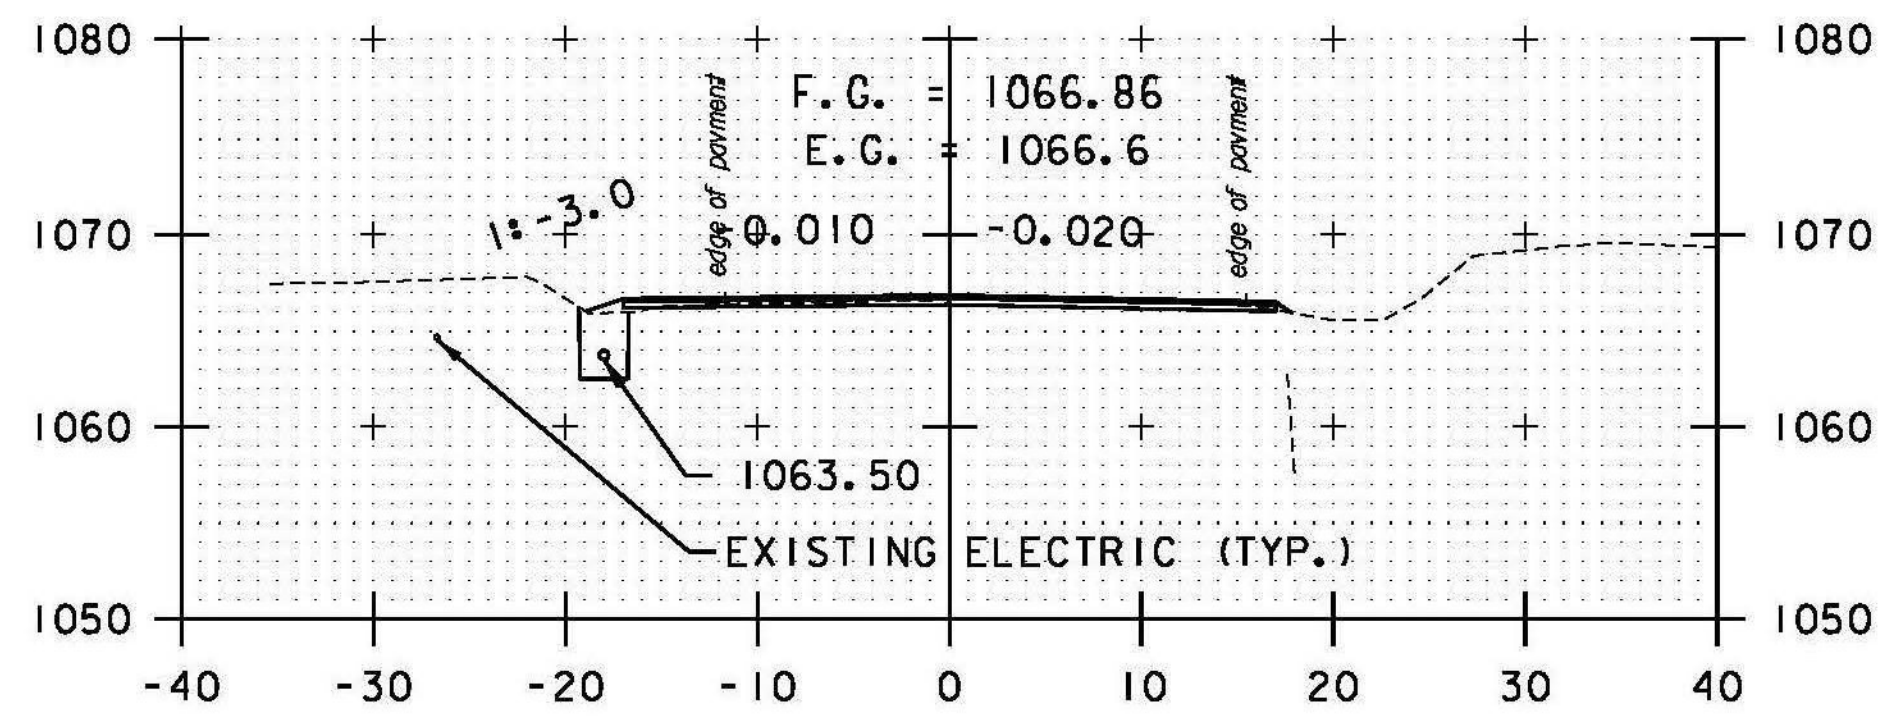


117+00

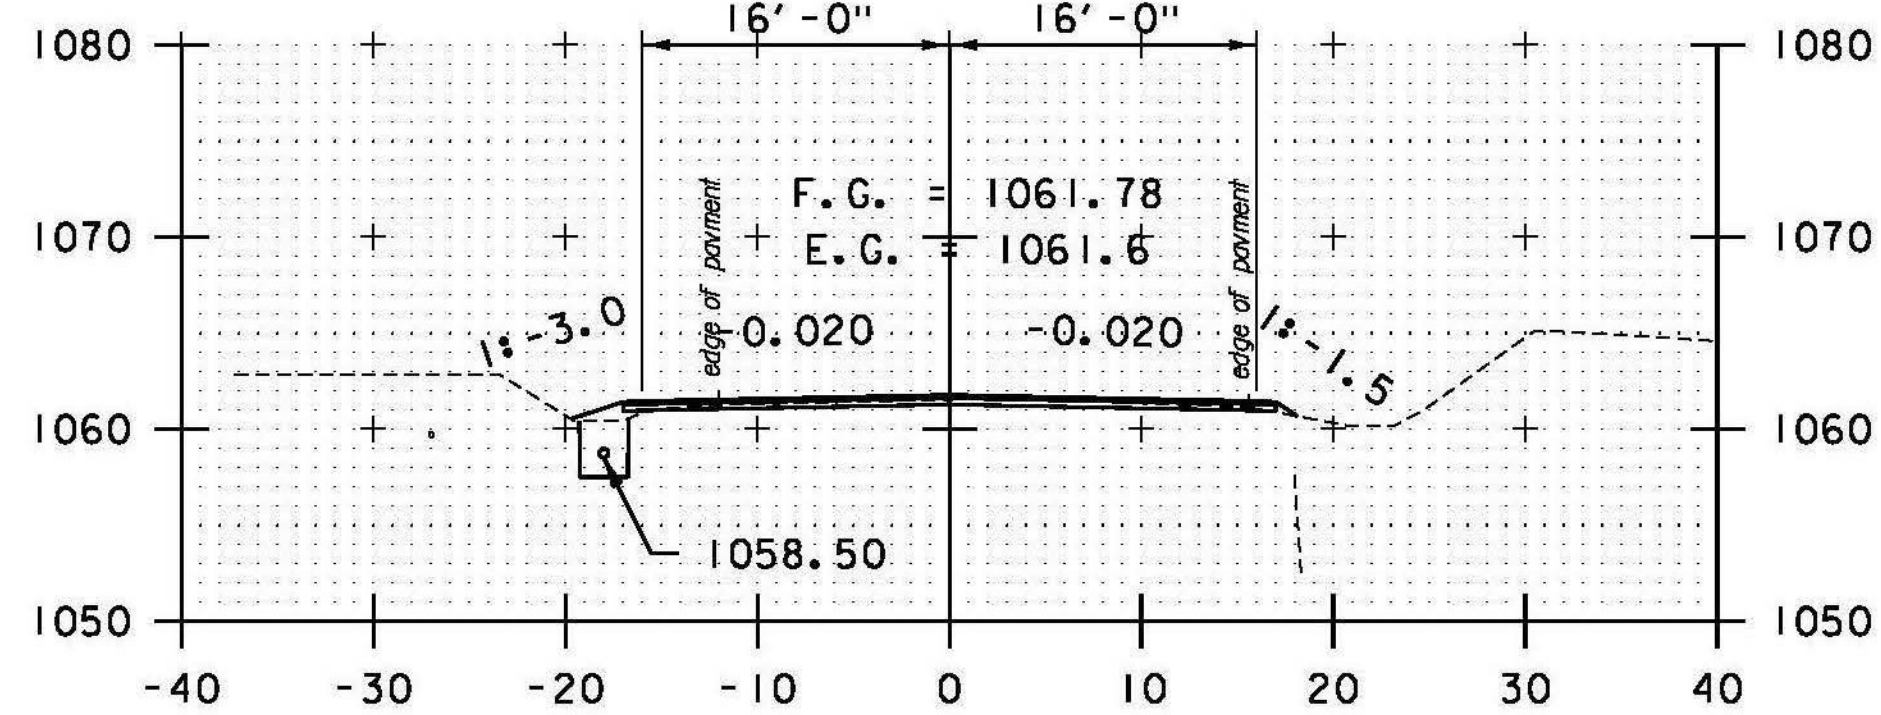


116+50

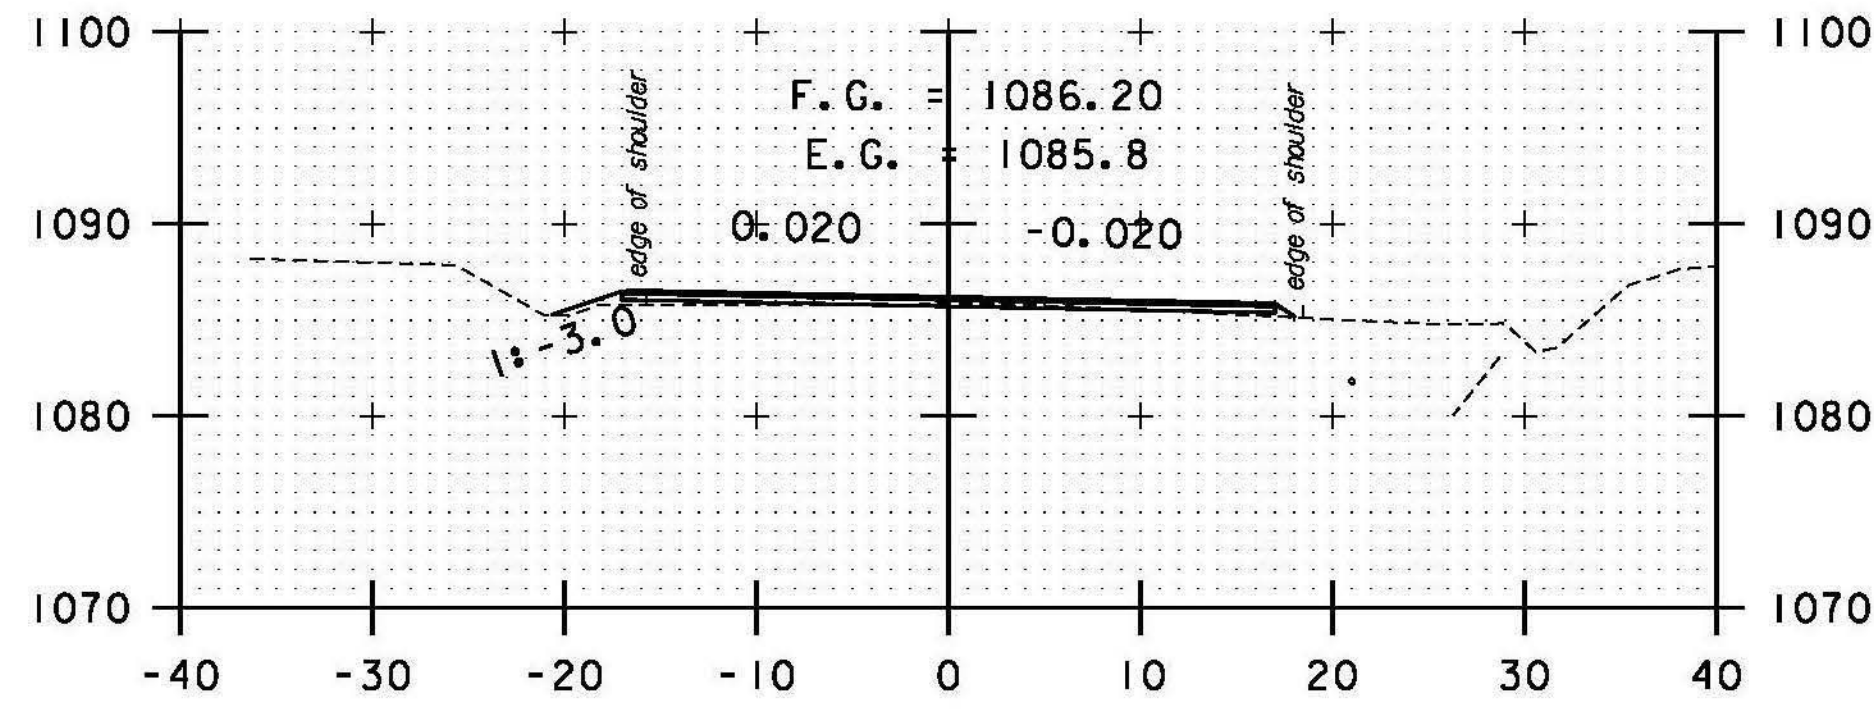


119+00

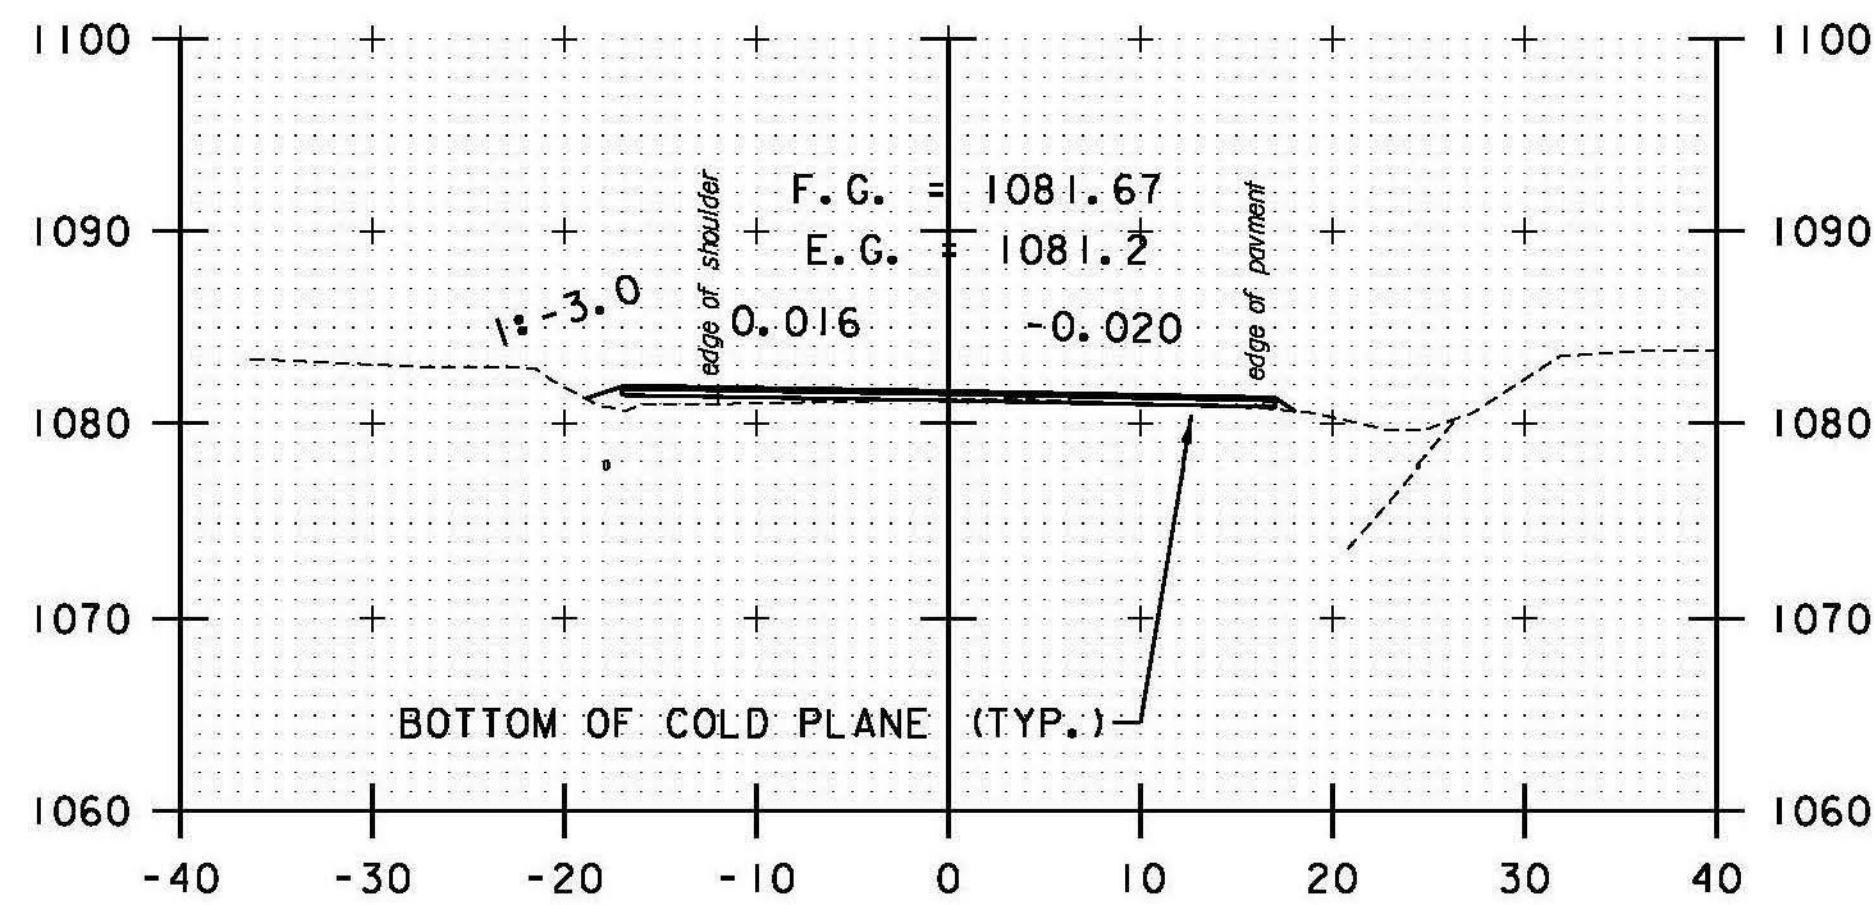


118+50

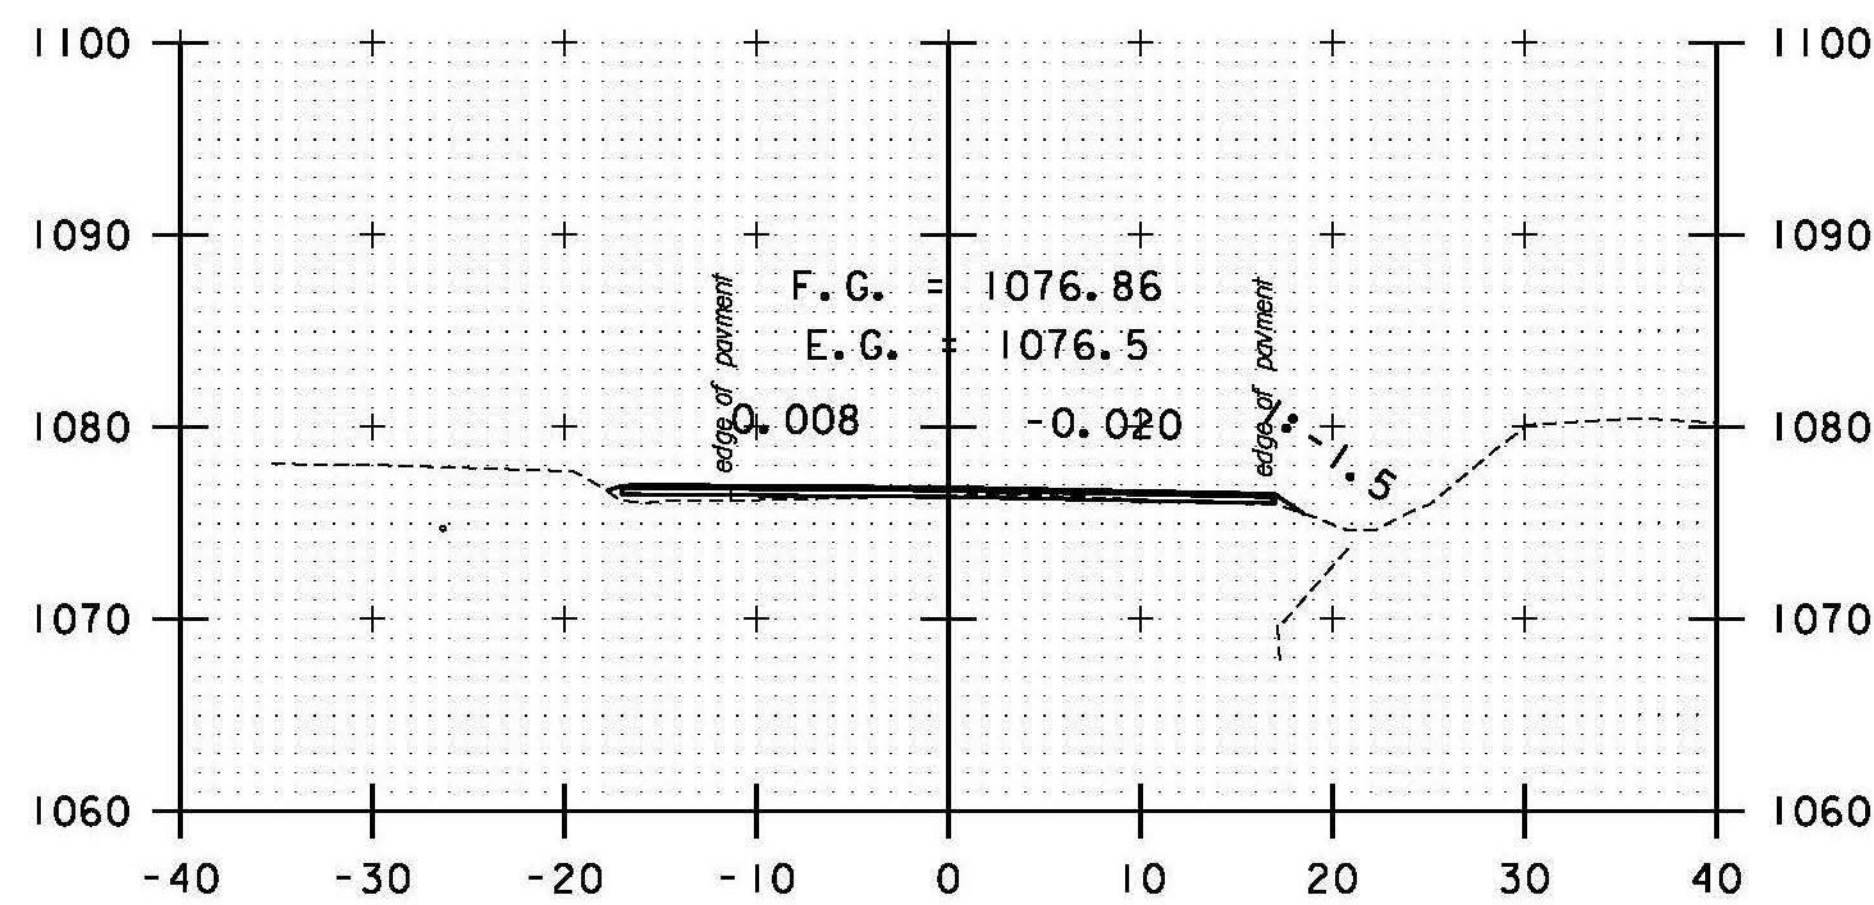


118+00

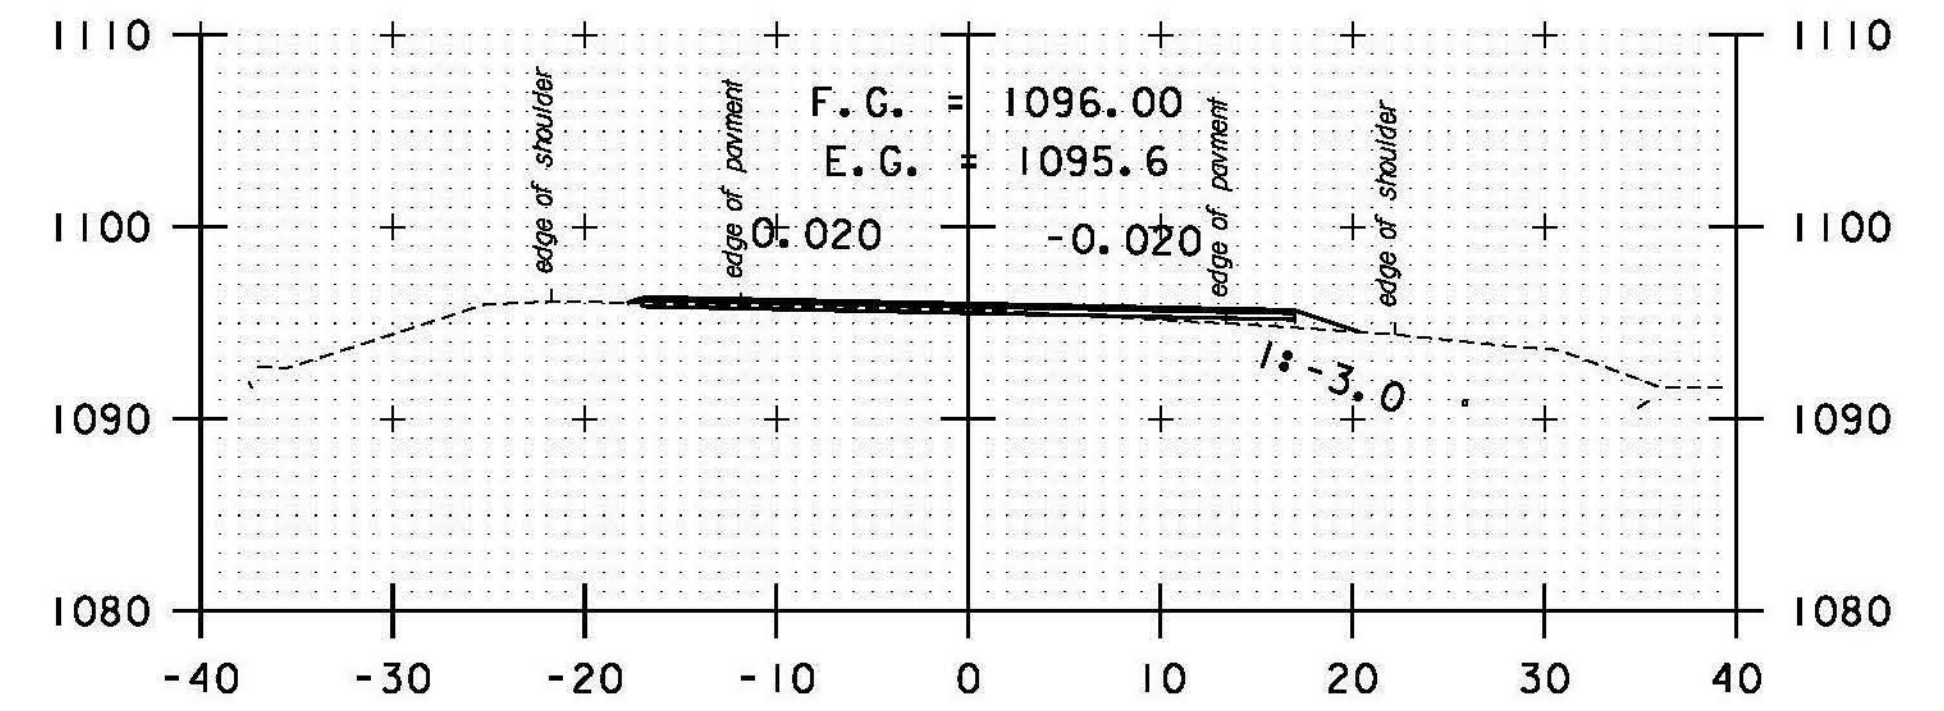

120+50

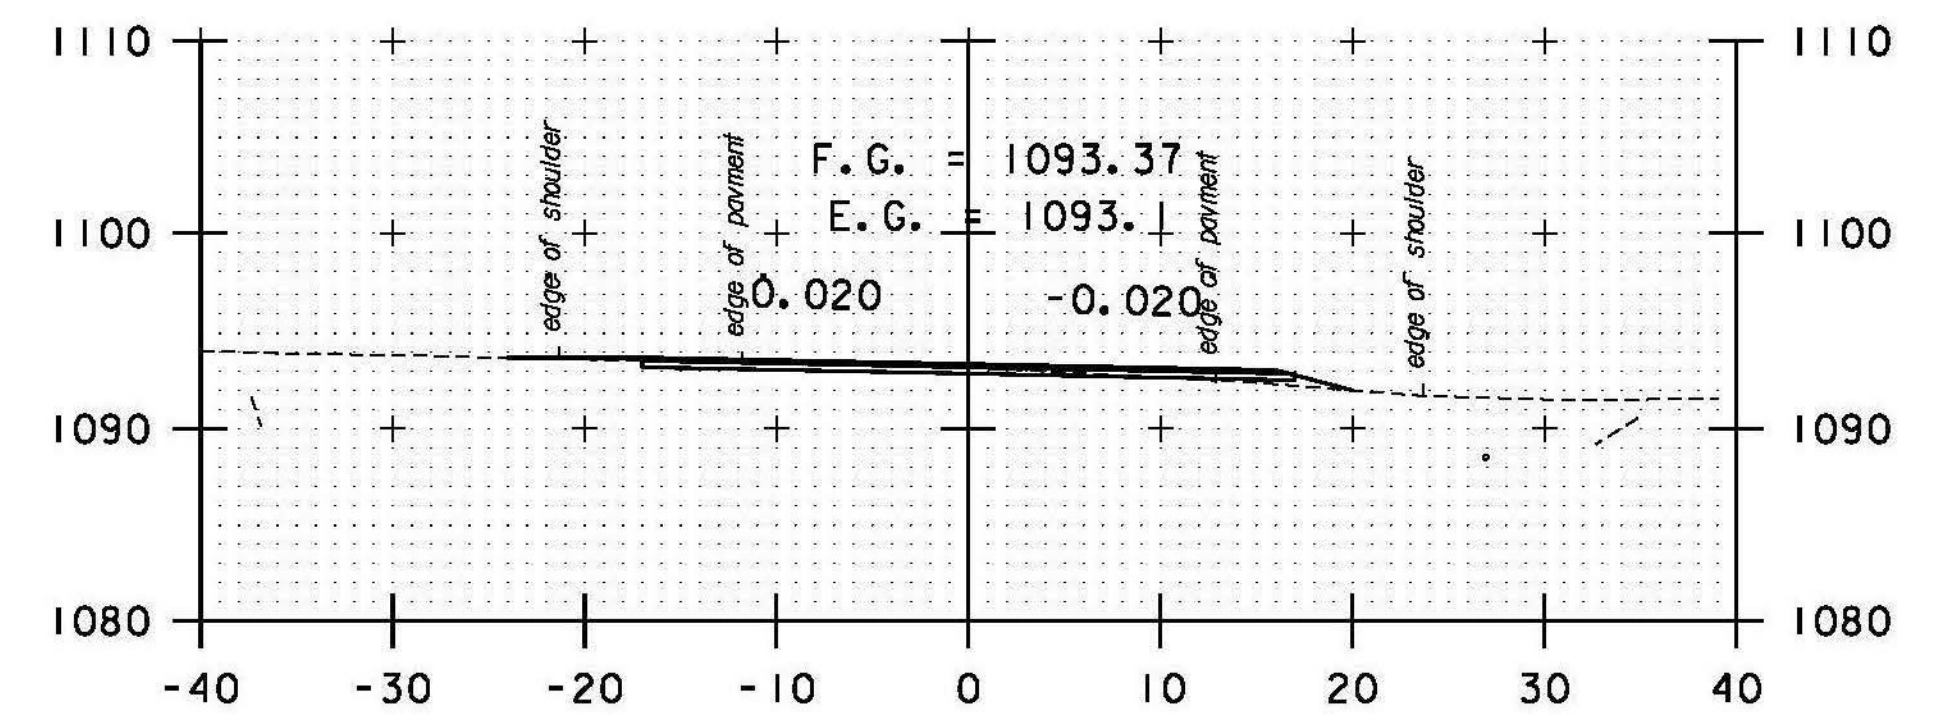


DRIVE LT / RT  
120+00

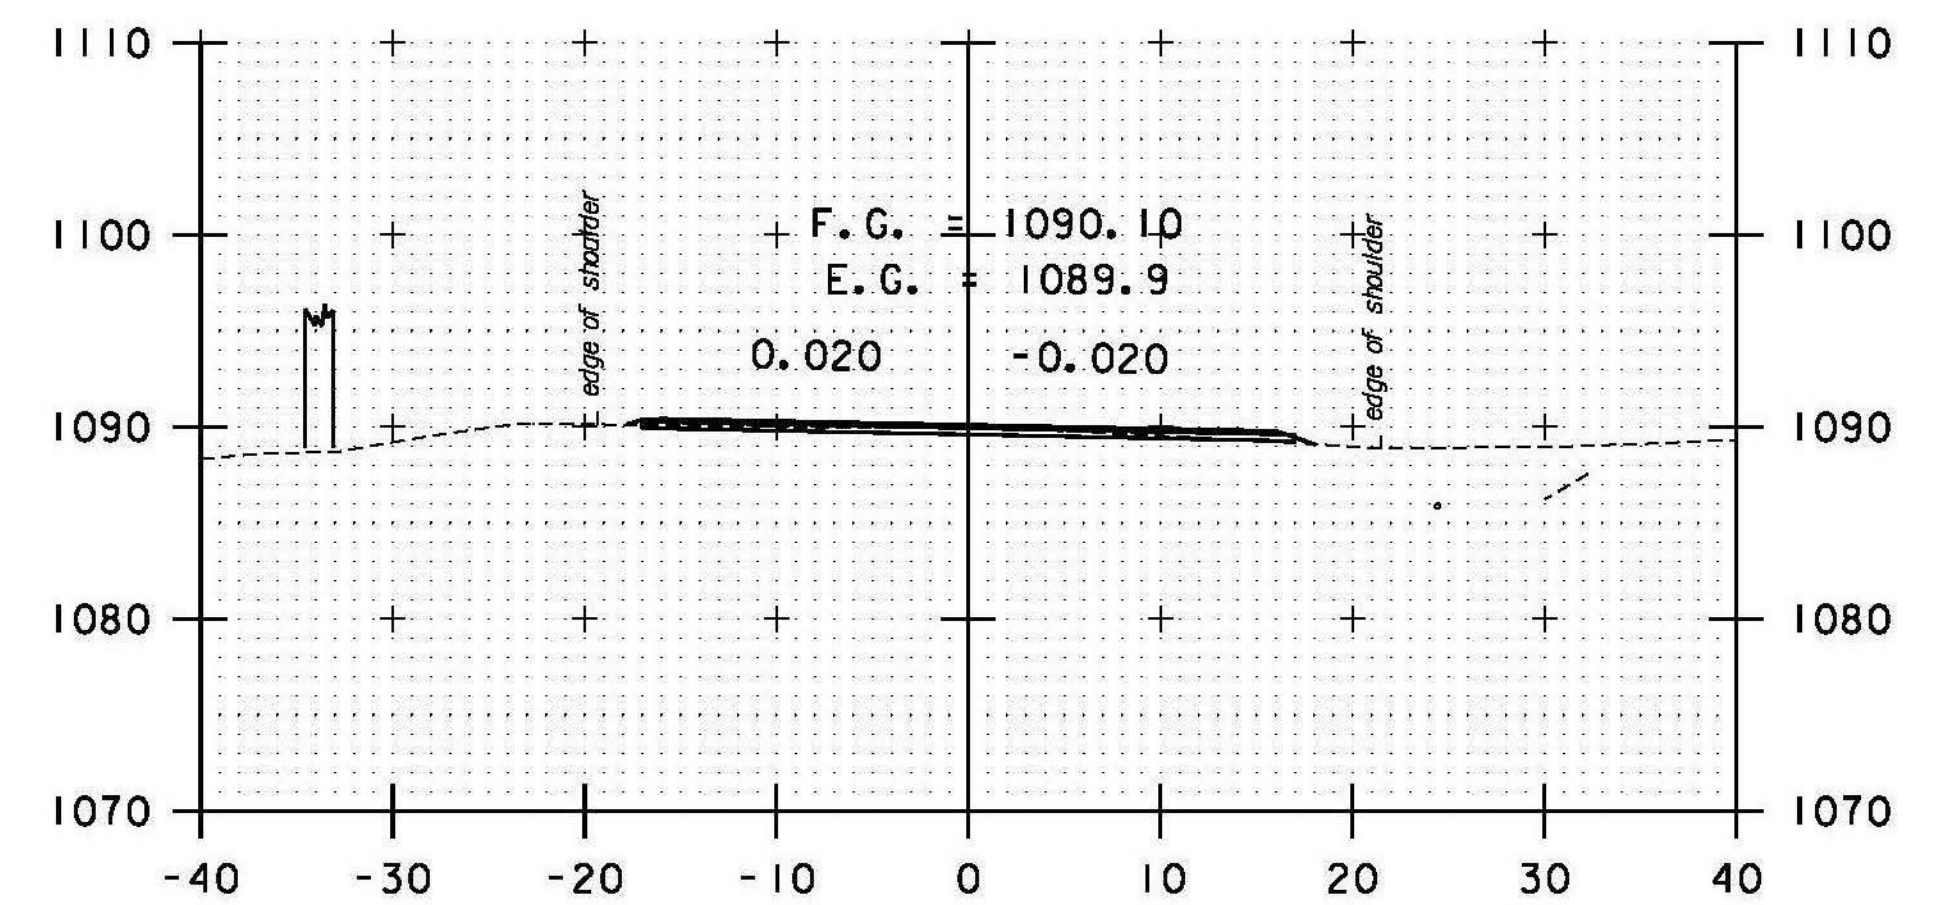

DRIVE RT  
119+50

STA. 116+50 TO STA. 120+50

DATUM  
VERTICAL NAVD 88  
HORIZONTAL NAD 83 (07)

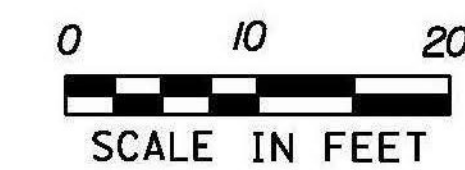

PROJECT NAME: RANDOLPH  
PROJECT NUMBER: STP 2932 (1)

FILE NAME: z10c270.dgn  
PROJECT LEADER: C. LATHROP  
DESIGNED BY: B. BRESLEND  
VT 66 CROSS SECTION SHEET 23

PLOT DATE: 6/5/2014  
DRAWN BY: B. BRESLEND  
CHECKED BY: C. LATHROP  
SHEET 179 OF 276