



TH#46 LT  
139+18

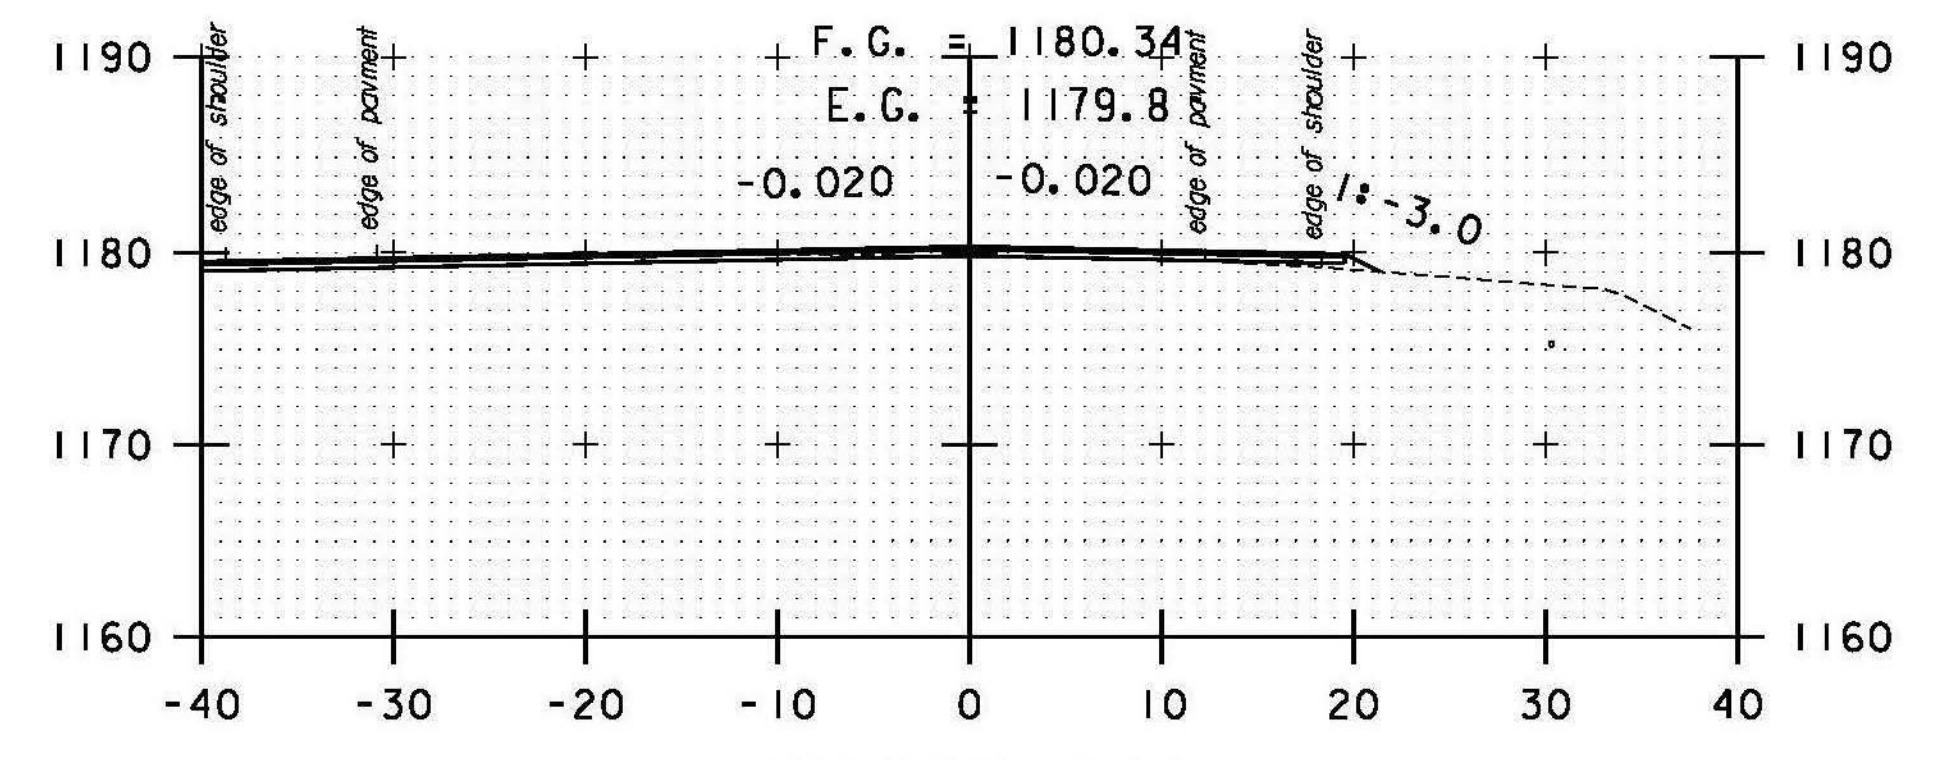


TH#46 LT  
139+00

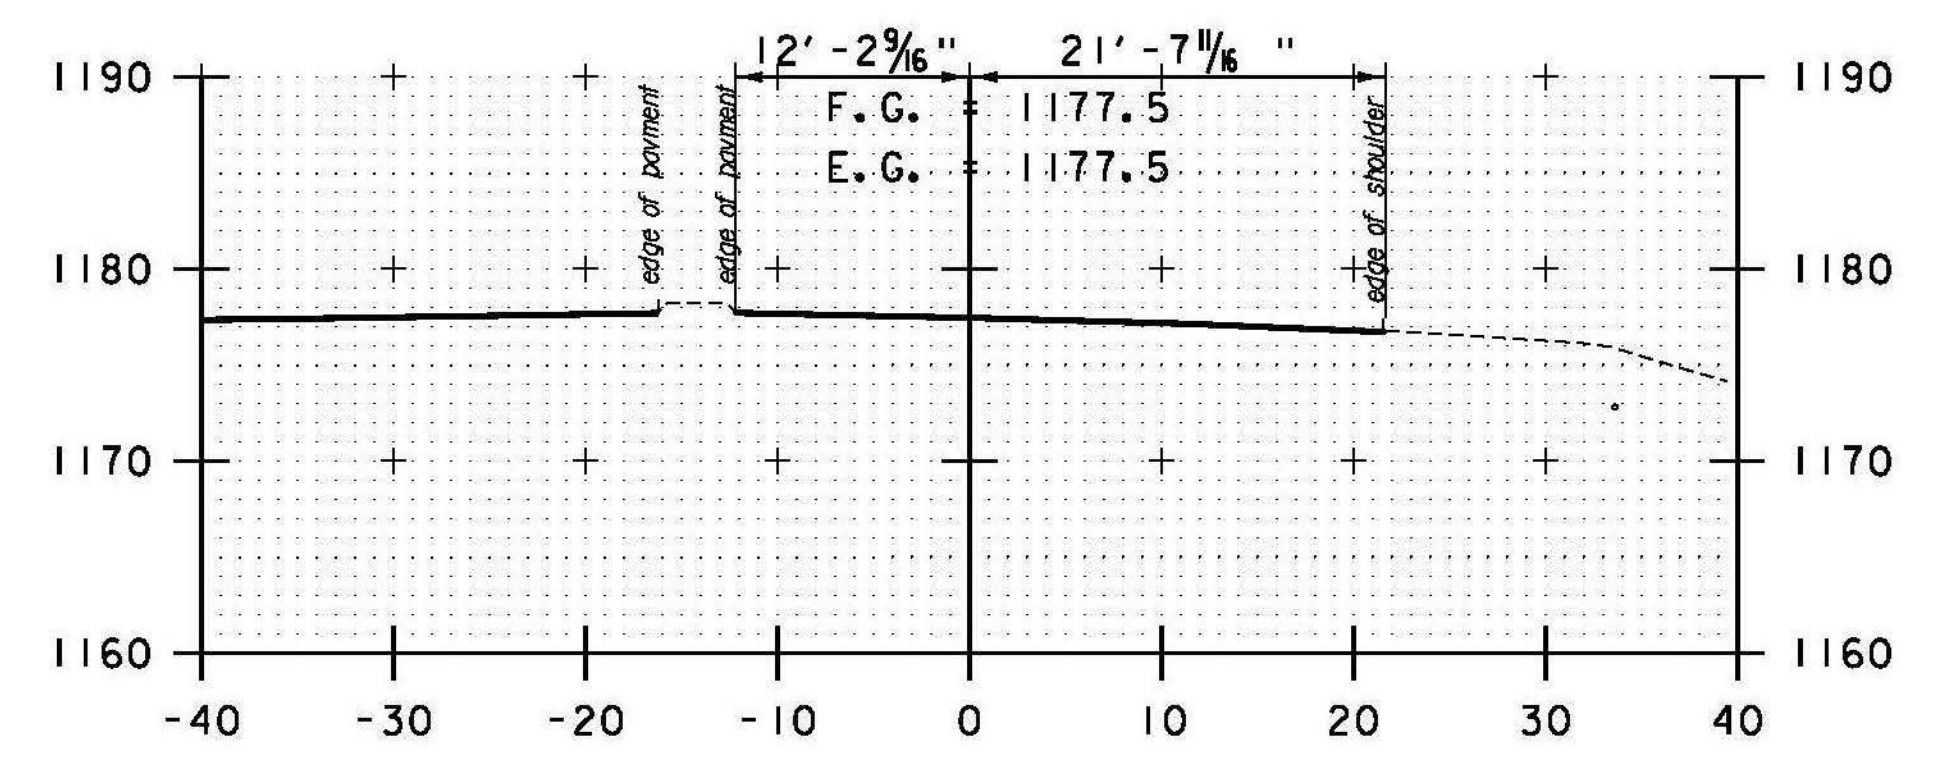

END MILL/FILL / BEGIN TRANSITION / MATCH EXISTING  
138+50

STA. 138+50 TO STA. 139+18

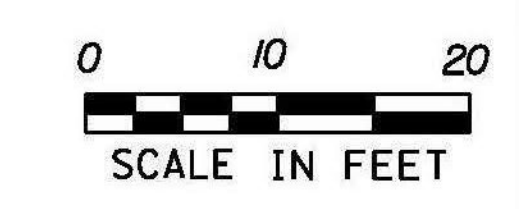

PROJECT NAME: RANDOLPH	
PROJECT NUMBER: STP 2932 (1)	
FILE NAME: z10c270.dgn	PLOT DATE: 6/5/2014
PROJECT LEADER: C. LATHROP	DRAWN BY: B. BRESLEND
DESIGNED BY: B. BRESLEND	CHECKED BY: C. LATHROP
VT 66 CROSS SECTION SHEET 25	SHEET 181 OF 276

DATUM	
VERTICAL	NAVD 88
HORIZONTAL	NAD 83 (07)