


RESUME RECLAIM / TH#46 LT  
139+50

141+00

142+50

STA. 139+50 TO STA. 143+50

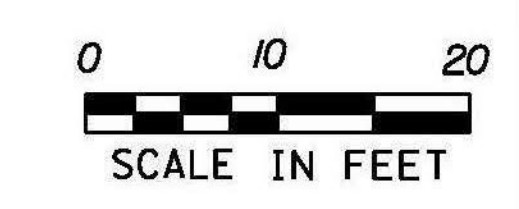

DATUM  
VERTICAL NAVD 88  
HORIZONTAL NAD 83 (07)

PROJECT NAME: RANDOLPH  
PROJECT NUMBER: STP 2932 (1)  
FILE NAME: z10c270.dgn  
PROJECT LEADER: C. LATHROP  
DESIGNED BY: B. BRESLEND  
VT 66 CROSS SECTION SHEET 26  
PLOT DATE: 6/5/2014  
DRAWN BY: B. BRESLEND  
CHECKED BY: C. LATHROP  
SHEET 182 OF 276