


DRIVE LT
144+00

145+50

DRIVE RT
147+00

STA. 144+00 TO STA. 148+00

DATUM
VERTICAL NAVD 88
HORIZONTAL NAD 83 (07)

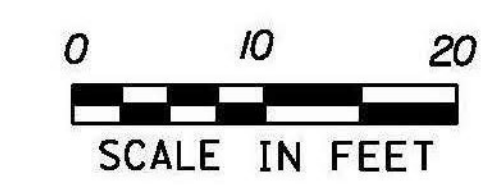

PROJECT NAME: RANDOLPH
PROJECT NUMBER: STP 2932 (1)
FILE NAME: z10c270.dgn
PROJECT LEADER: C. LATHROP
DESIGNED BY: B. BRESLEND
VT 66 CROSS SECTION SHEET 27
PLOT DATE: 6/5/2014
DRAWN BY: B. BRESLEND
CHECKED BY: C. LATHROP
SHEET 183 OF 276