




DRIVE LT
149+50

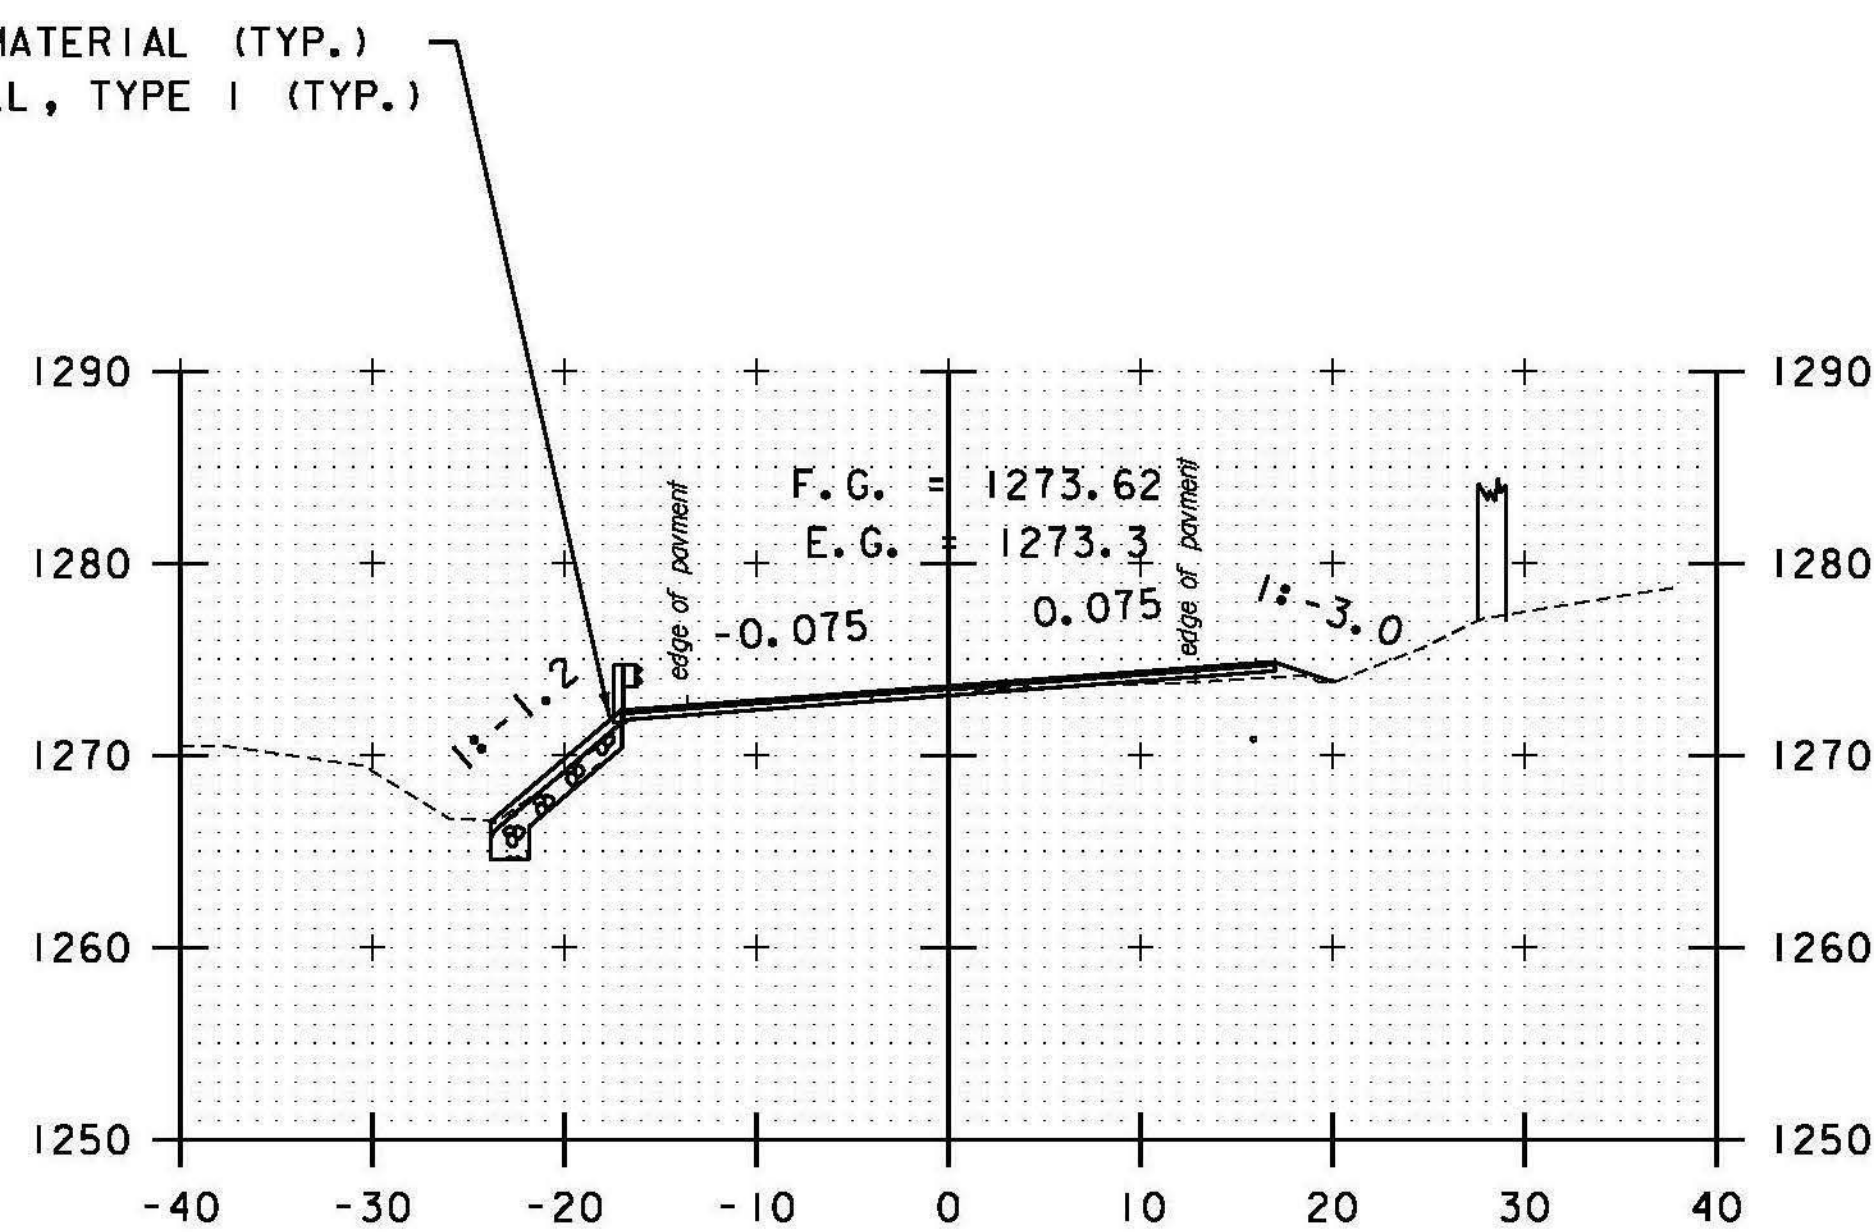


151+00

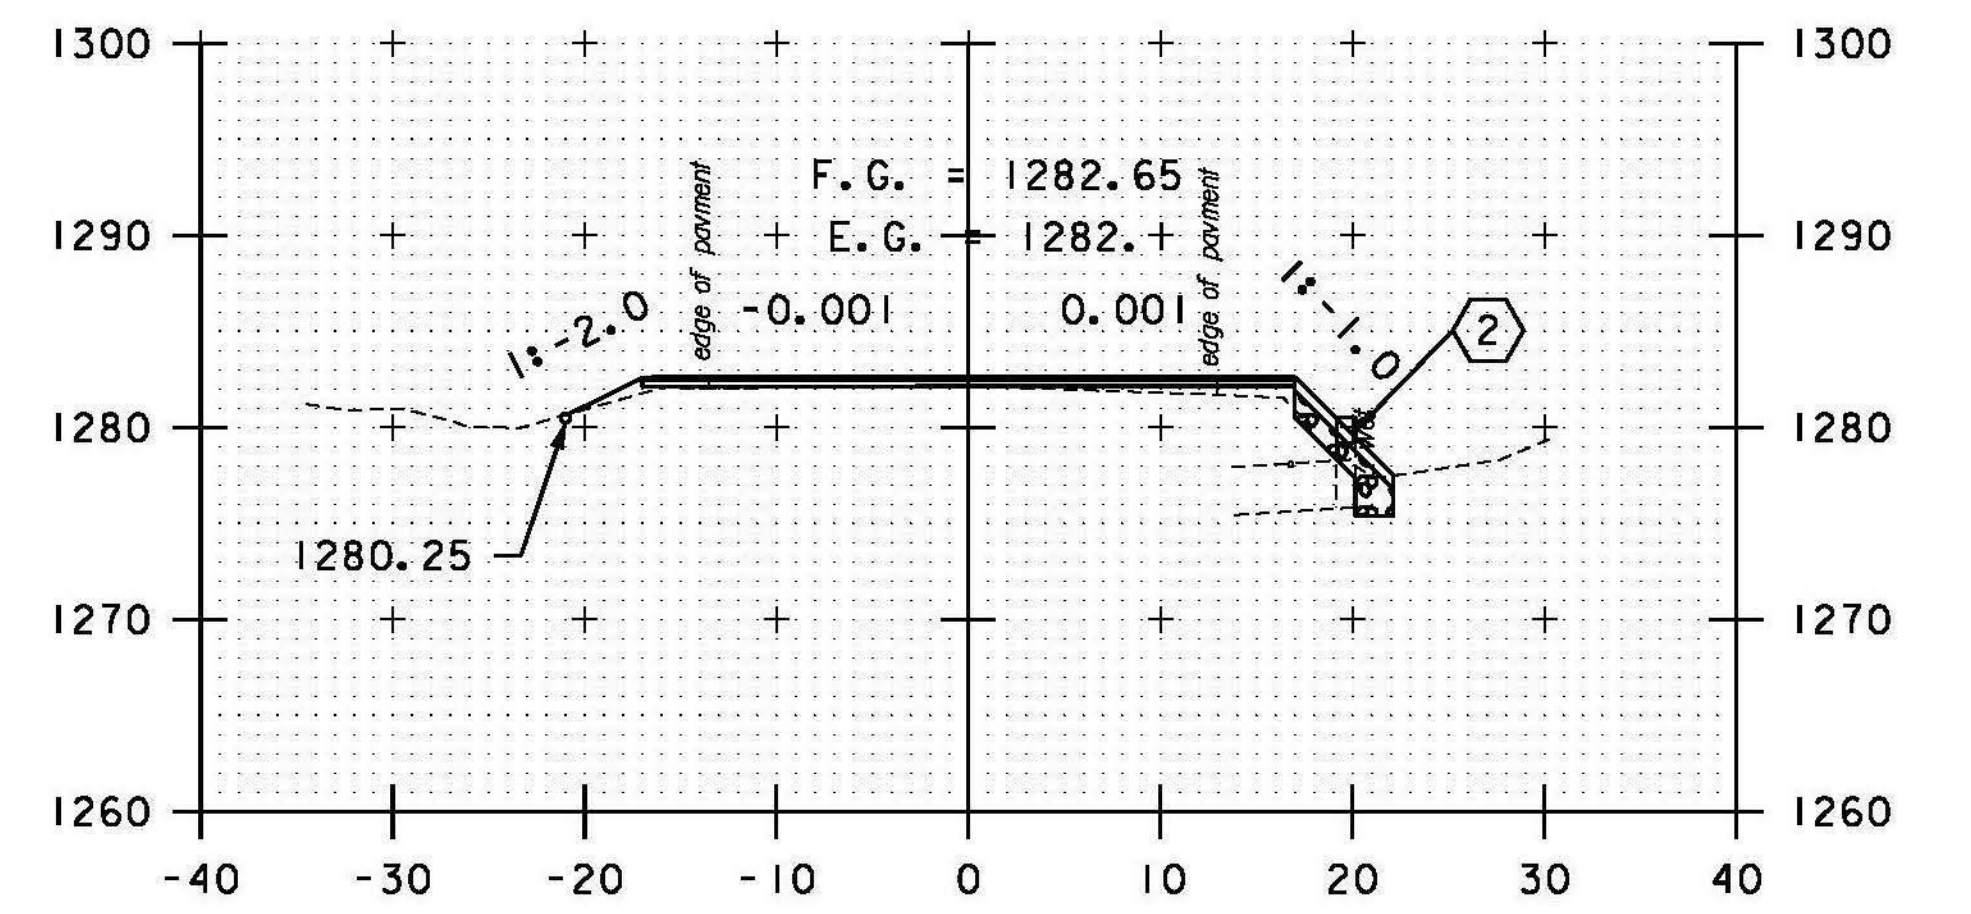


152+50

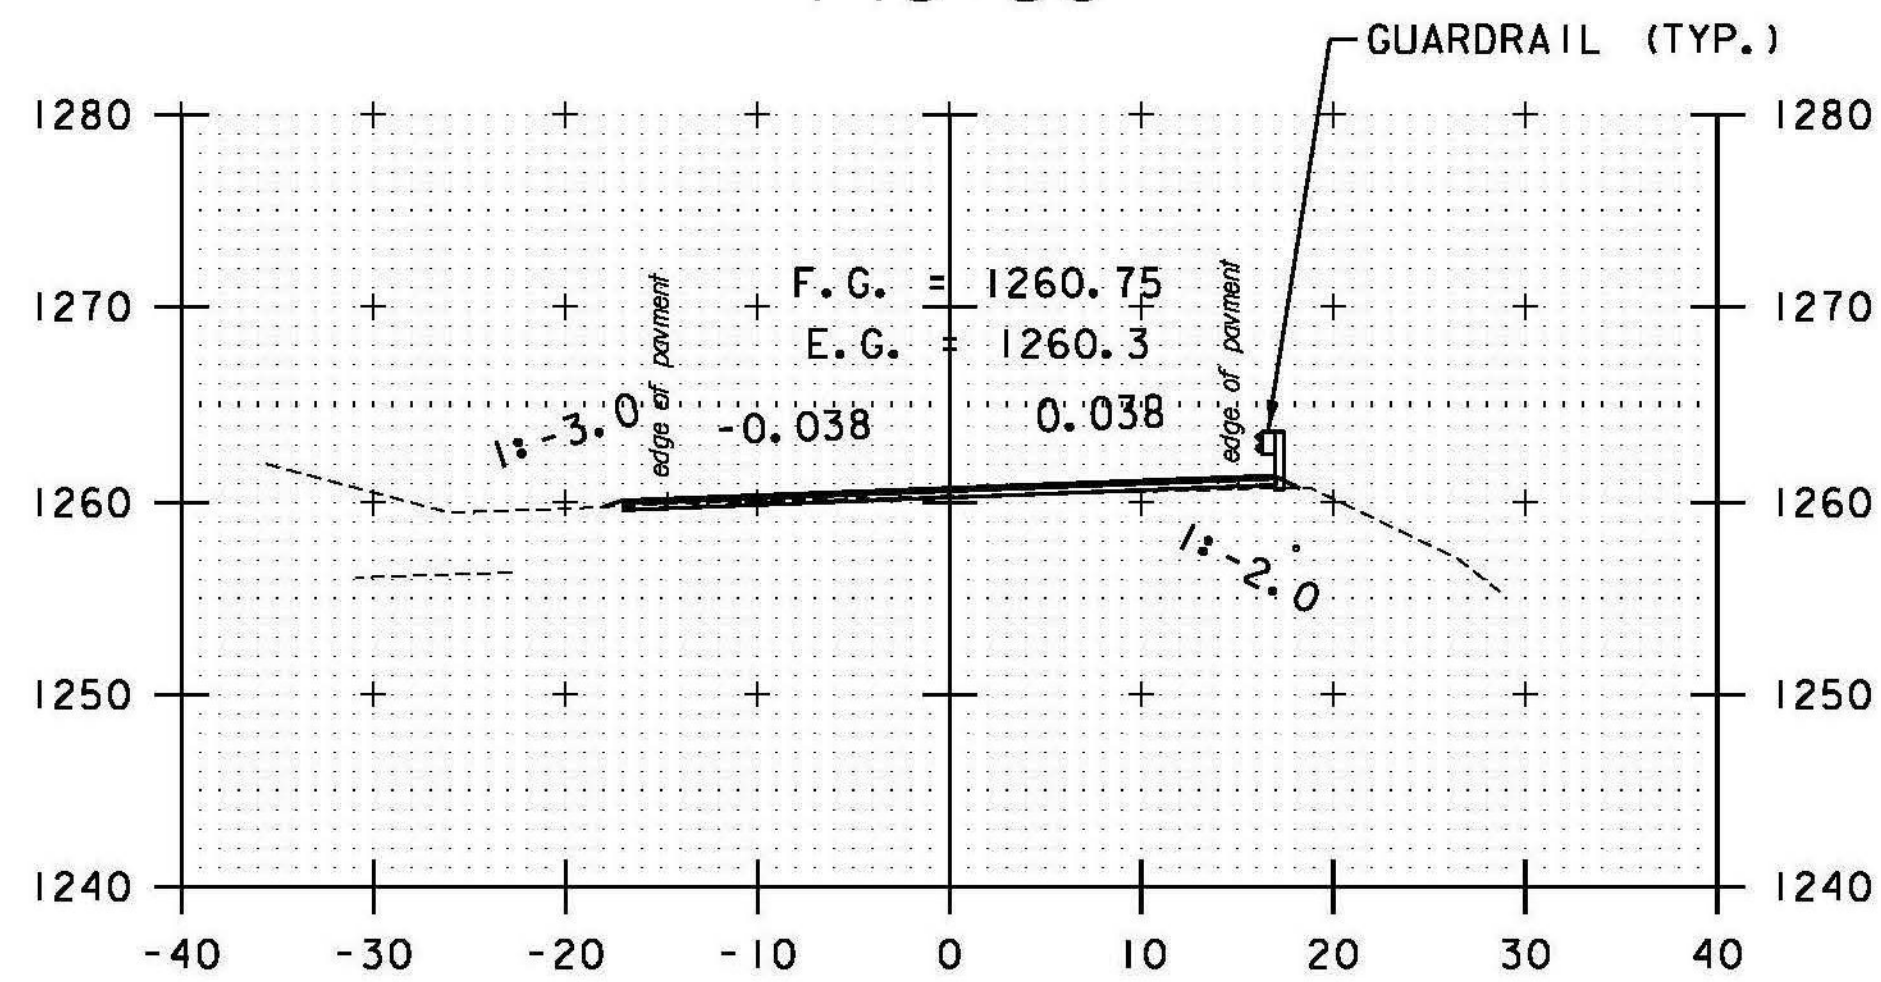


149+00

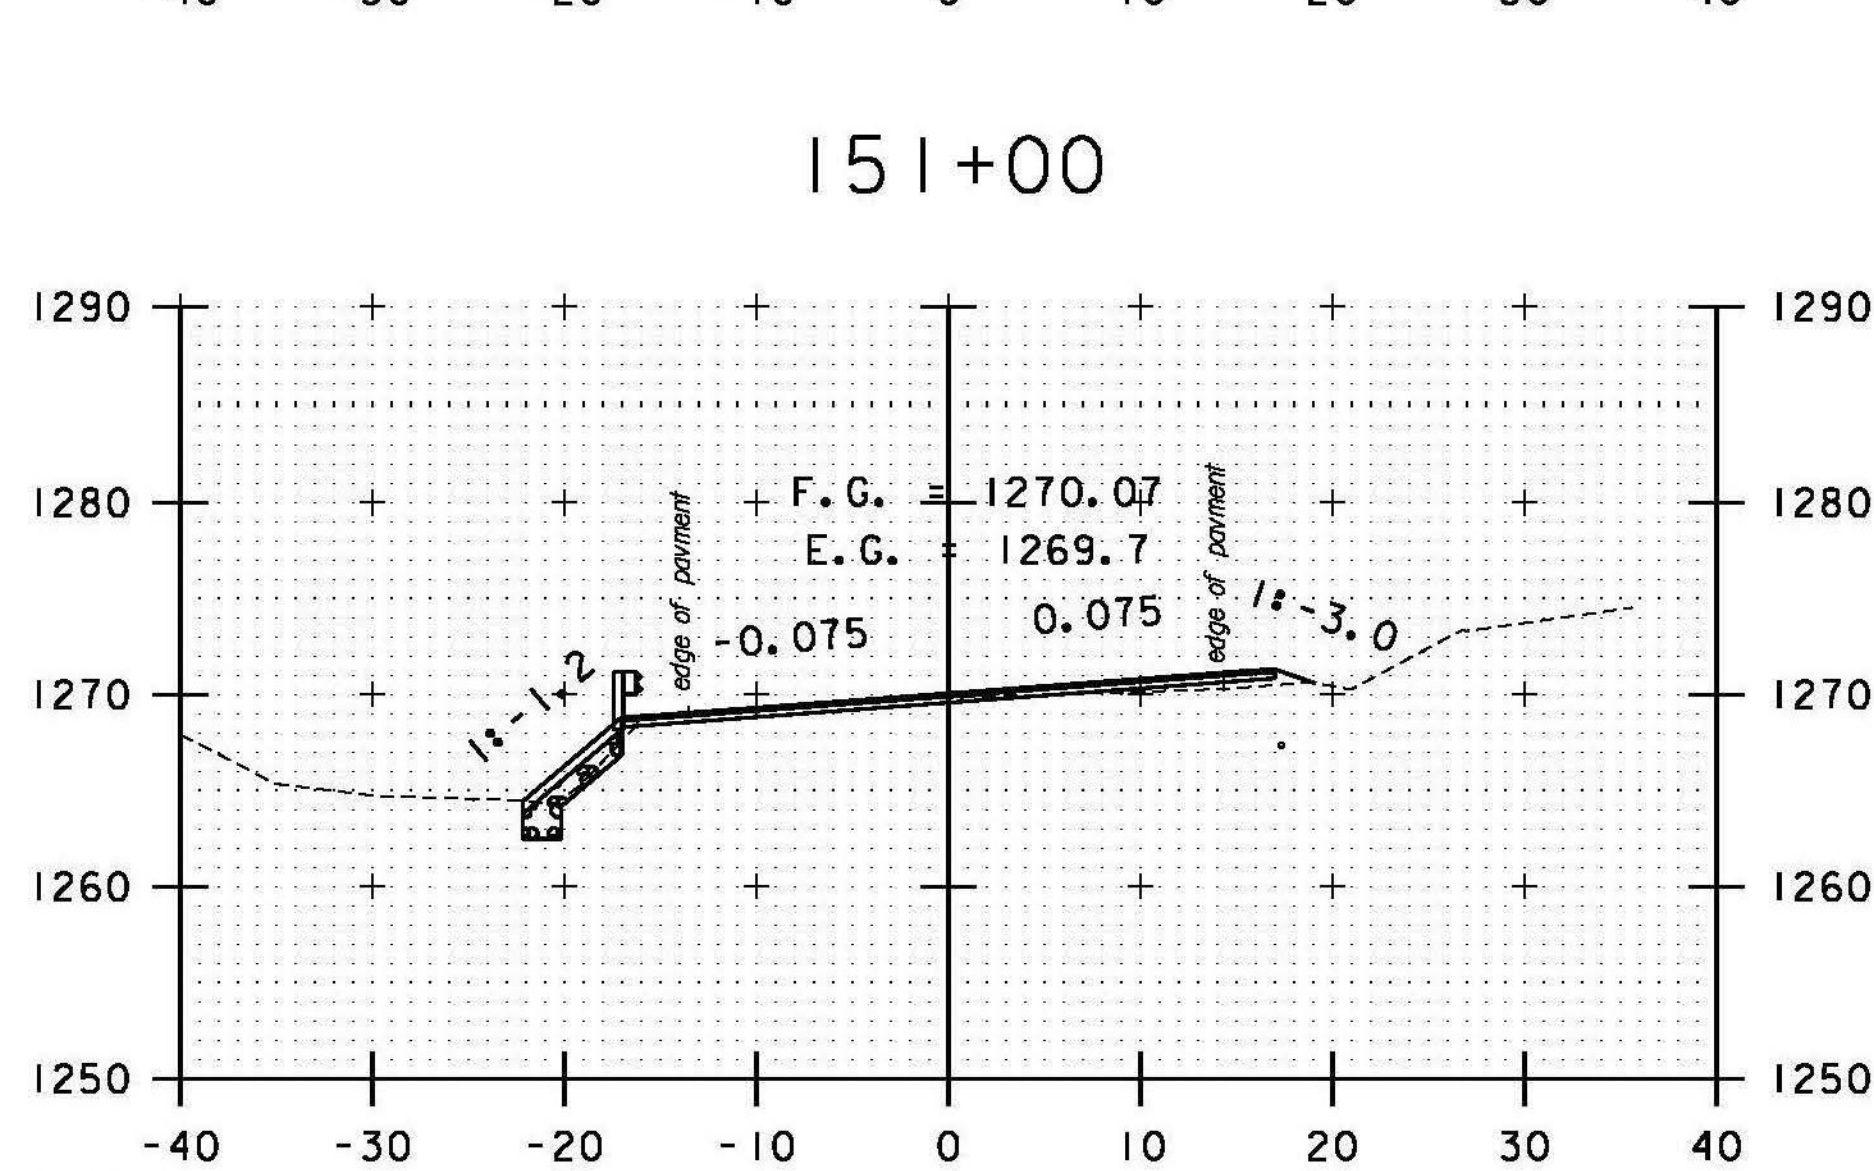


150+50

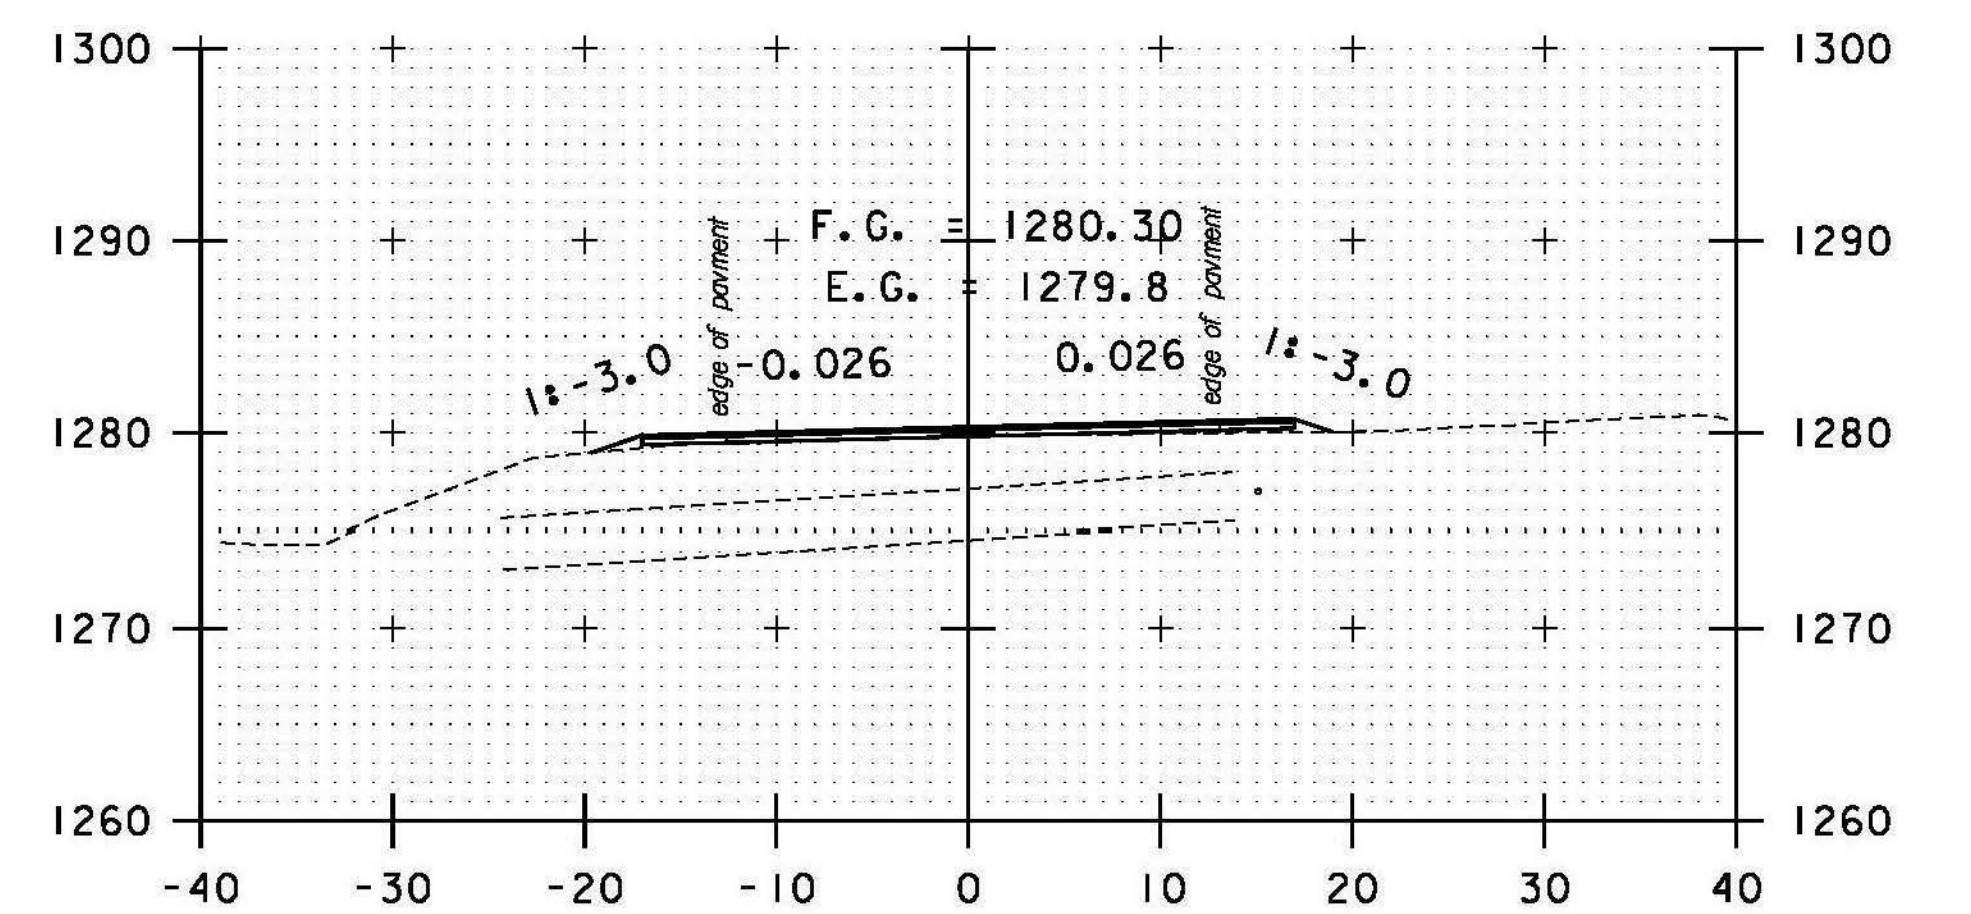


DRIVE RT
152+00

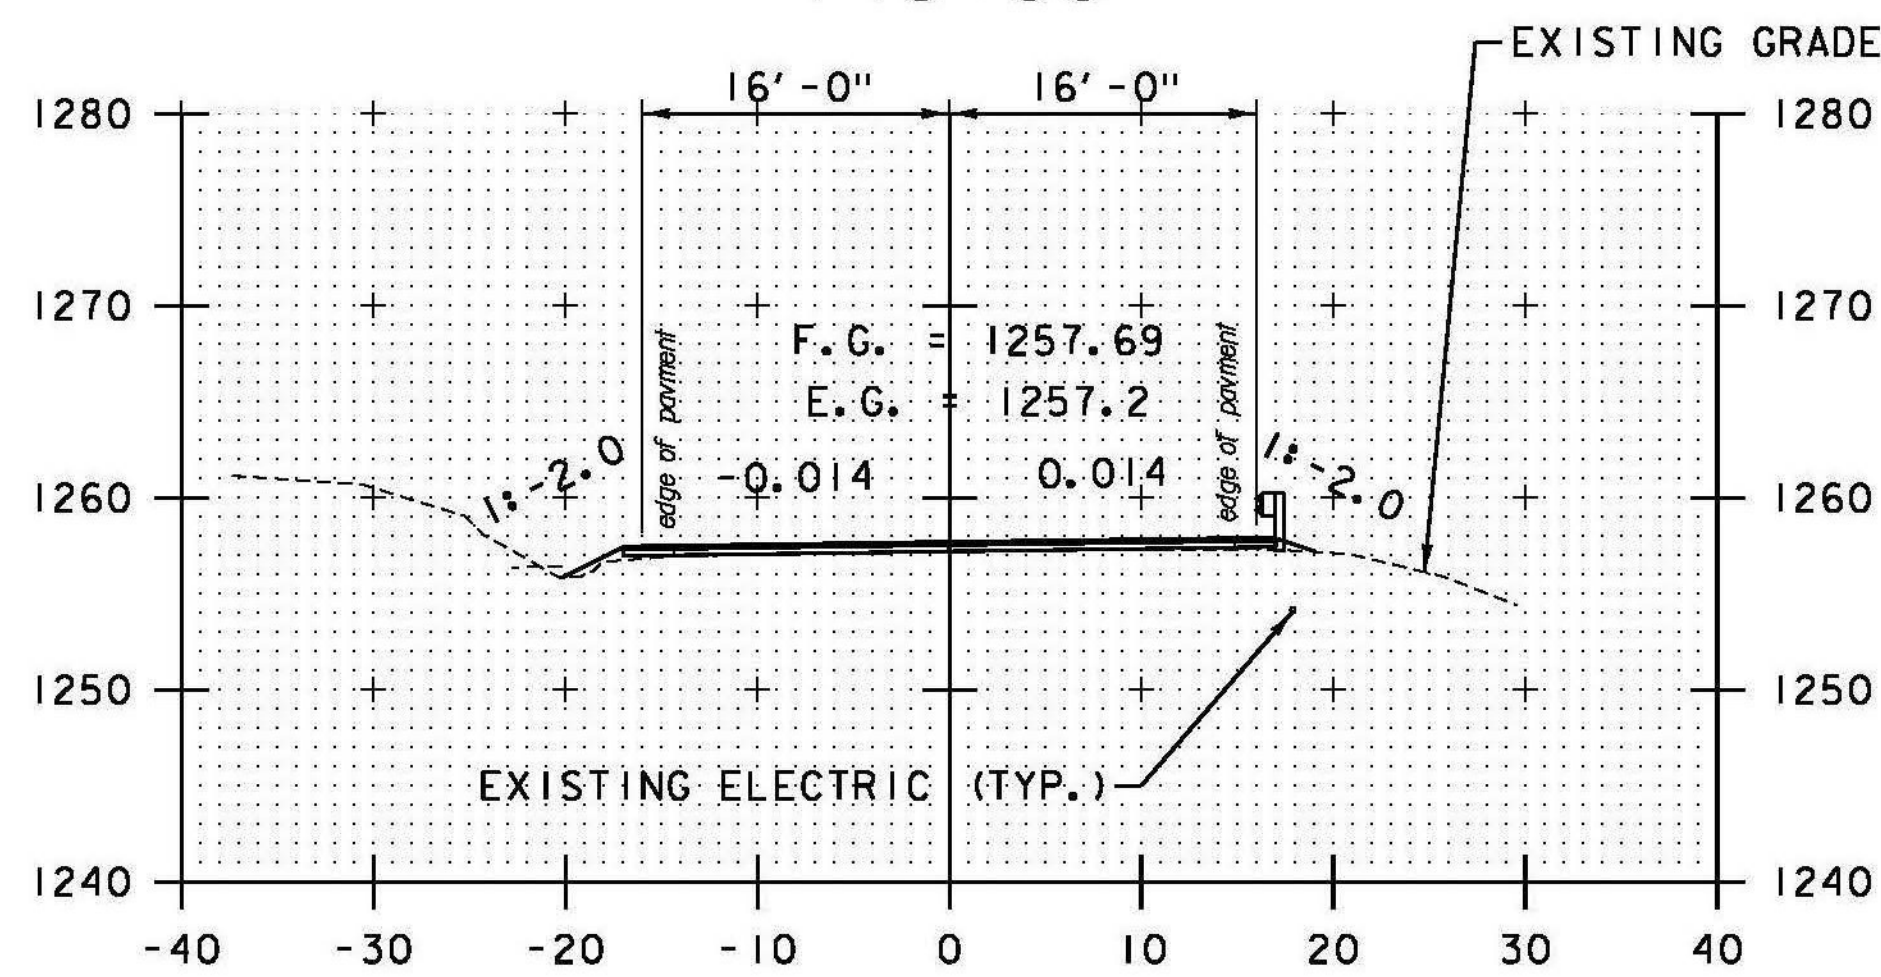

148+50

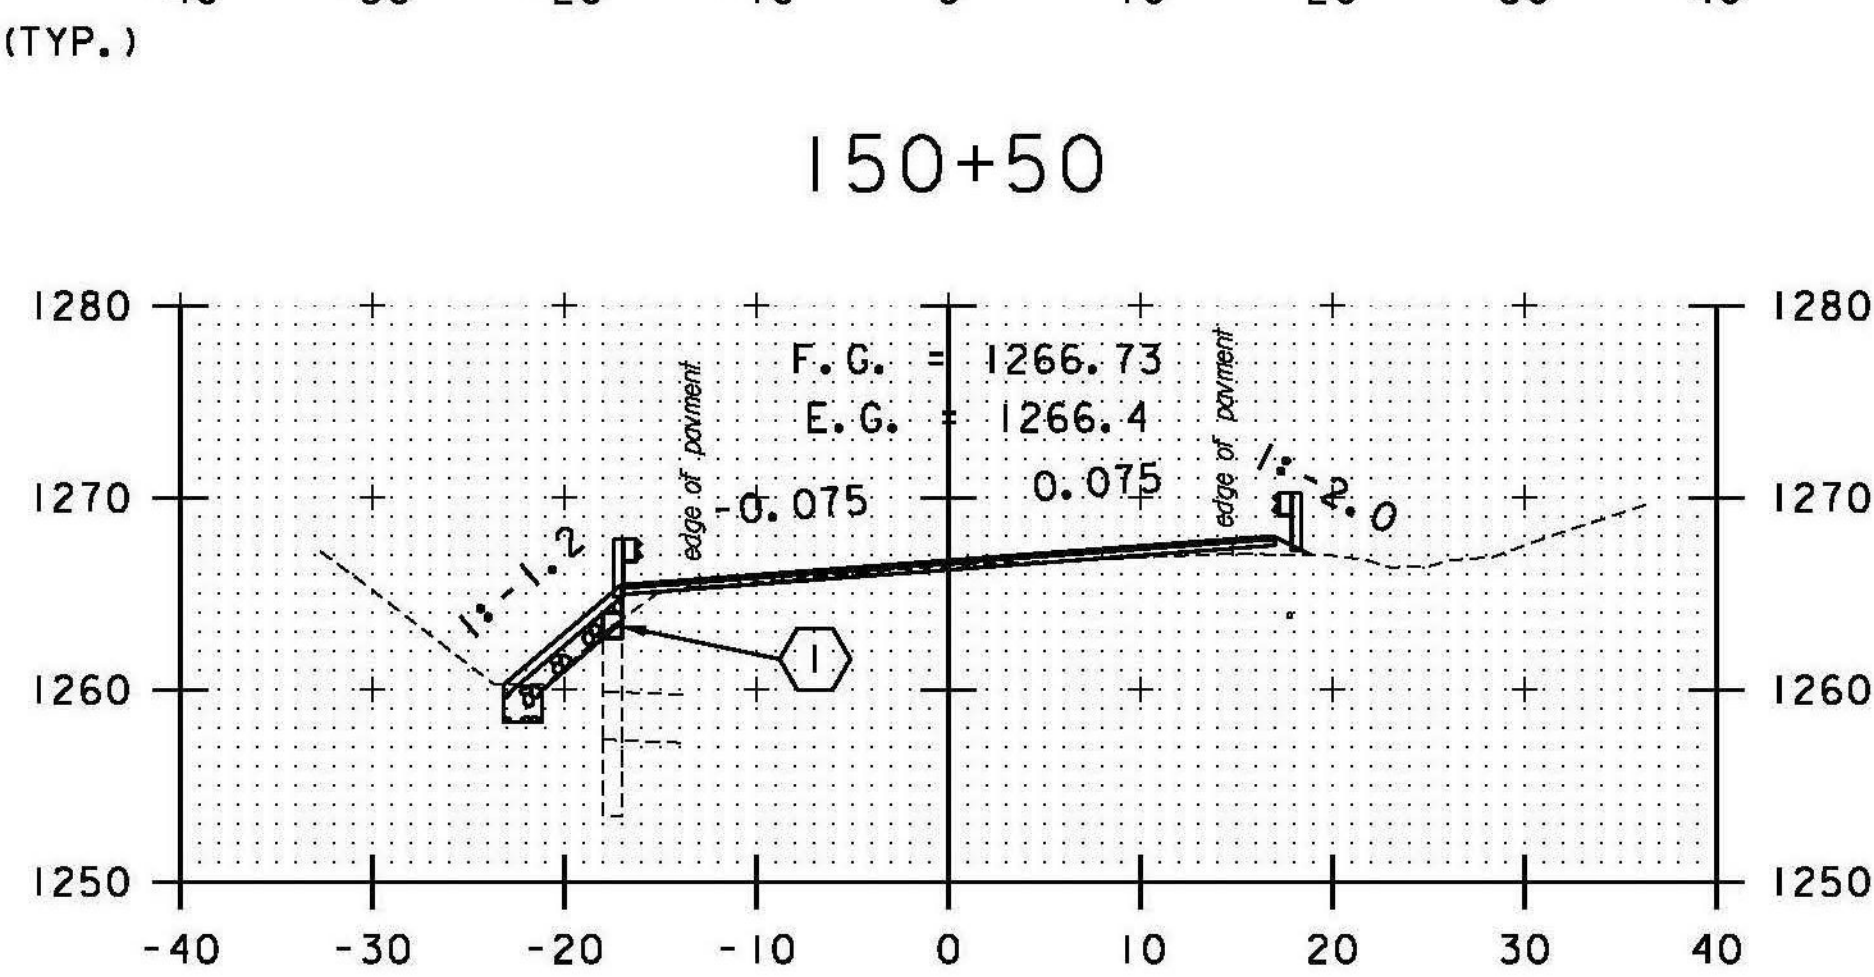

150+00

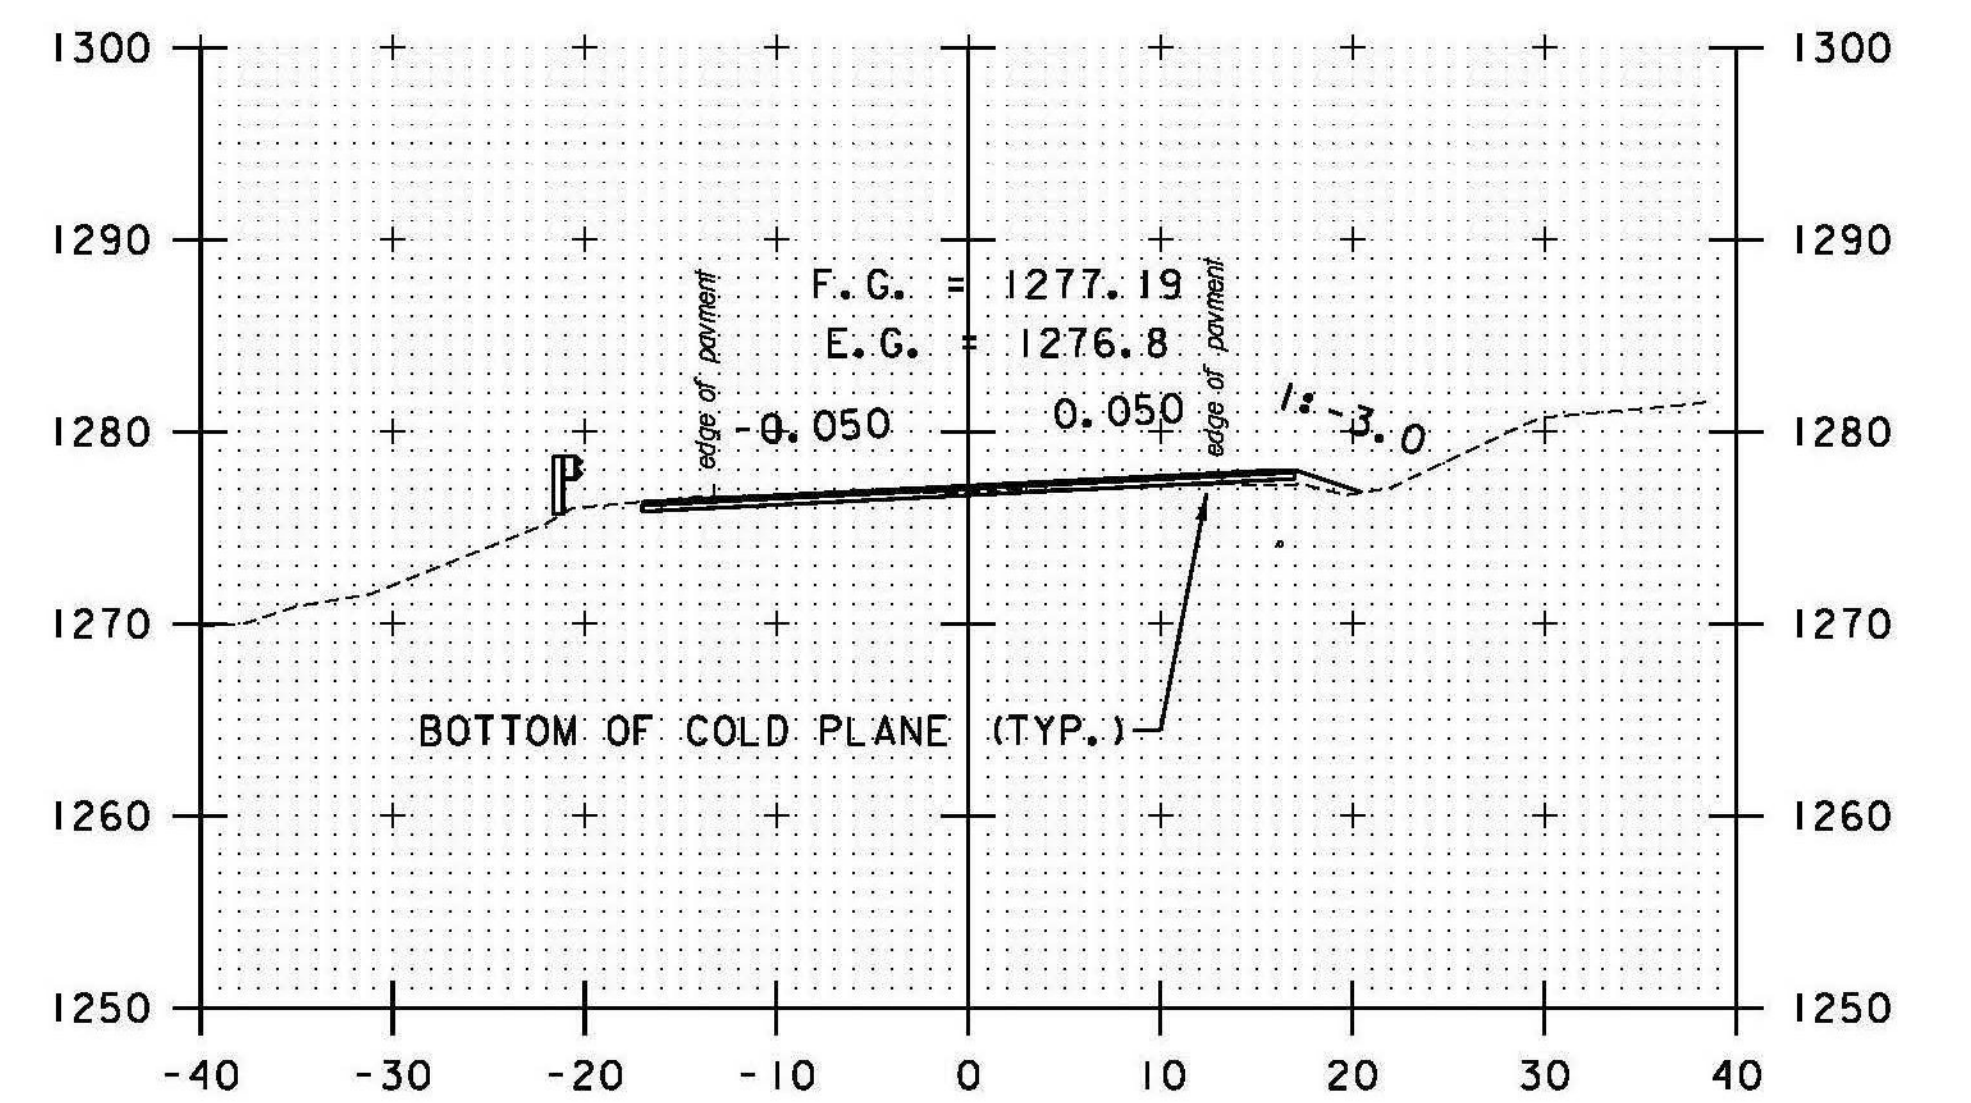


151+50

- 1 STA. 149+72.22 LT 22.39' TO
STA. 149+84.89 LT 16.65'
RAISE CONCRETE REINFORCED
HEADWALL (1'-4")
- 2 STA. 152+26.53 RT 22.74' TO
STA. 152+38.08 RT 17.61'
RAISE CONCRETE REINFORCED
HEADWALL (1'-4")

STA. 148+50 TO STA. 152+50

DATUM
VERTICAL NAVD 88
HORIZONTAL NAD 83 (07)

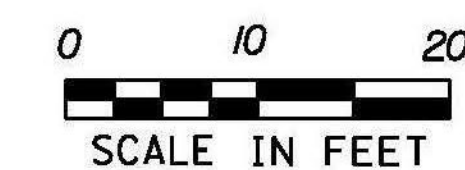

PROJECT NAME: RANDOLPH
PROJECT NUMBER: STP 2932 (1)

FILE NAME: z10c270.dgn
PROJECT LEADER: C. LATHROP
DESIGNED BY: B. BRESLEND
VT 66 CROSS SECTION SHEET 28

PLOT DATE: 6/5/2014
DRAWN BY: B. BRESLEND
CHECKED BY: C. LATHROP
SHEET 184 OF 276