




154+00

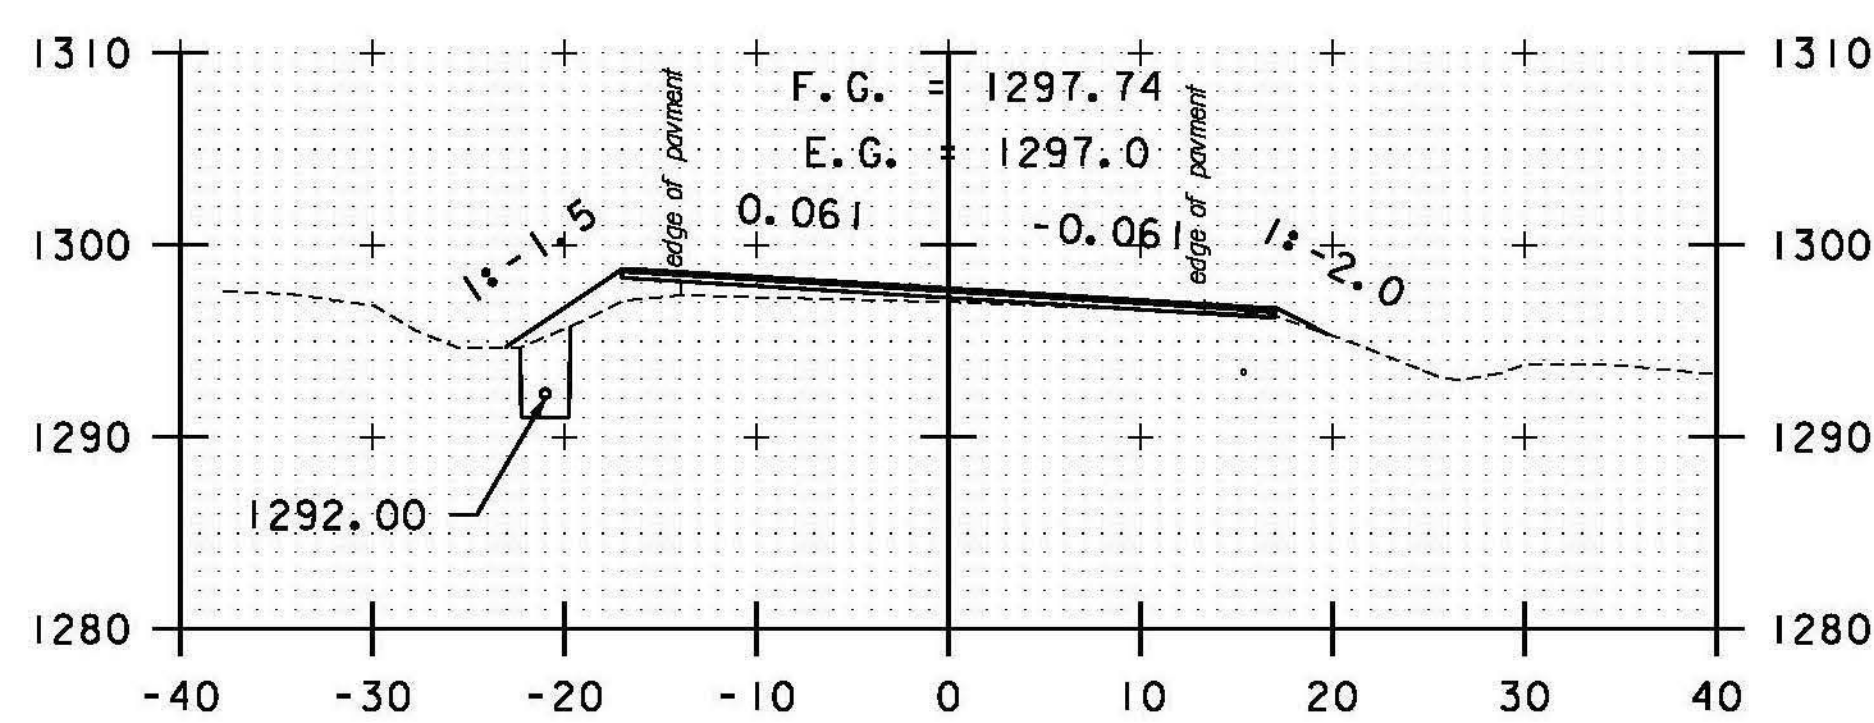


155+50

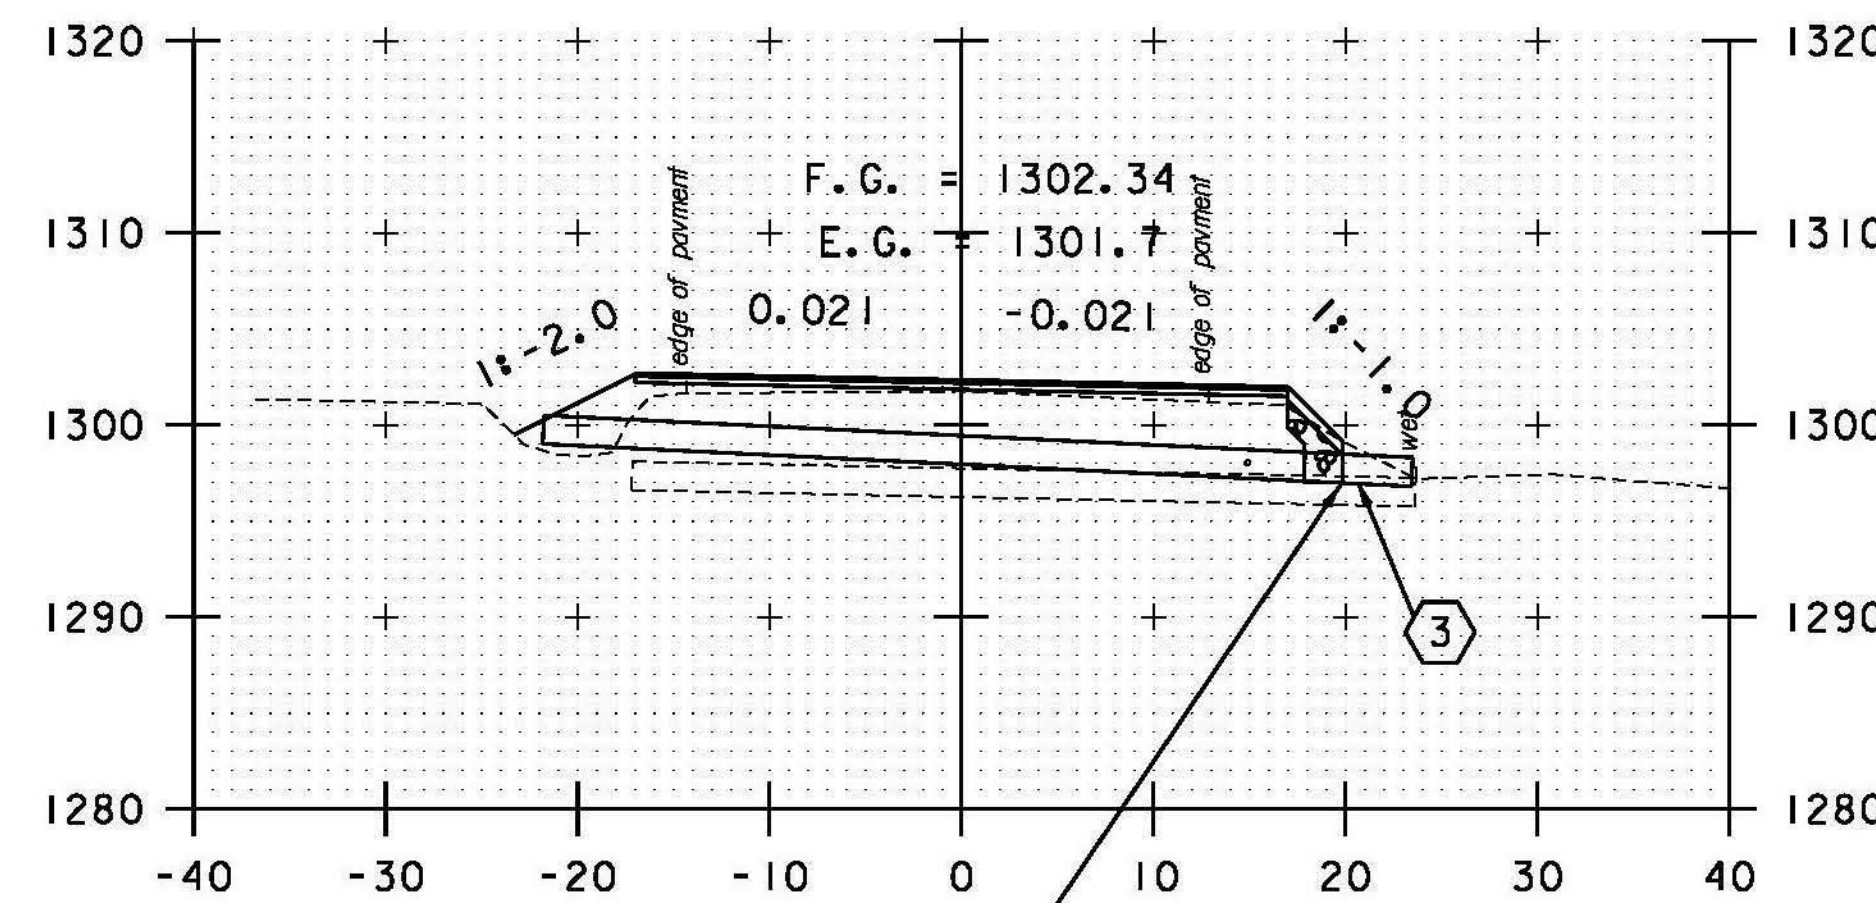


157+00

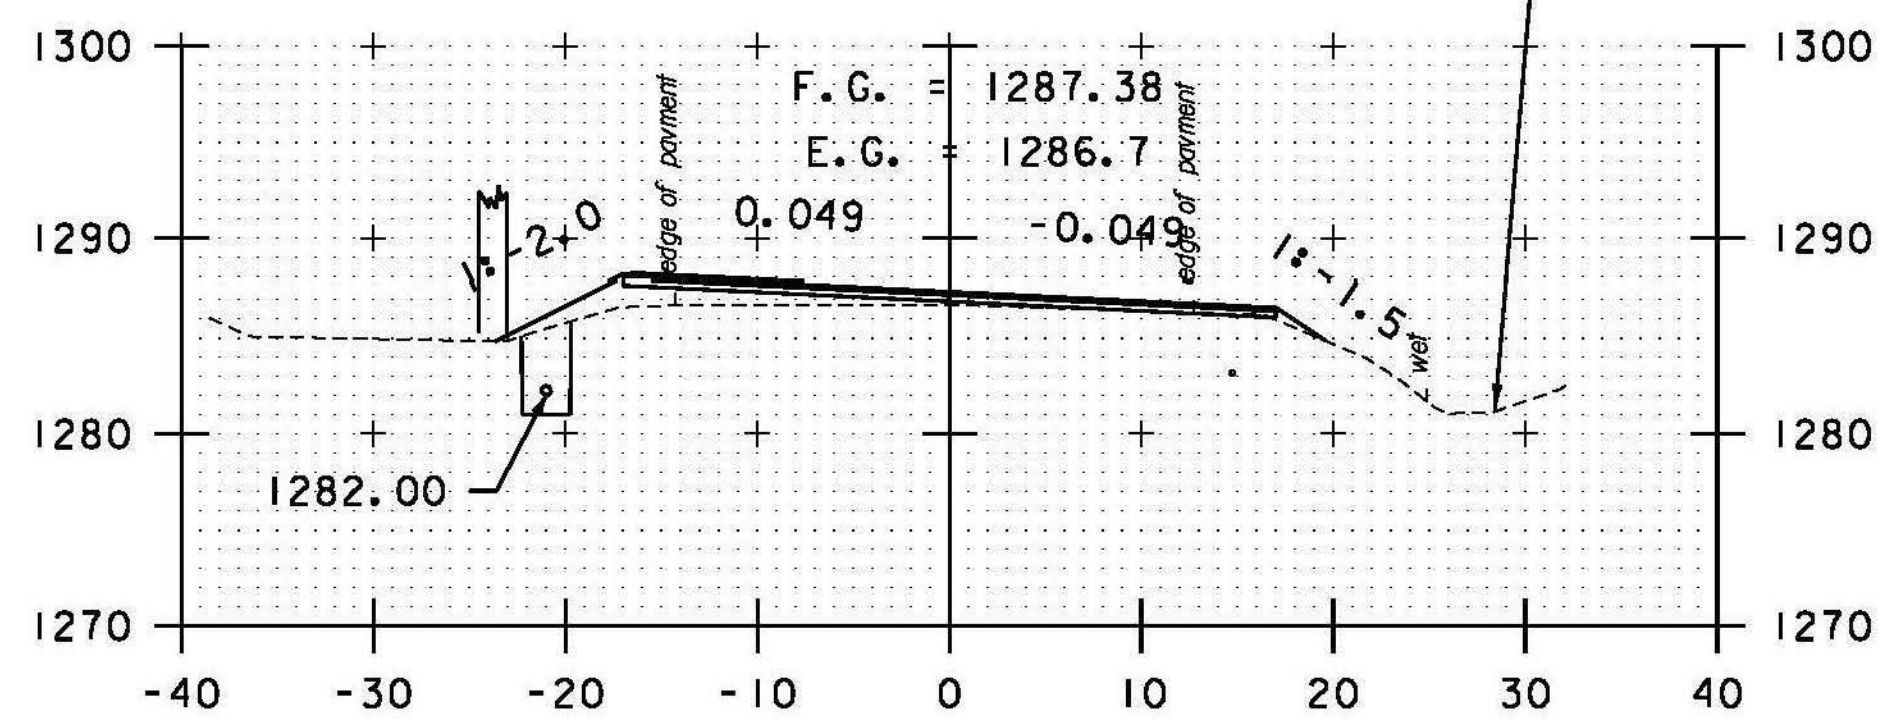


153+50

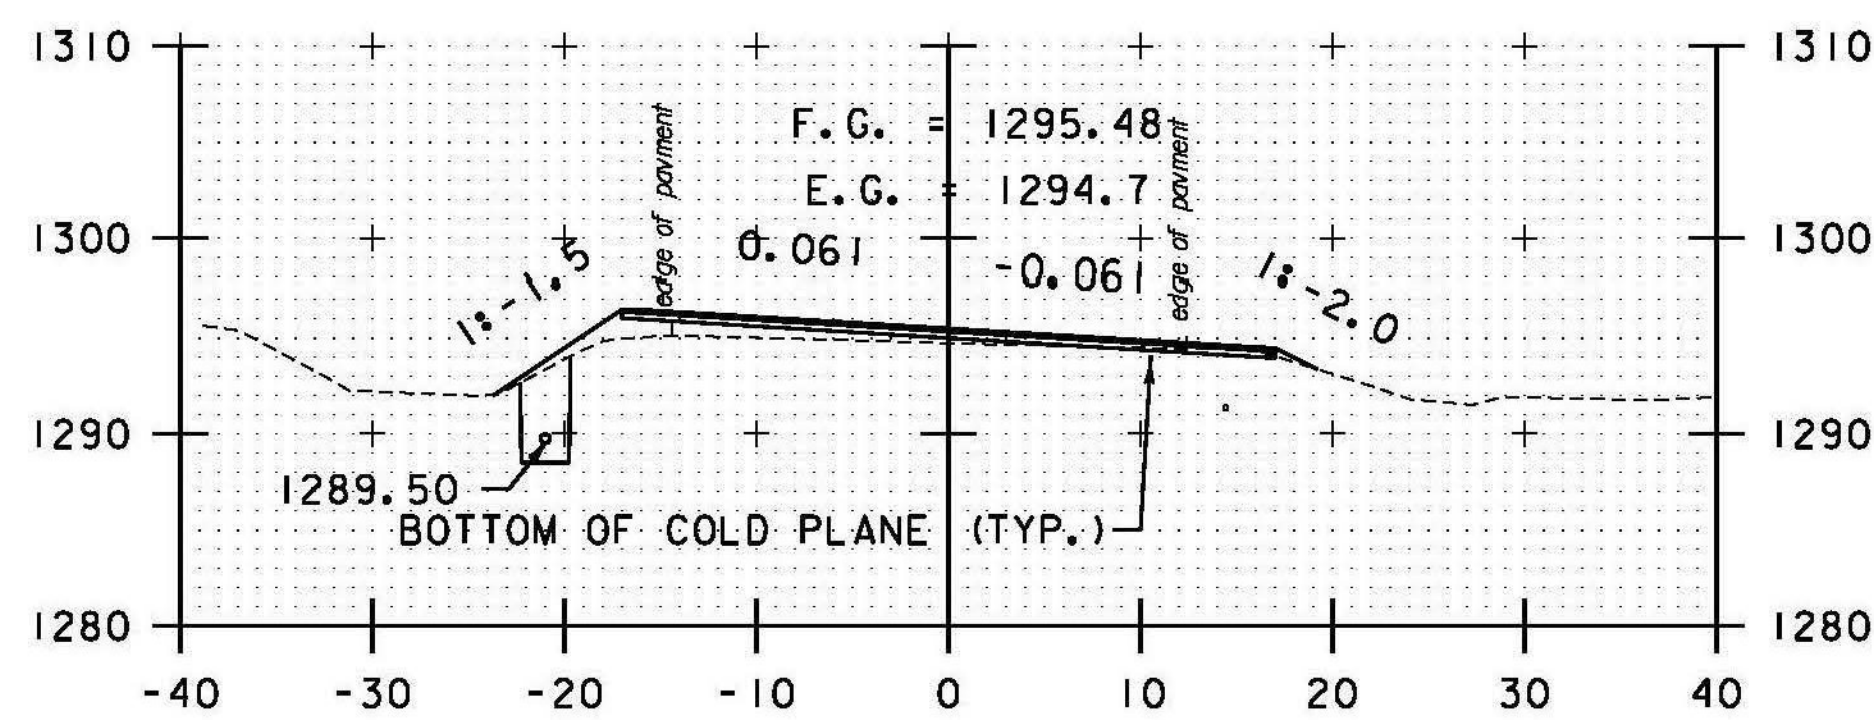


155+00

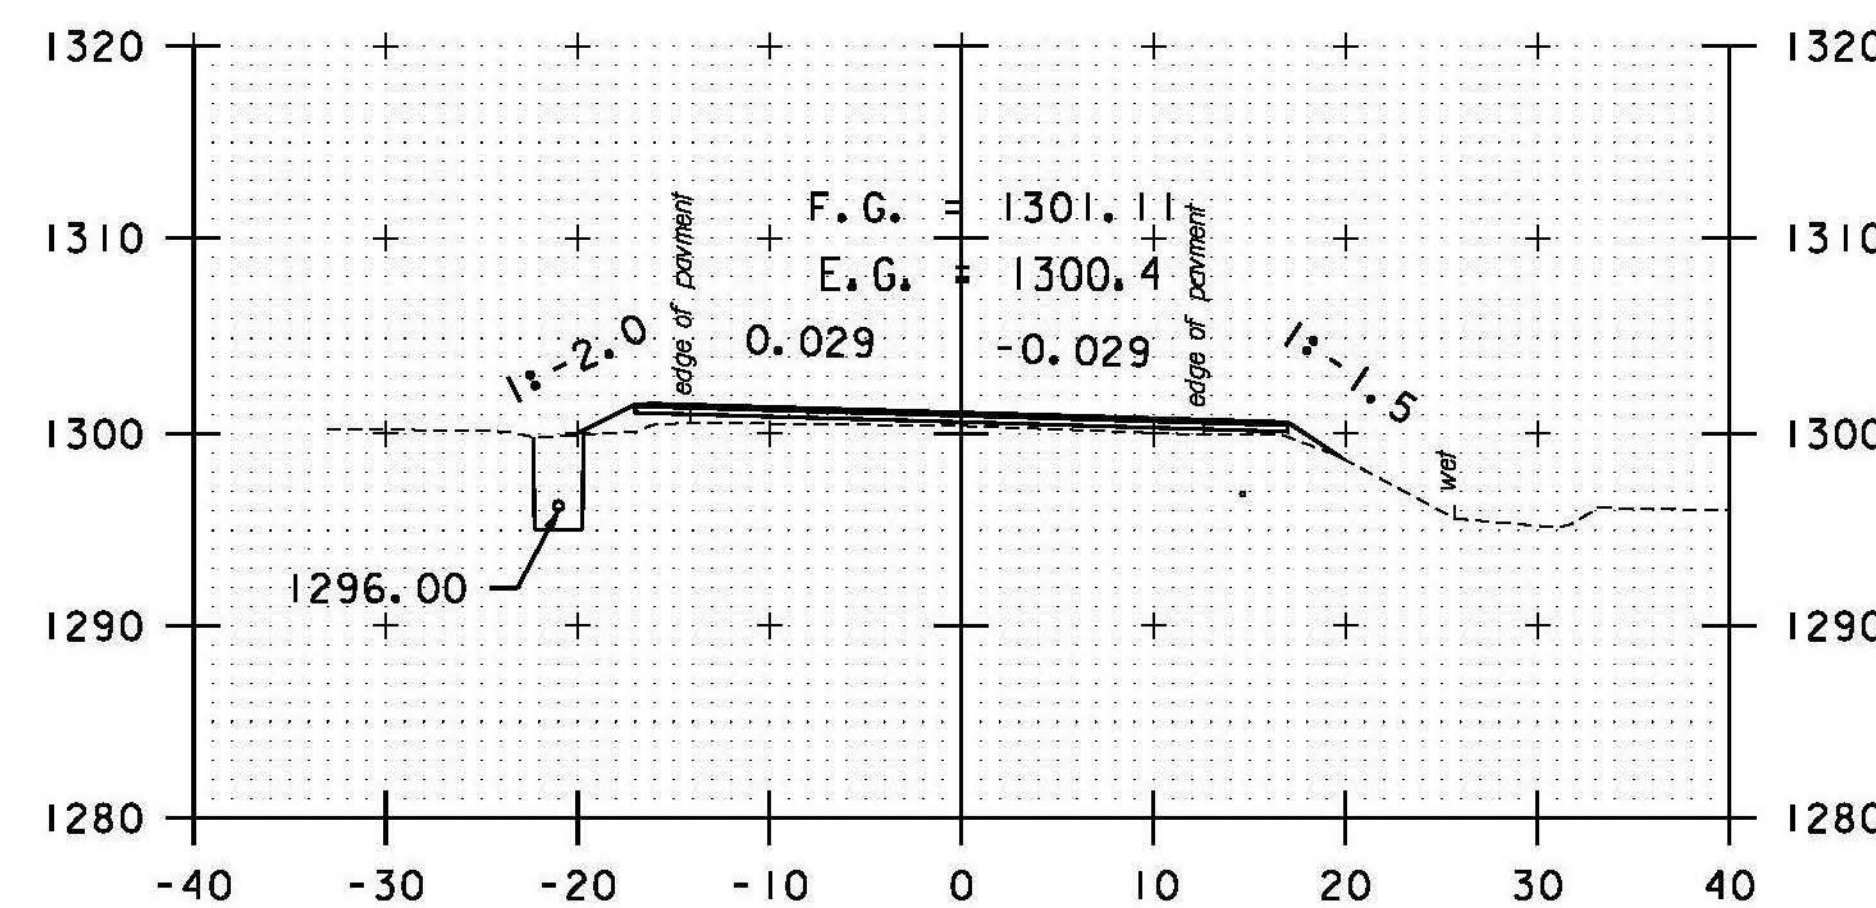


156+50

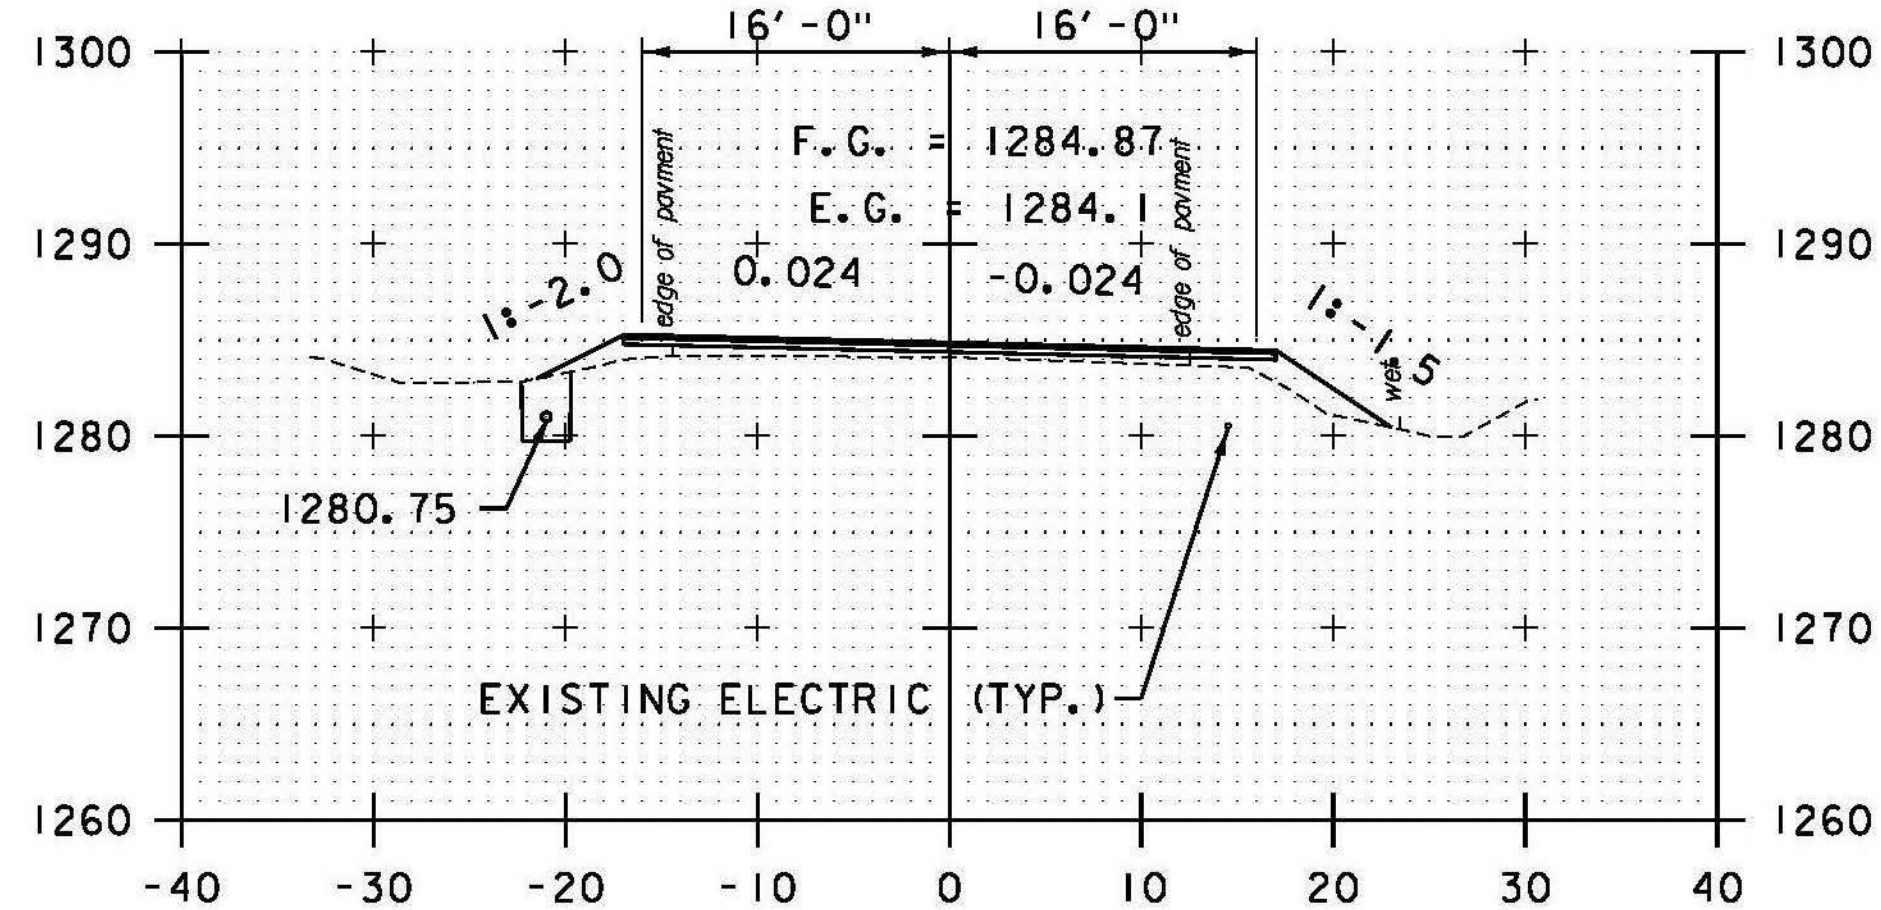

153+00

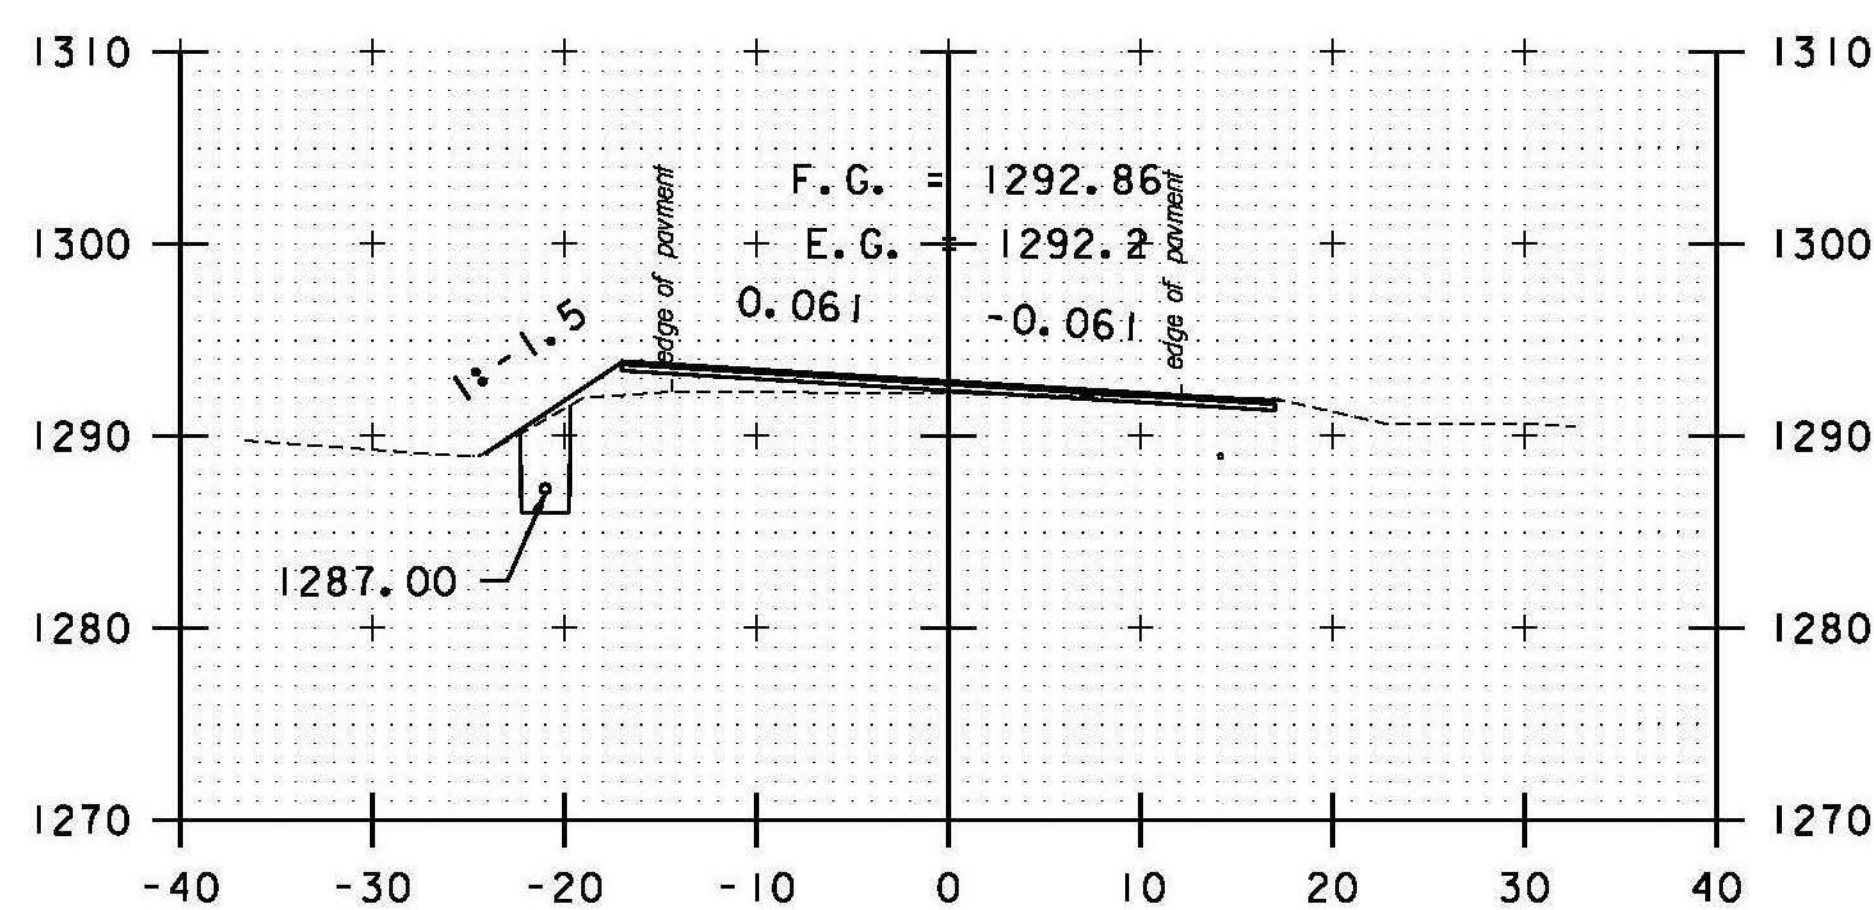

154+50

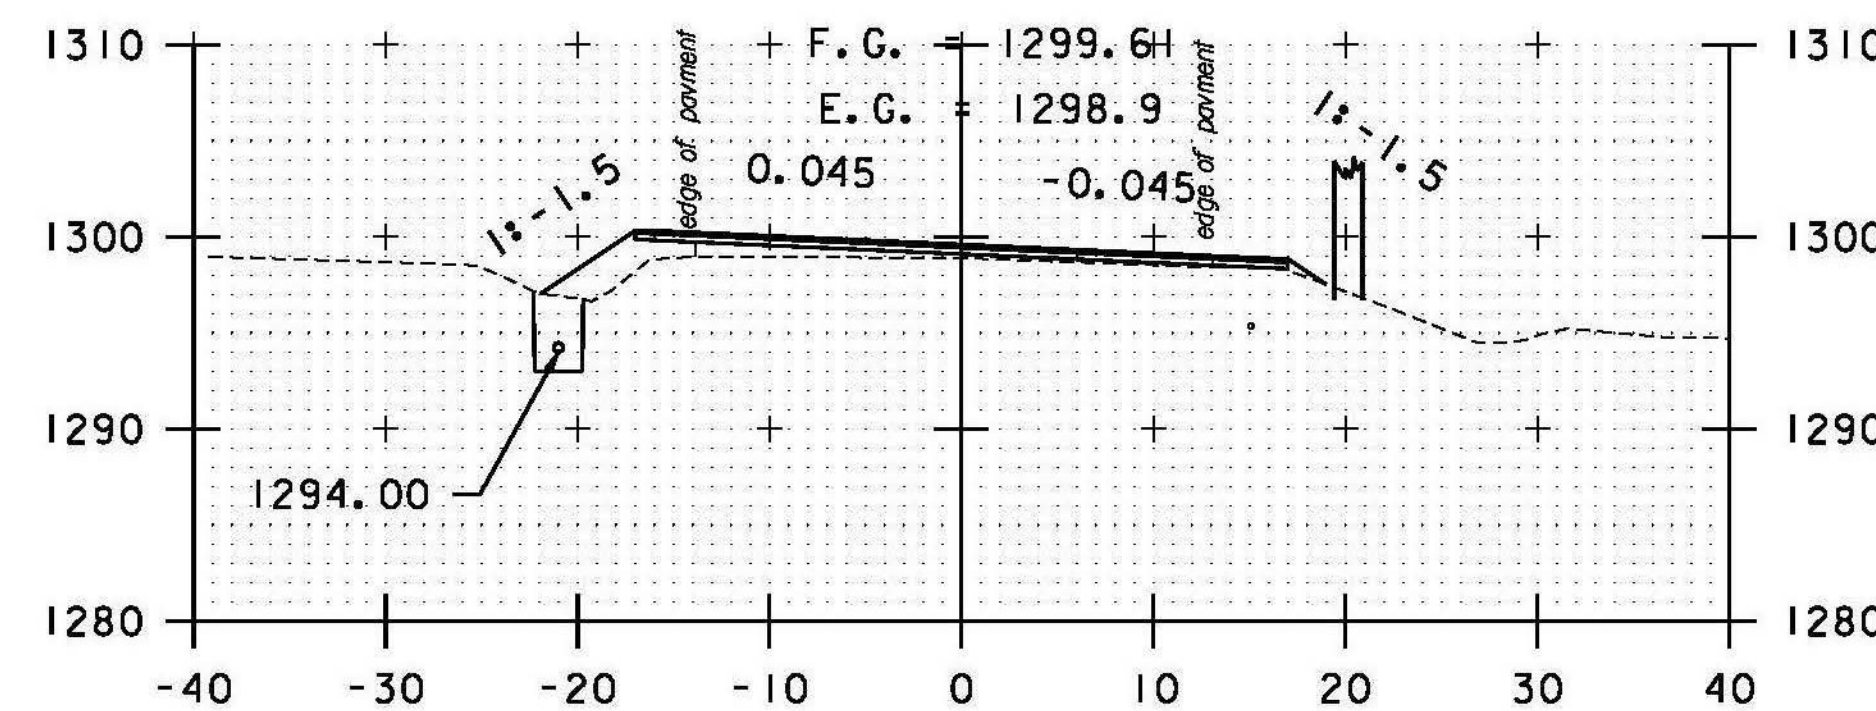


156+00

3 STA. 156+53.92 RT 23.42' TO
 STA. 156+83.43 LT 21.81'
 REMOVE EXISTING 18" CPEP
 INSTALL NEW 18" CPEP (54'-0")
 INV. IN = 1299.00'
 INV. OUT = 1296.80'

STA. 153+00 TO STA. 157+00

DATUM
 VERTICAL NAVD 88
 HORIZONTAL NAD 83 (07)

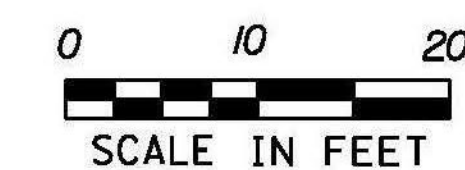

PROJECT NAME: RANDOLPH
 PROJECT NUMBER: STP 2932 (1)

FILE NAME: z10c270.dgn
 PROJECT LEADER: C. LATHROP
 DESIGNED BY: B. BRESLEND
 VT 66 CROSS SECTION SHEET 29
 PLOT DATE: 6/5/2014
 DRAWN BY: B. BRESLEND
 CHECKED BY: C. LATHROP
 SHEET 185 OF 276