




DRIVE RT
172+00

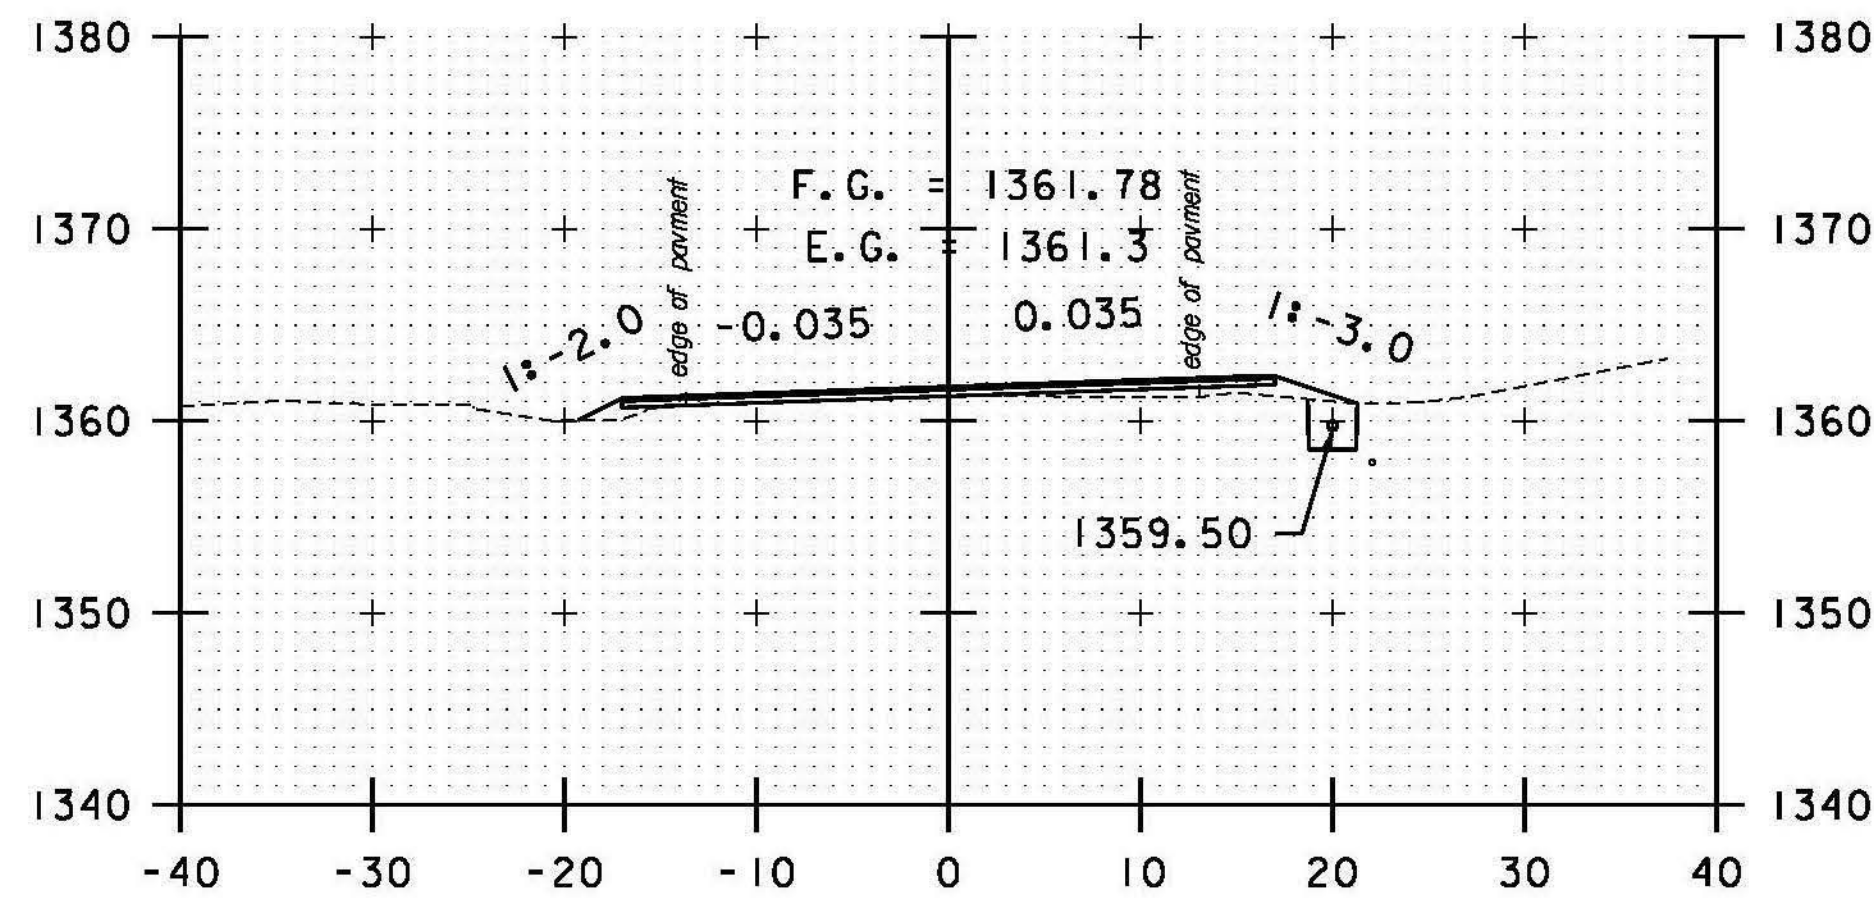


173+50

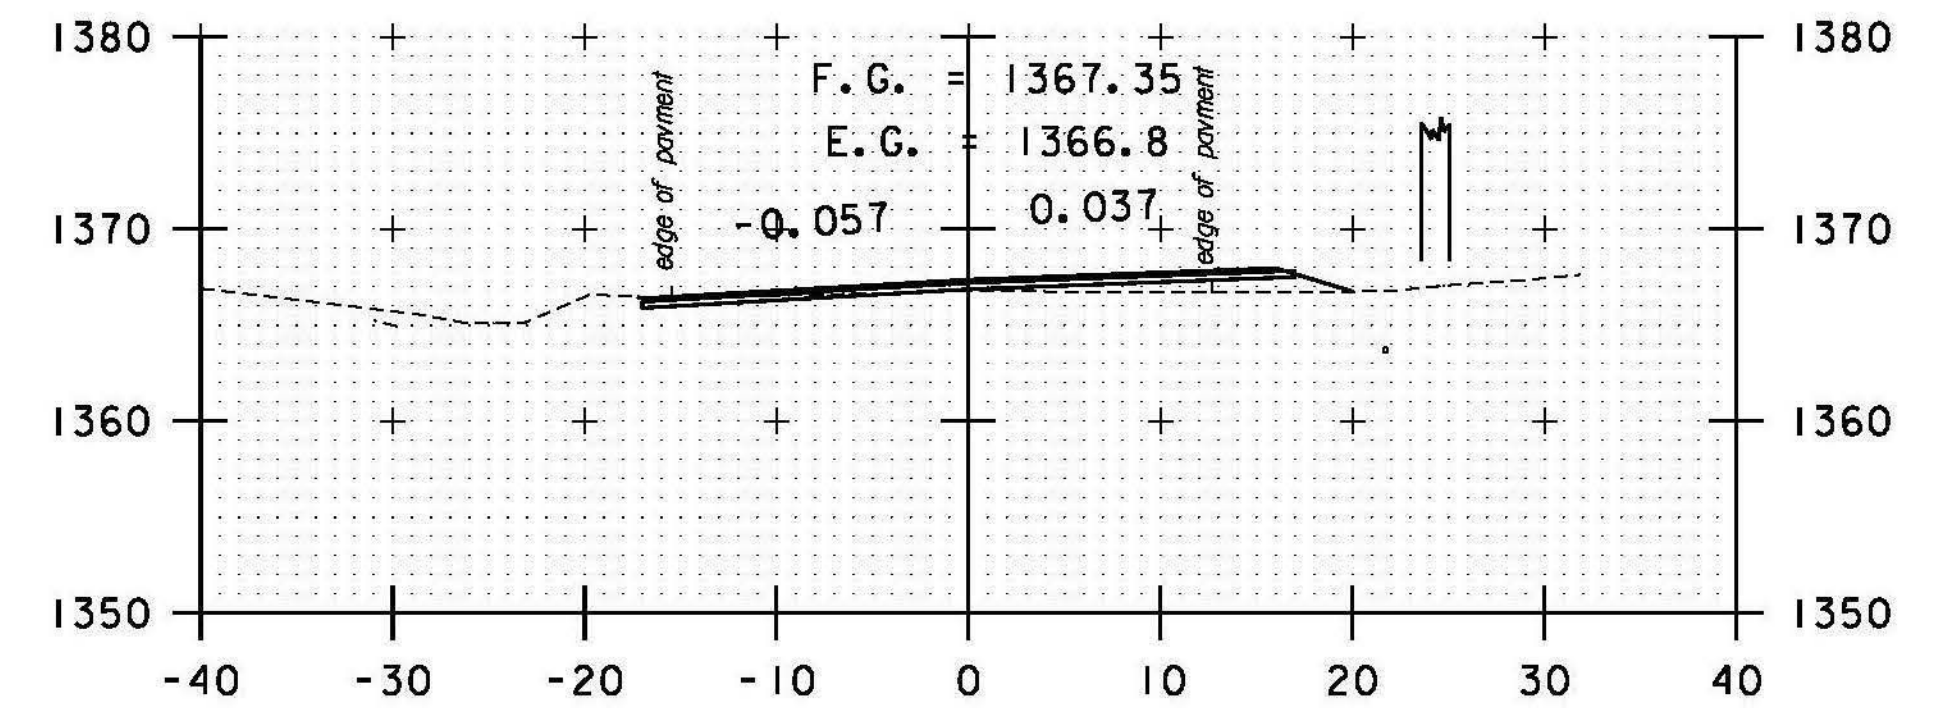


DRIVE RT
175+00

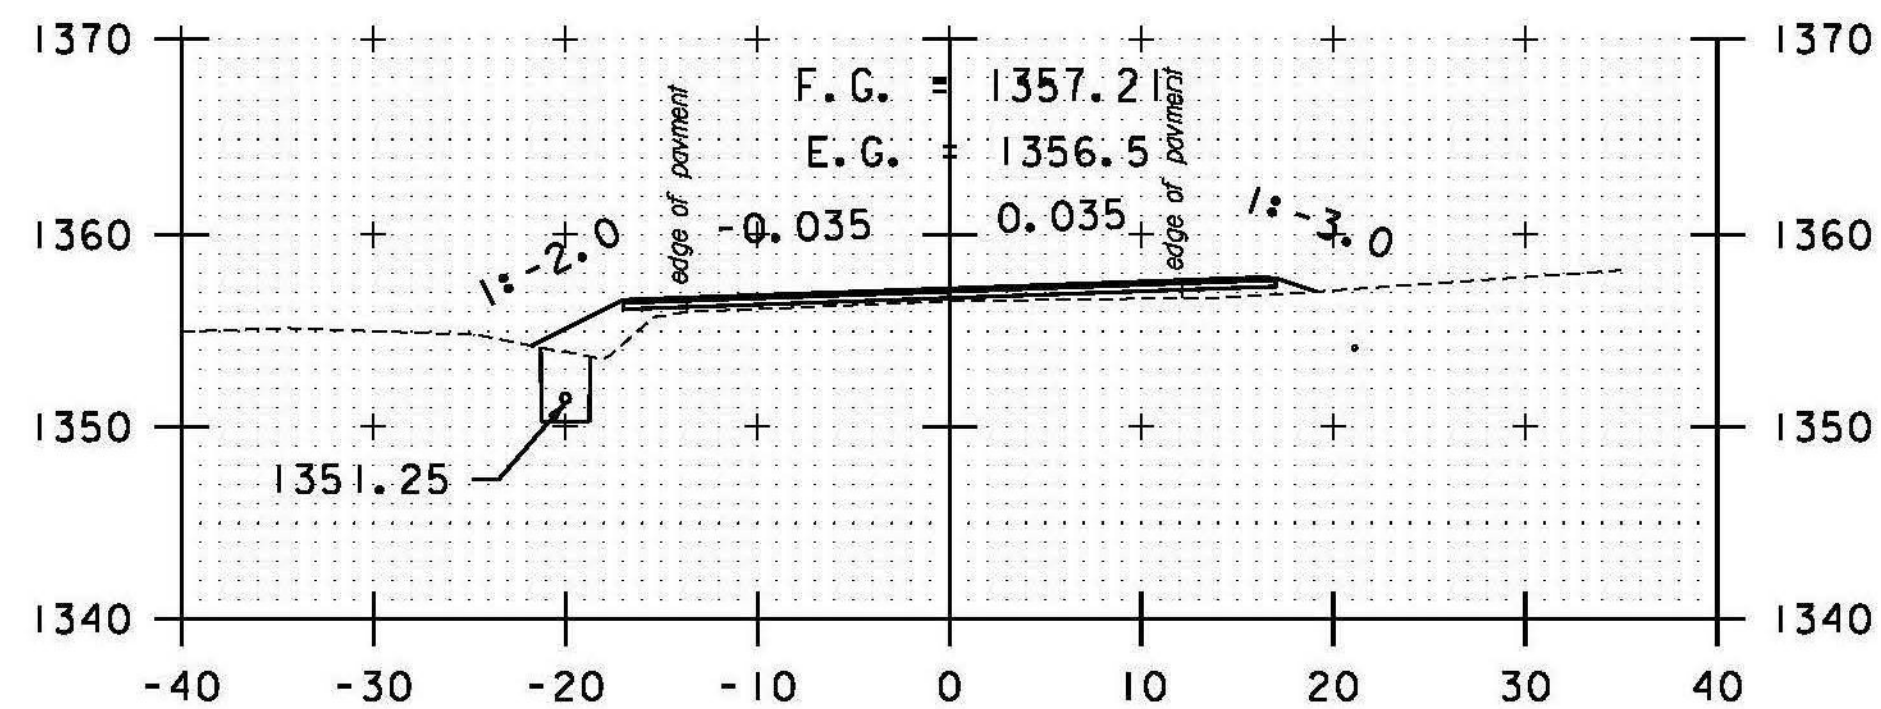


171+50

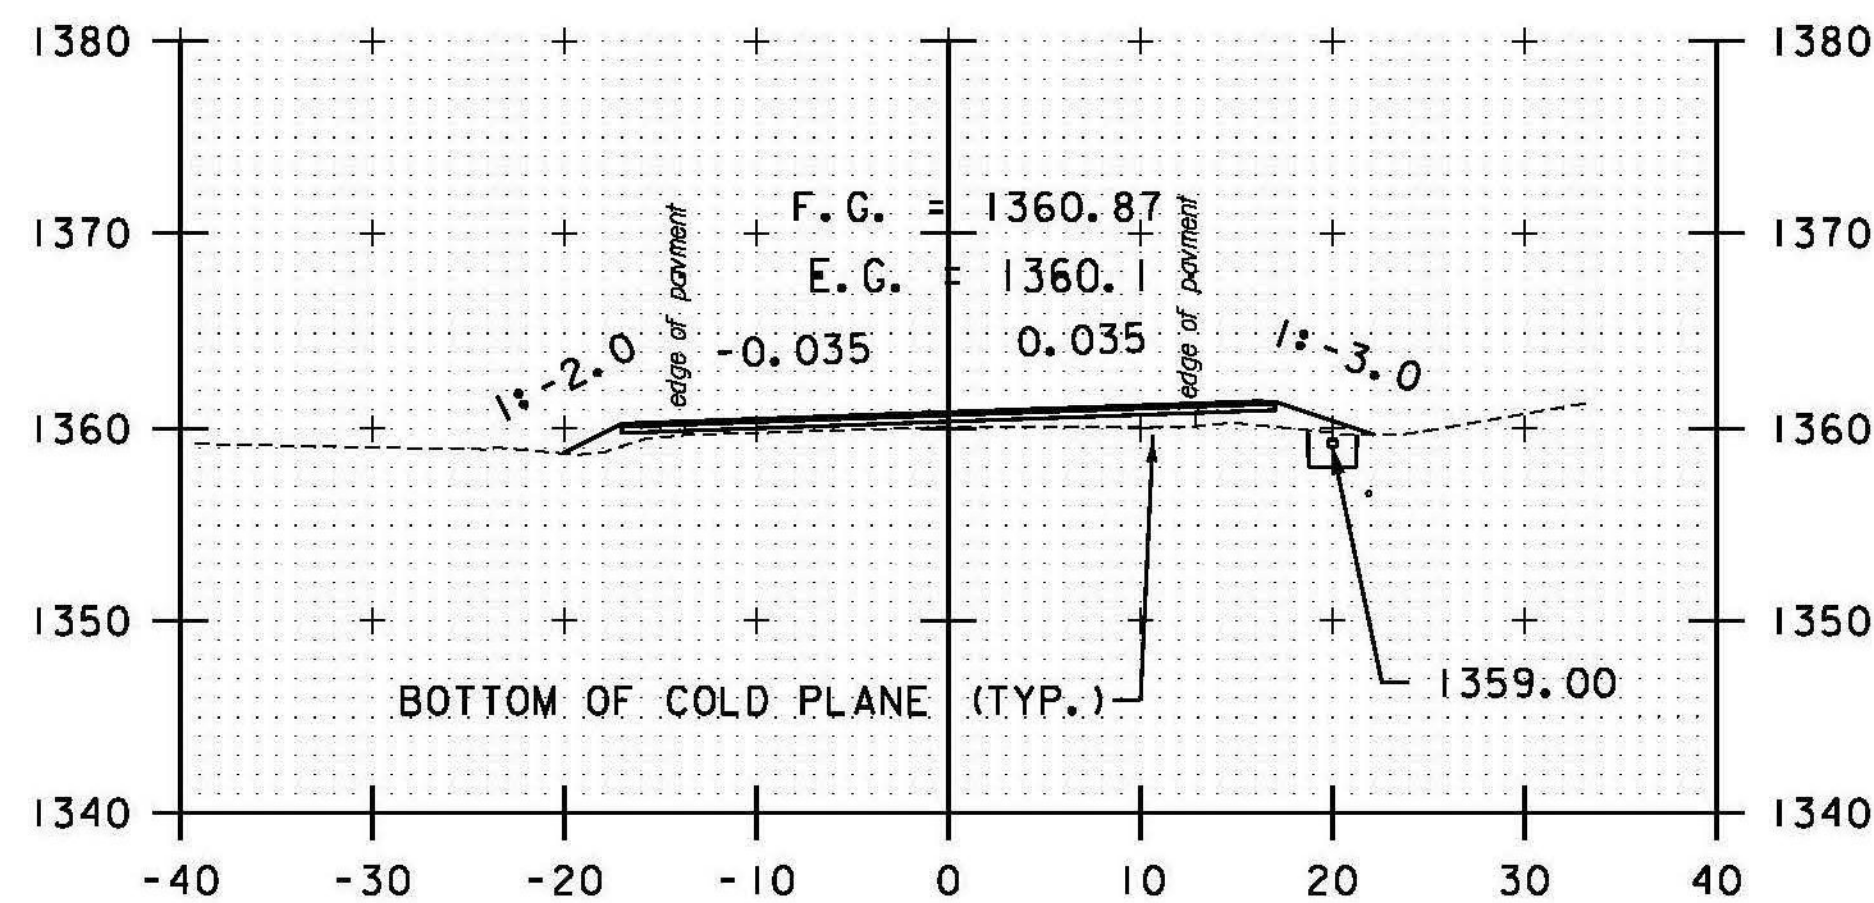


173+00

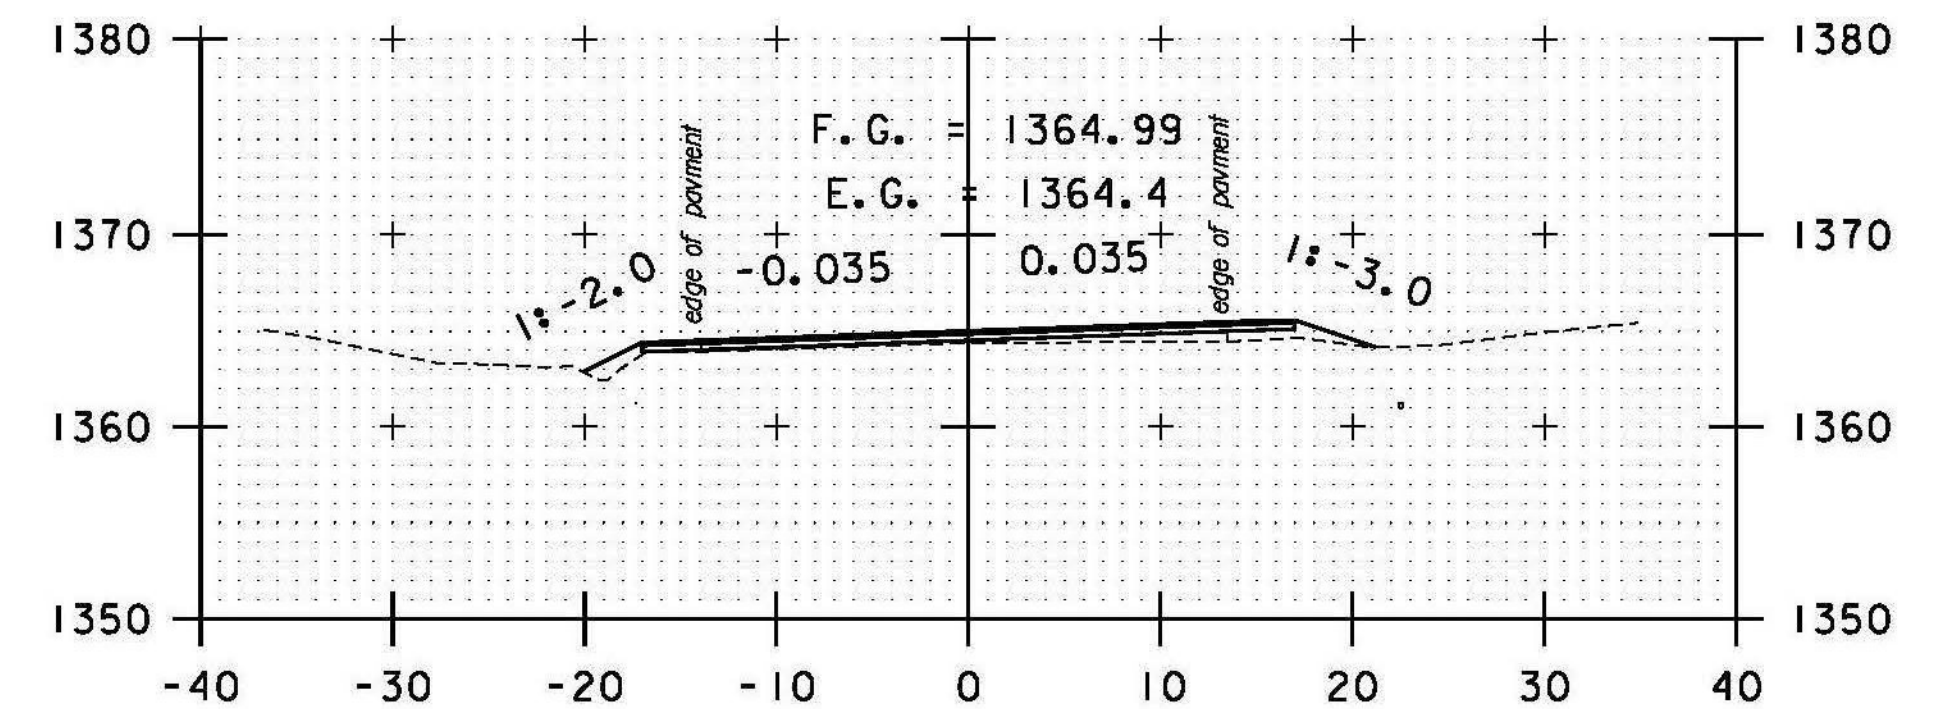


174+50

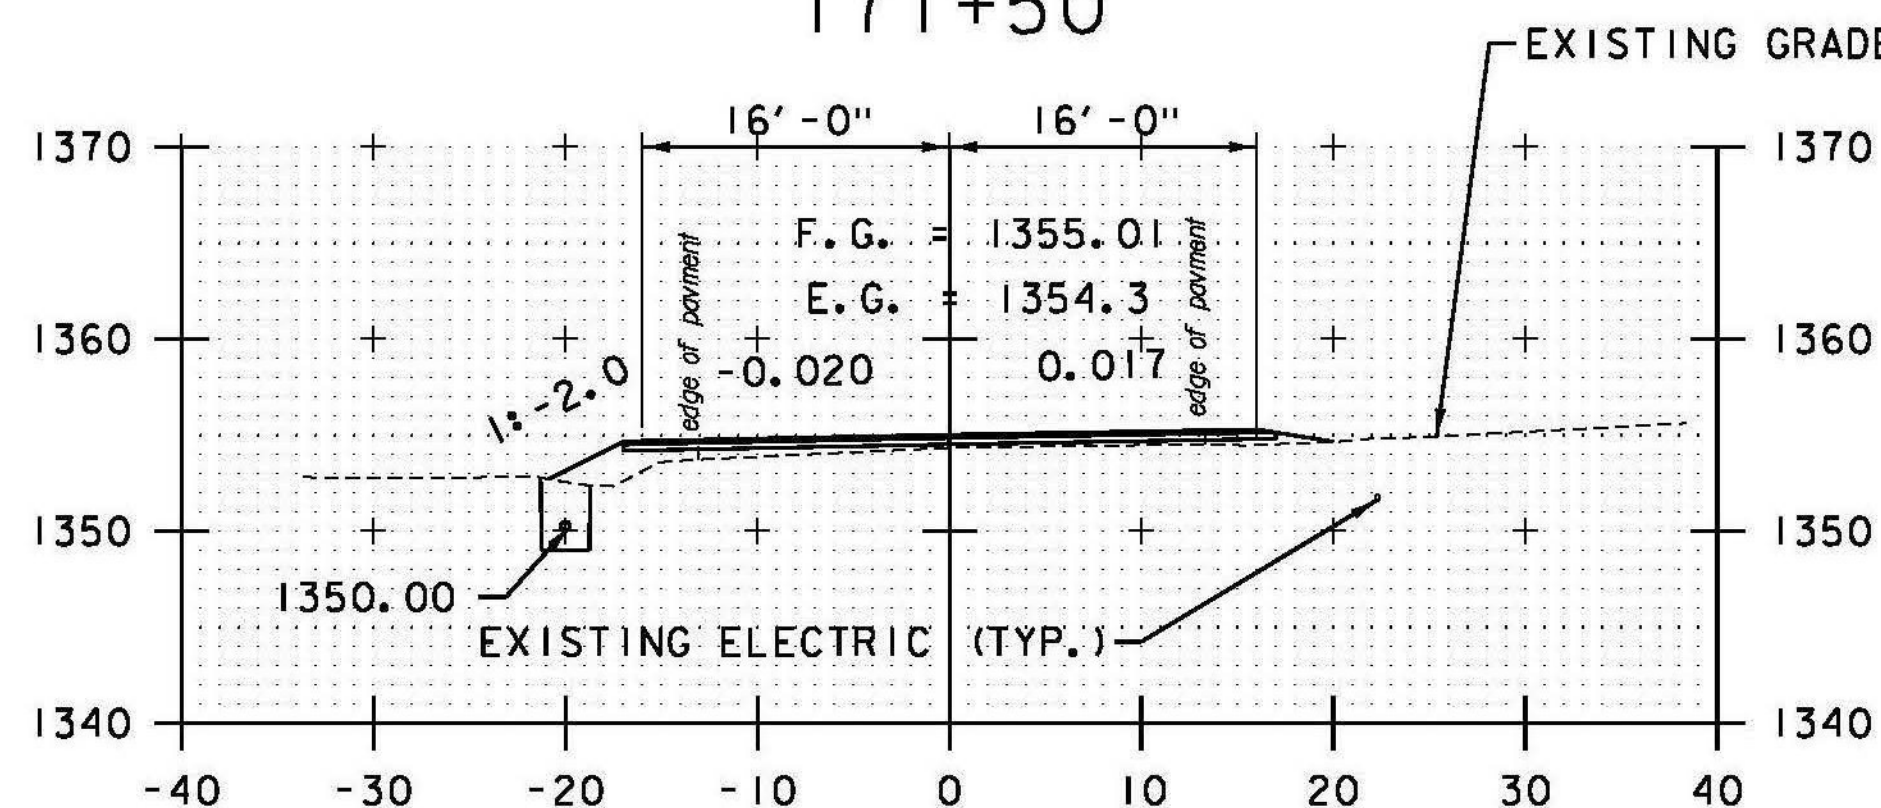

DRIVE RT
171+00

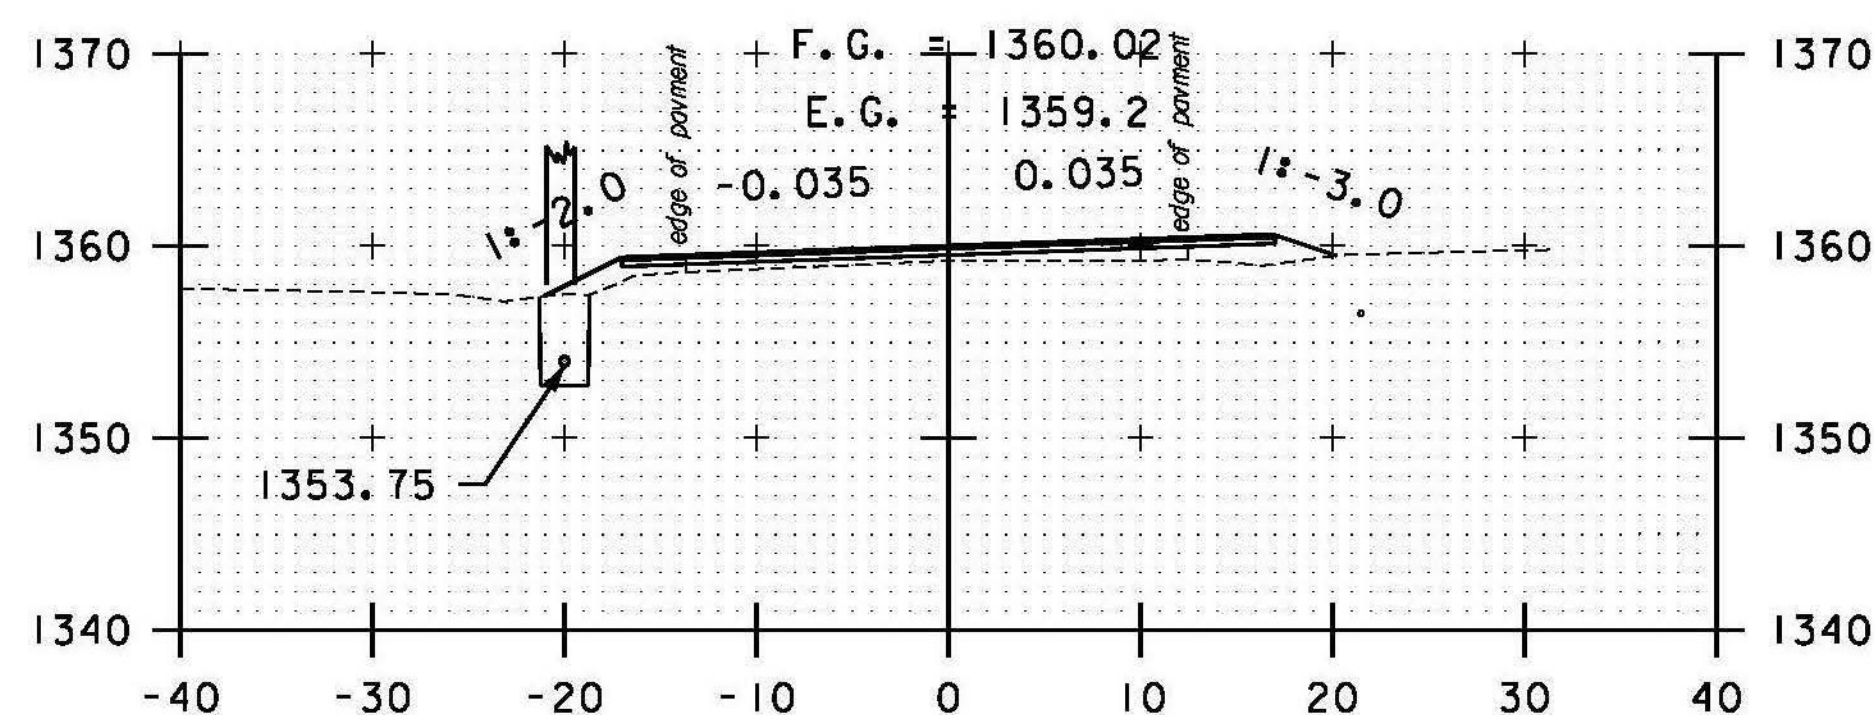


172+50

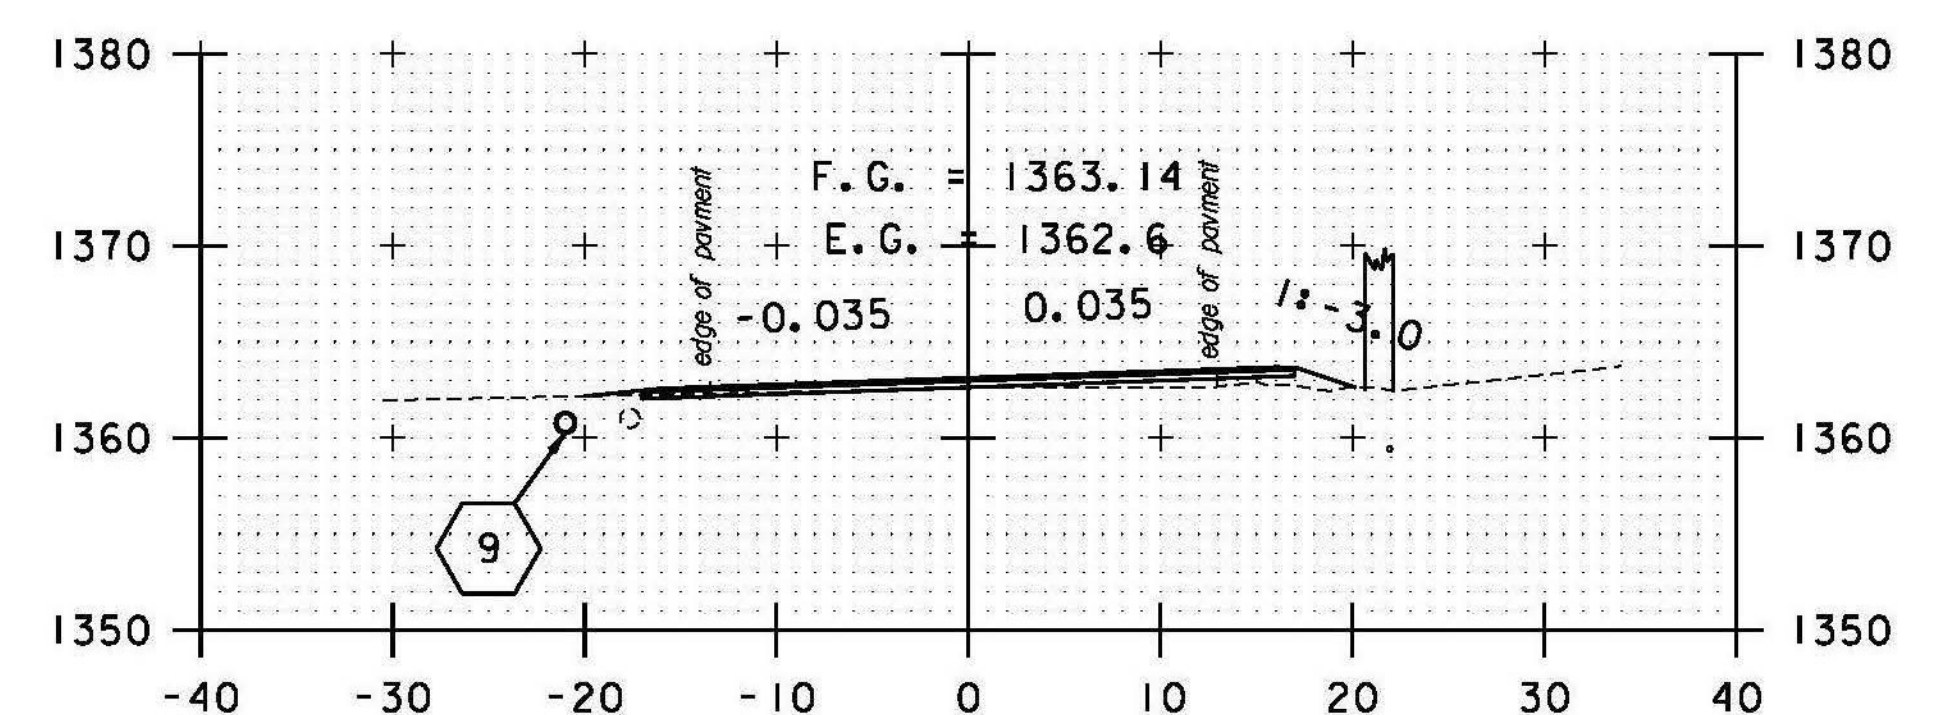

DRIVE LT
174+00

9 STA. 173+86.00 LT 21.00' TO
STA. 174+28.00 LT 21.00'
REMOVED EXISTING 12" CMP
INSTALL 12" CPEP (41'-6")
INV. IN = 1361.25'
INV. OUT = 1359.80'

STA. 171+00 TO STA. 175+00

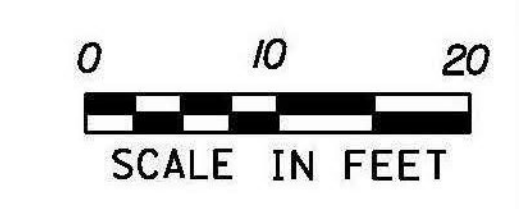

PROJECT NAME: RANDOLPH	PLOT DATE: 6/5/2014
PROJECT NUMBER: STP 2932 (1)	DRAWN BY: B. BRESLEND
FILE NAME: z10c270.dgn	CHECKED BY: C. LATHROP
PROJECT LEADER: C. LATHROP	VT 66 CROSS SECTION SHEET 33
DESIGNED BY: B. BRESLEND	SHEET 189 OF 276

DATUM
VERTICAL NAVD 88
HORIZONTAL NAD 83 (07)