



176+00

10 STA. 175+22.05 LT 30.24' TO
 STA. 176+25.43 RT 34.47'
 REMOVE EXISTING PIPE
 INSTALL 18" CPEP (106'-0")
 INV. IN = 1370.05'
 INV. OUT = 1364.95'


11 STA. 177+25.00 RT 21.00' TO
 STA. 177+57.00 RT 21.00'
 REMOVE EXISTING 15" CMP
 INSTALL 15" CPEP (32'-0")
 INV. IN = 1375.70'
 INV. OUT = 1374.35'

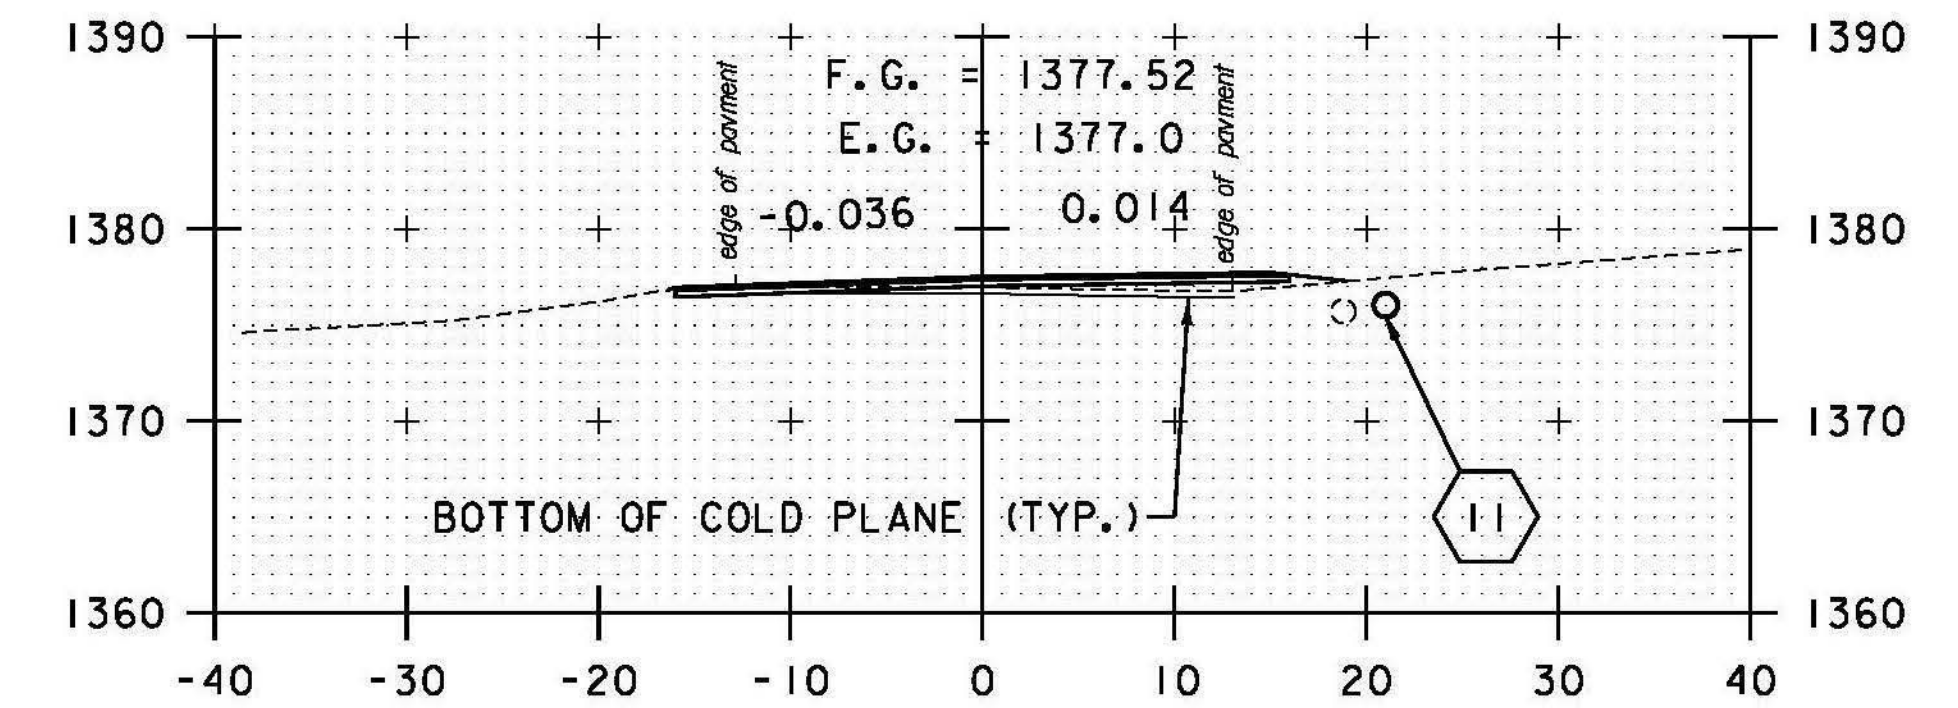


DRIVE RT
 177+50

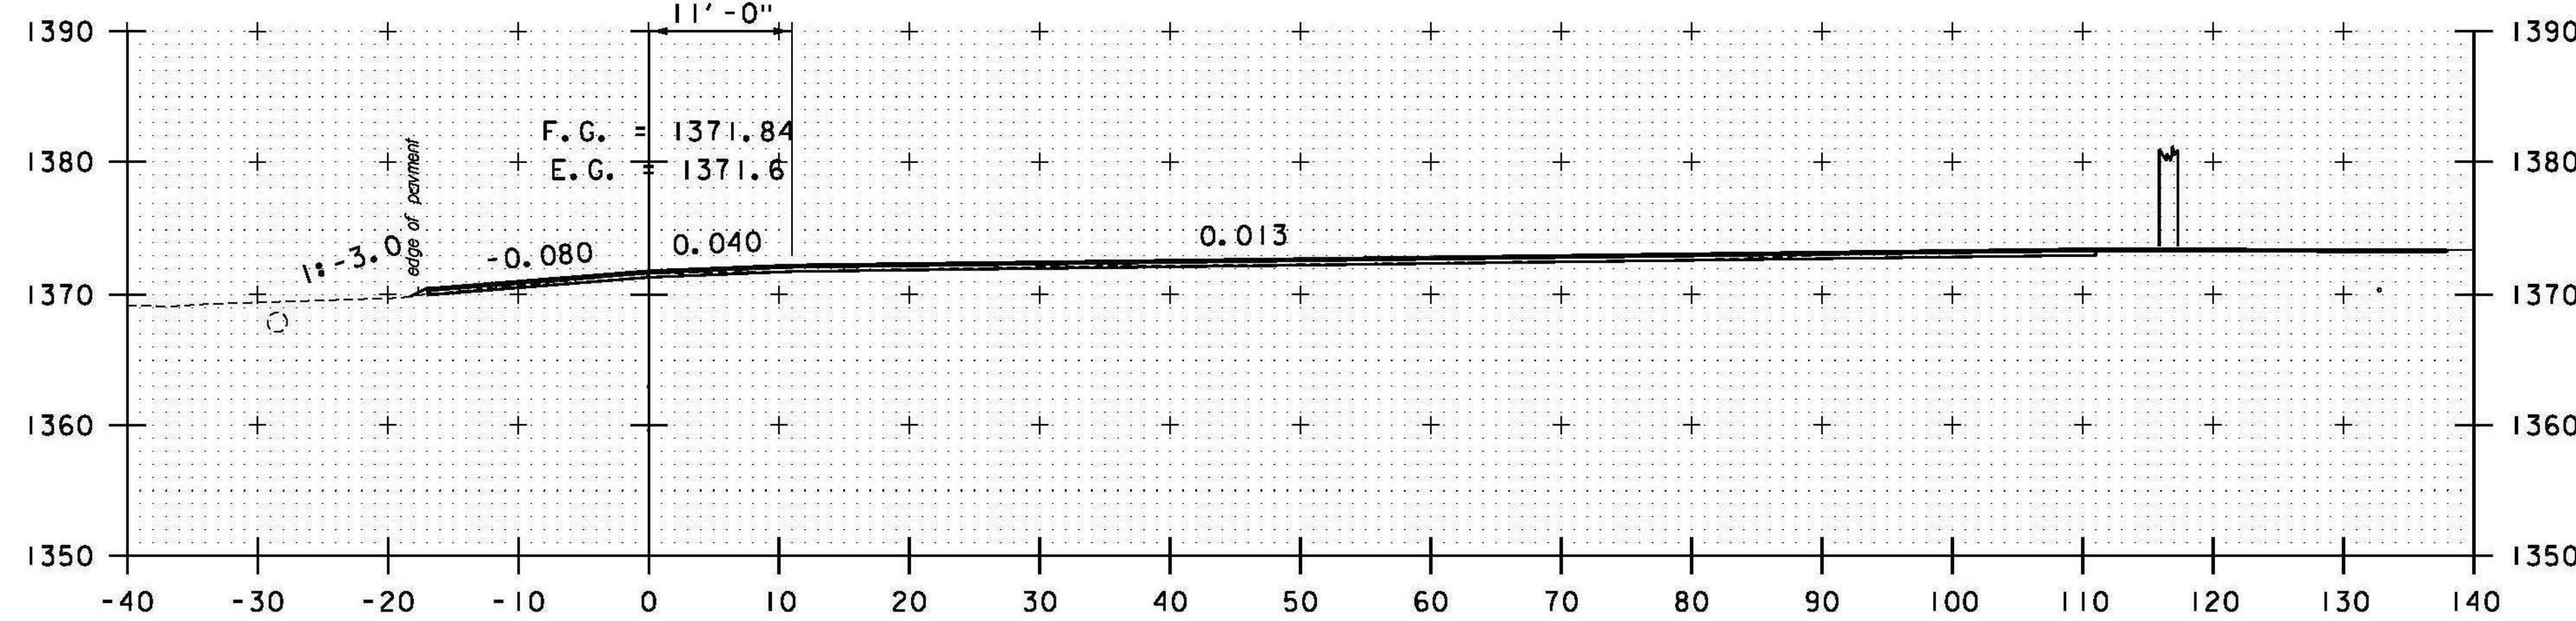


TH#2 RT
 175+77

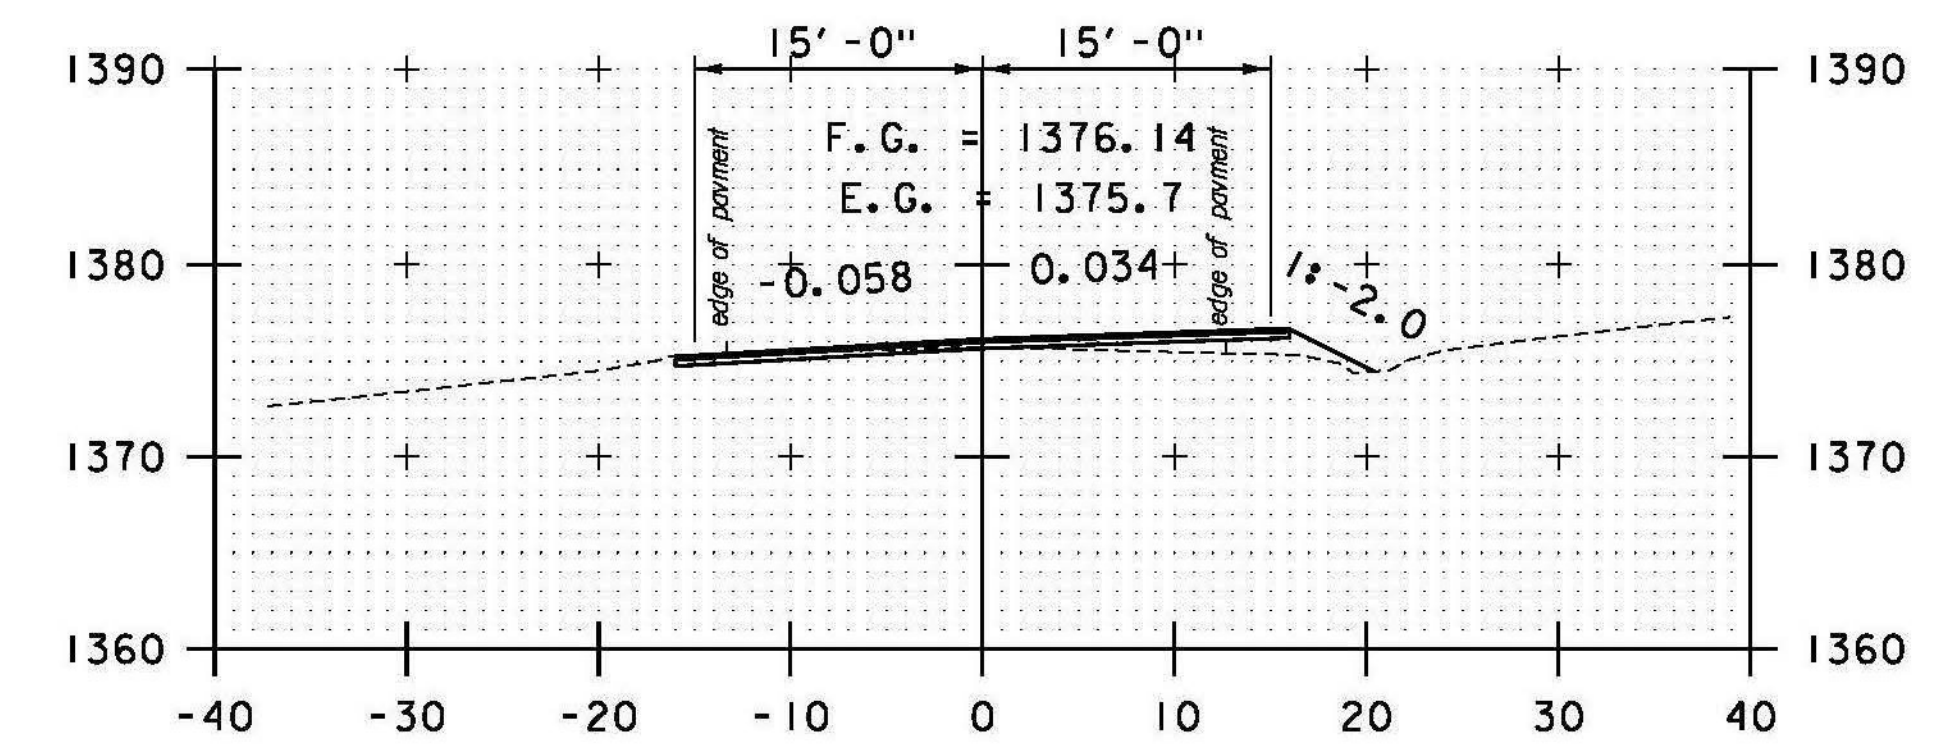

177+00

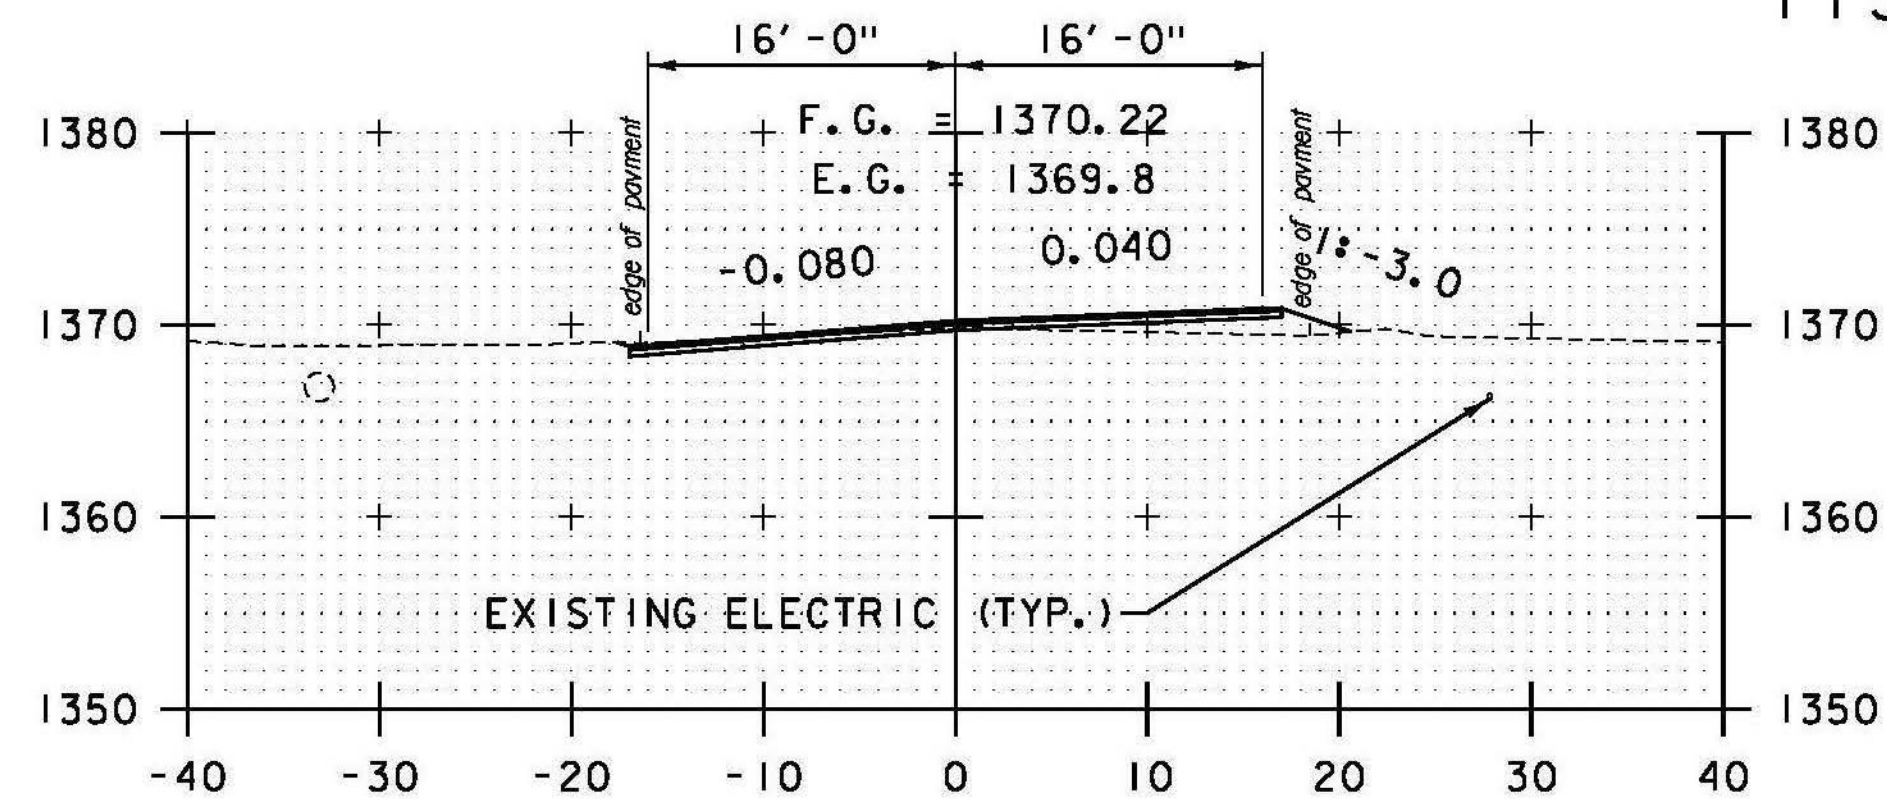


175+50

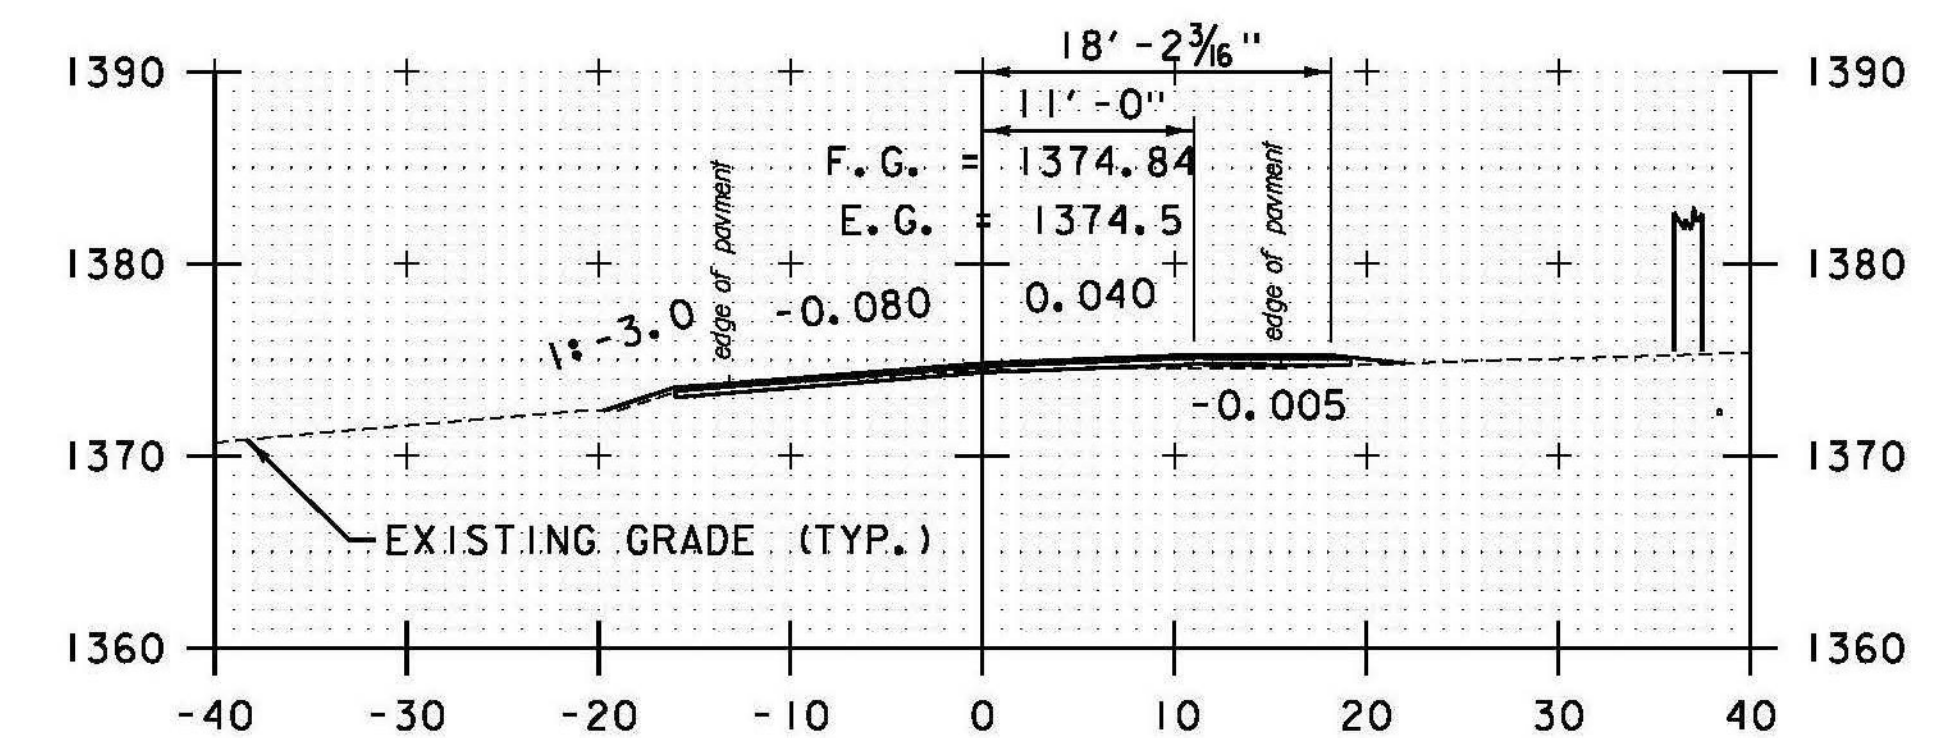

DRIVE RT
 176+50

STA. 175+50 TO STA. 177+50

DATUM
 VERTICAL NAVD 88
 HORIZONTAL NAD 83 (07)

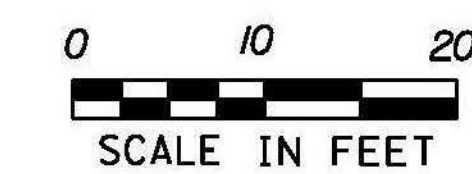

PROJECT NAME: RANDOLPH
 PROJECT NUMBER: STP 2932 (1)

FILE NAME: z10c270.dgn
 PROJECT LEADER: C. LATHROP
 DESIGNED BY: B. BRESLEND
 VT 66 CROSS SECTION SHEET 34

PLOT DATE: 6/5/2014
 DRAWN BY: B. BRESLEND
 CHECKED BY: C. LATHROP
 SHEET 190 OF 276