




DRIVE LT
179+00

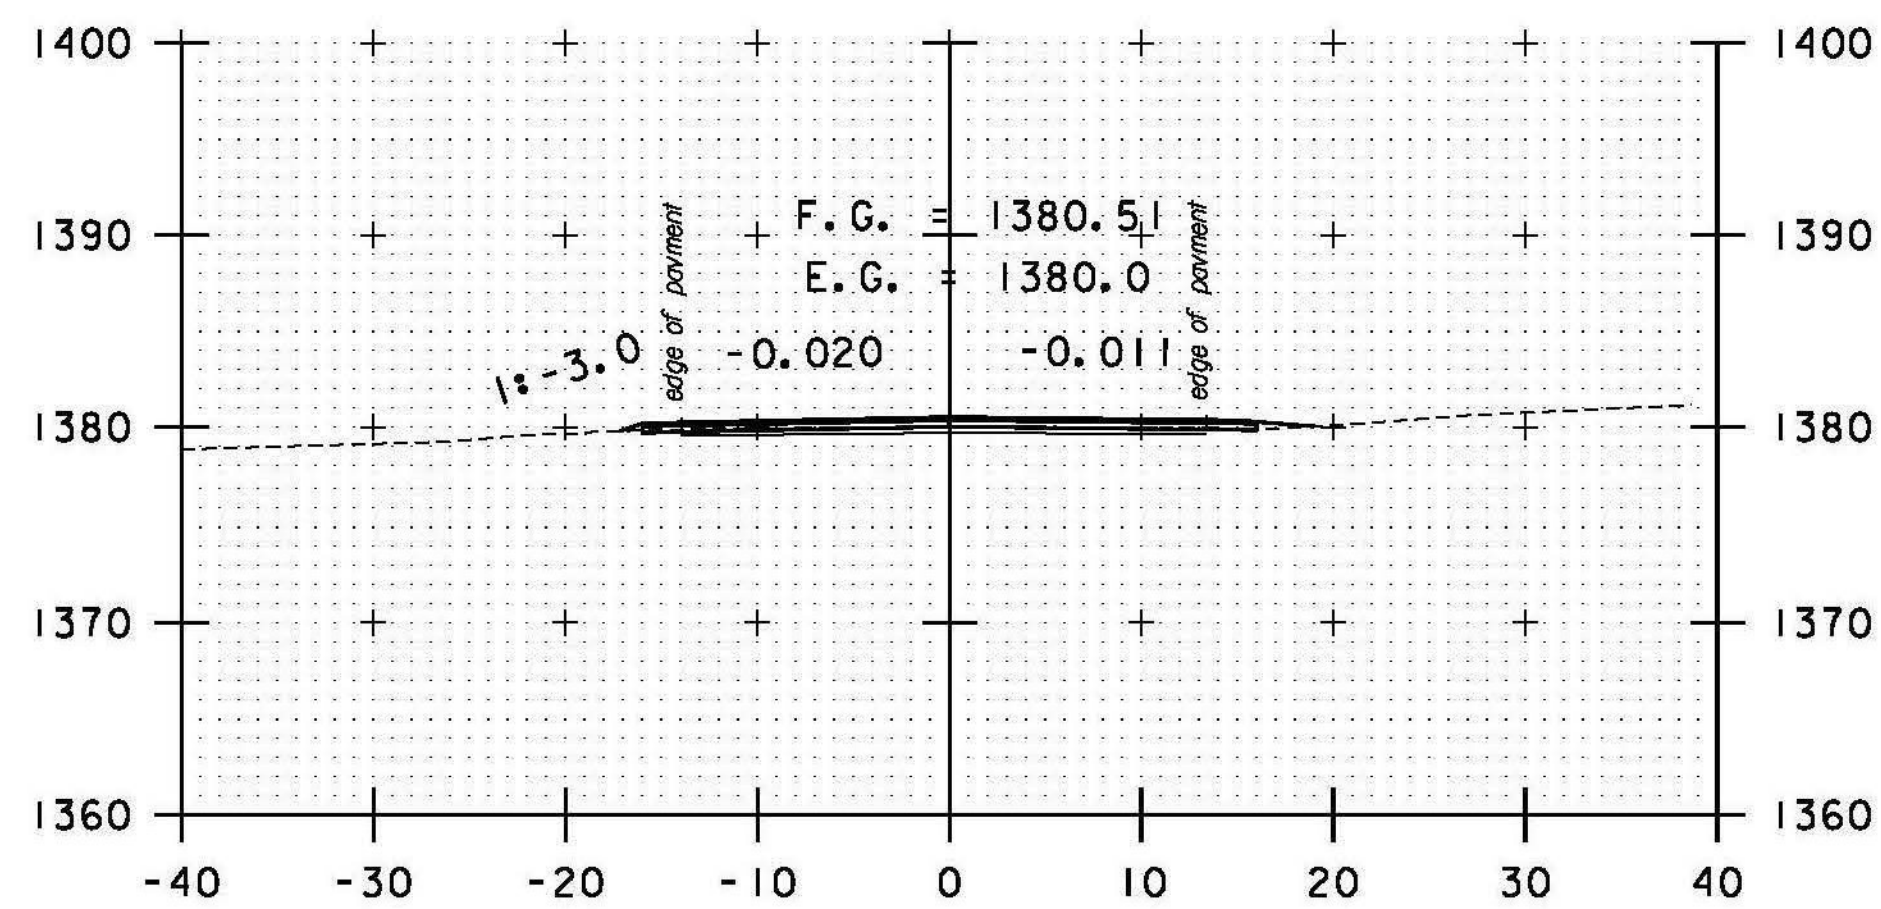


DRIVE RT
178+50

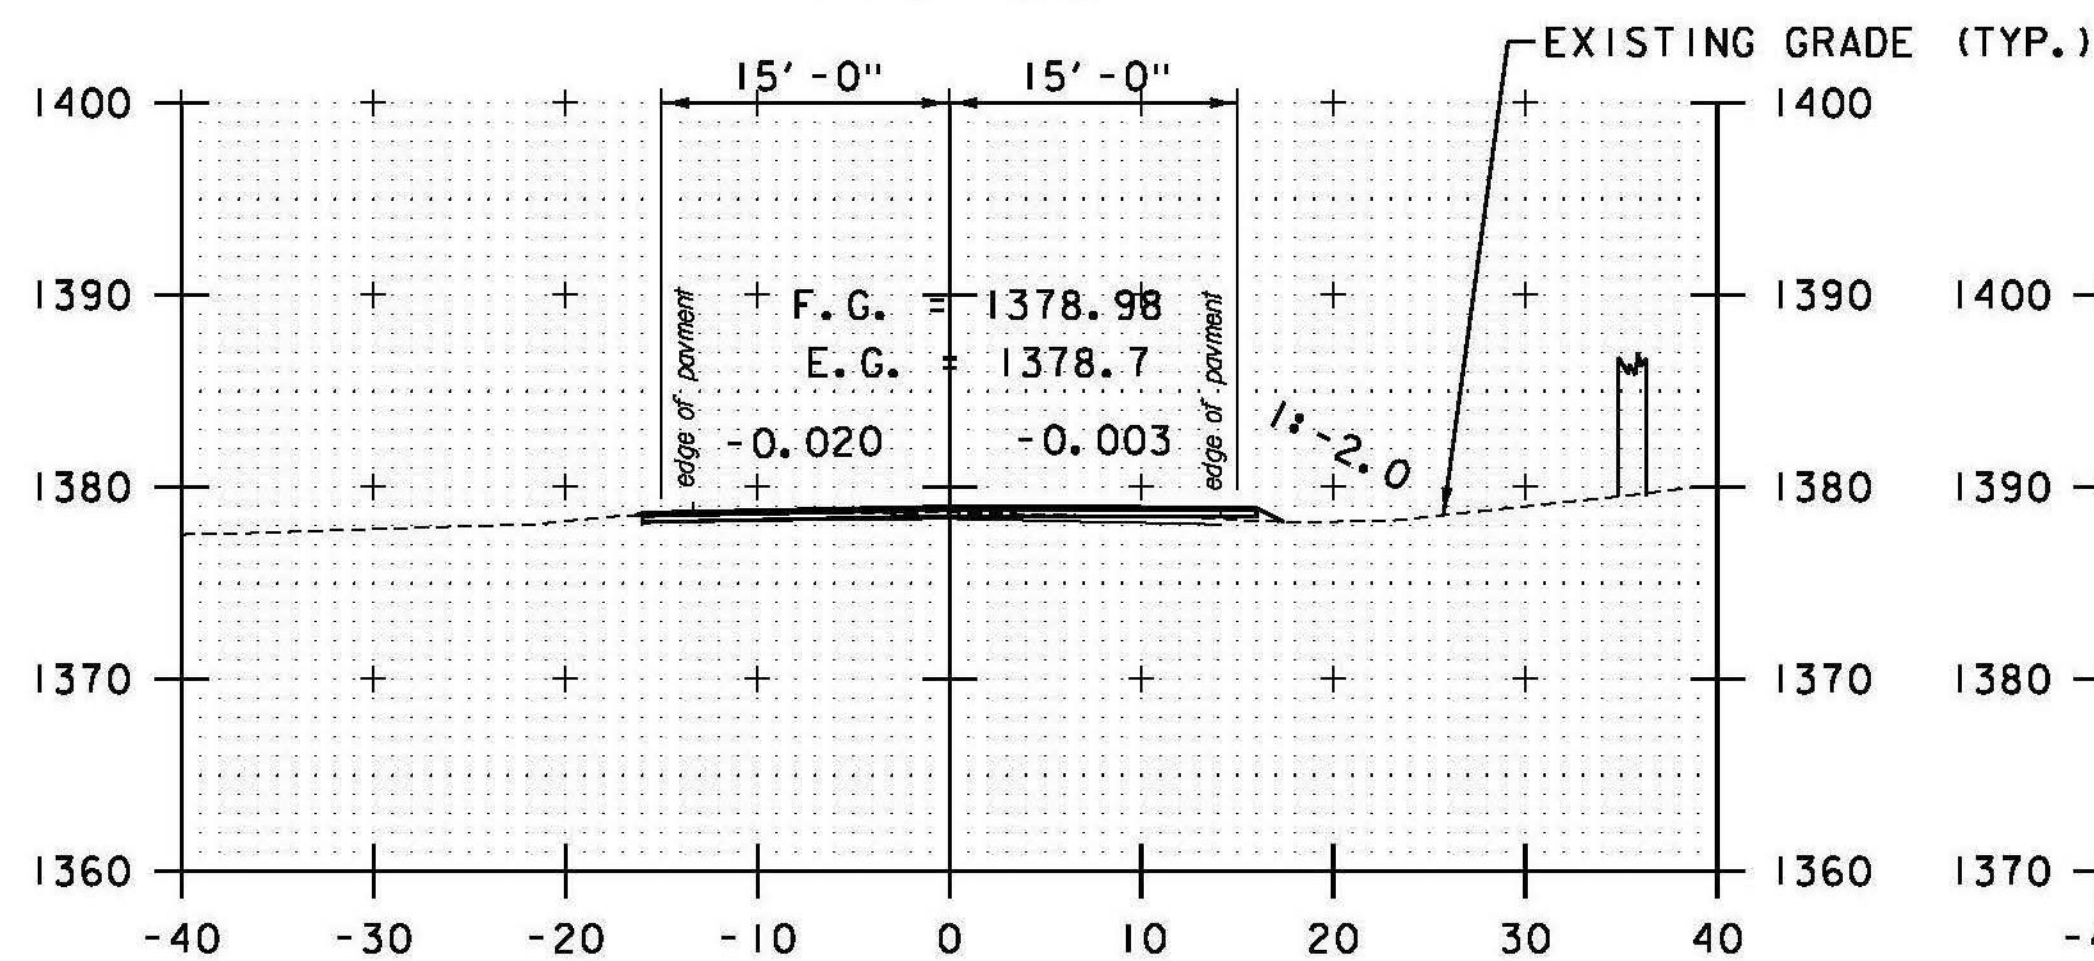


178+00

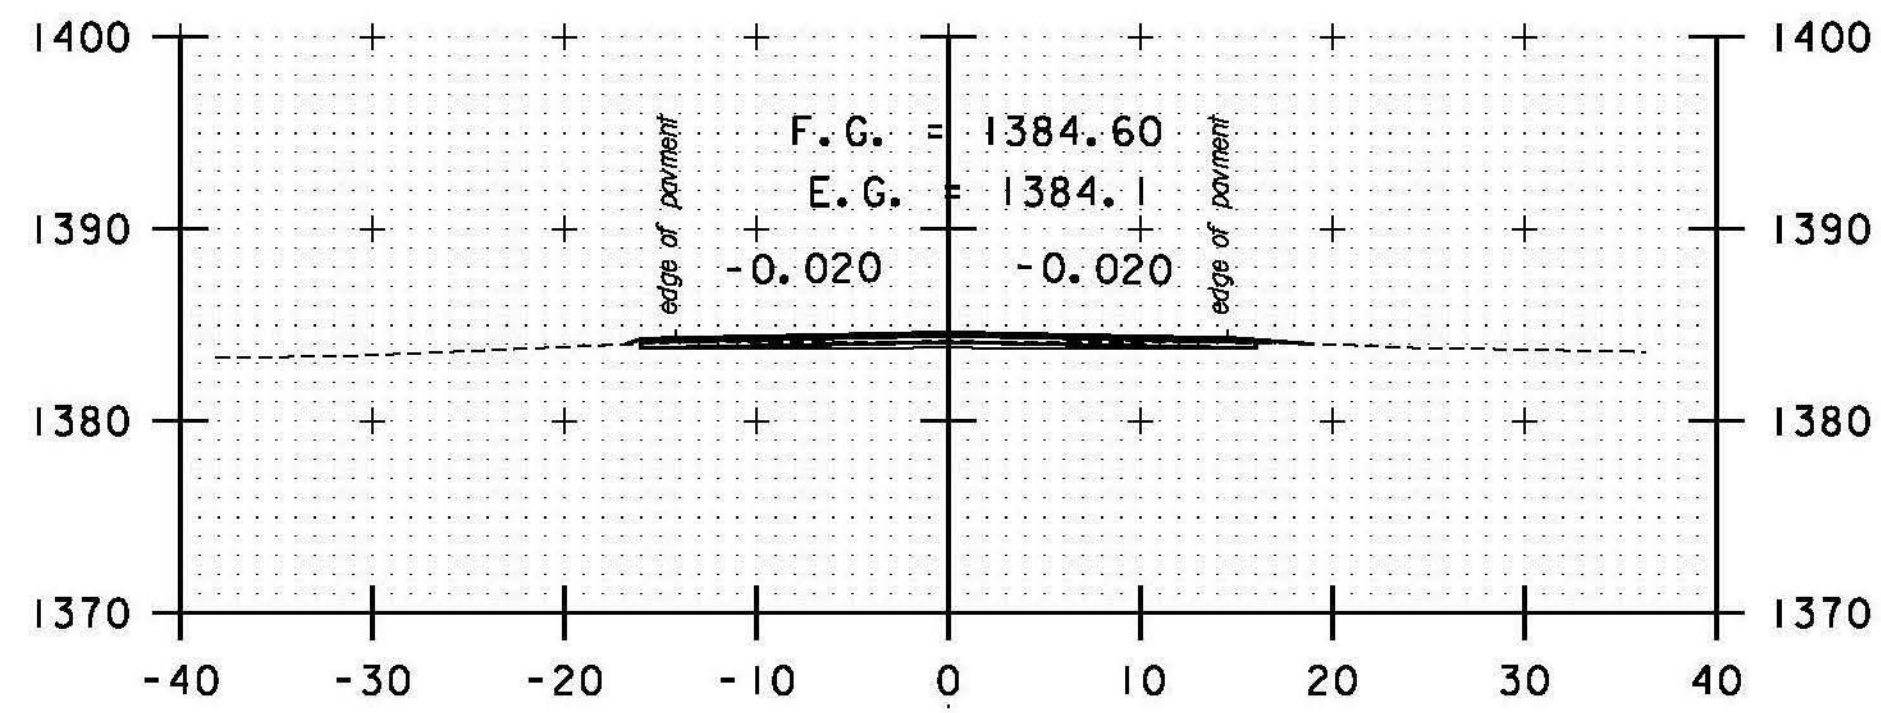


DRIVE RT
180+50

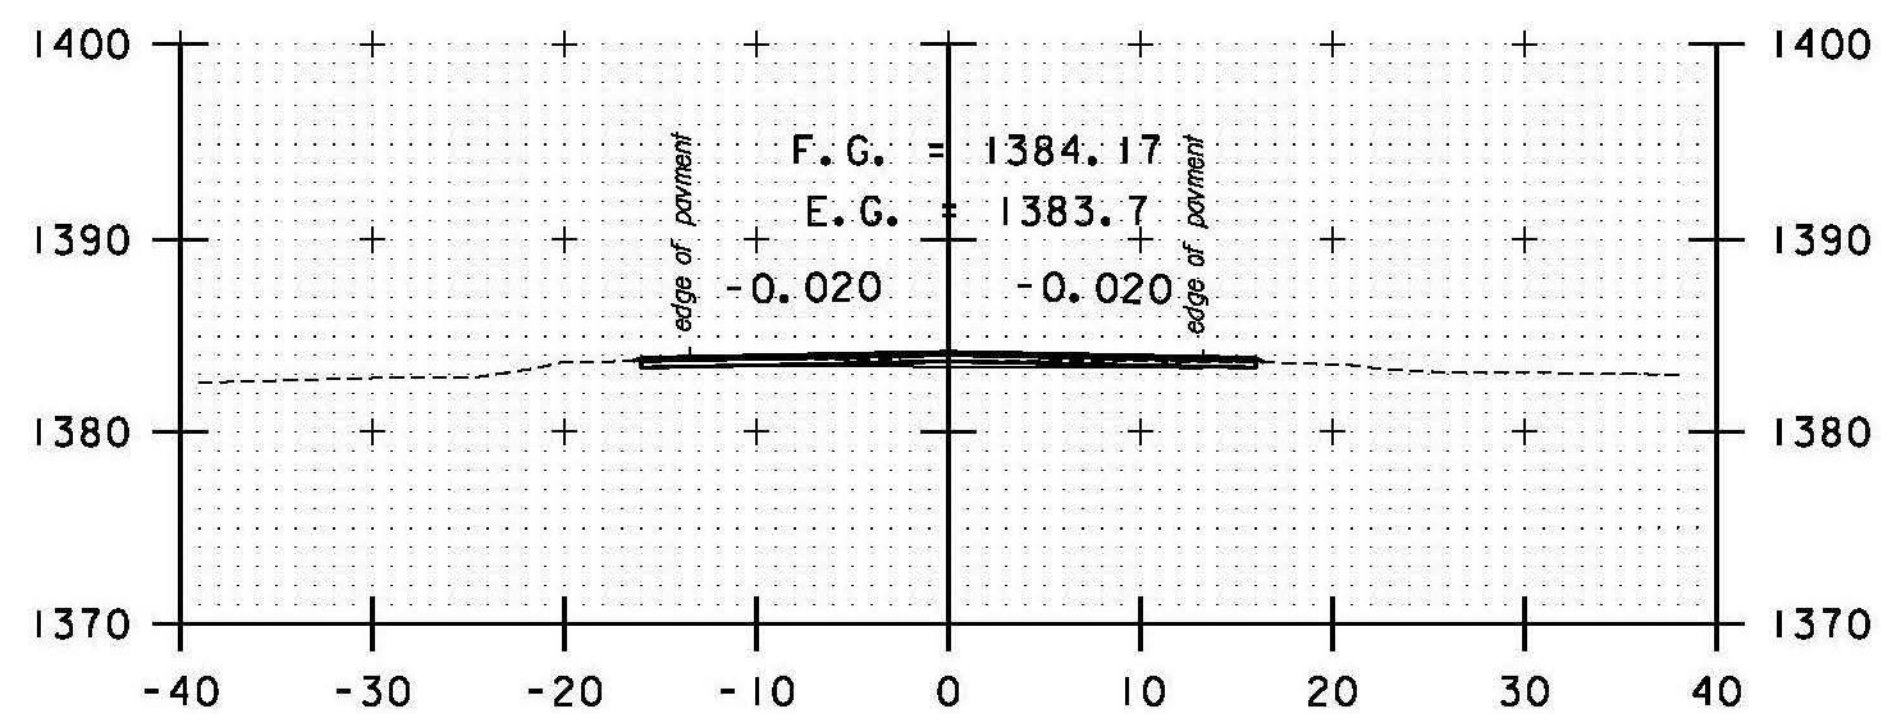


180+00

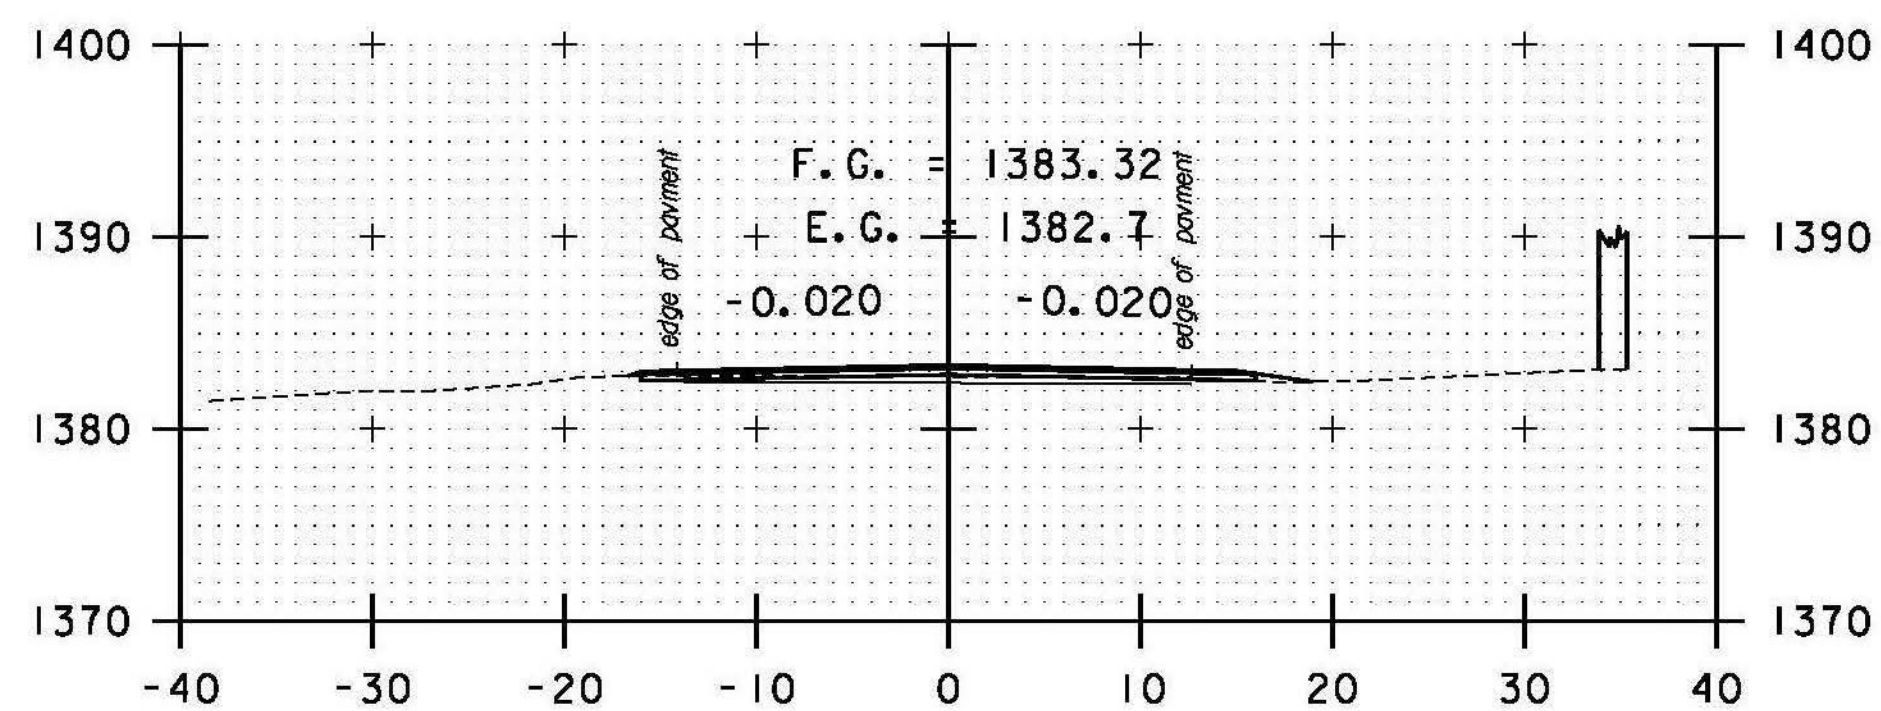


DRIVE RT
179+50

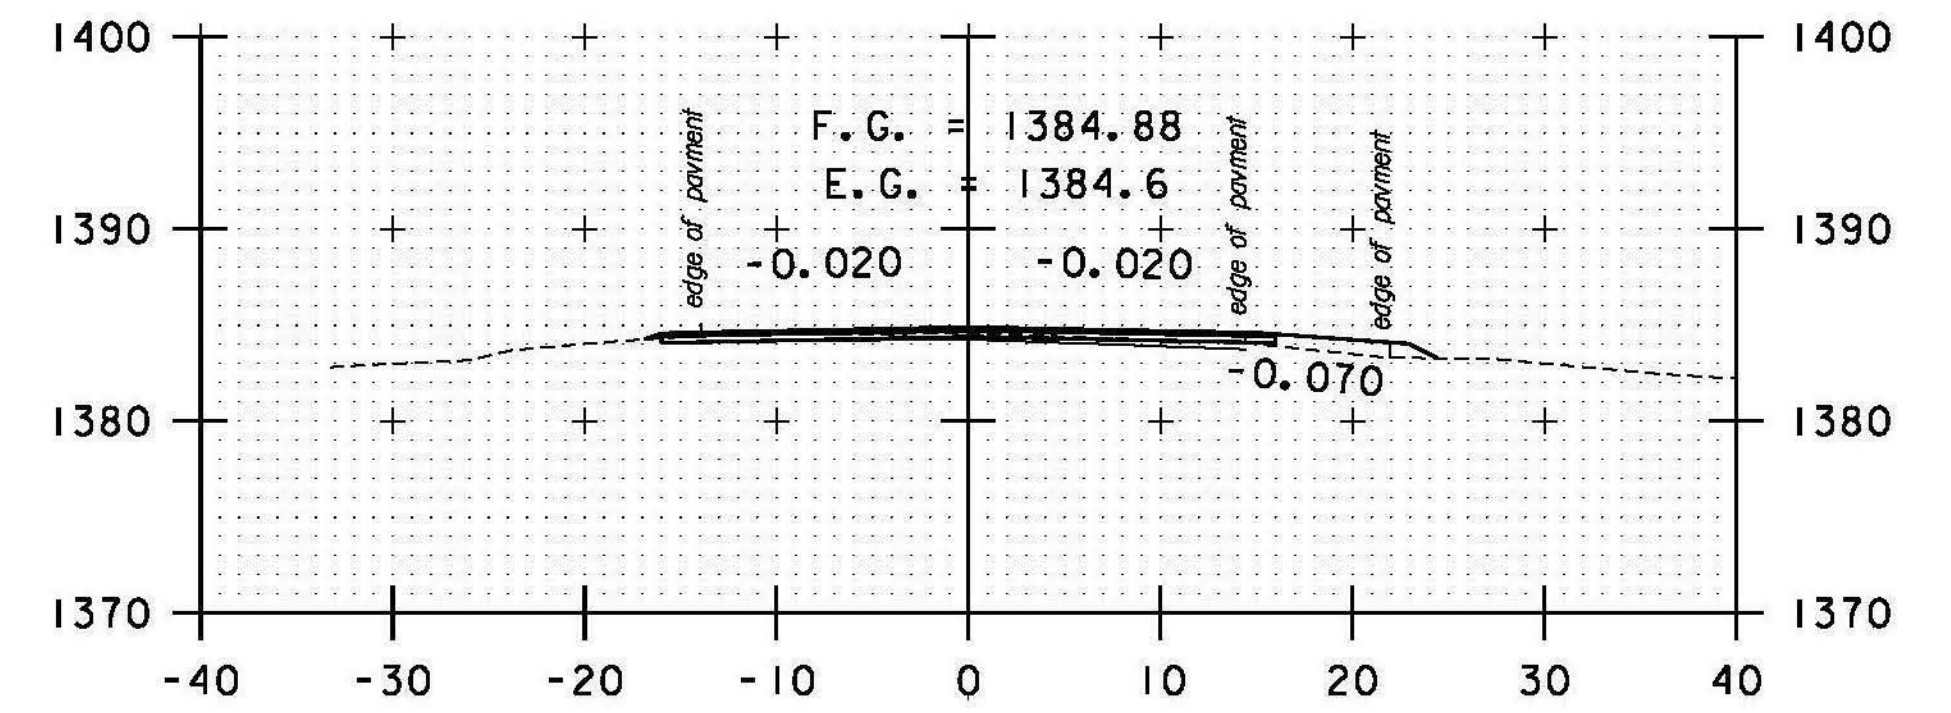

TH#50 RT
181+50

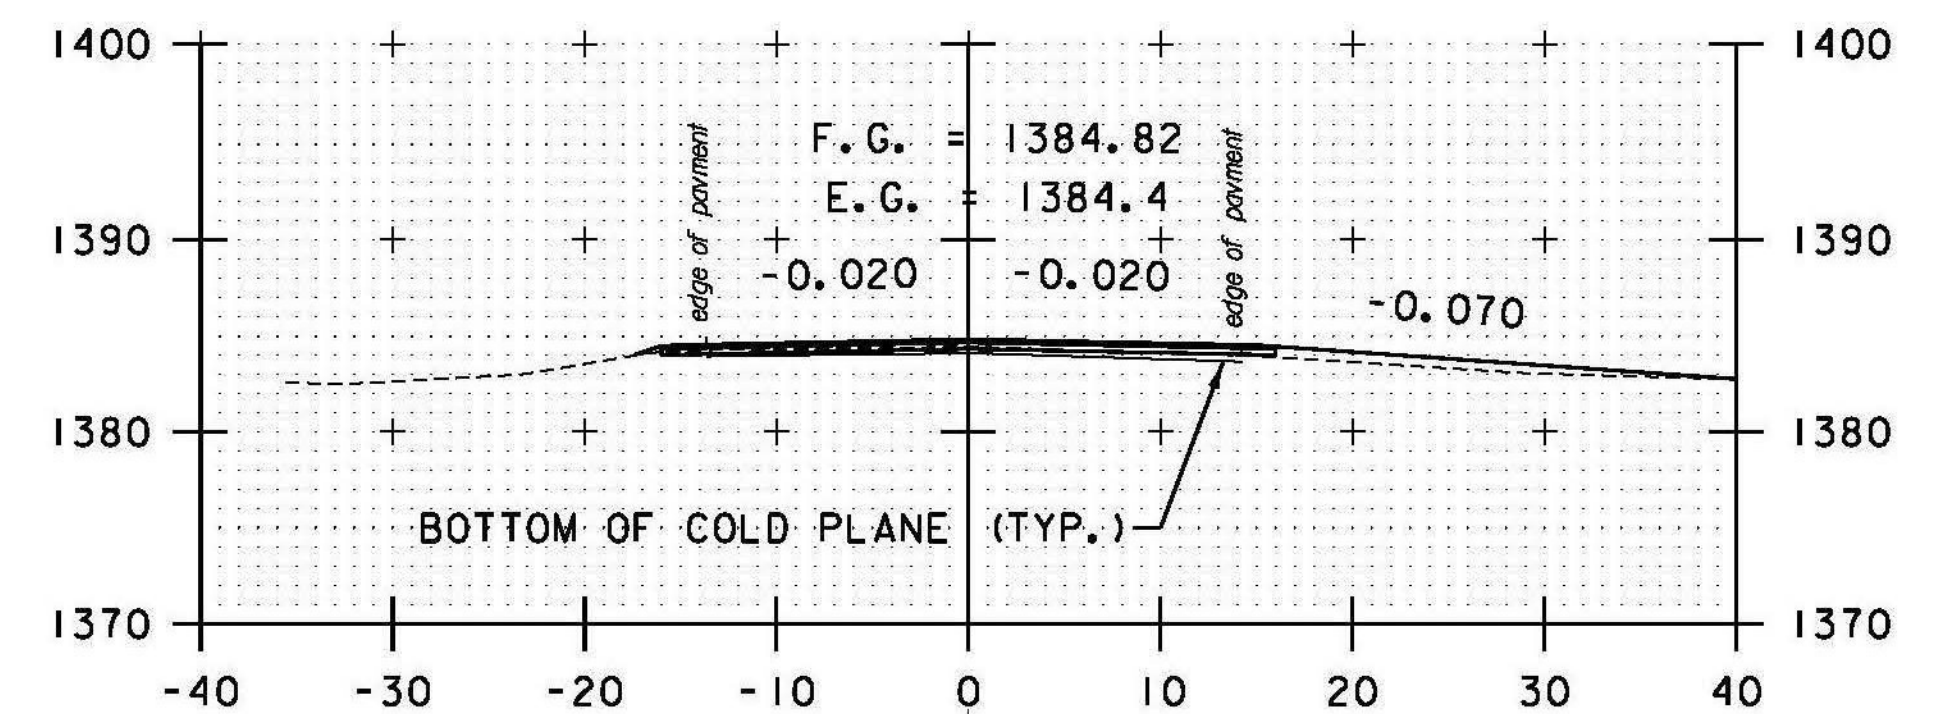


TH#50 RT
181+27

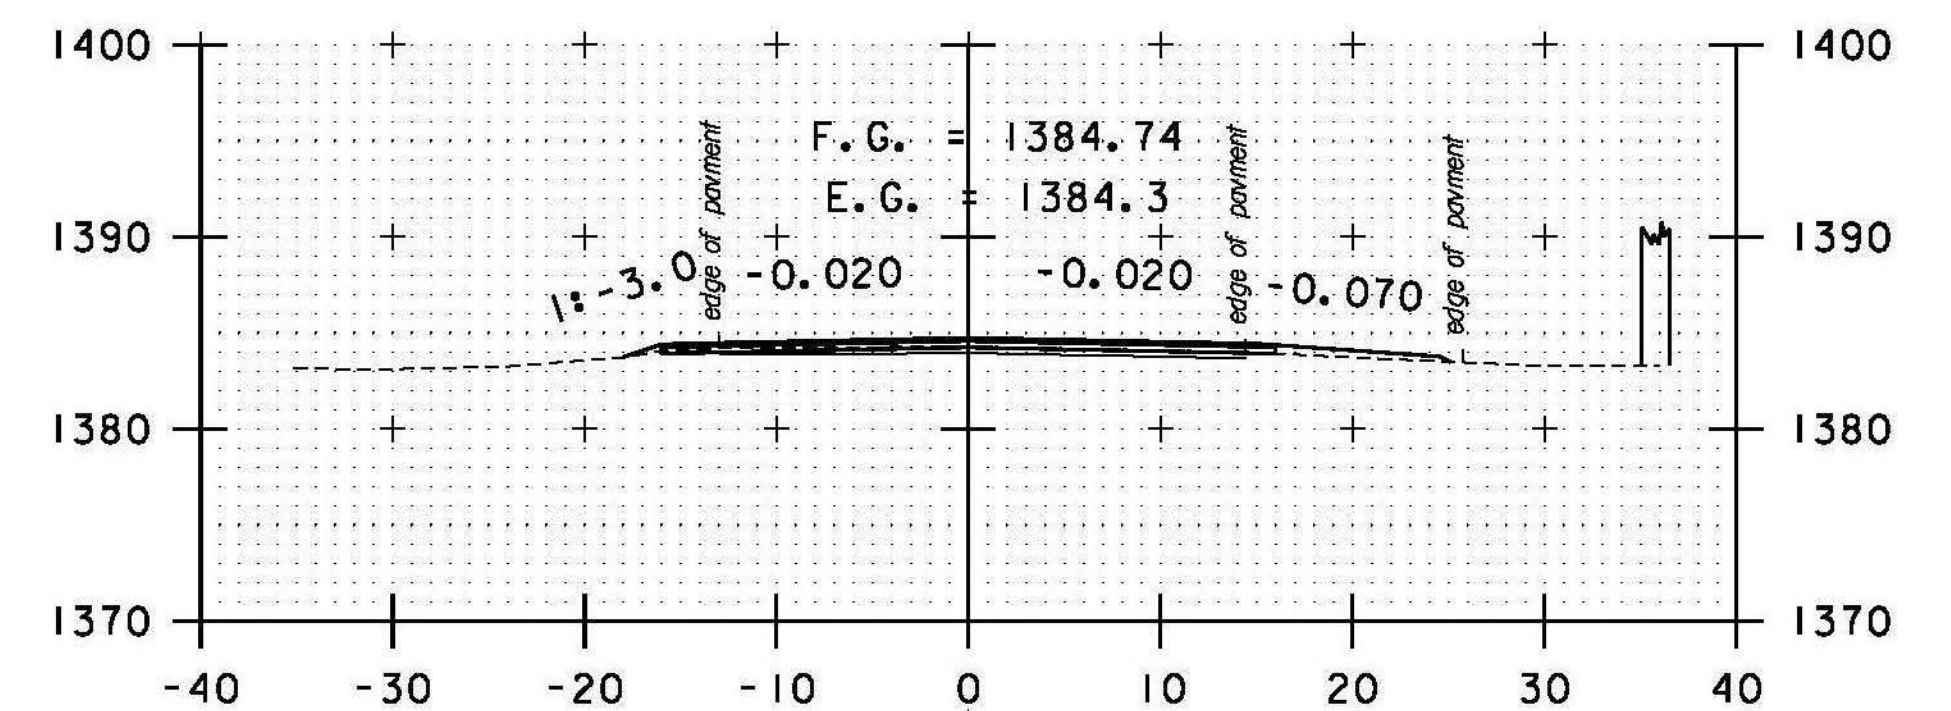

TH#50 RT
181+00

STA. 178+00 TO STA. 181+50

DATUM
VERTICAL NAVD 88
HORIZONTAL NAD 83 (07)

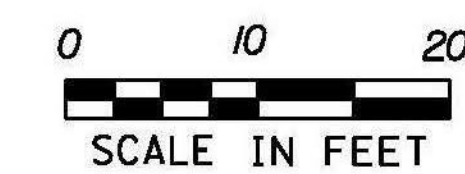

PROJECT NAME: RANDOLPH
PROJECT NUMBER: STP 2932 (1)

FILE NAME: z10c270.dgn
PROJECT LEADER: C. LATHROP
DESIGNED BY: B. BRESLEND
VT 66 CROSS SECTION SHEET 35

PLOT DATE: 6/5/2014
DRAWN BY: B. BRESLEND
CHECKED BY: C. LATHROP
SHEET 191 OF 276