




183+00

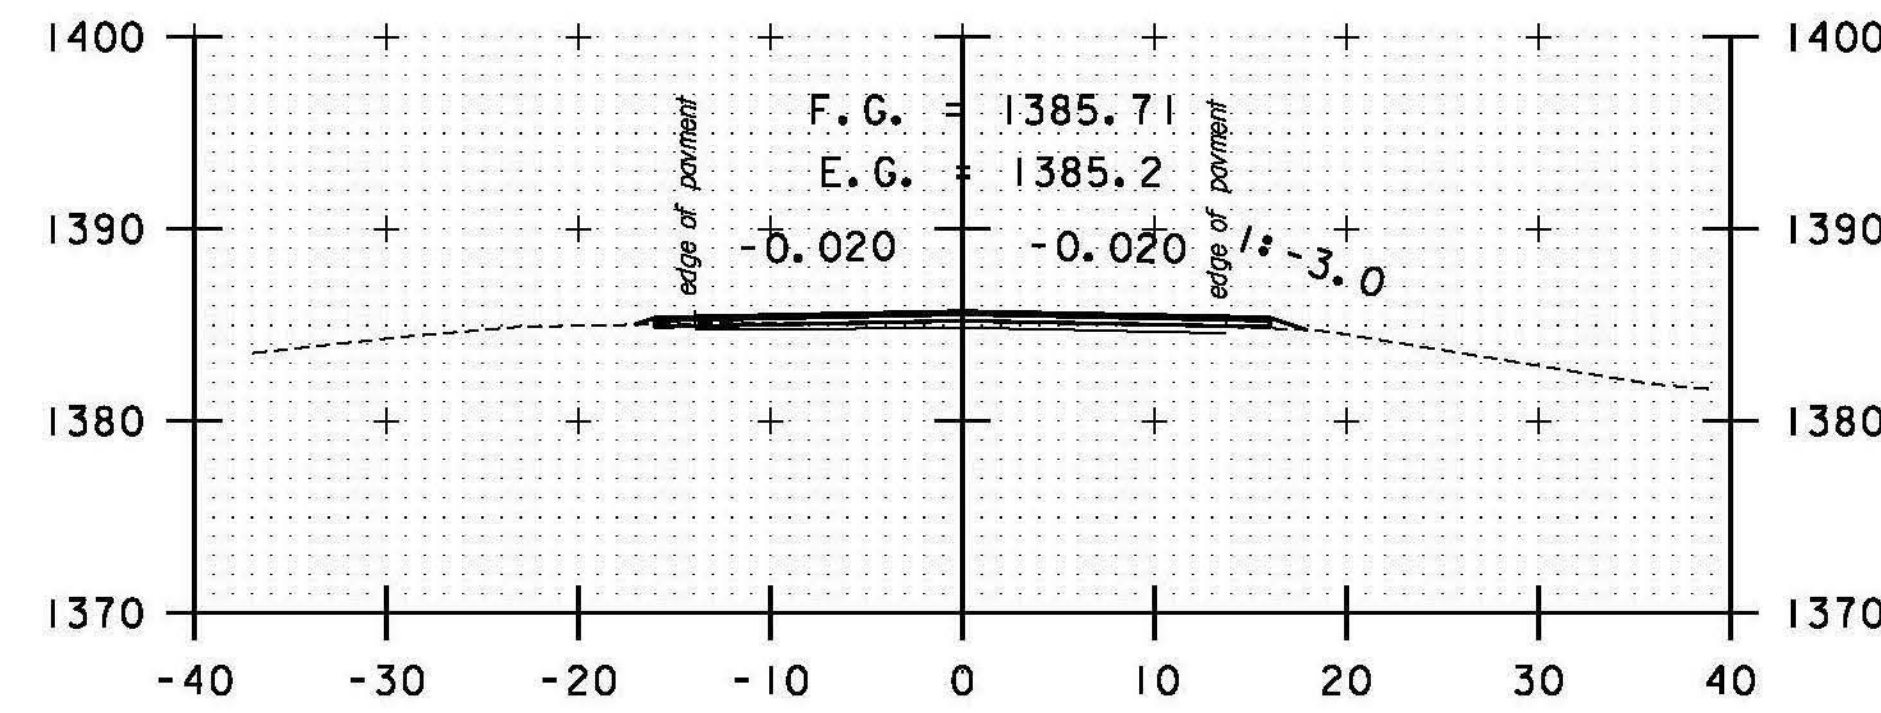


184+50

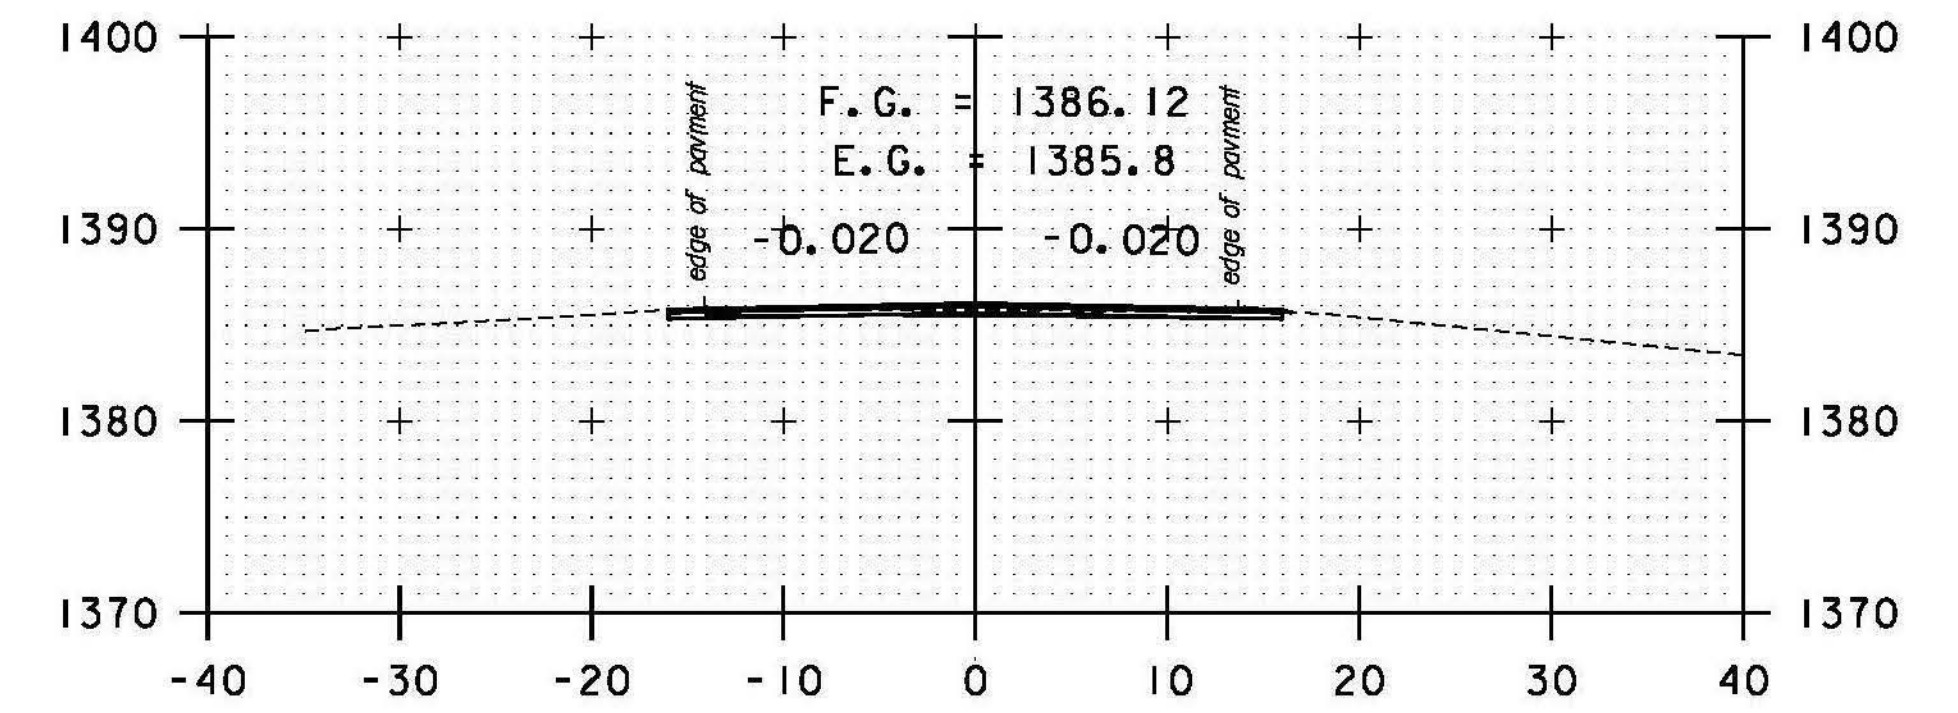


186+00

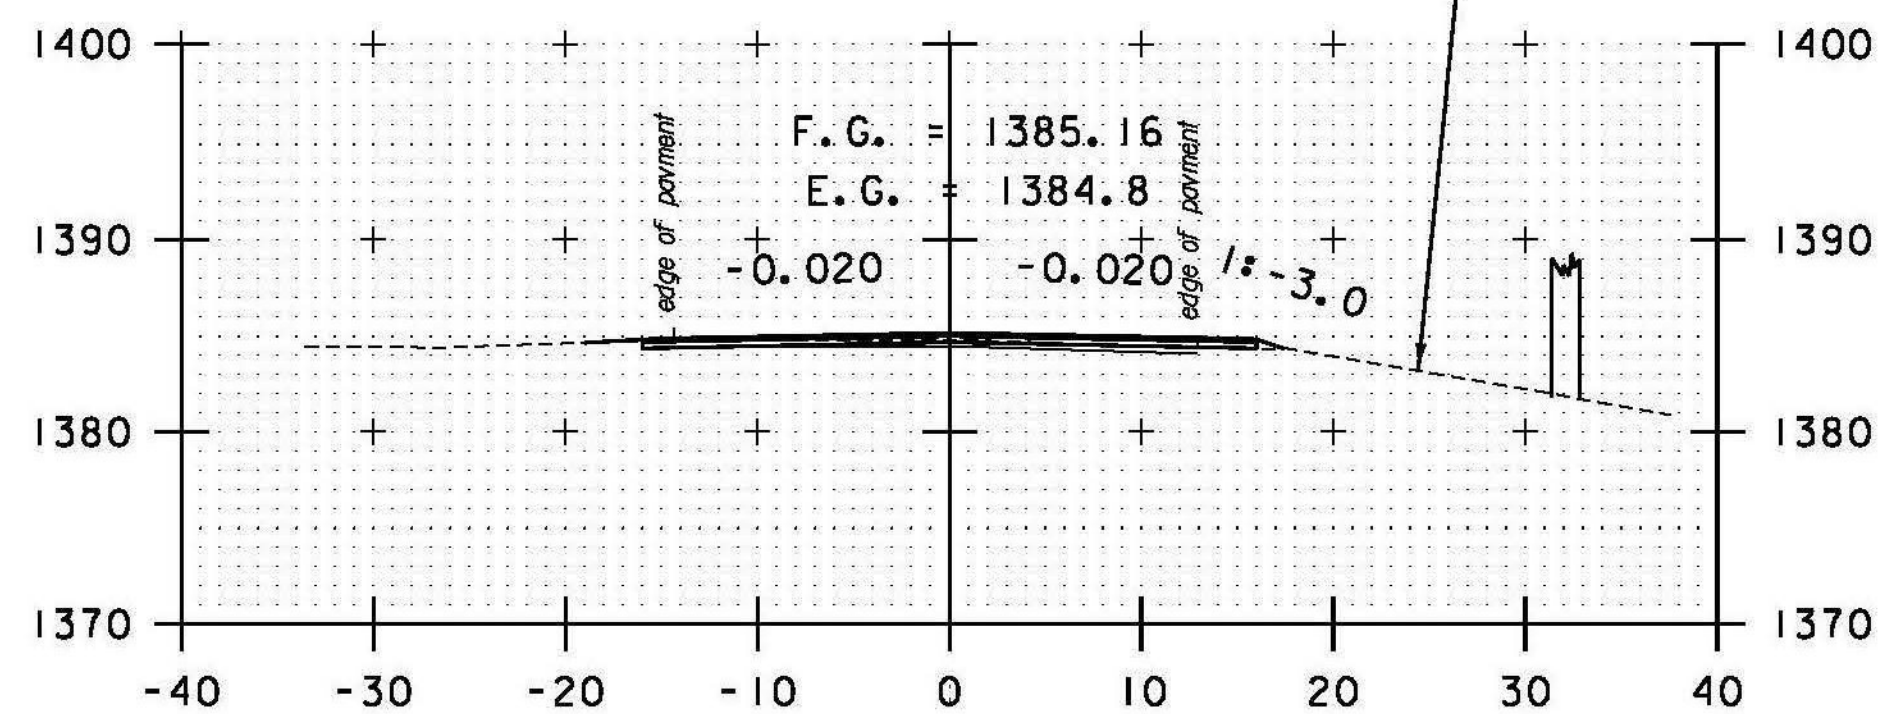


DRIVE LT
182+50

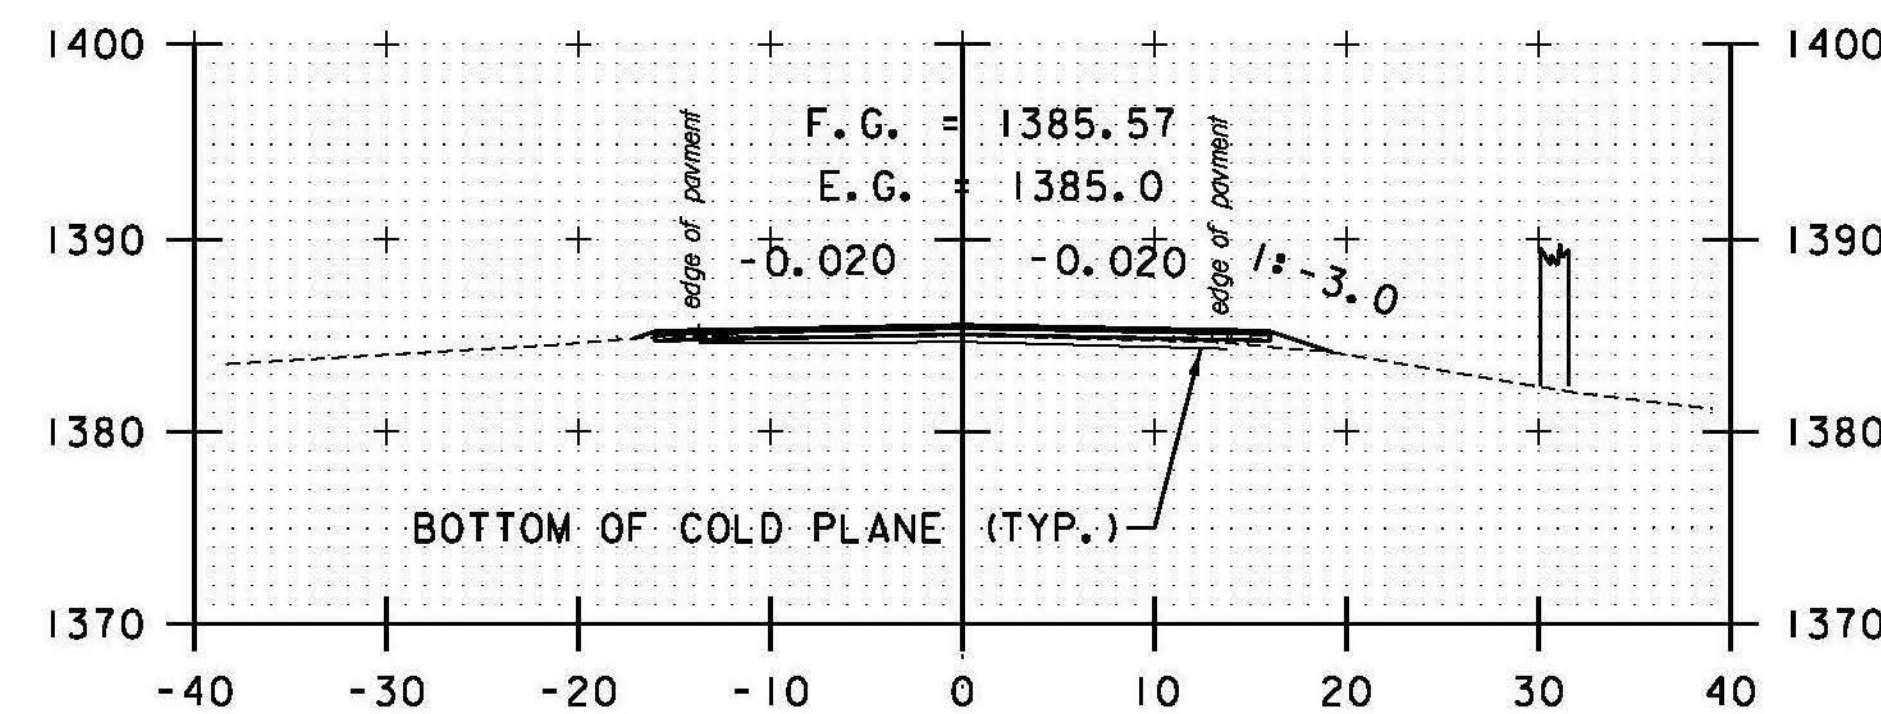


184+00

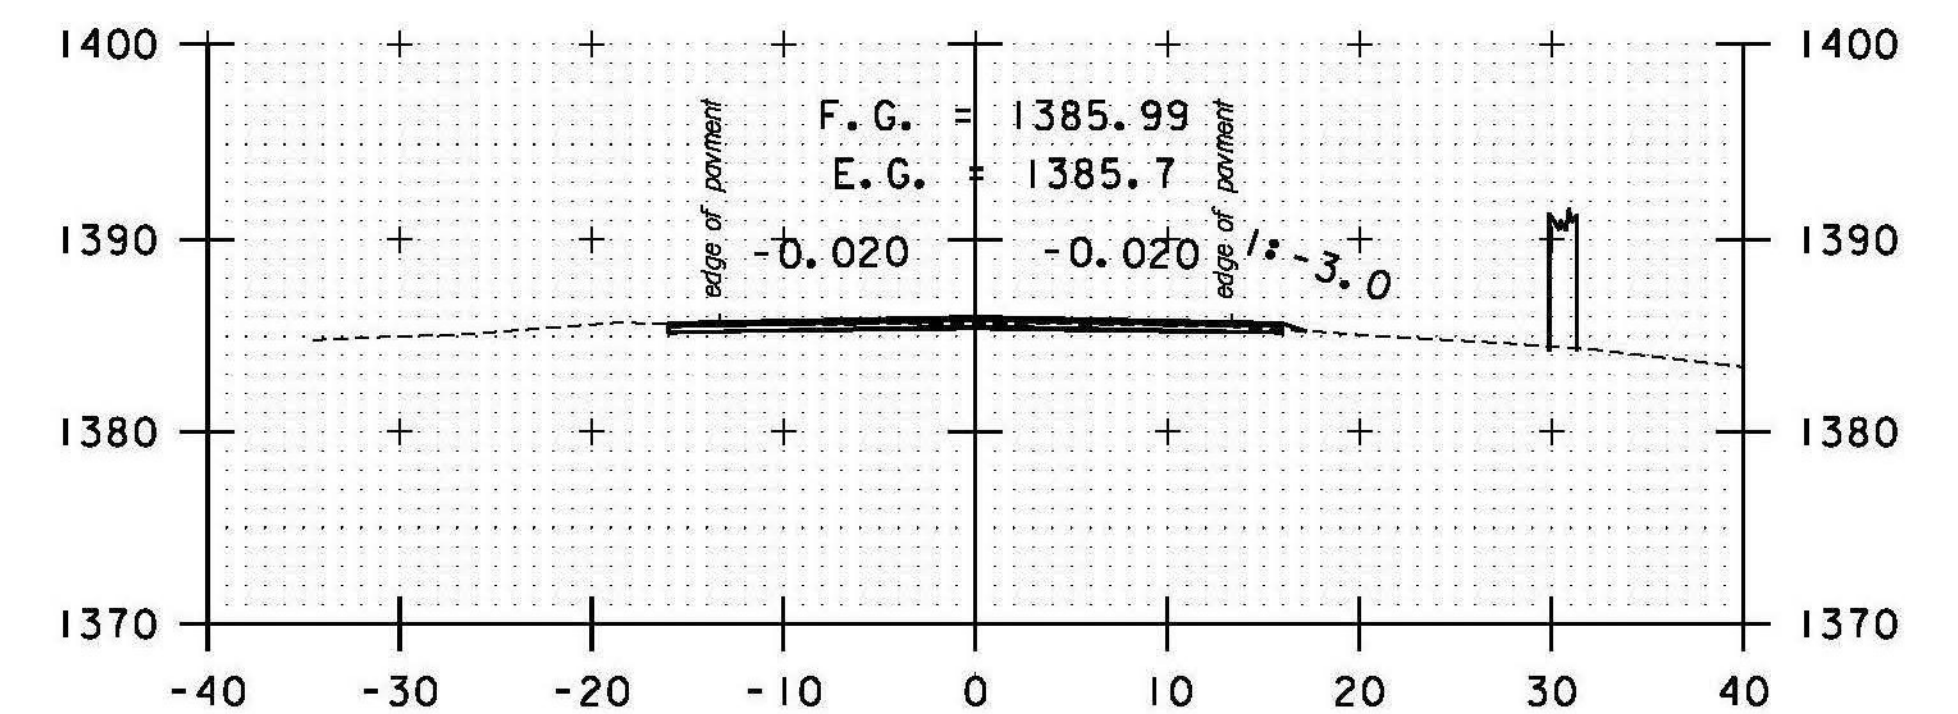


185+50

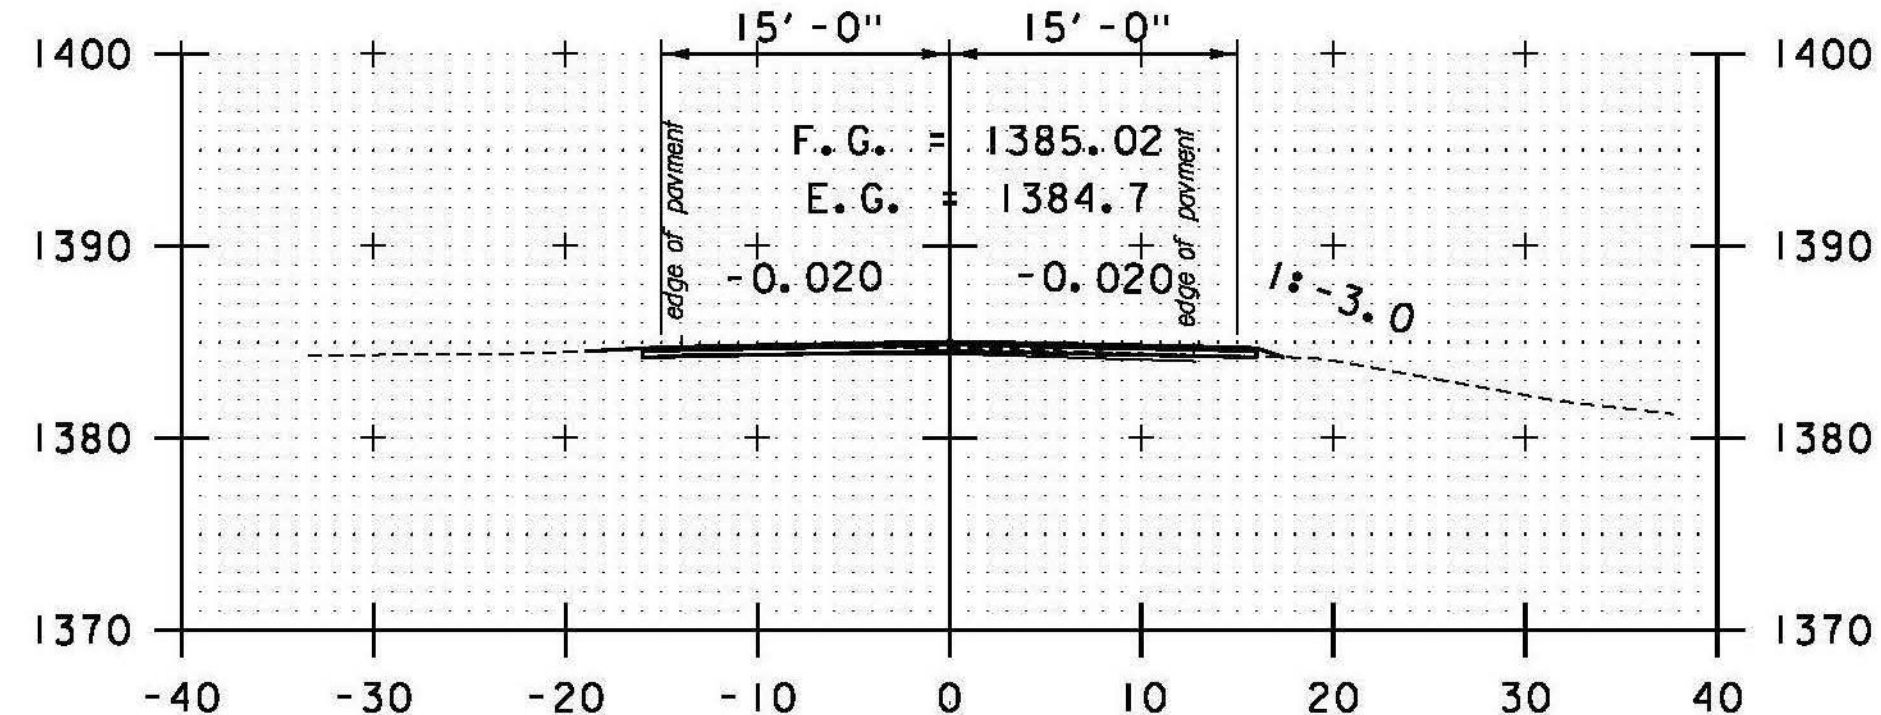

DRIVE LT
182+00

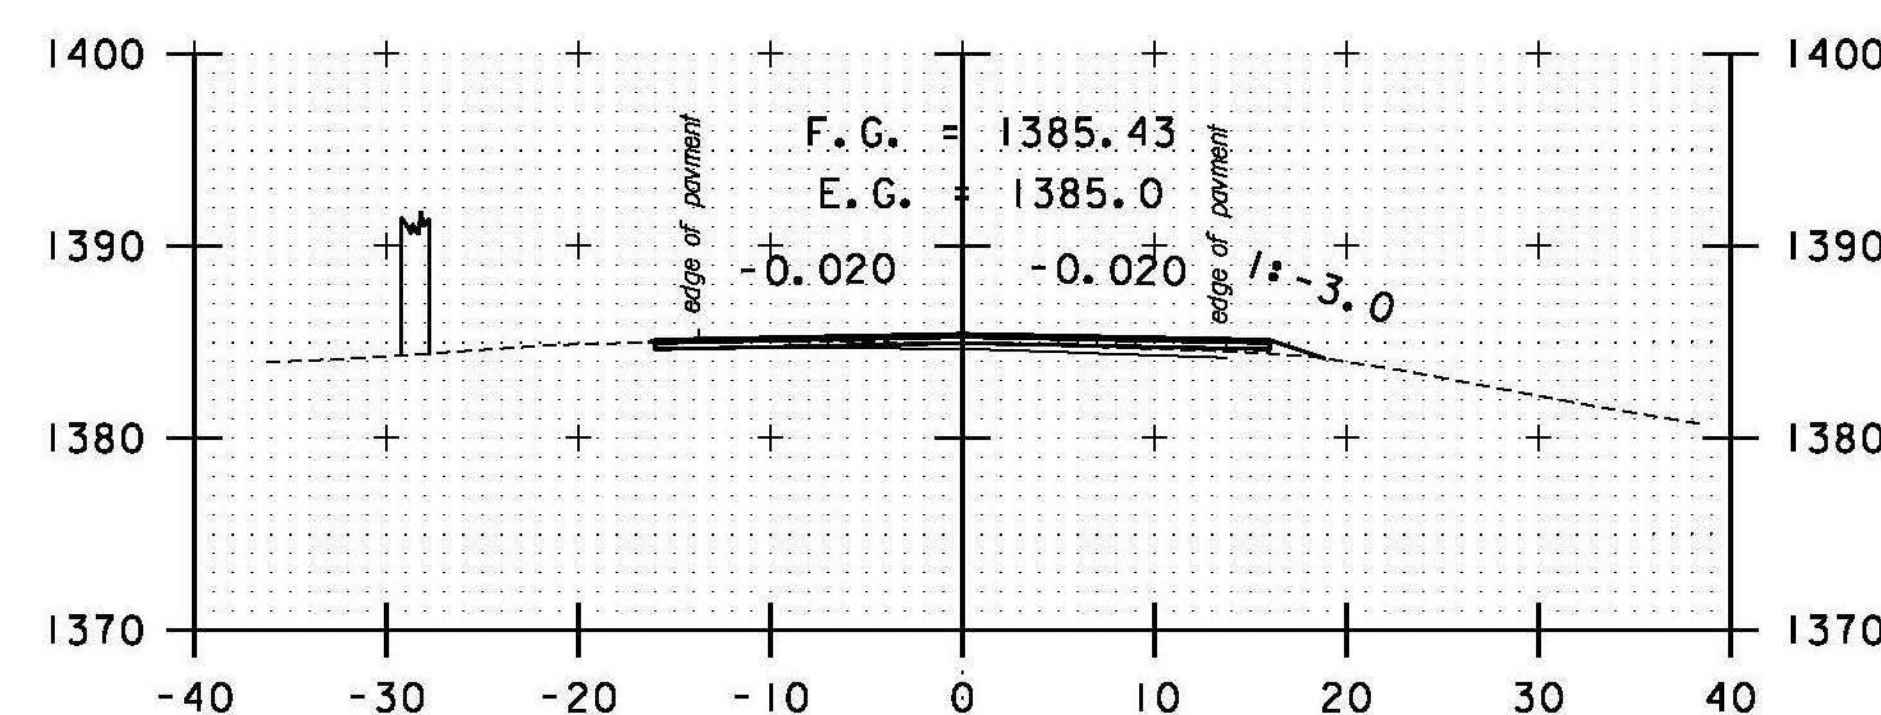


183+50

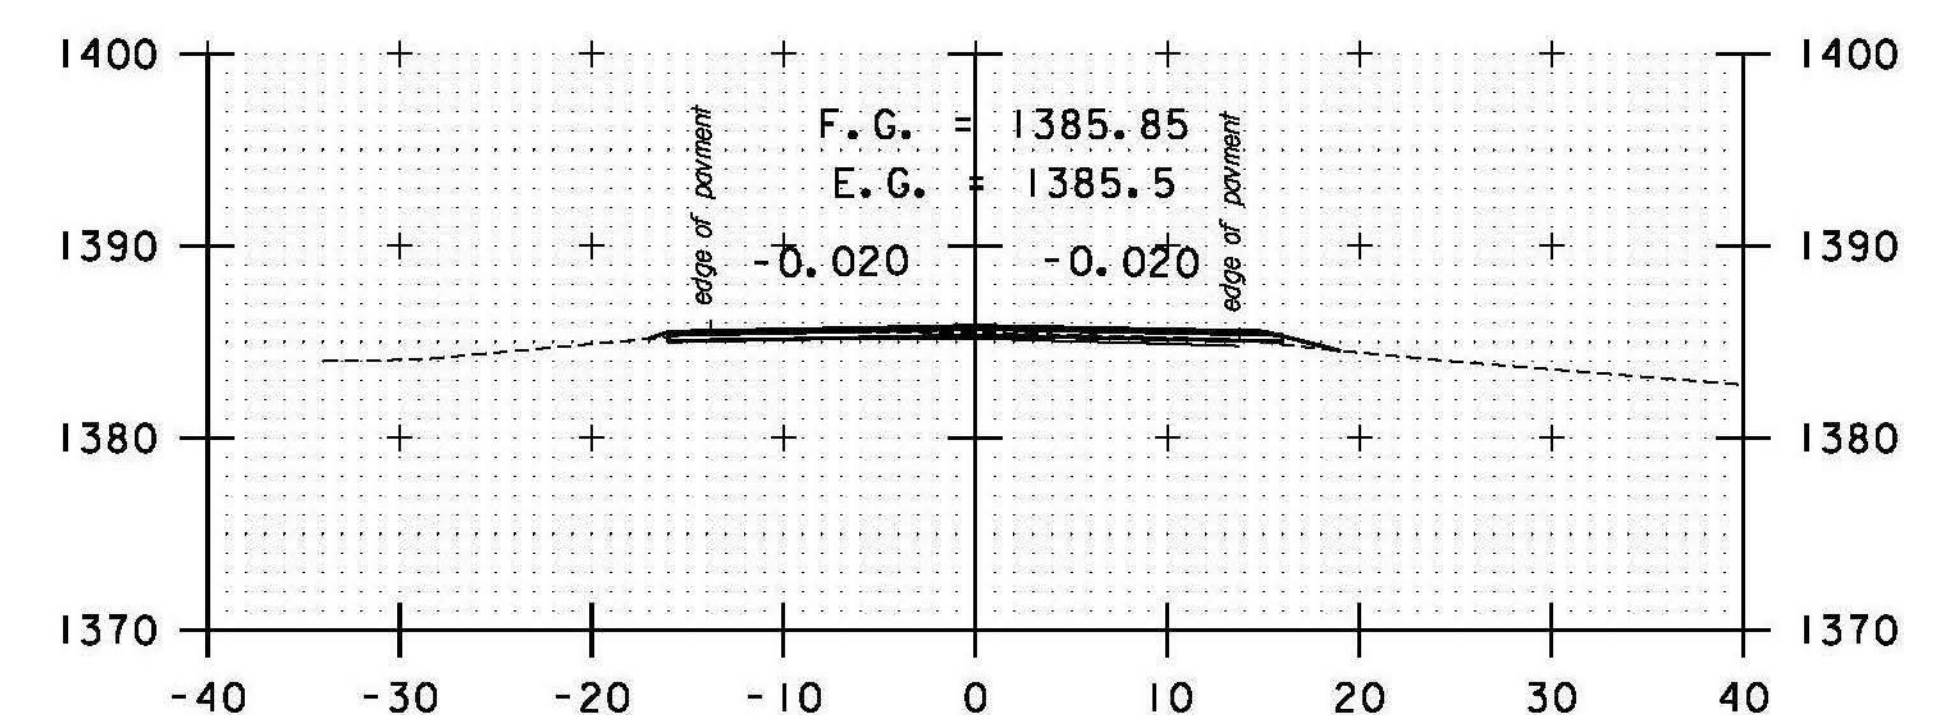

DRIVE RT
185+00

STA. 182+00 TO STA. 186+00

DATUM
VERTICAL NAVD 88
HORIZONTAL NAD 83 (07)

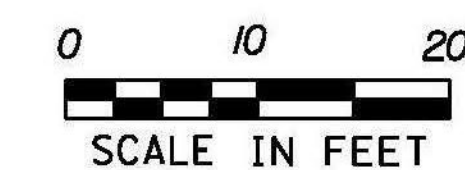

PROJECT NAME: RANDOLPH
PROJECT NUMBER: STP 2932 (1)

FILE NAME: z10c270.dgn
PROJECT LEADER: C. LATHROP
DESIGNED BY: B. BRESLEND
VT 66 CROSS SECTION SHEET 36

PLOT DATE: 6/5/2014
DRAWN BY: B. BRESLEND
CHECKED BY: C. LATHROP
SHEET 192 OF 276