




187+50

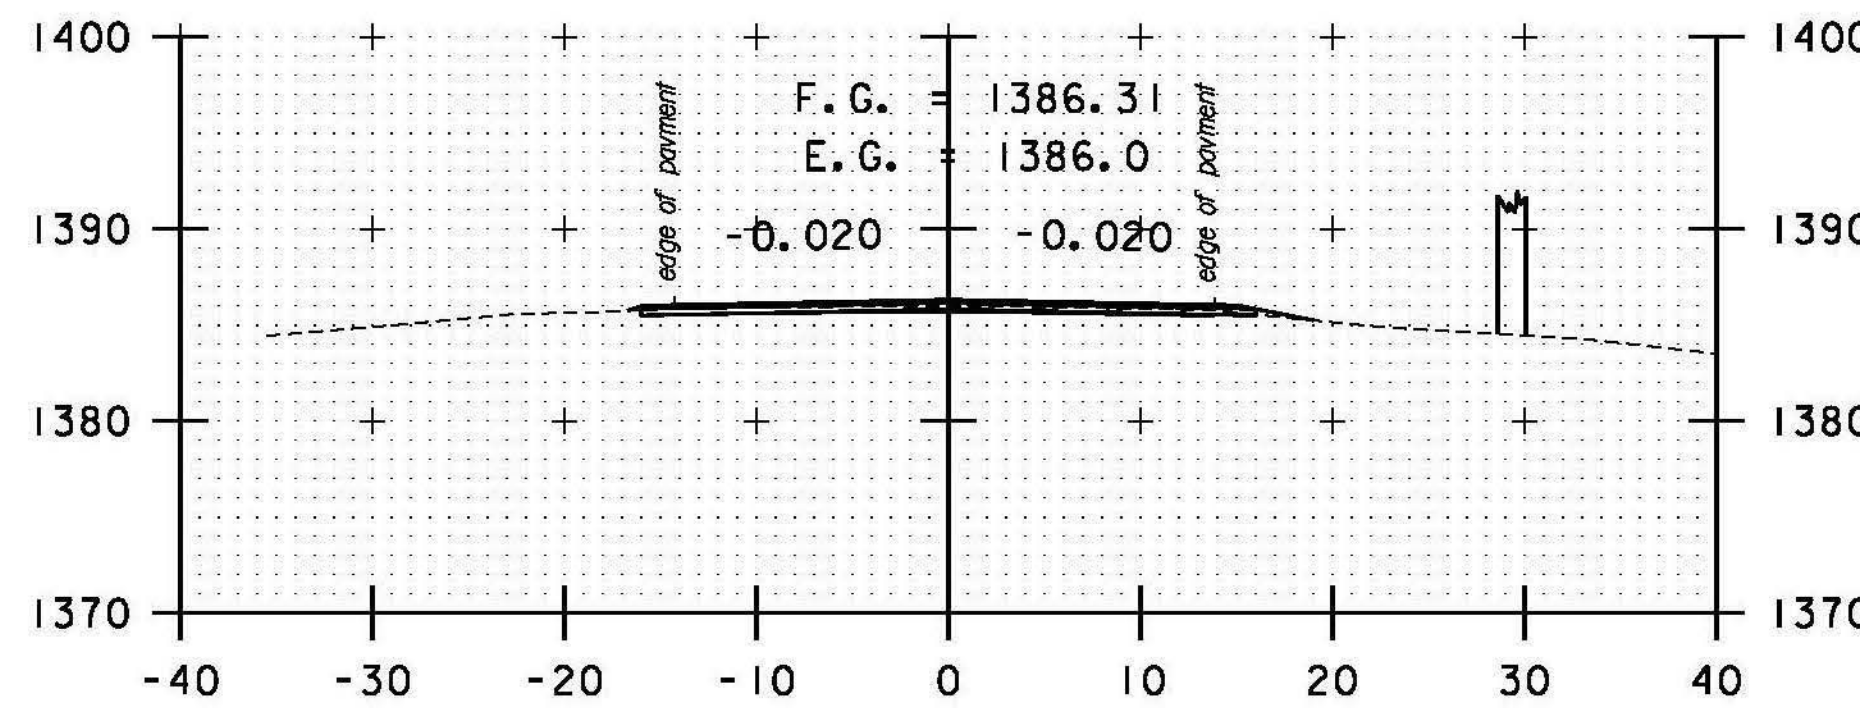


DRIVE RT
189+00

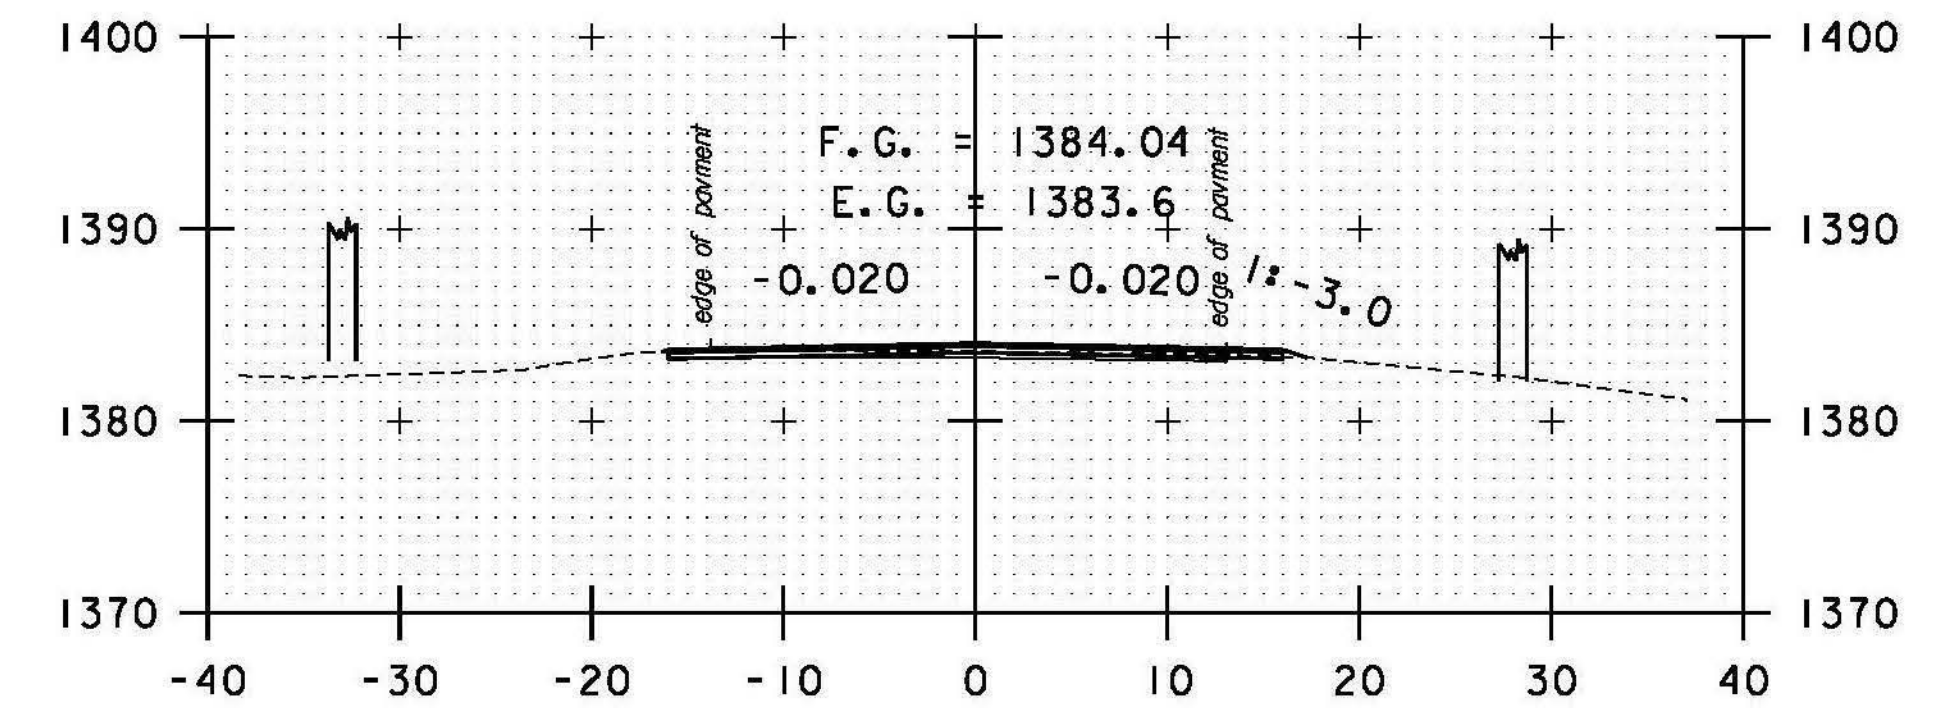


190+50

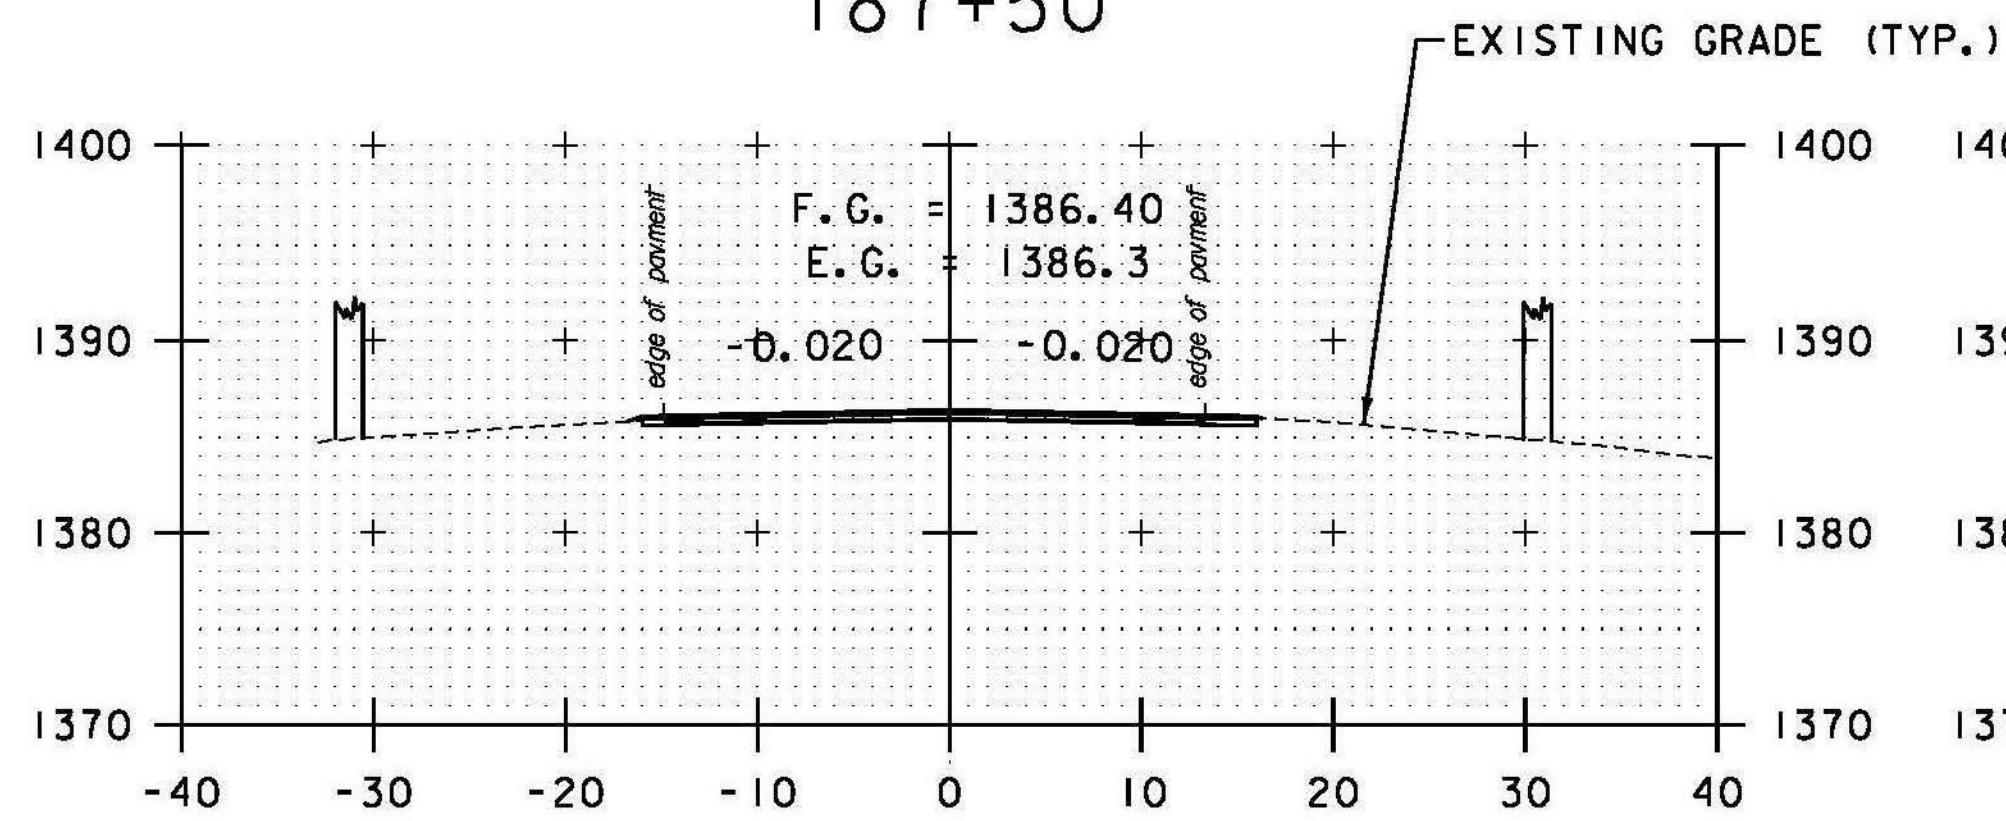


187+00

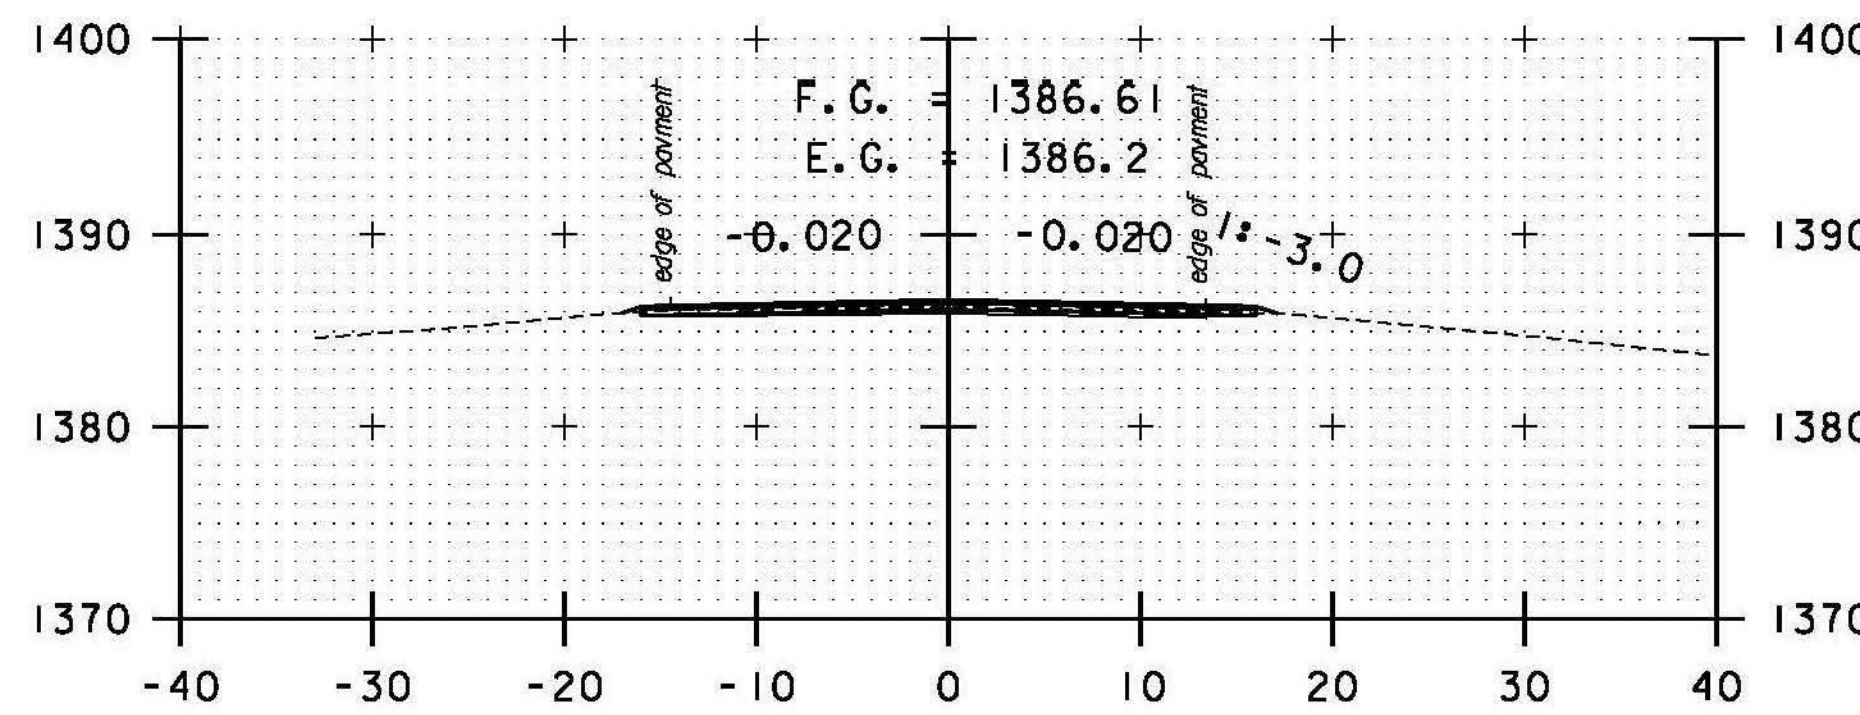


188+50

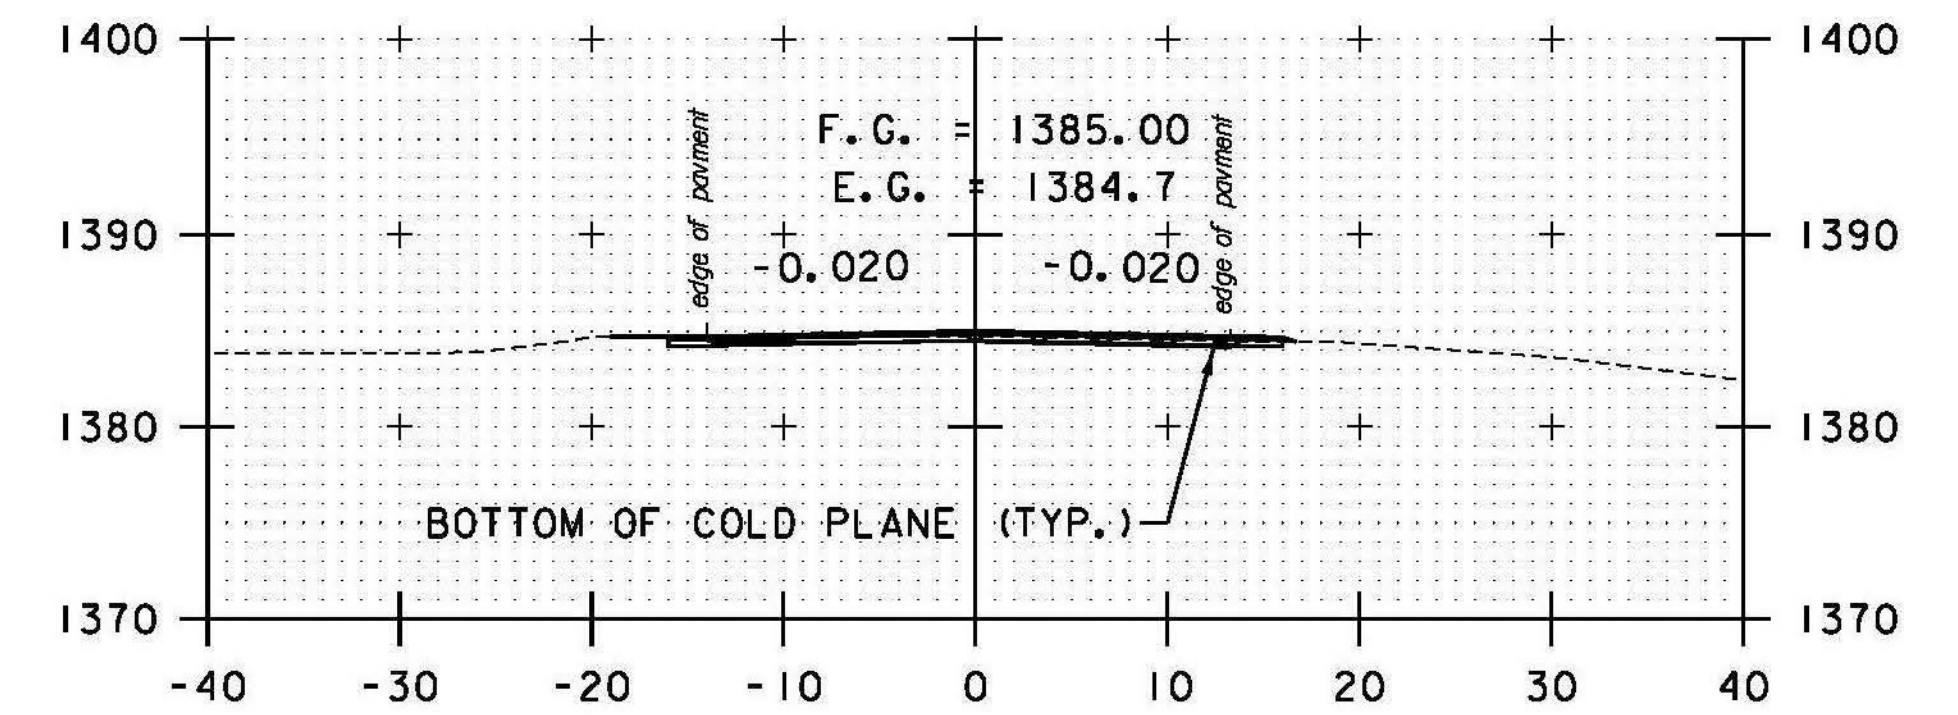


DRIVE LT
190+00

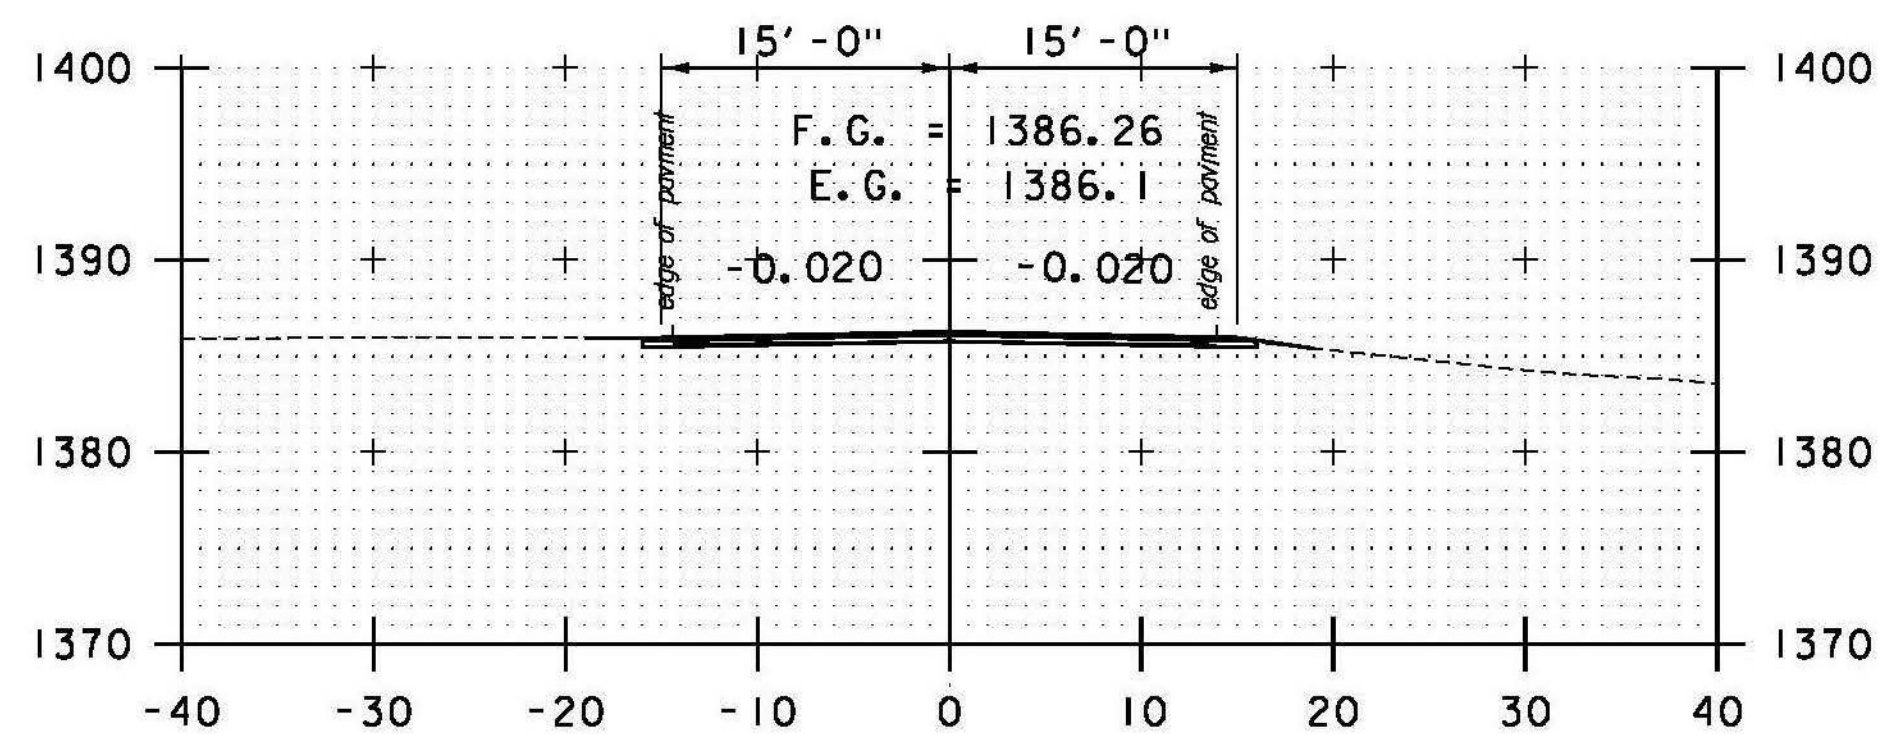

DRIVE LT / RT
186+50

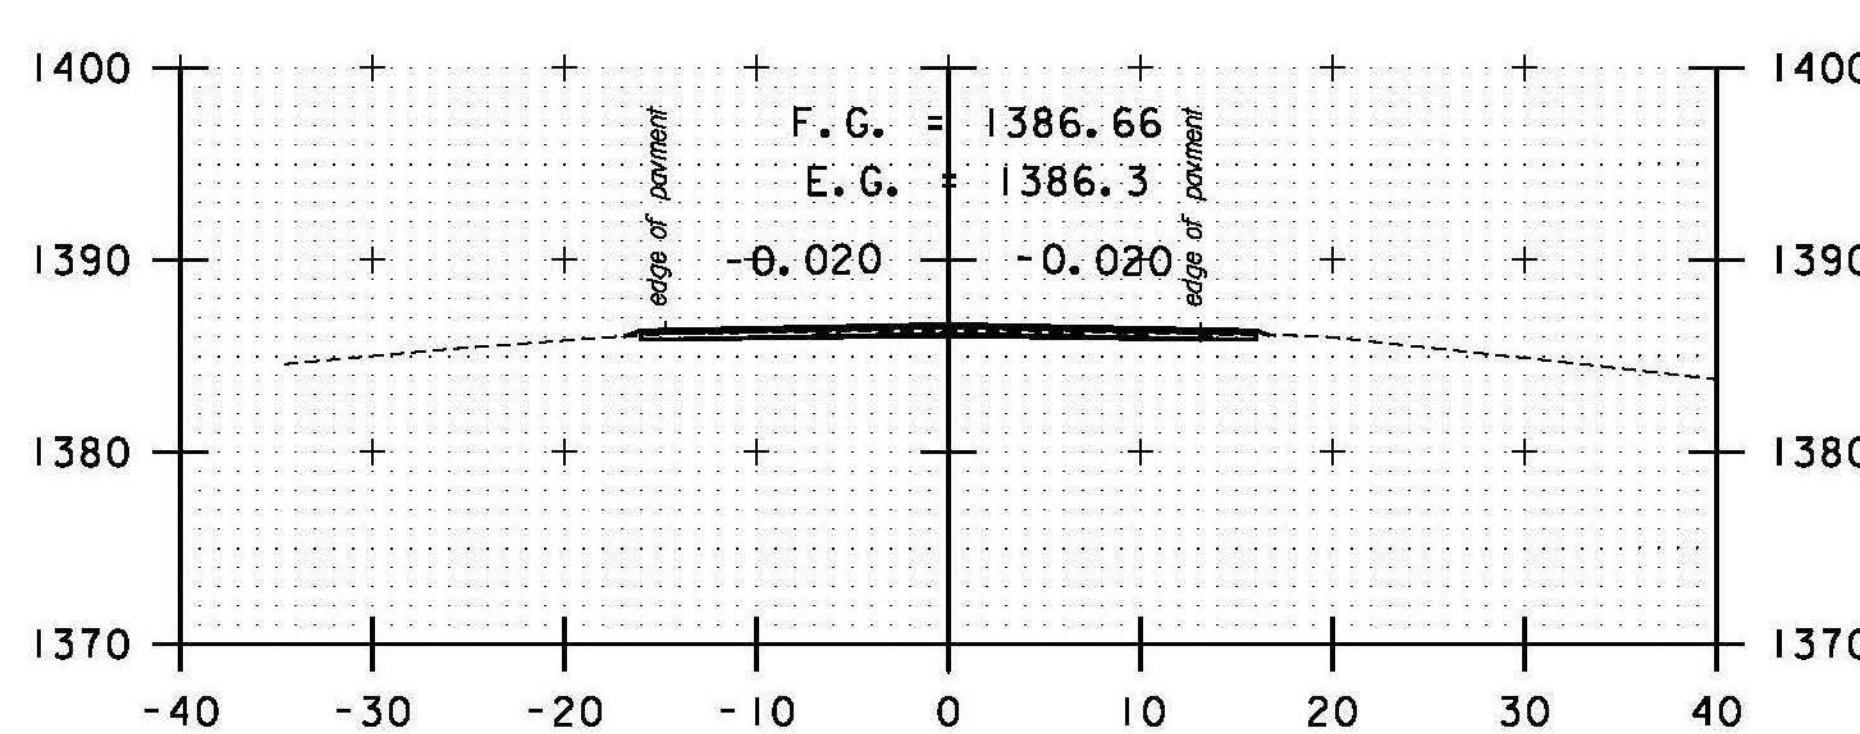


188+00

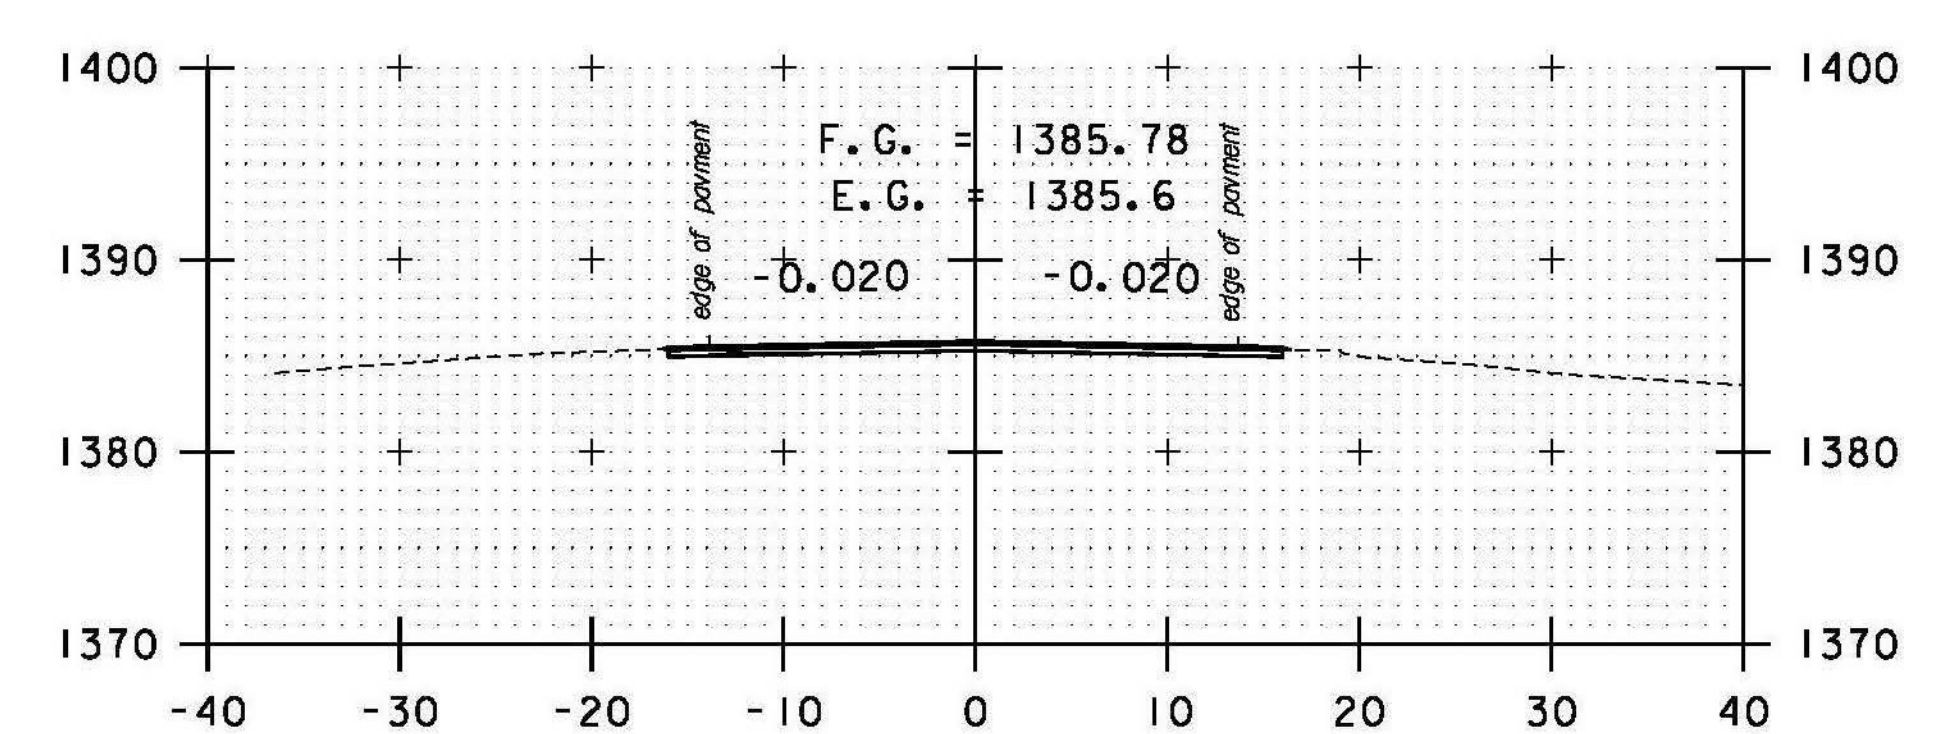

189+50

STA. 186+50 TO STA. 190+50

DATUM
VERTICAL NAVD 88
HORIZONTAL NAD 83 (07)

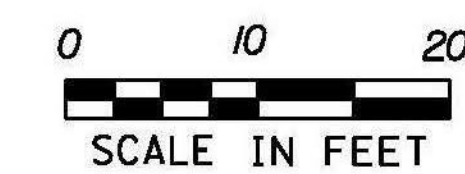

PROJECT NAME: RANDOLPH
PROJECT NUMBER: STP 2932 (1)

FILE NAME: z10c270.dgn
PROJECT LEADER: C. LATHROP
DESIGNED BY: B. BRESLEND
VT 66 CROSS SECTION SHEET 37

PLOT DATE: 6/5/2014
DRAWN BY: B. BRESLEND
CHECKED BY: C. LATHROP
SHEET 193 OF 276