


DRIVE LT

DRIVE RT

DRIVE LT

STA. 191+00 TO STA. 195+00

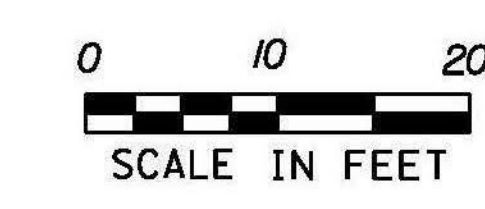

DATUM  
VERTICAL NAVD 88  
HORIZONTAL NAD 83 (07)

PROJECT NAME: RANDOLPH  
PROJECT NUMBER: STP 2932 (1)  
FILE NAME: z10c270.dgn  
PROJECT LEADER: C. LATHROP  
DESIGNED BY: B. BRESLEND  
VT 66 CROSS SECTION SHEET 38

PLOT DATE: 6/5/2014  
DRAWN BY: B. BRESLEND  
CHECKED BY: C. LATHROP  
SHEET 194 OF 276