




196+50

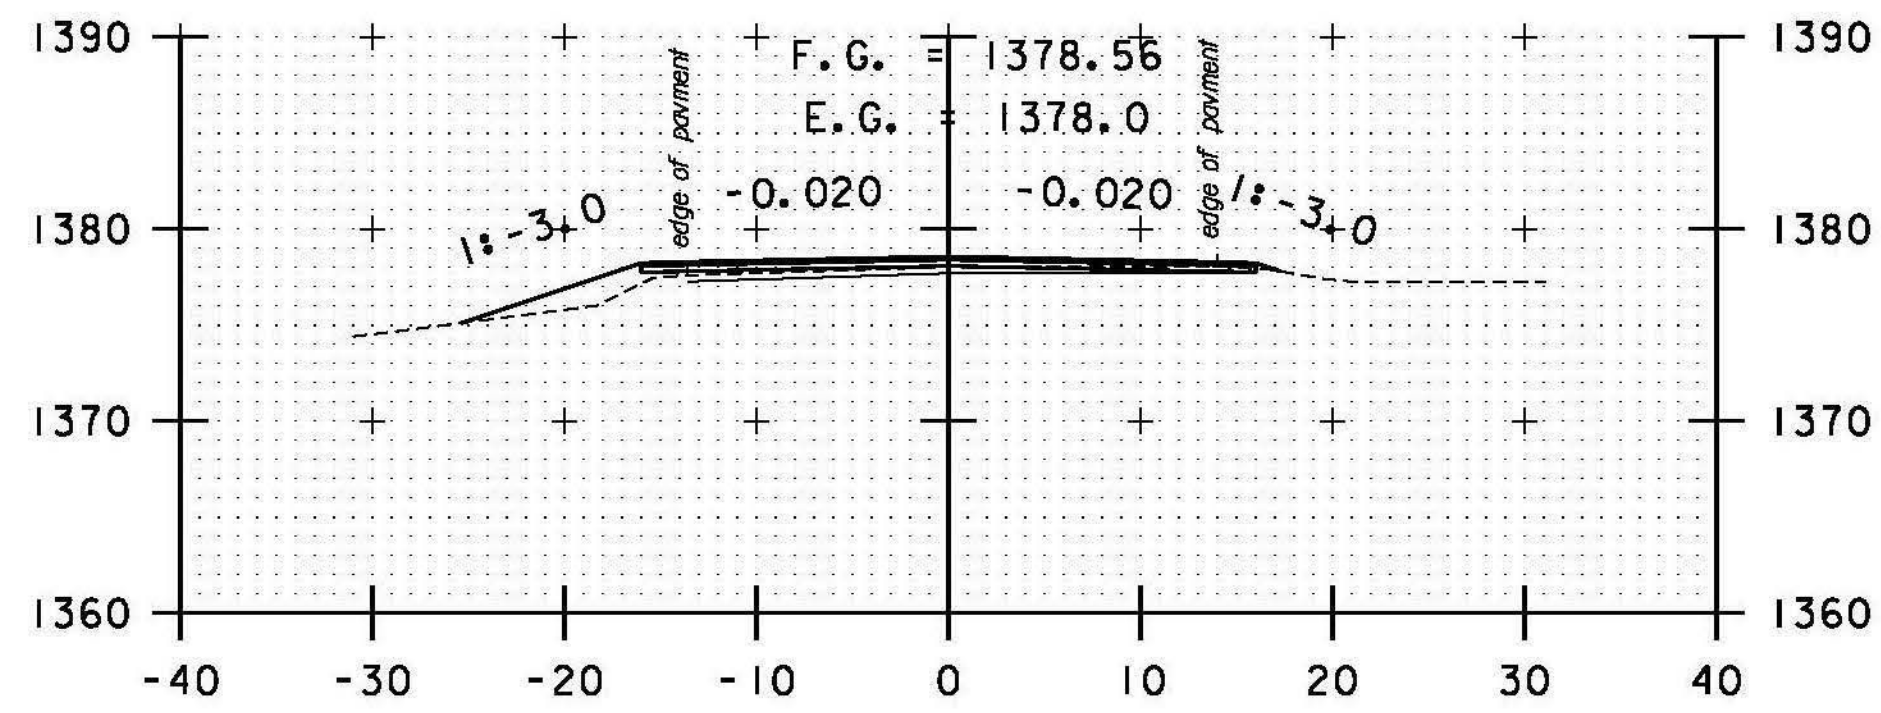


198+00

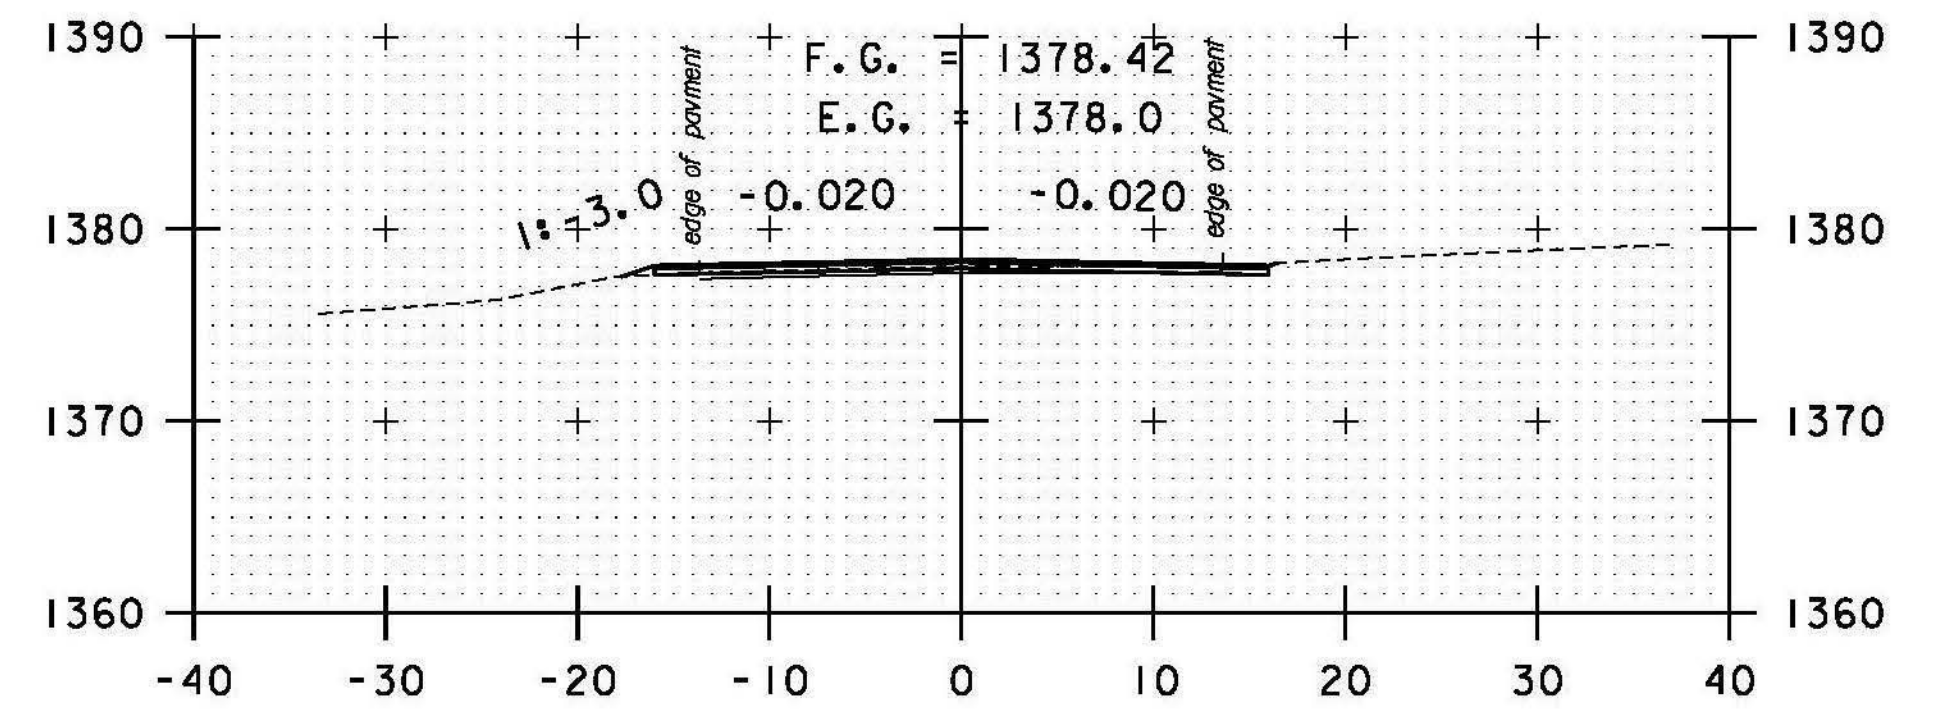


199+50

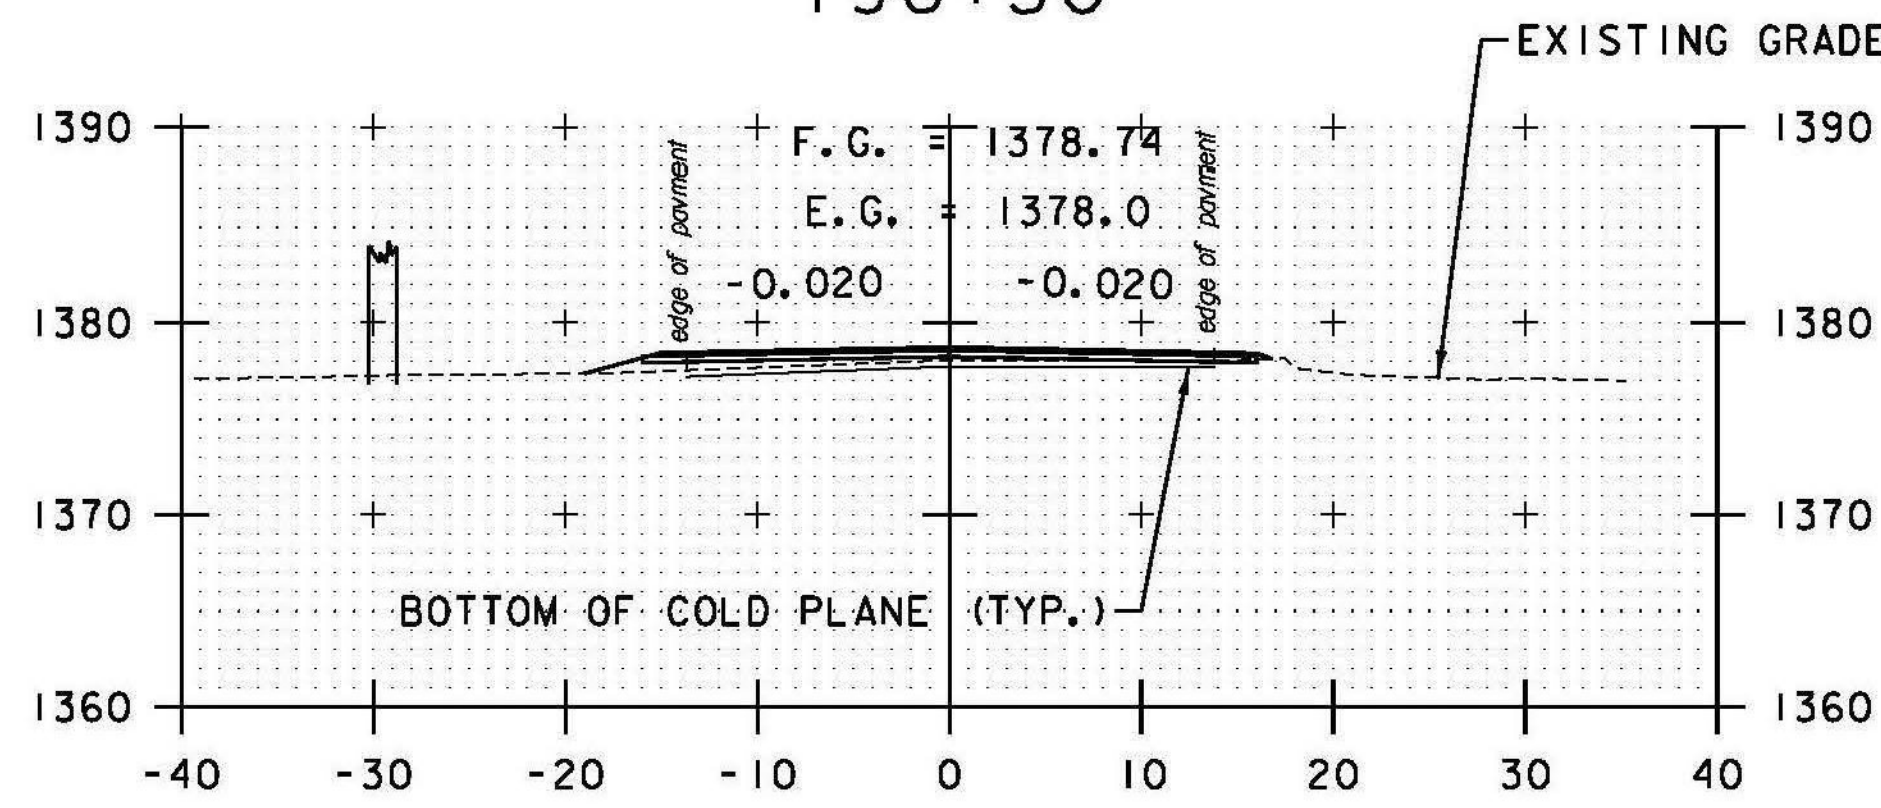


DRIVE LT
196+00

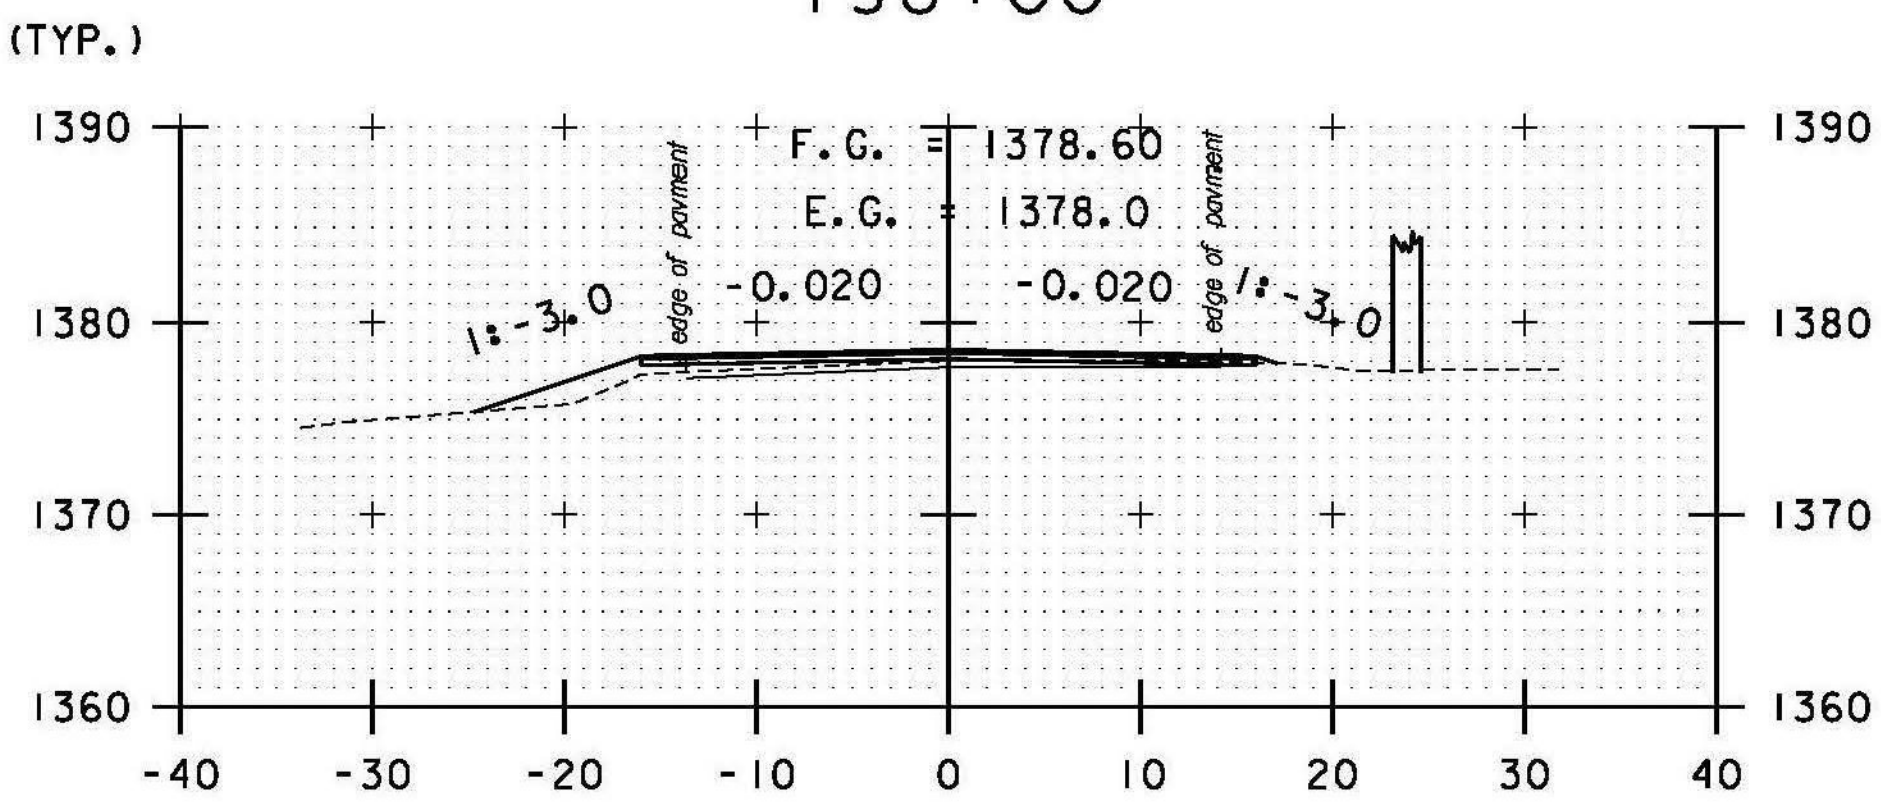


197+50

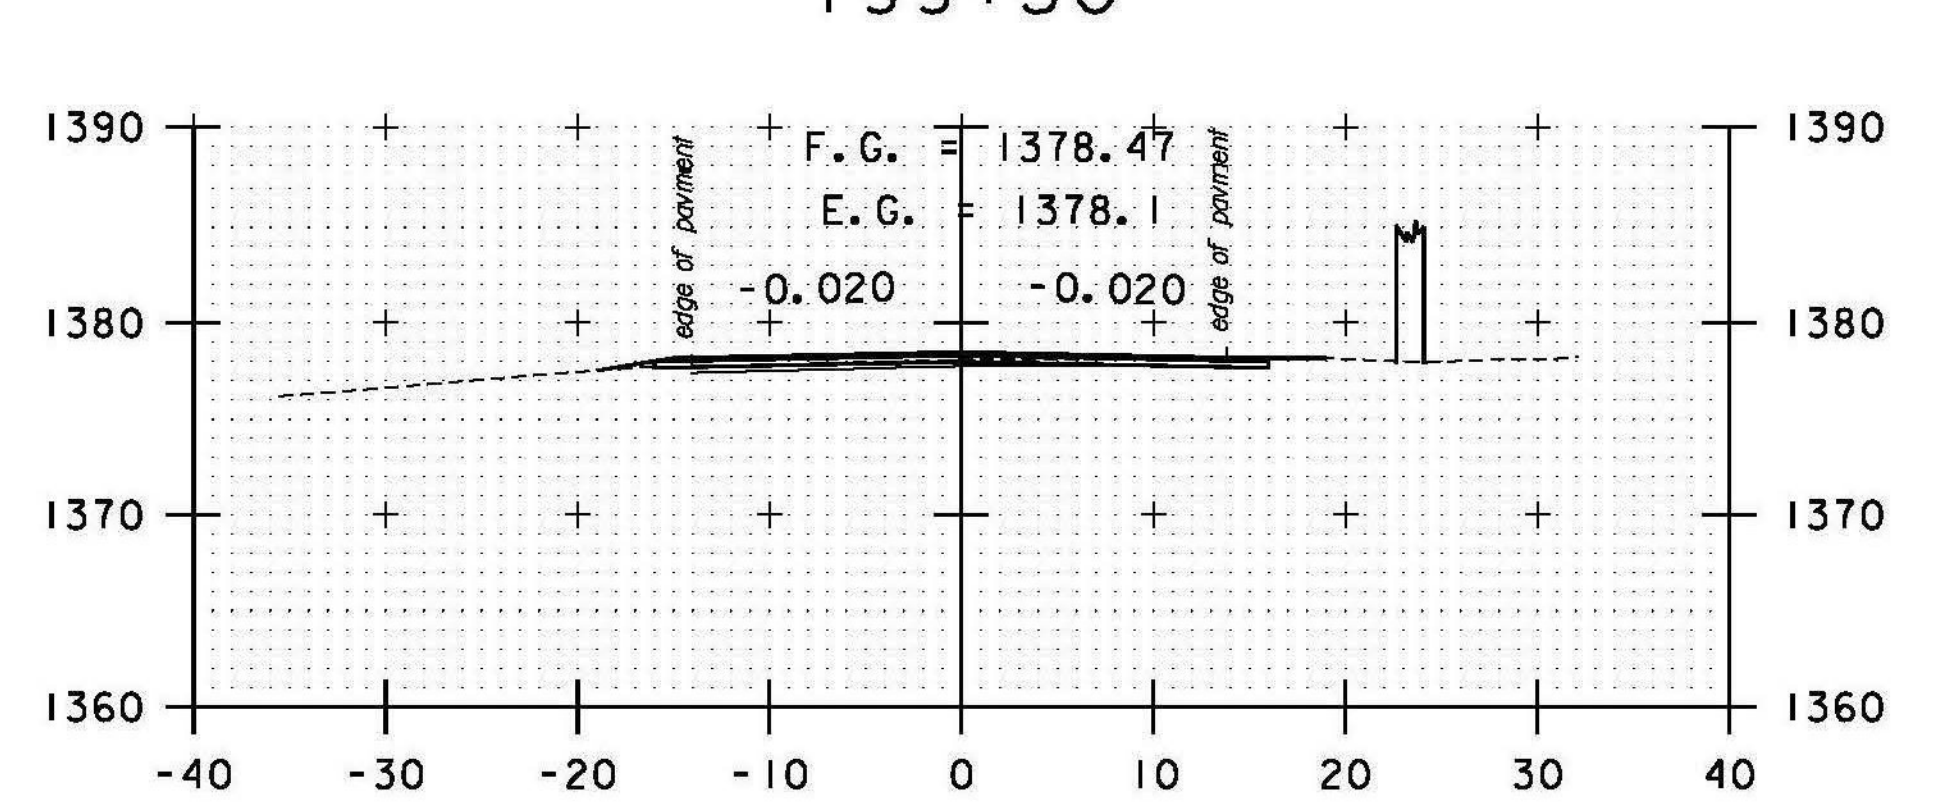


DRIVE LT / RT
199+00

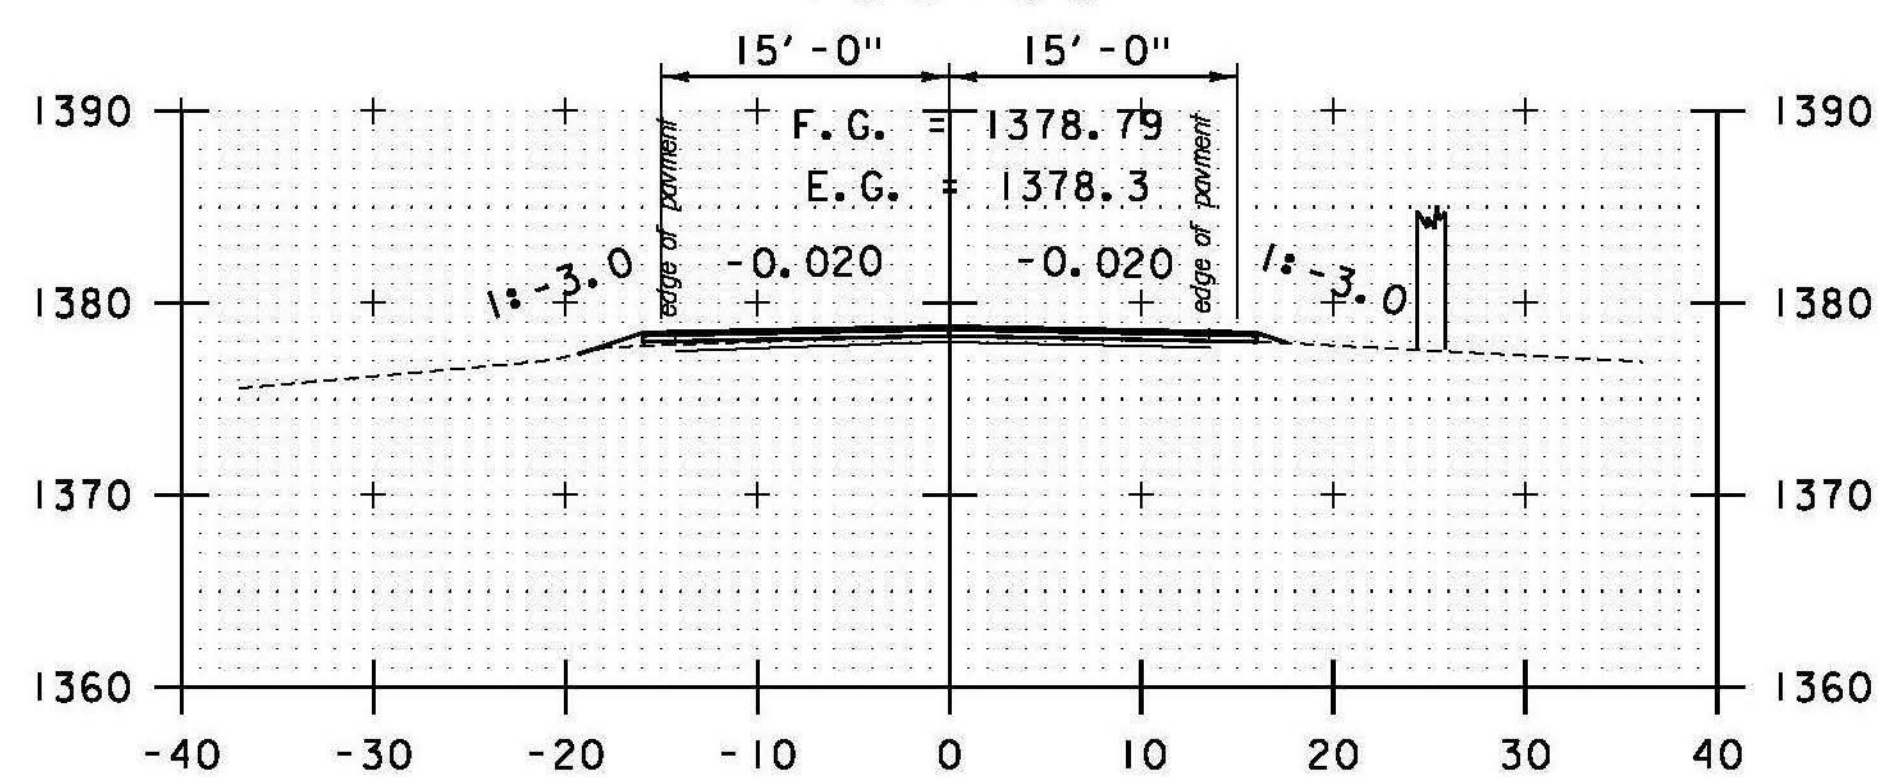

195+50

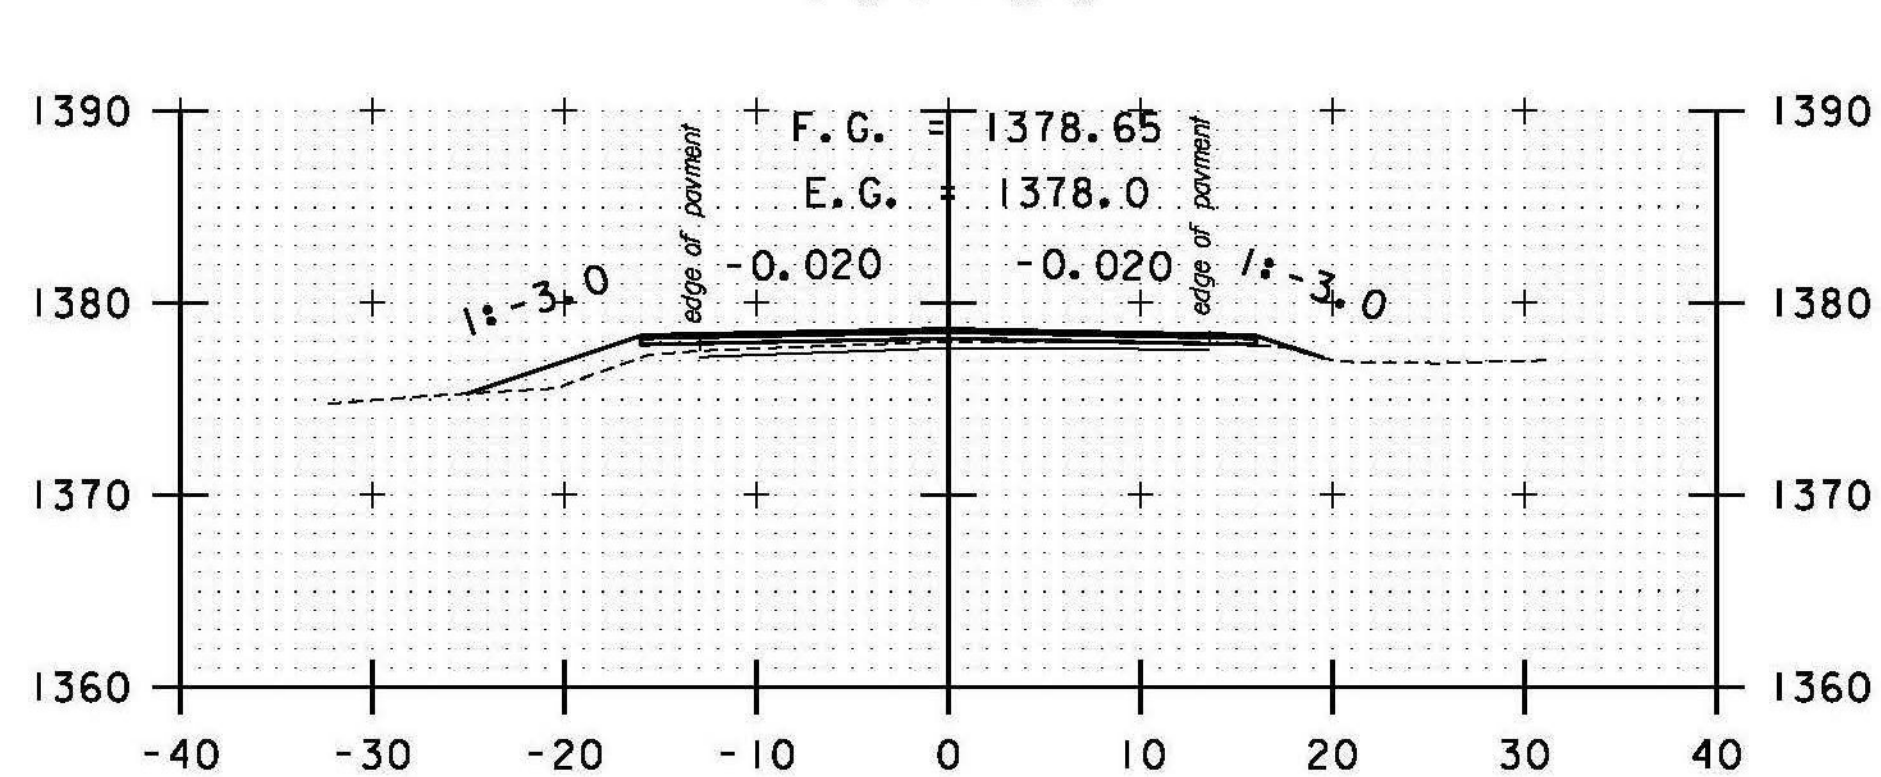


197+00

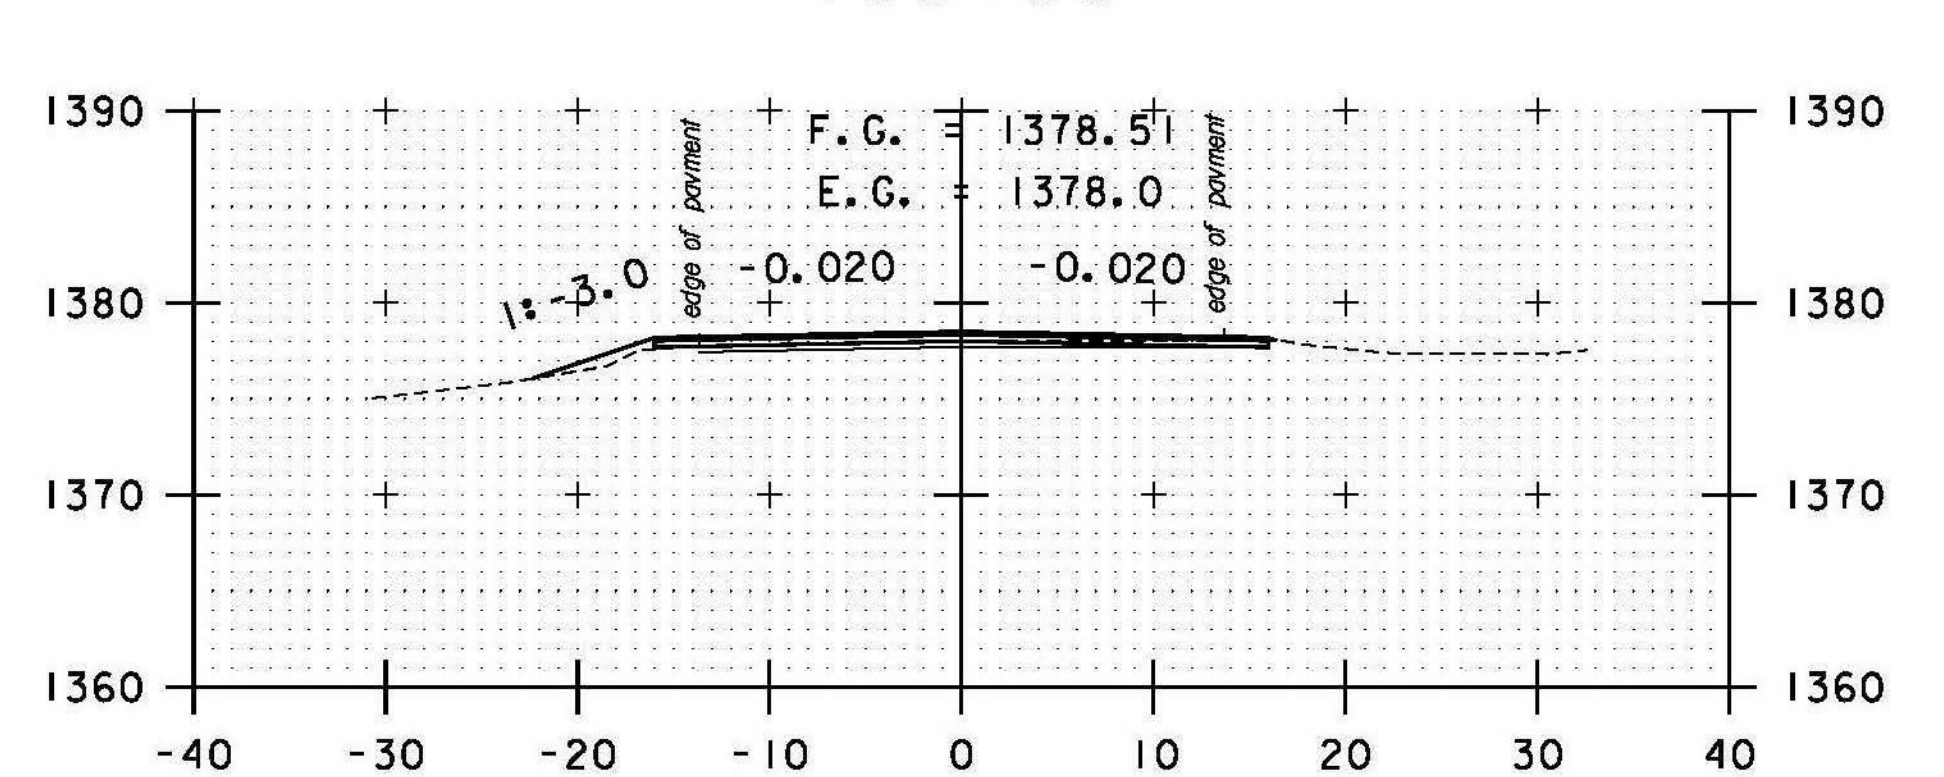

198+50

STA. 195+50 TO STA. 199+50

DATUM
VERTICAL NAVD 88
HORIZONTAL NAD 83 (07)

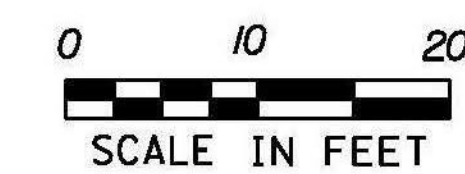

PROJECT NAME: RANDOLPH
PROJECT NUMBER: STP 2932 (1)

FILE NAME: z10c270.dgn
PROJECT LEADER: C. LATHROP
DESIGNED BY: B. BRESLEND
VT 66 CROSS SECTION SHEET 39

PLOT DATE: 6/5/2014
DRAWN BY: B. BRESLEND
CHECKED BY: C. LATHROP
SHEET 195 OF 276