




201+00

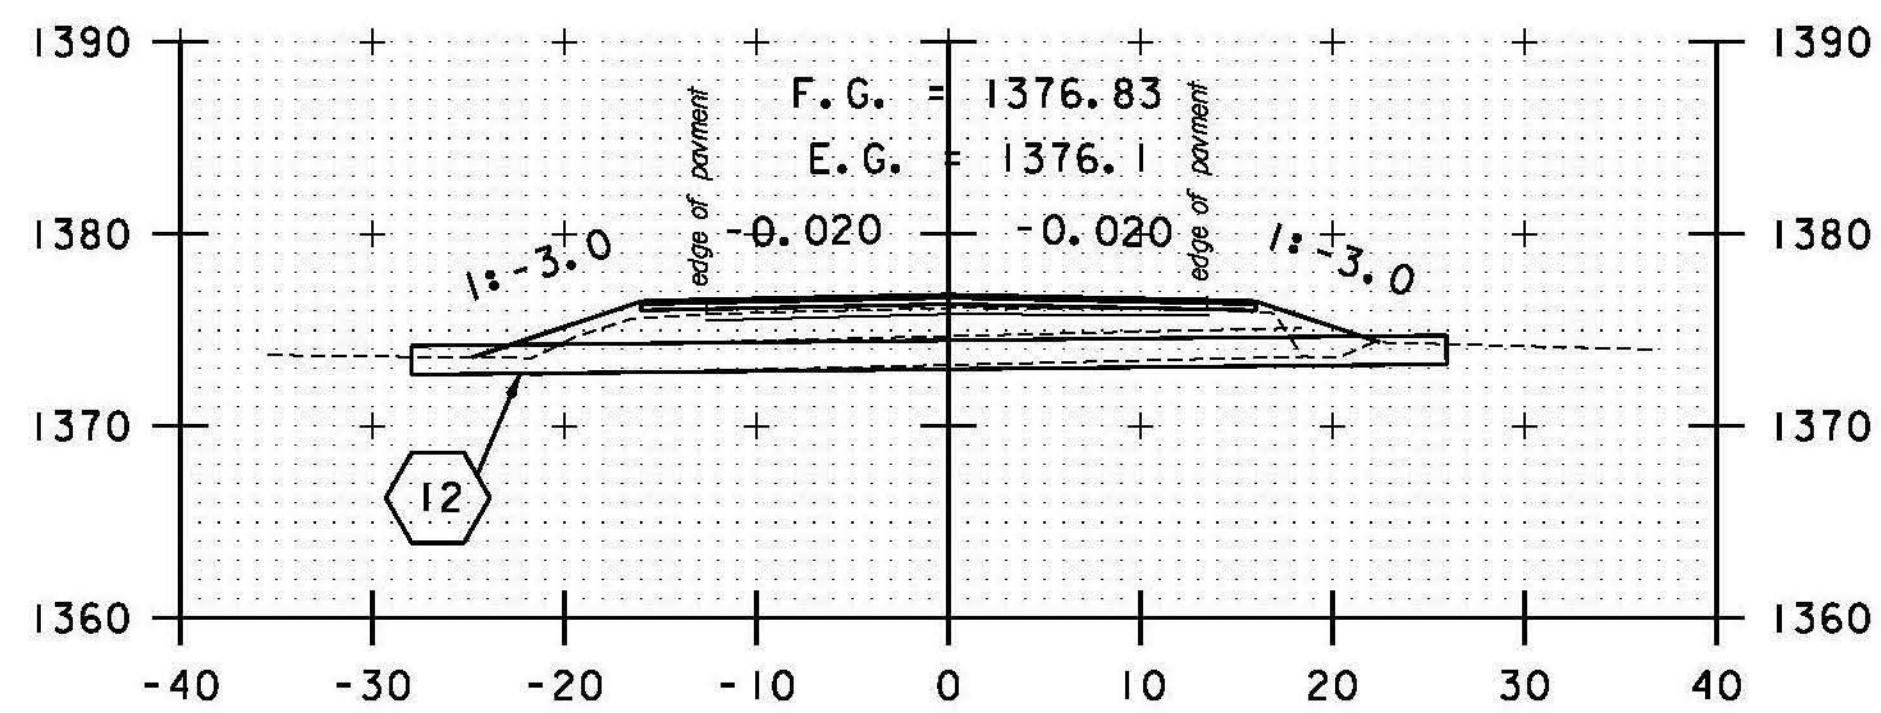


202+50

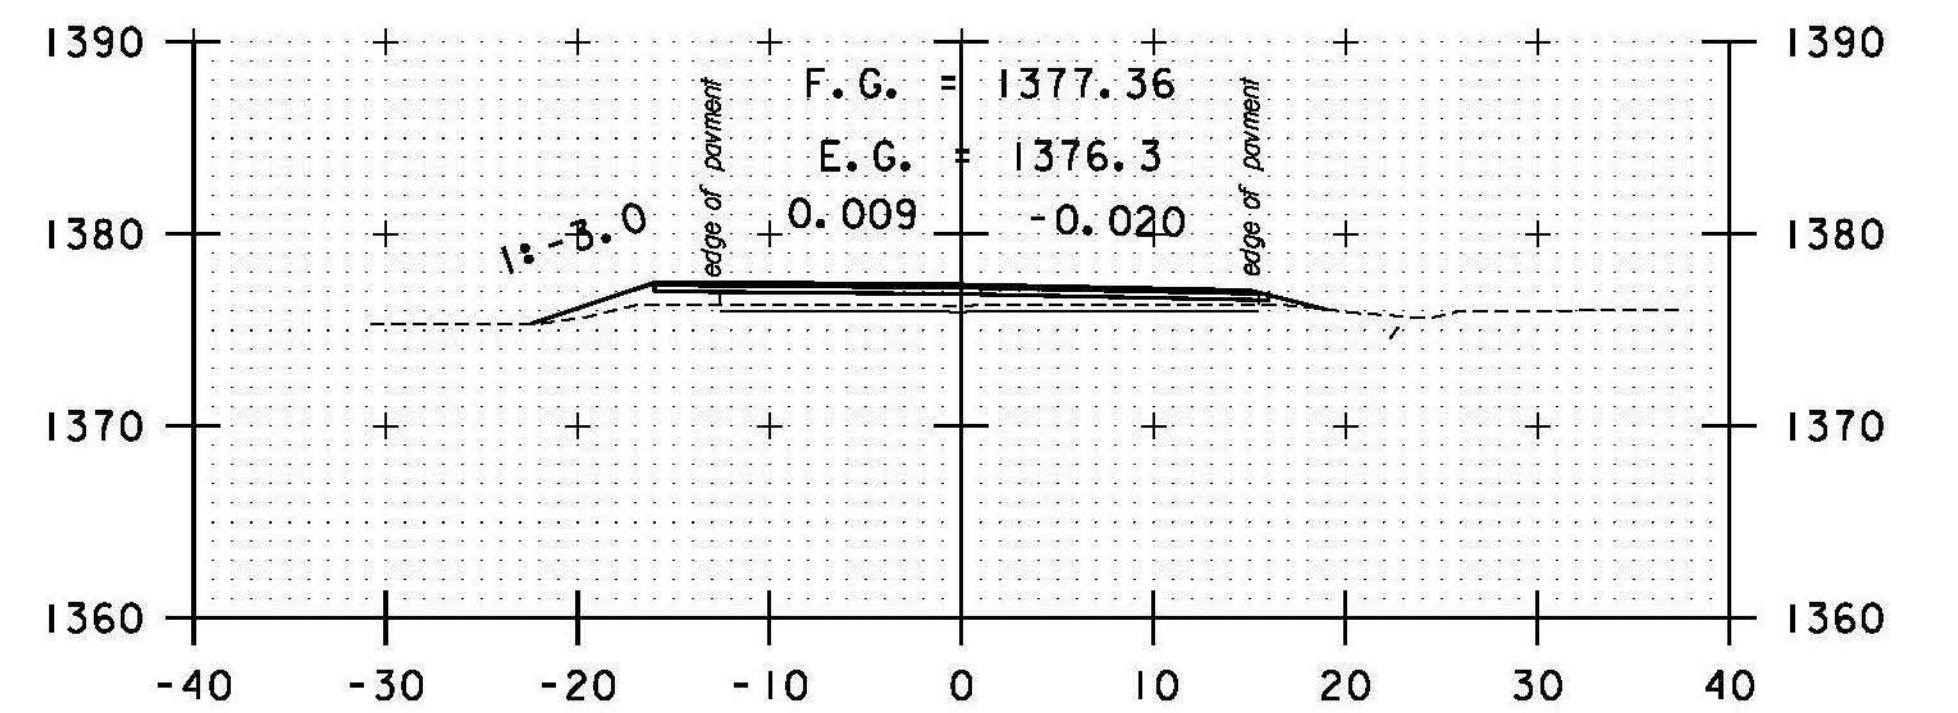


DRIVE RT
204+00

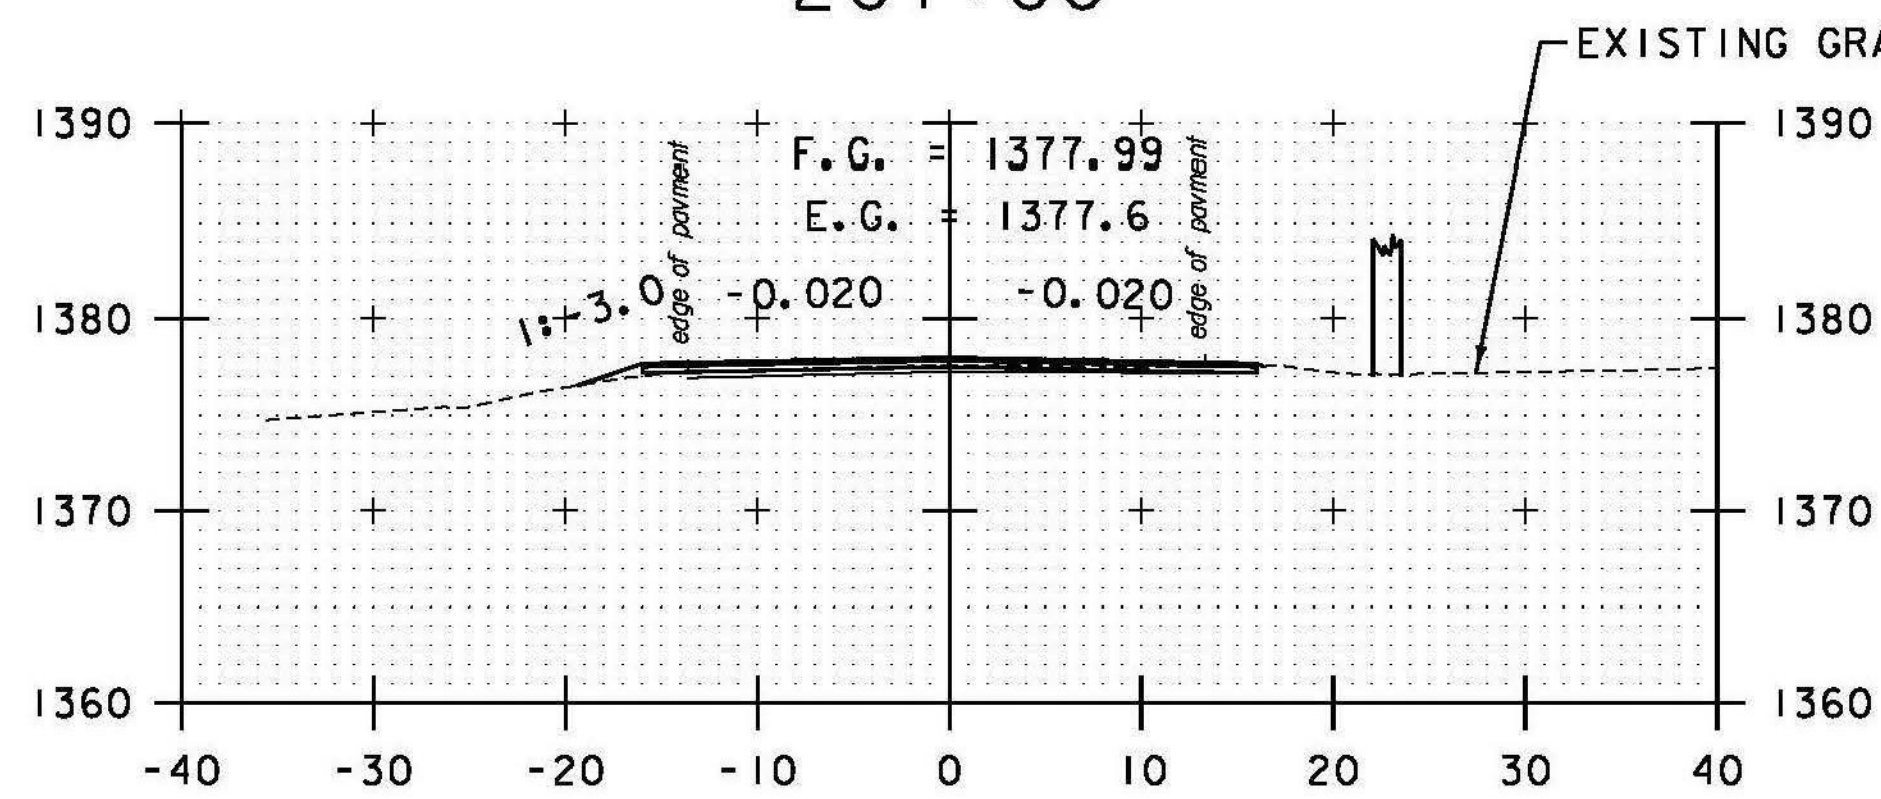


200+50

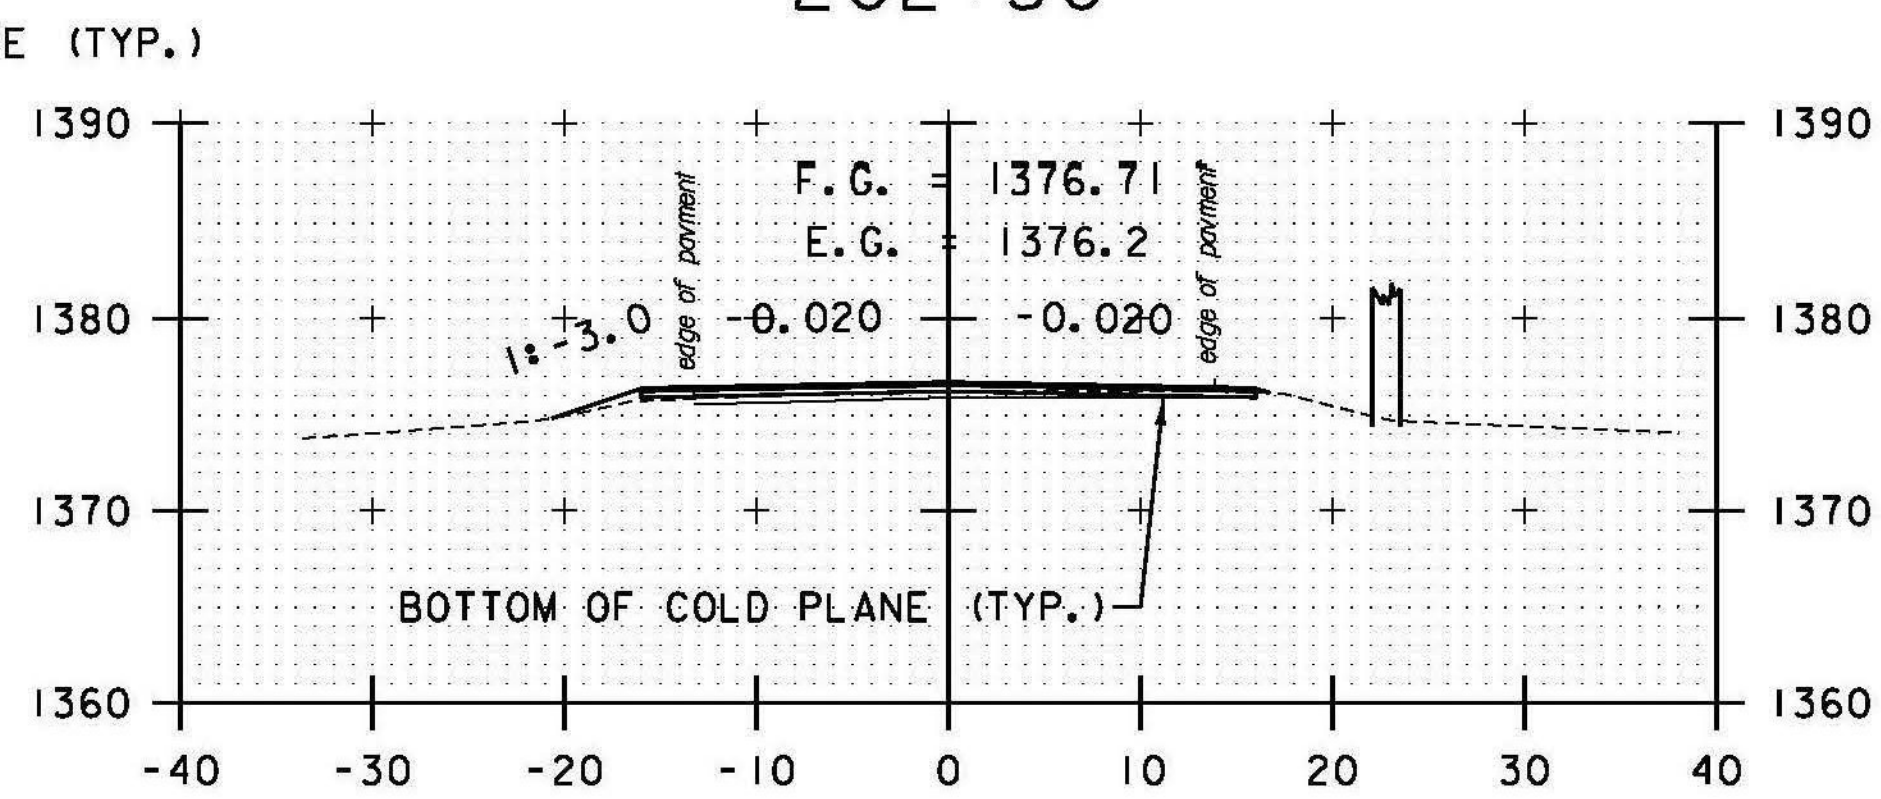


202+00

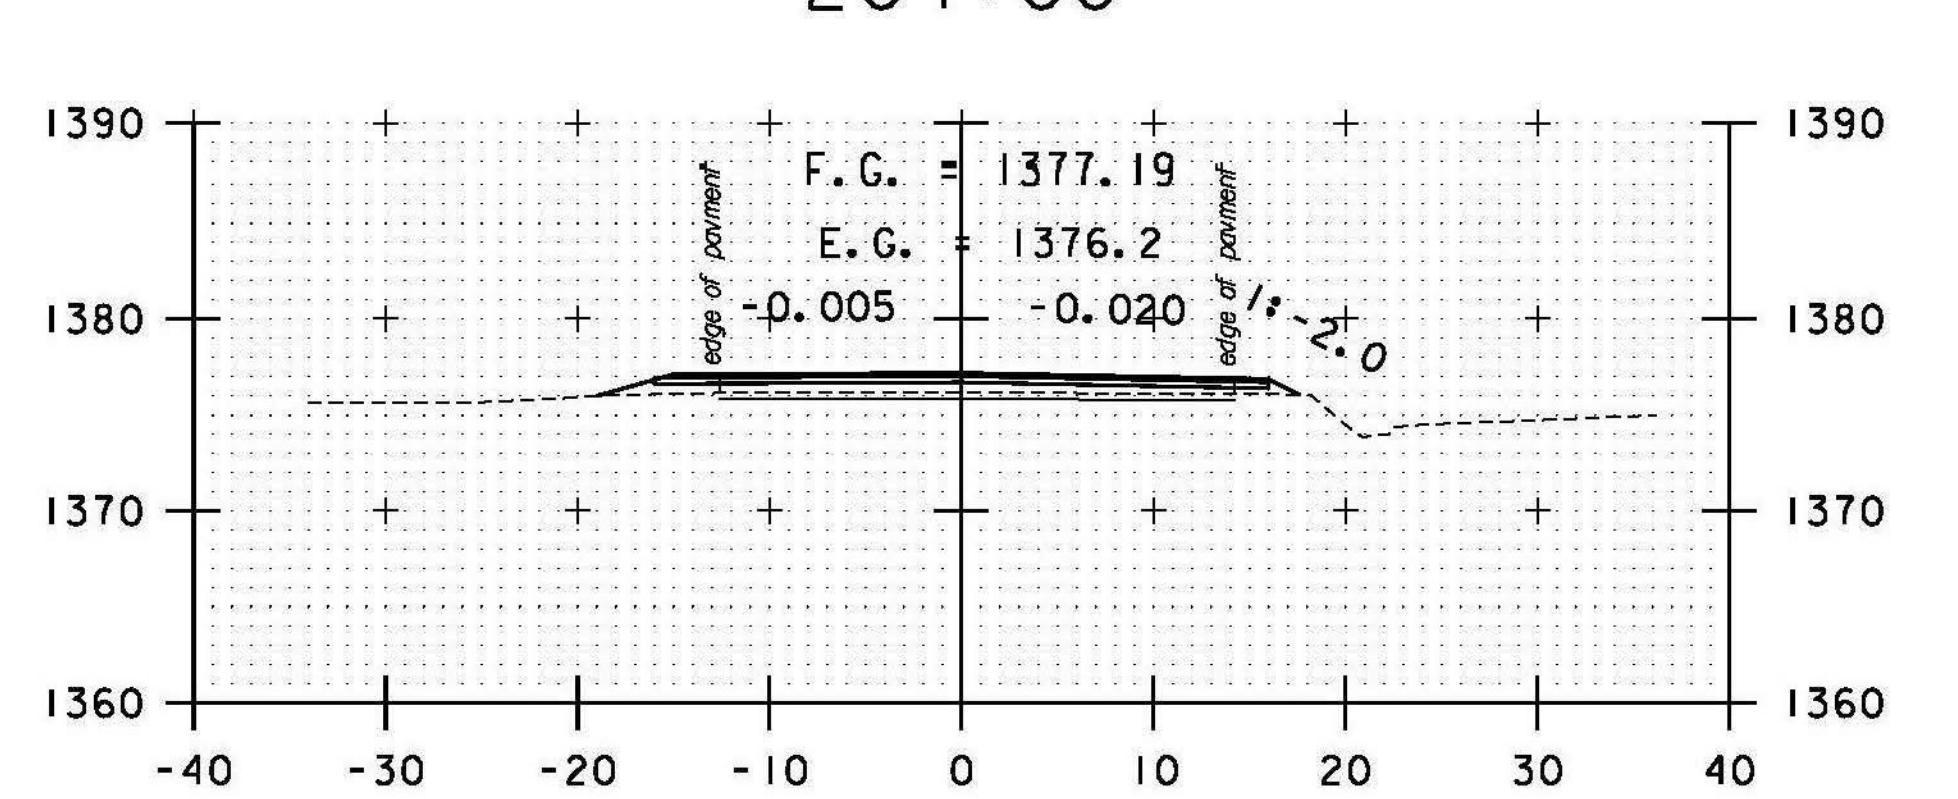


DRIVE LT
203+50

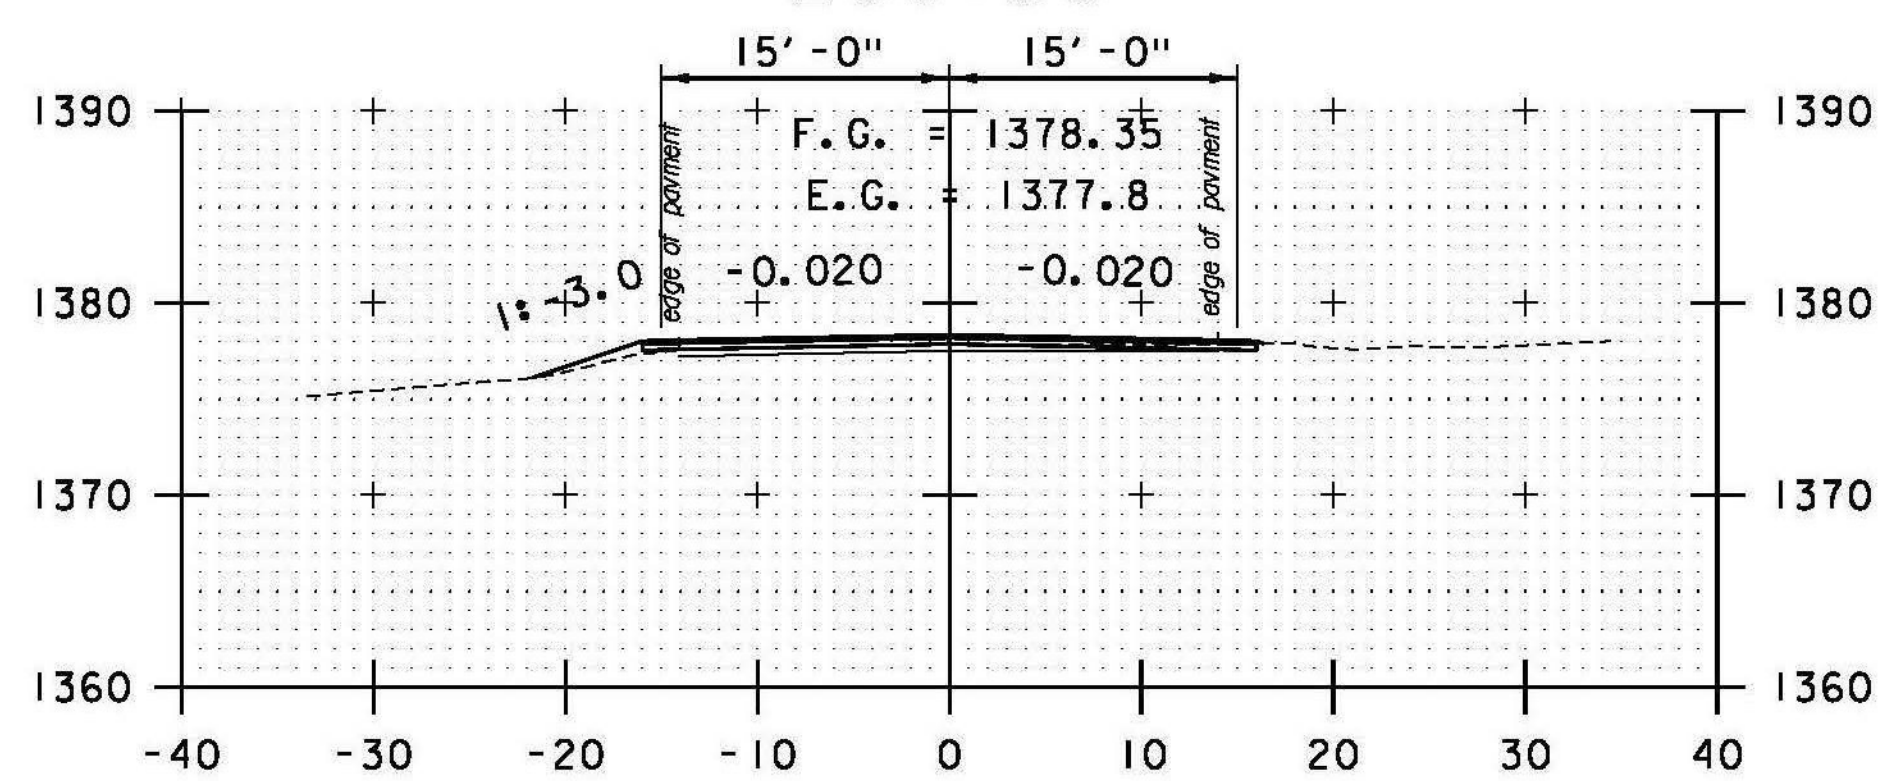

200+00

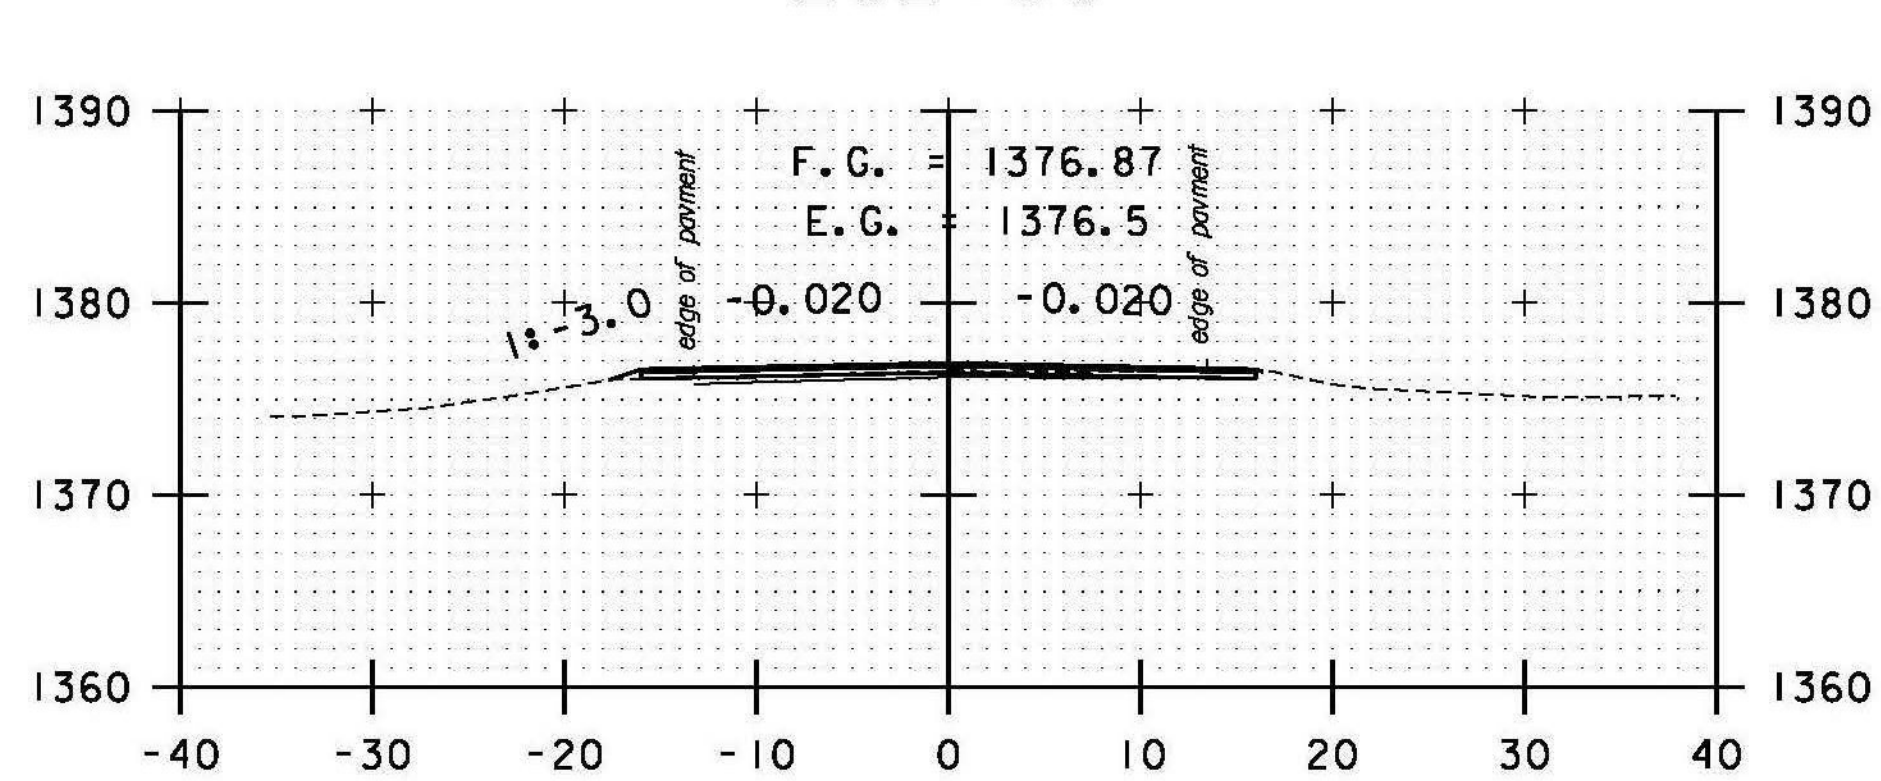

201+50

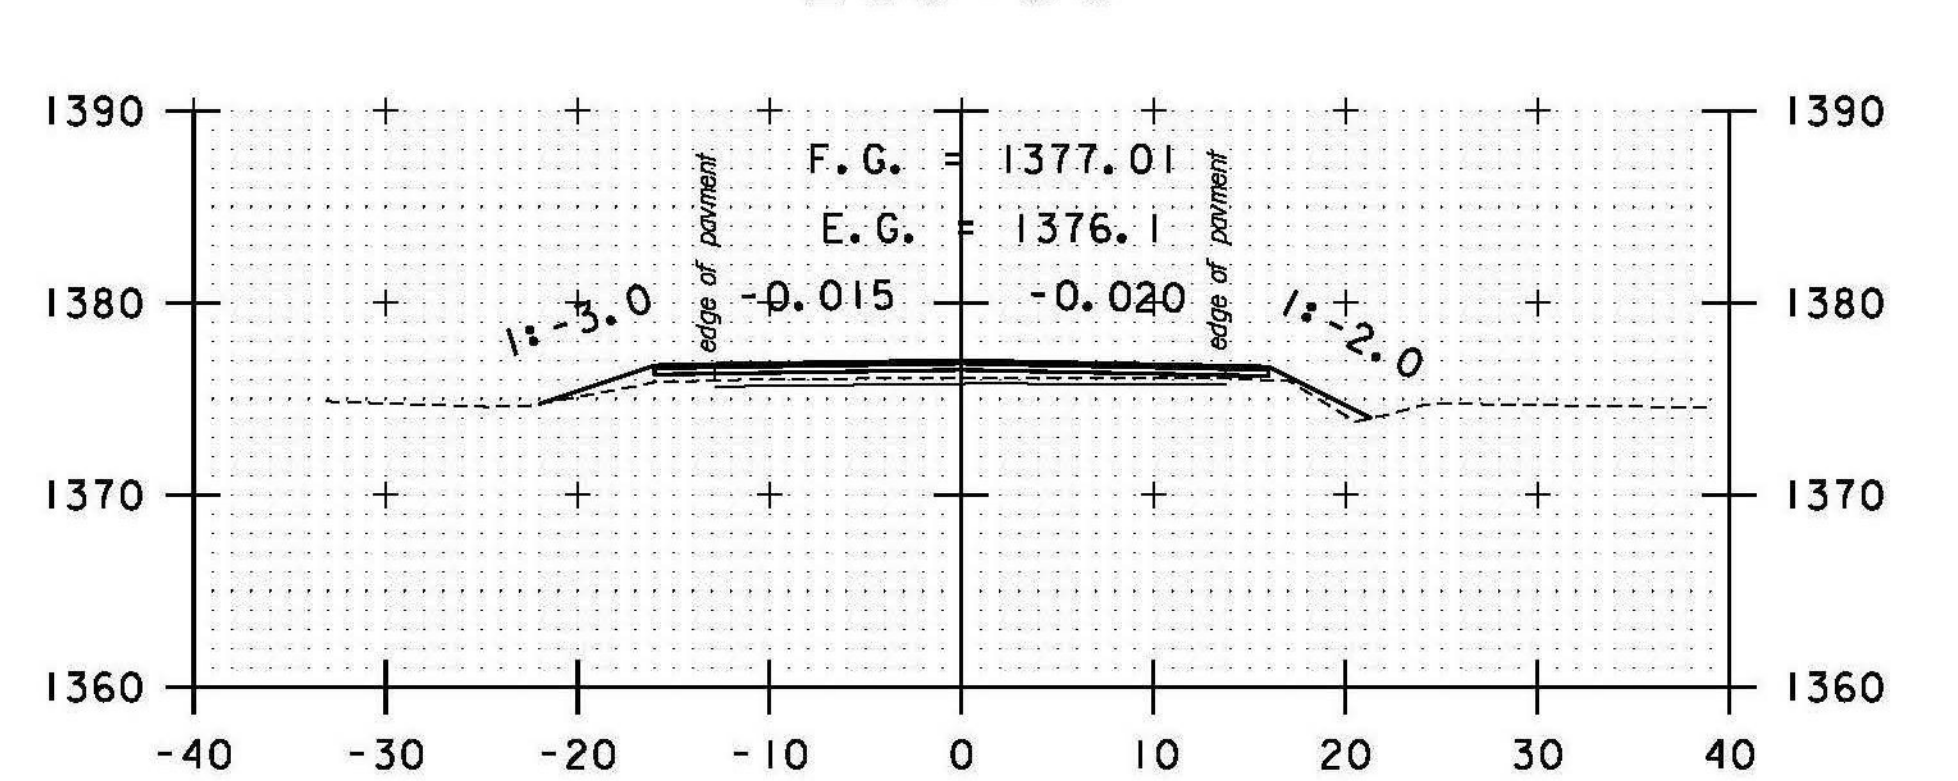


203+00

12 STA. 202+46.44 LT 27.94' TO
STA. 202+49.86 RT 25.95'
REMOVE EXISTING PIPE
INSTALL 18" CPEP (54'-0")
INV. IN = 1373.21'
INV. OUT = 1372.67'

STA. 200+00 TO STA. 204+00

DATUM
VERTICAL NAVD 88
HORIZONTAL NAD 83 (07)

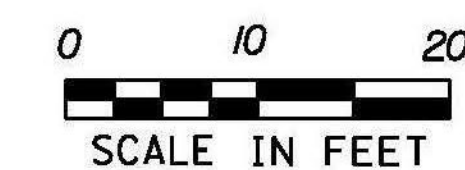

PROJECT NAME: RANDOLPH
PROJECT NUMBER: STP 2932 (1)

FILE NAME: z10c270.dgn
PROJECT LEADER: C. LATHROP
DESIGNED BY: B. BRESLEND
VT 66 CROSS SECTION SHEET 40
PLOT DATE: 6/5/2014
DRAWN BY: B. BRESLEND
CHECKED BY: C. LATHROP
SHEET 196 OF 276