




212+50

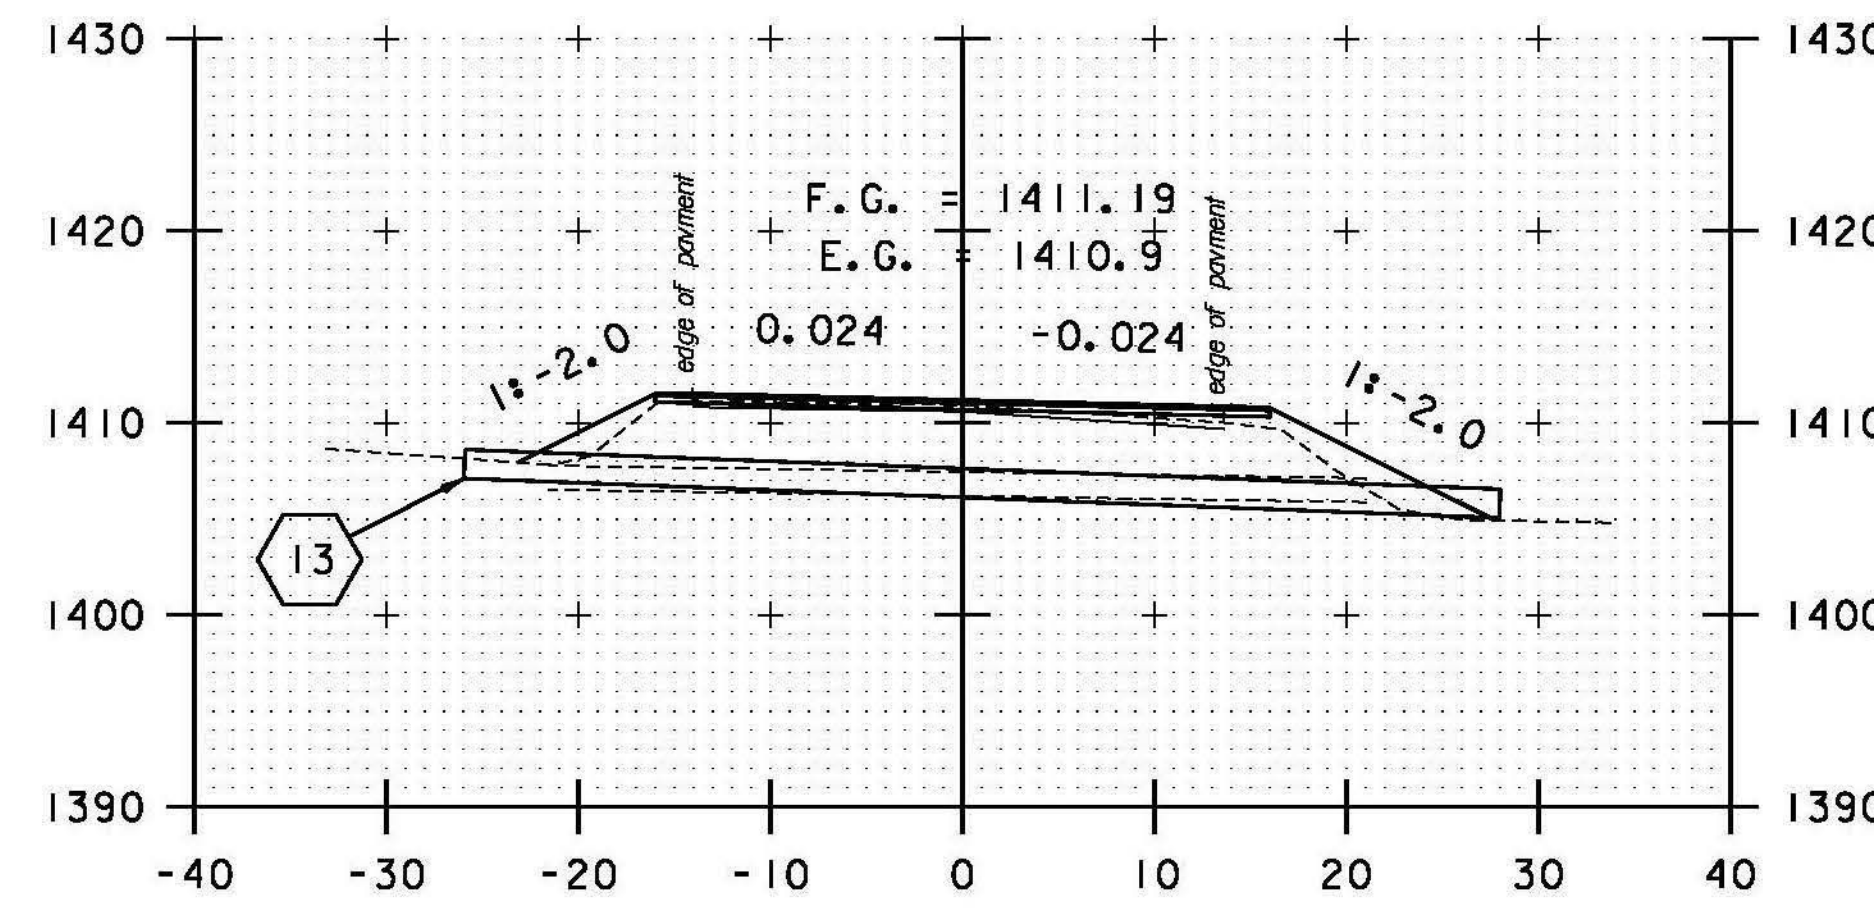


214+00

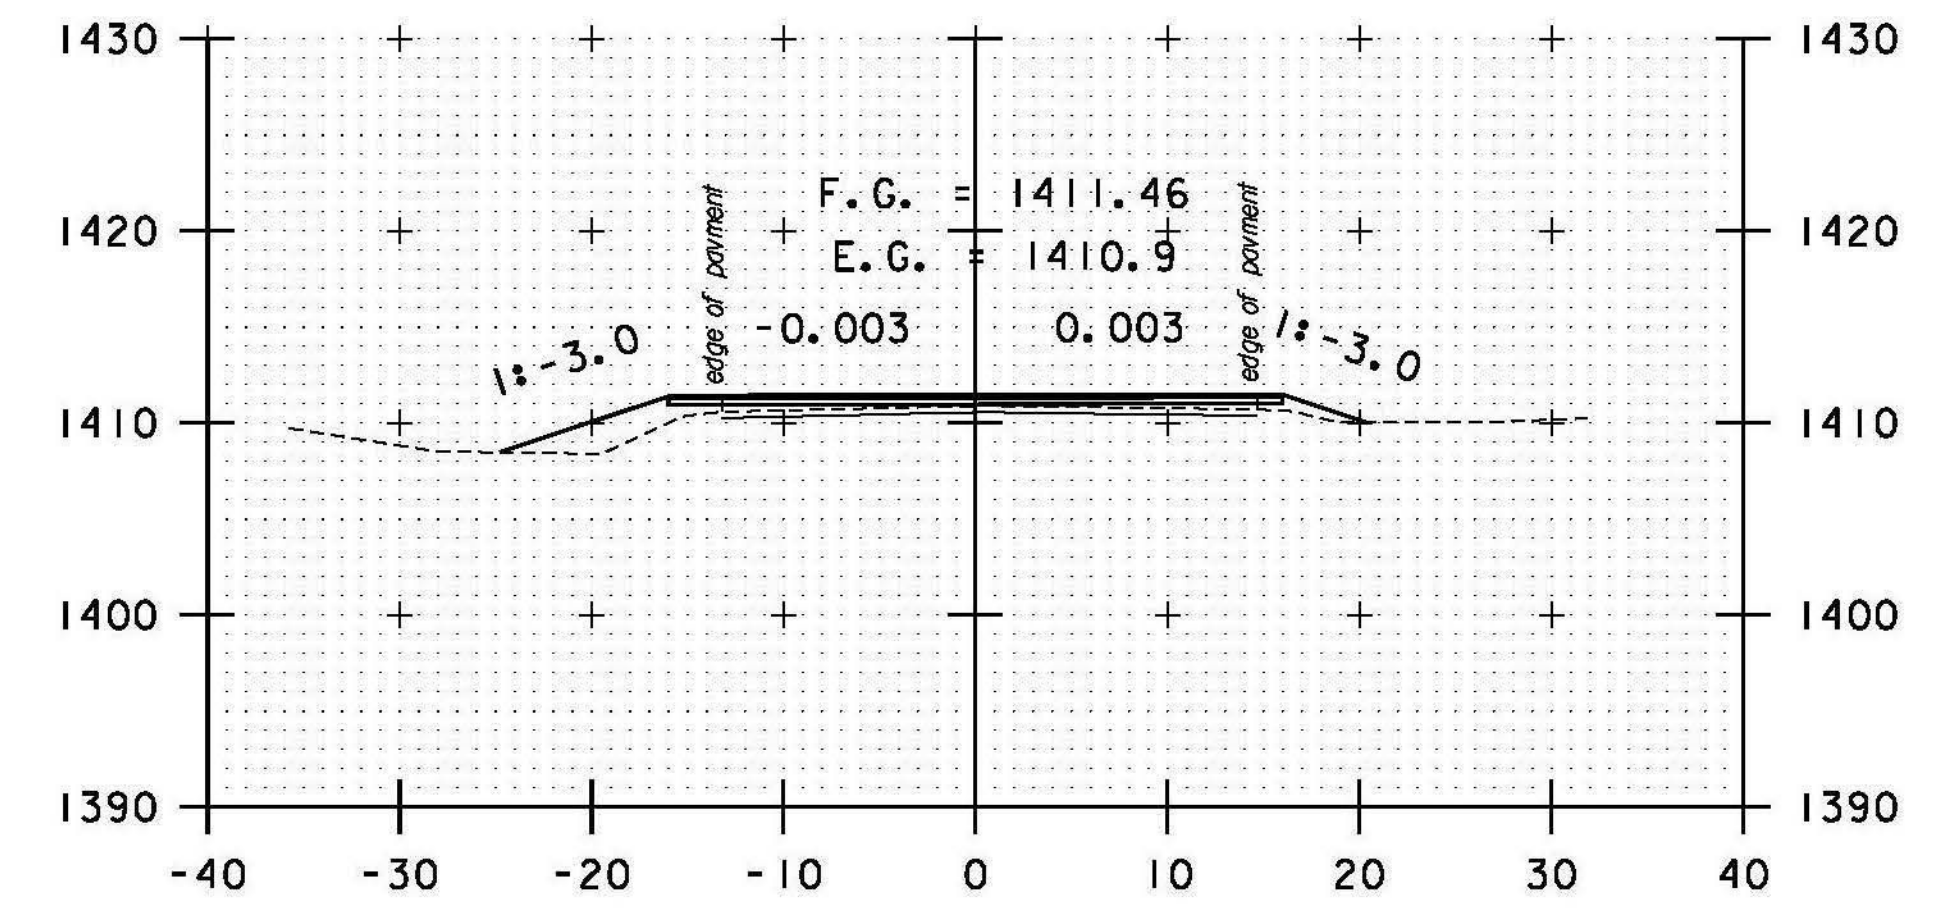


215+50

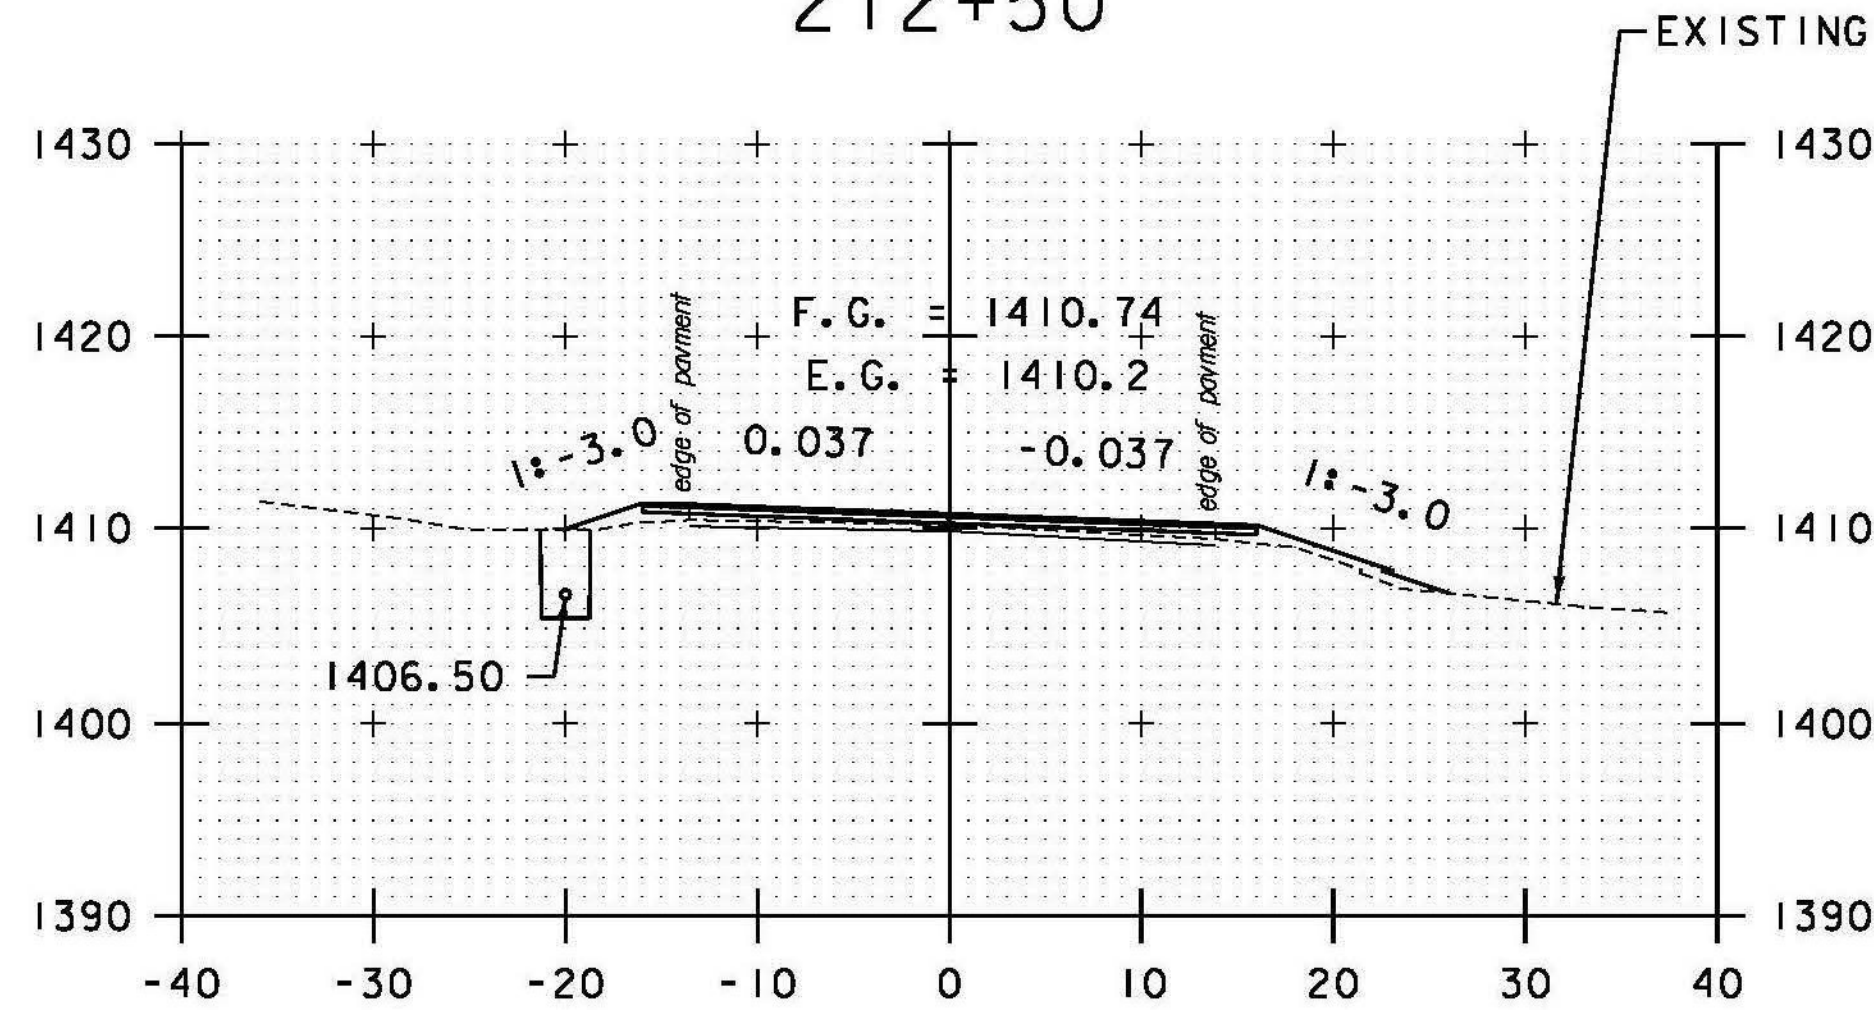


212+00

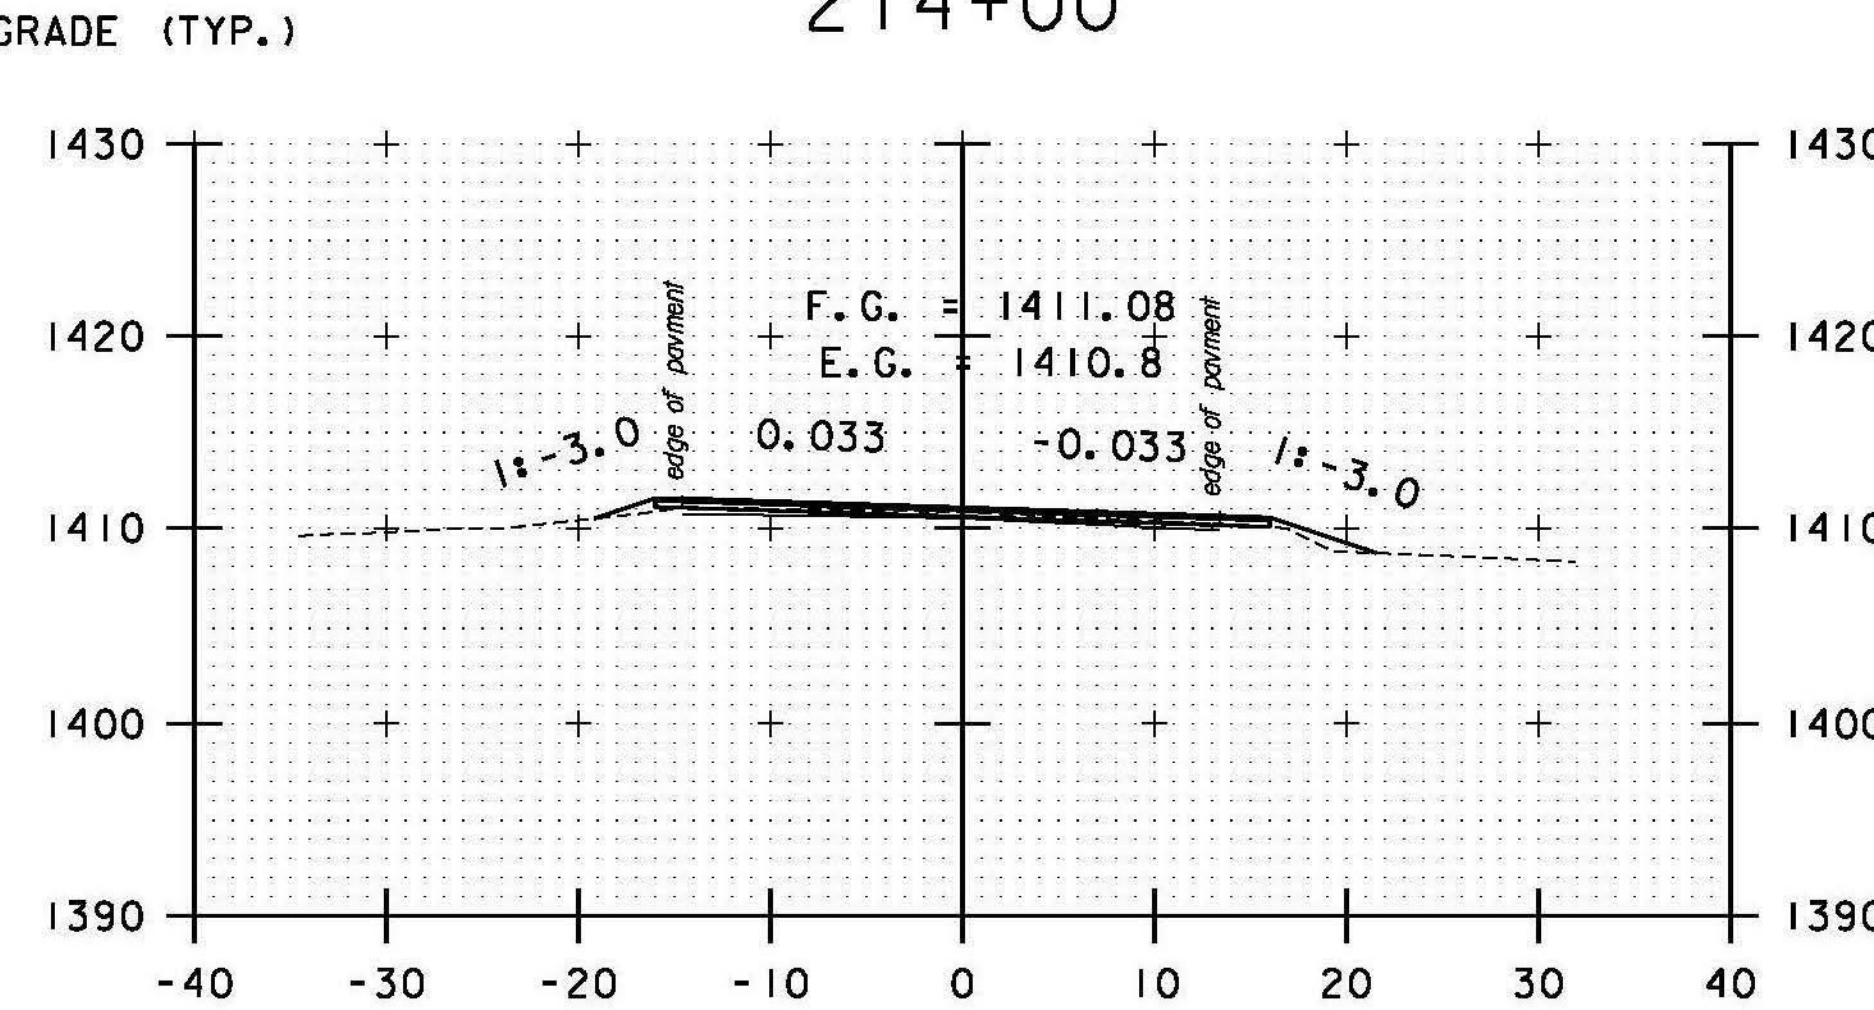


213+50

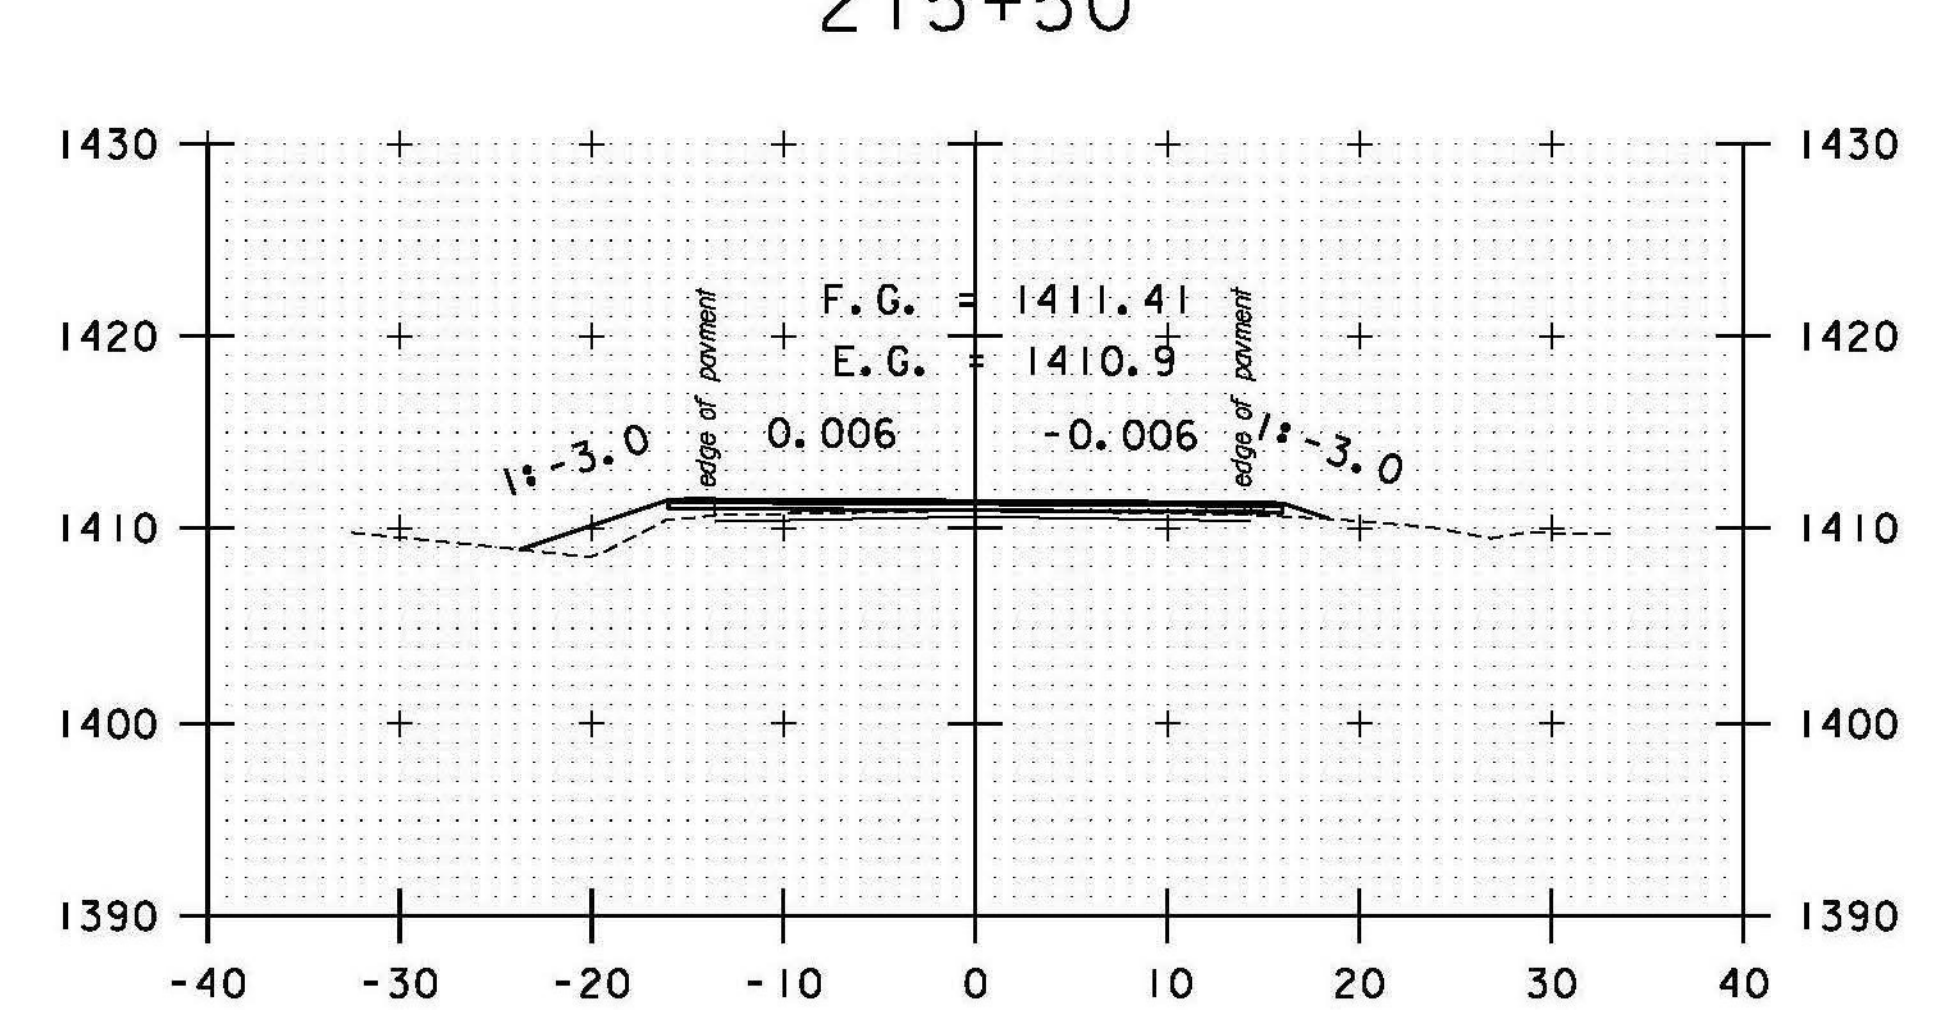


215+00

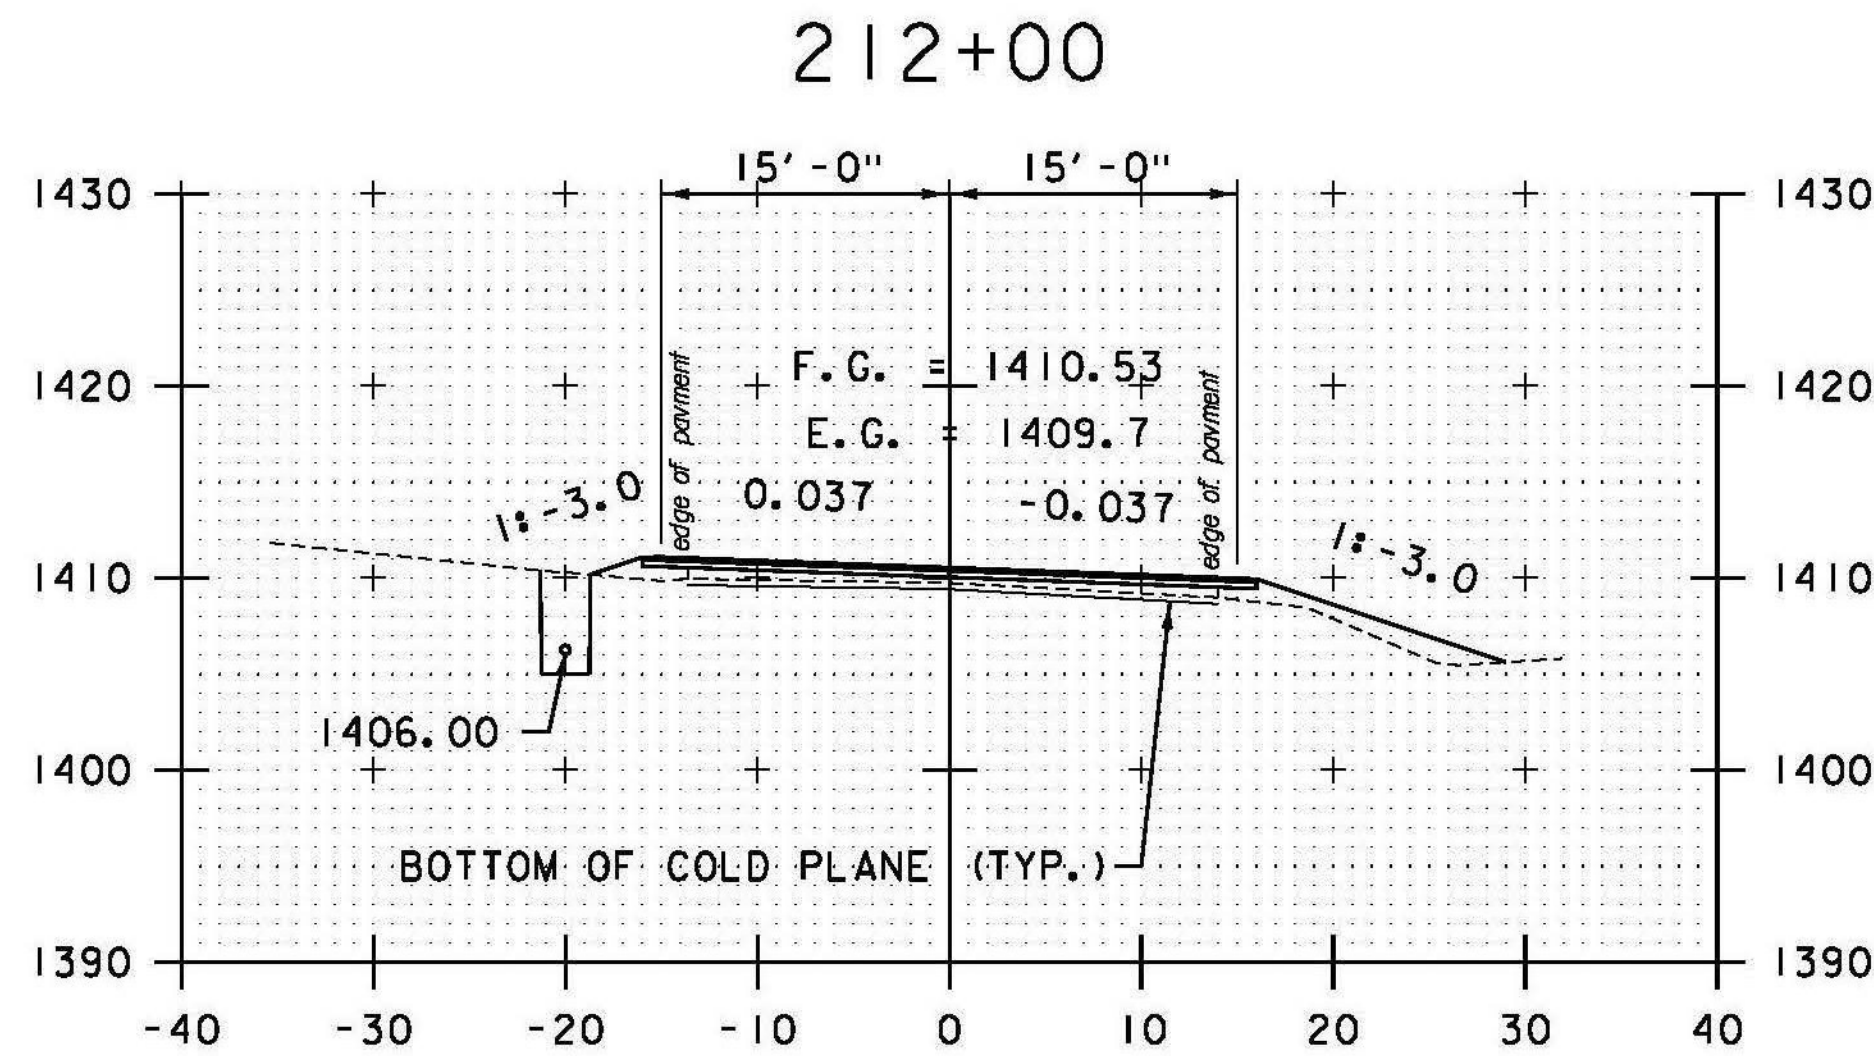

211+50

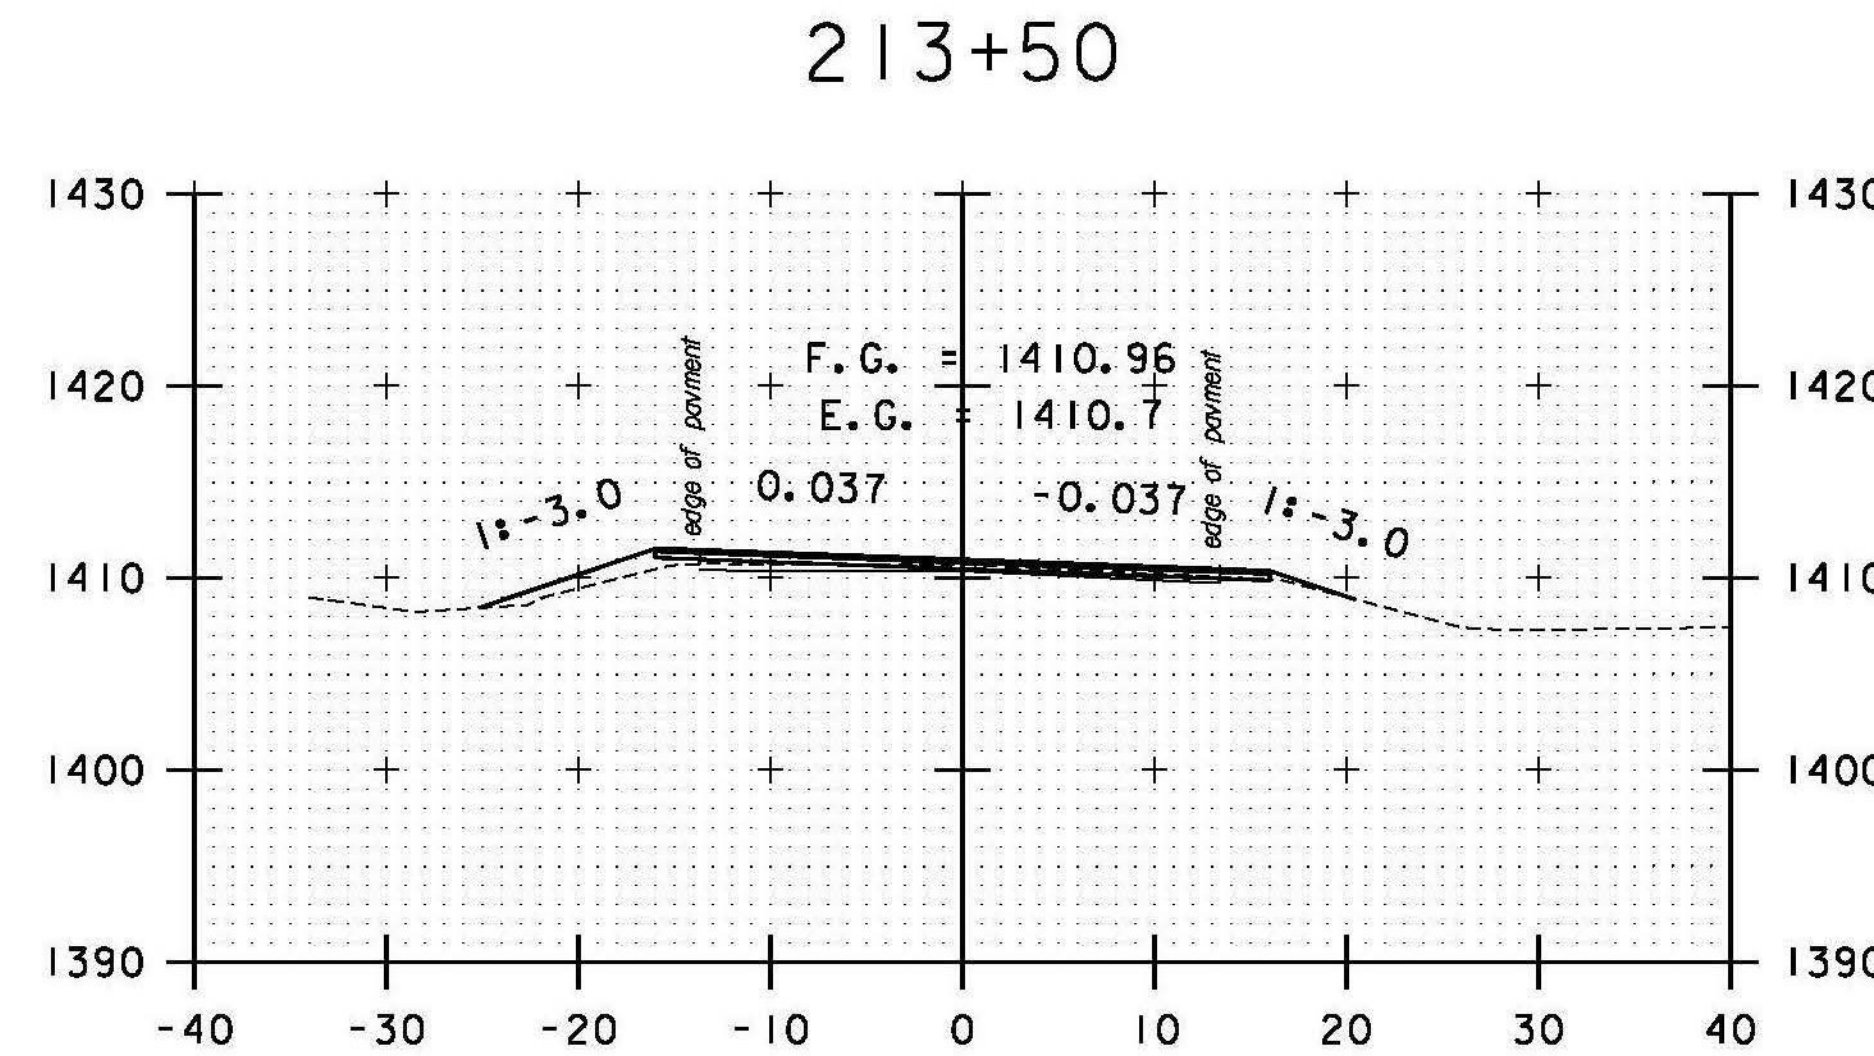

213+00

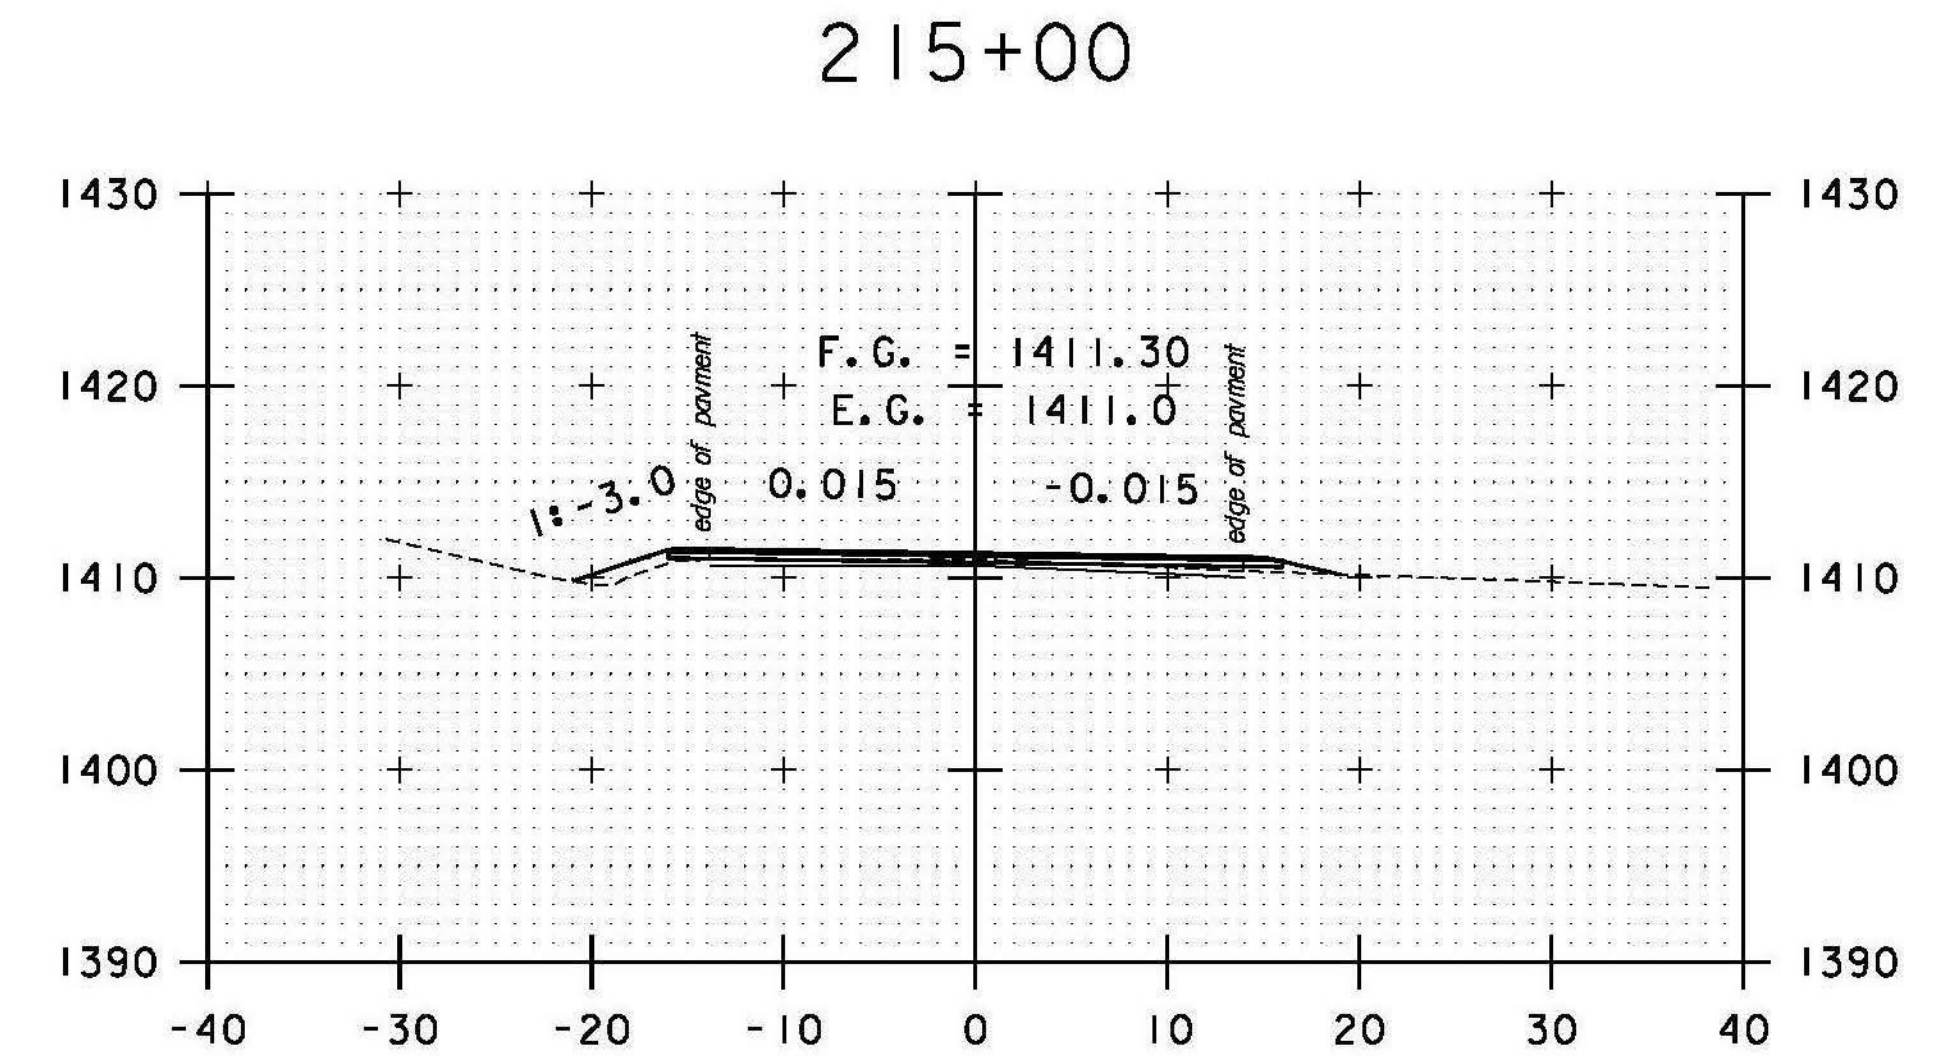


215+00

13 STA. 213+90.00 LT 25.96' TO
 STA. 213+92.87 RT 27.96'
 REMOVE EXISTING PIPE
 INSTALL 18" CPEP (54'-0")
 INV. IN = 1407.10'
 INV. OUT = 1405.05'

STA. 211+50 TO STA. 215+50

DRIVE RT
214+50

DATUM
 VERTICAL NAVD 88
 HORIZONTAL NAD 83 (07)

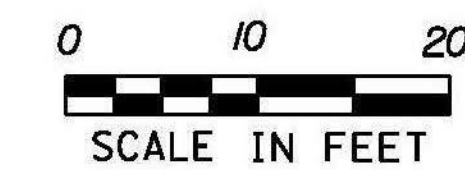

PROJECT NAME: RANDOLPH
 PROJECT NUMBER: STP 2932 (1)

FILE NAME: z10c270.dgn
 PROJECT LEADER: C. LATHROP
 DESIGNED BY: B. BRESLEND
 VT 66 CROSS SECTION SHEET 43

PLOT DATE: 6/5/2014
 DRAWN BY: B. BRESLEND
 CHECKED BY: C. LATHROP
 SHEET 199 OF 276