



230+50

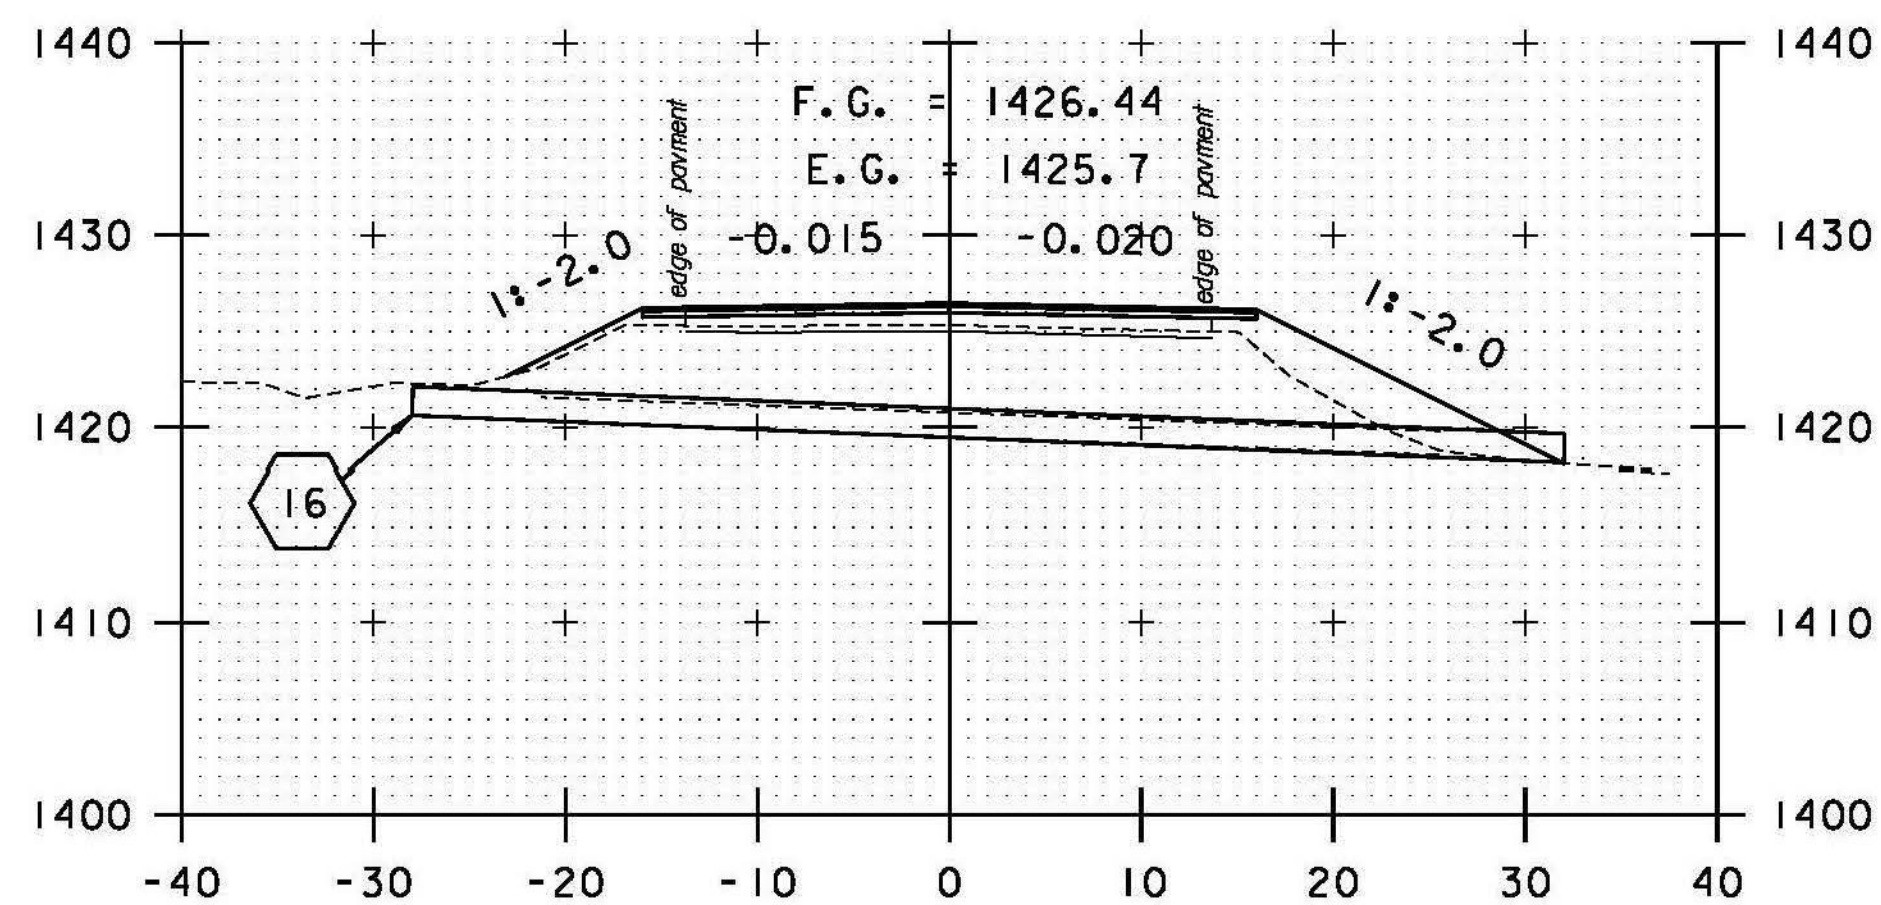


230+00

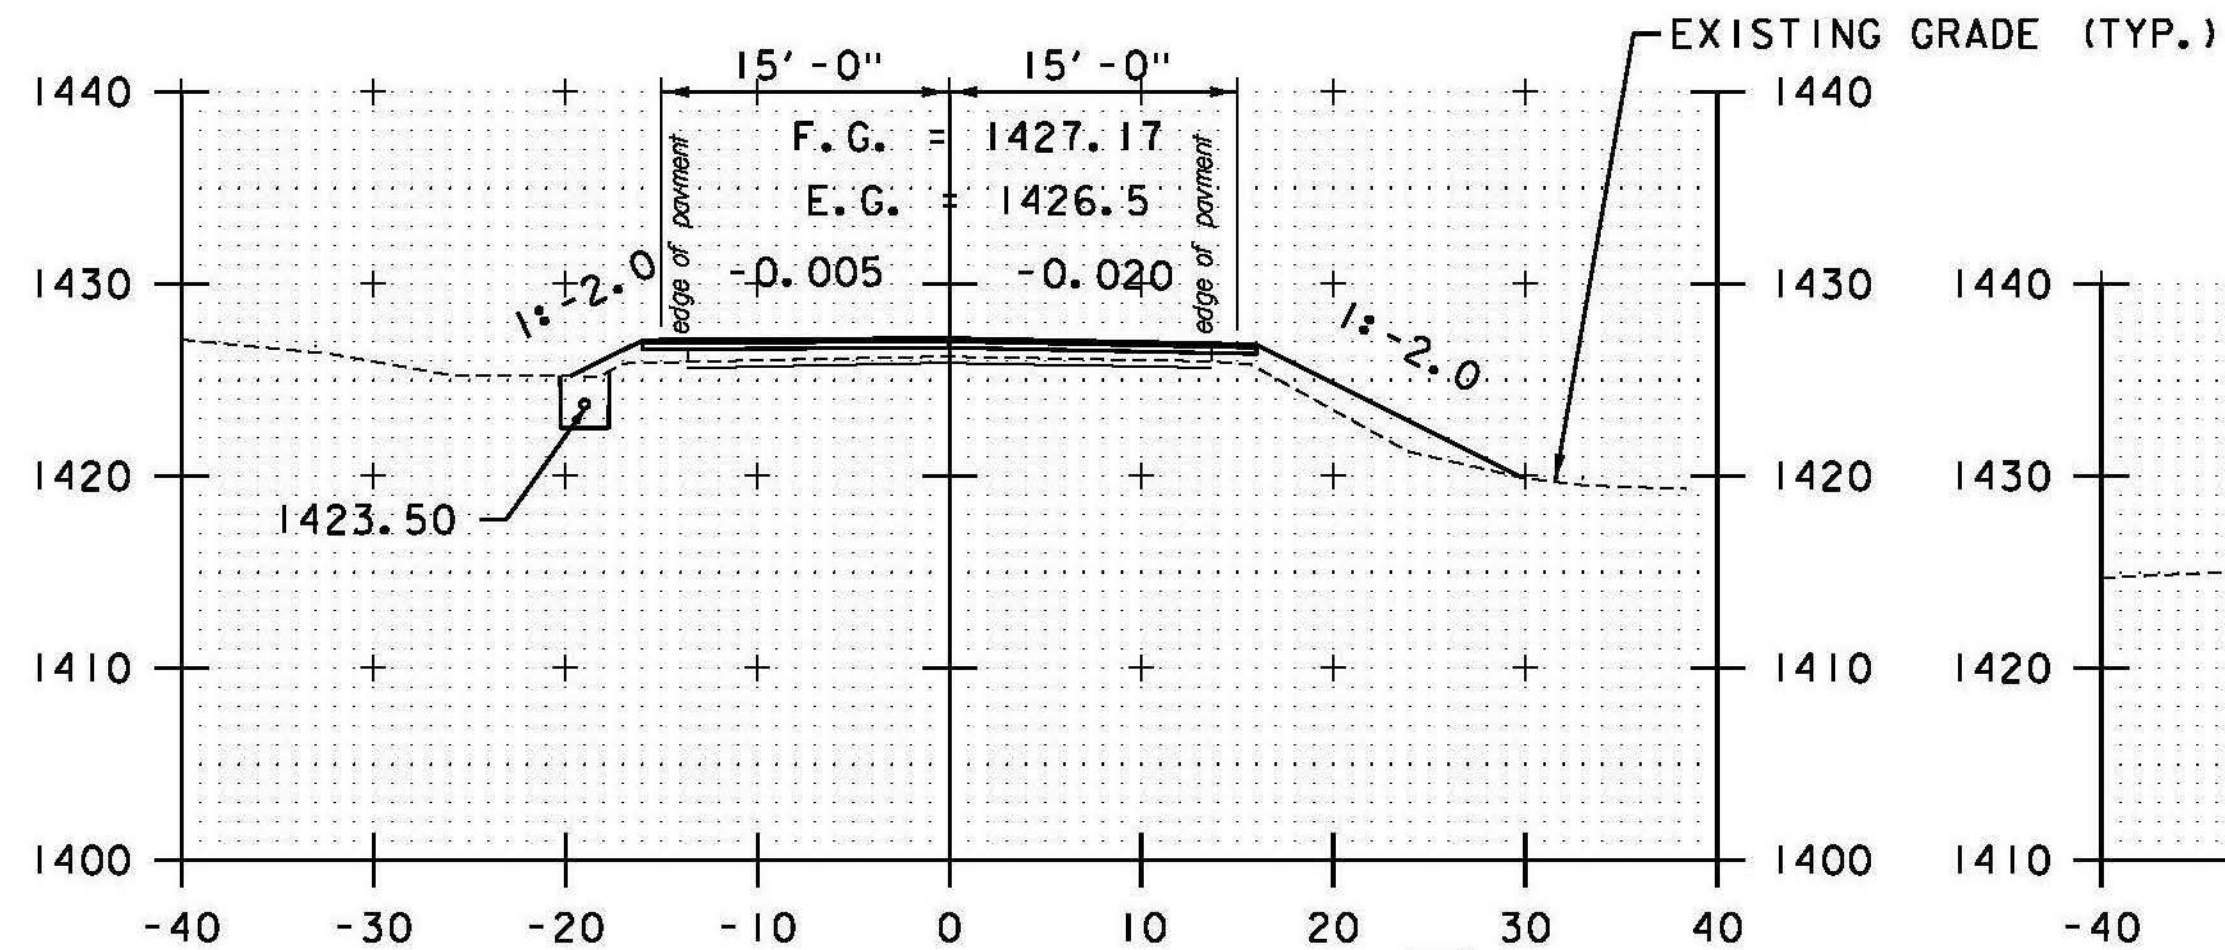


229+50


16 STA. 229+88.34 LT 27.99' TO  
STA. 229+89.86 RT 31.99'  
REMOVE HEADWALL AND PIPE  
INSTALL 18" CPEP (60'-0")  
INV. IN = 1420.60'  
INV. OUT = 1418.15'

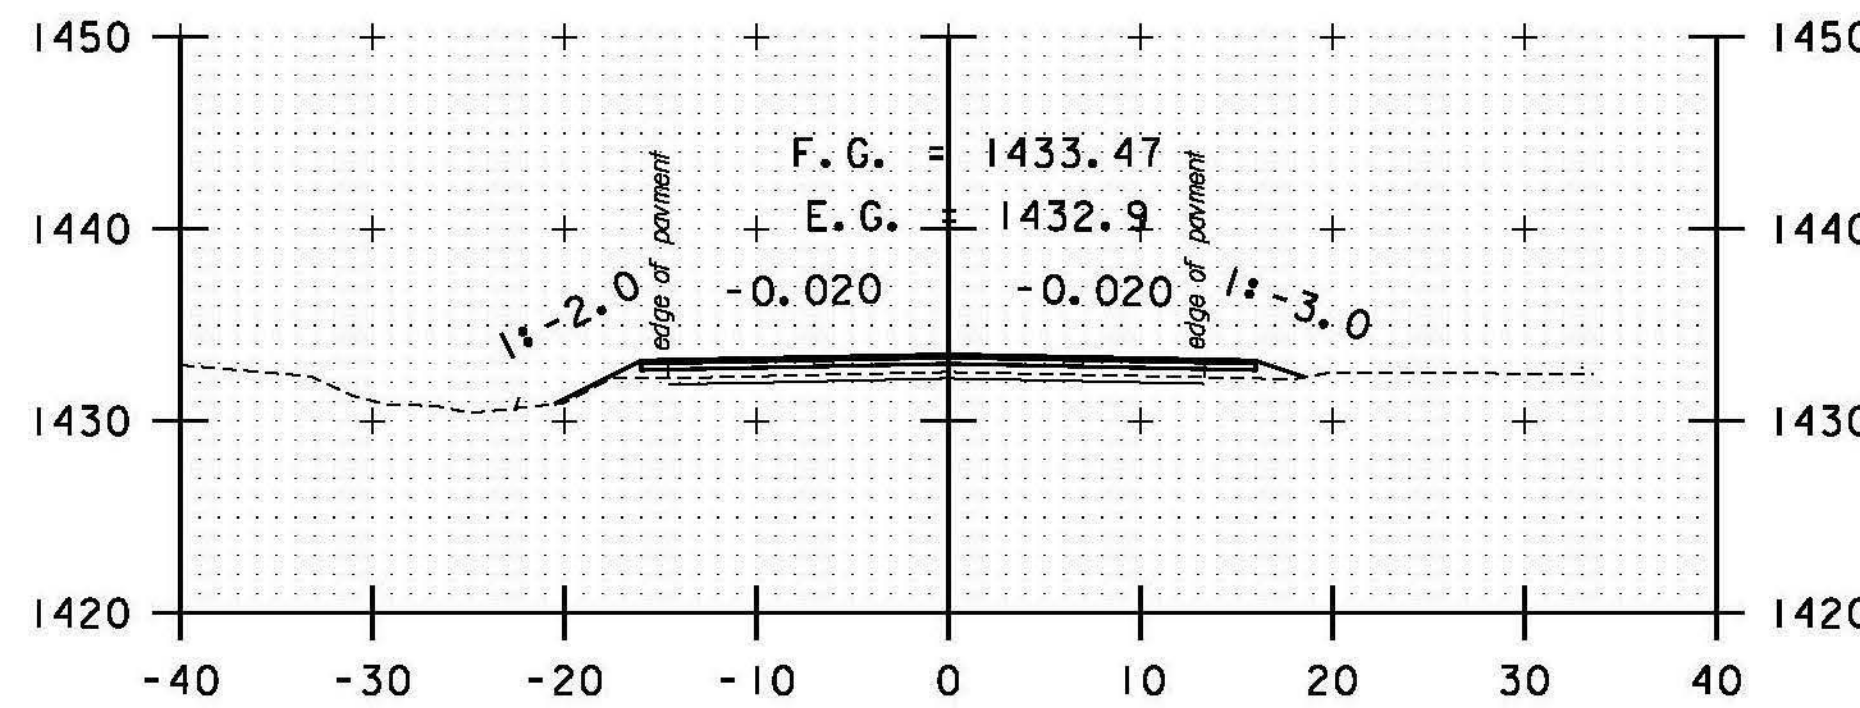


232+00

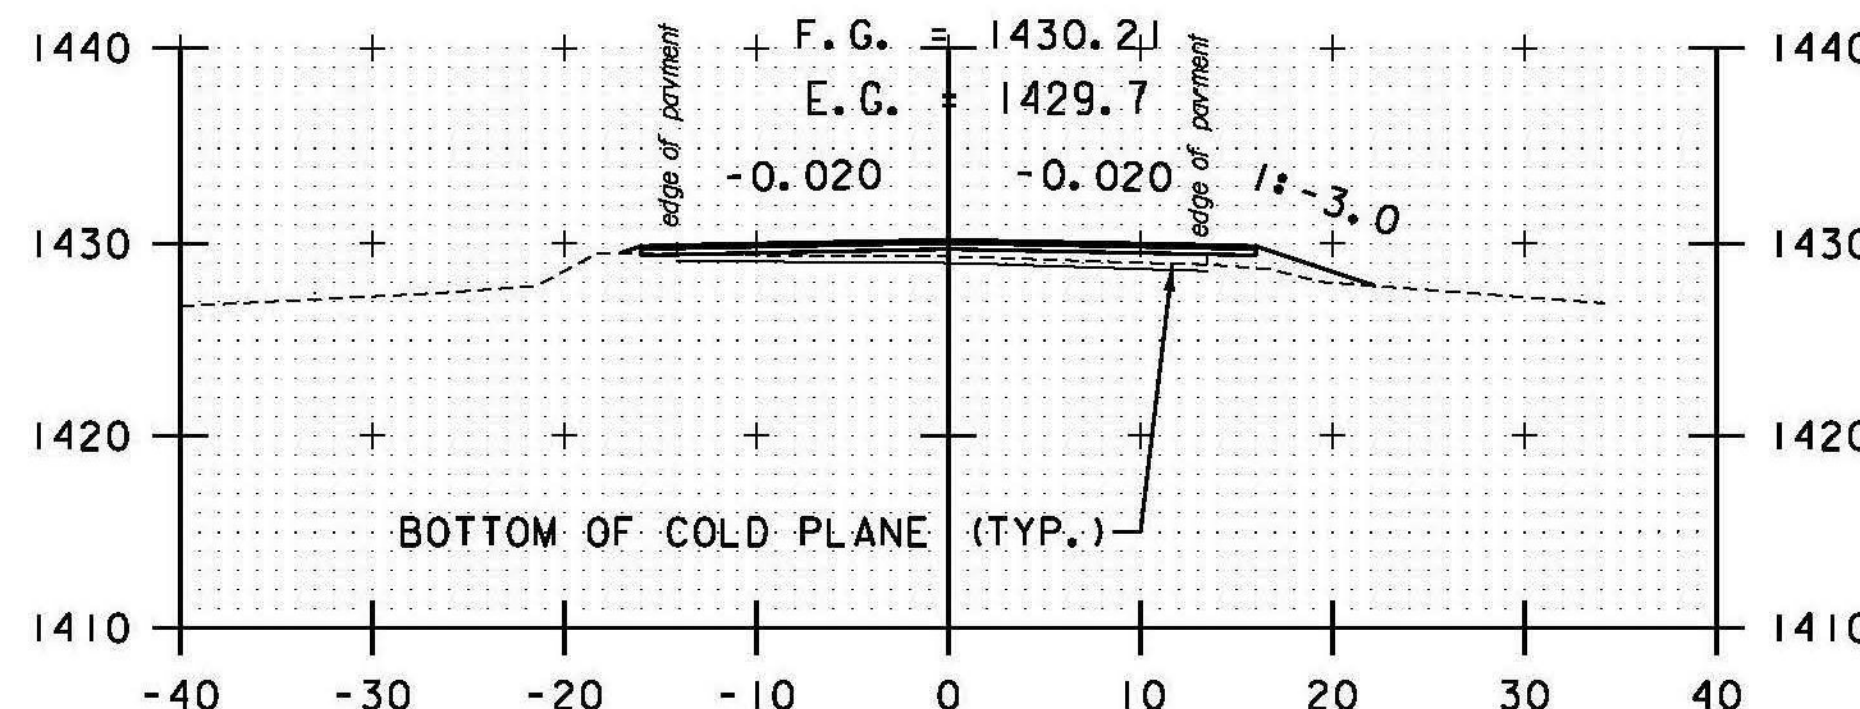


231+50

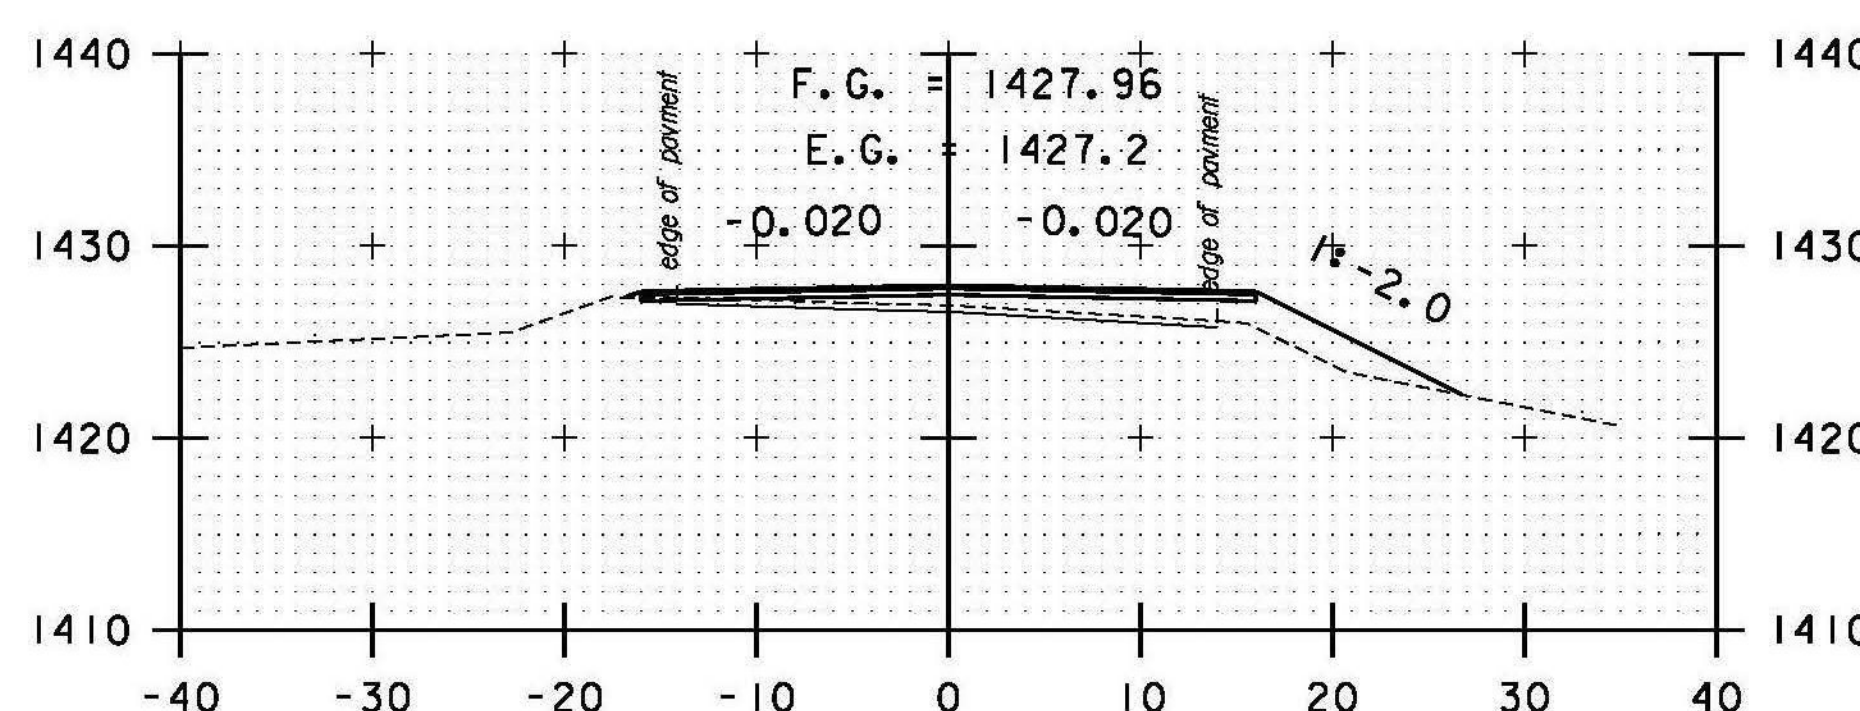


231+00

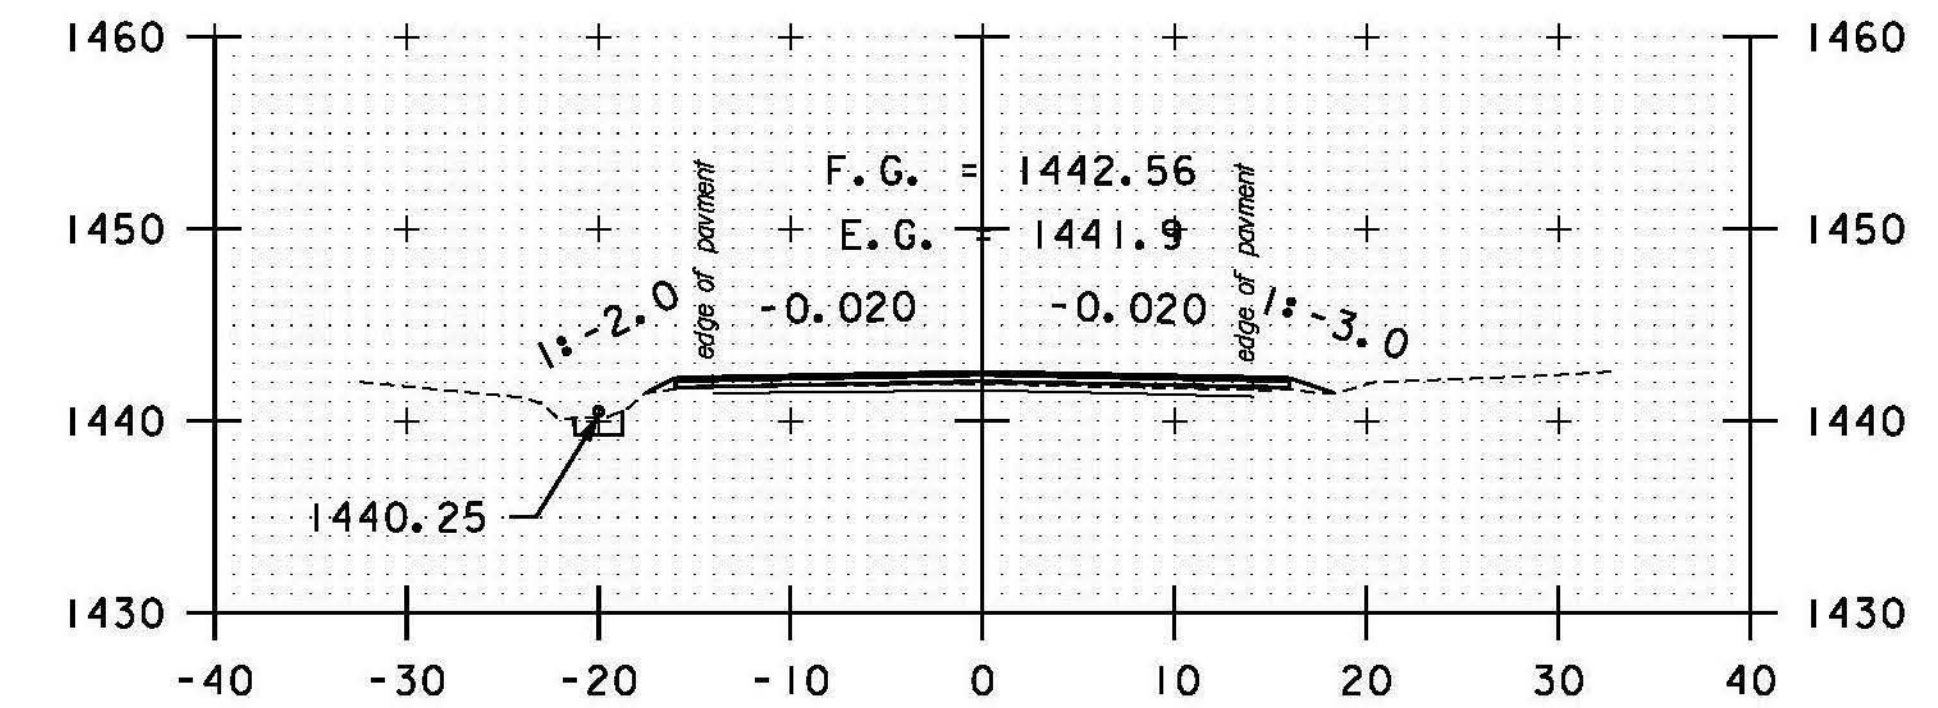

233+00

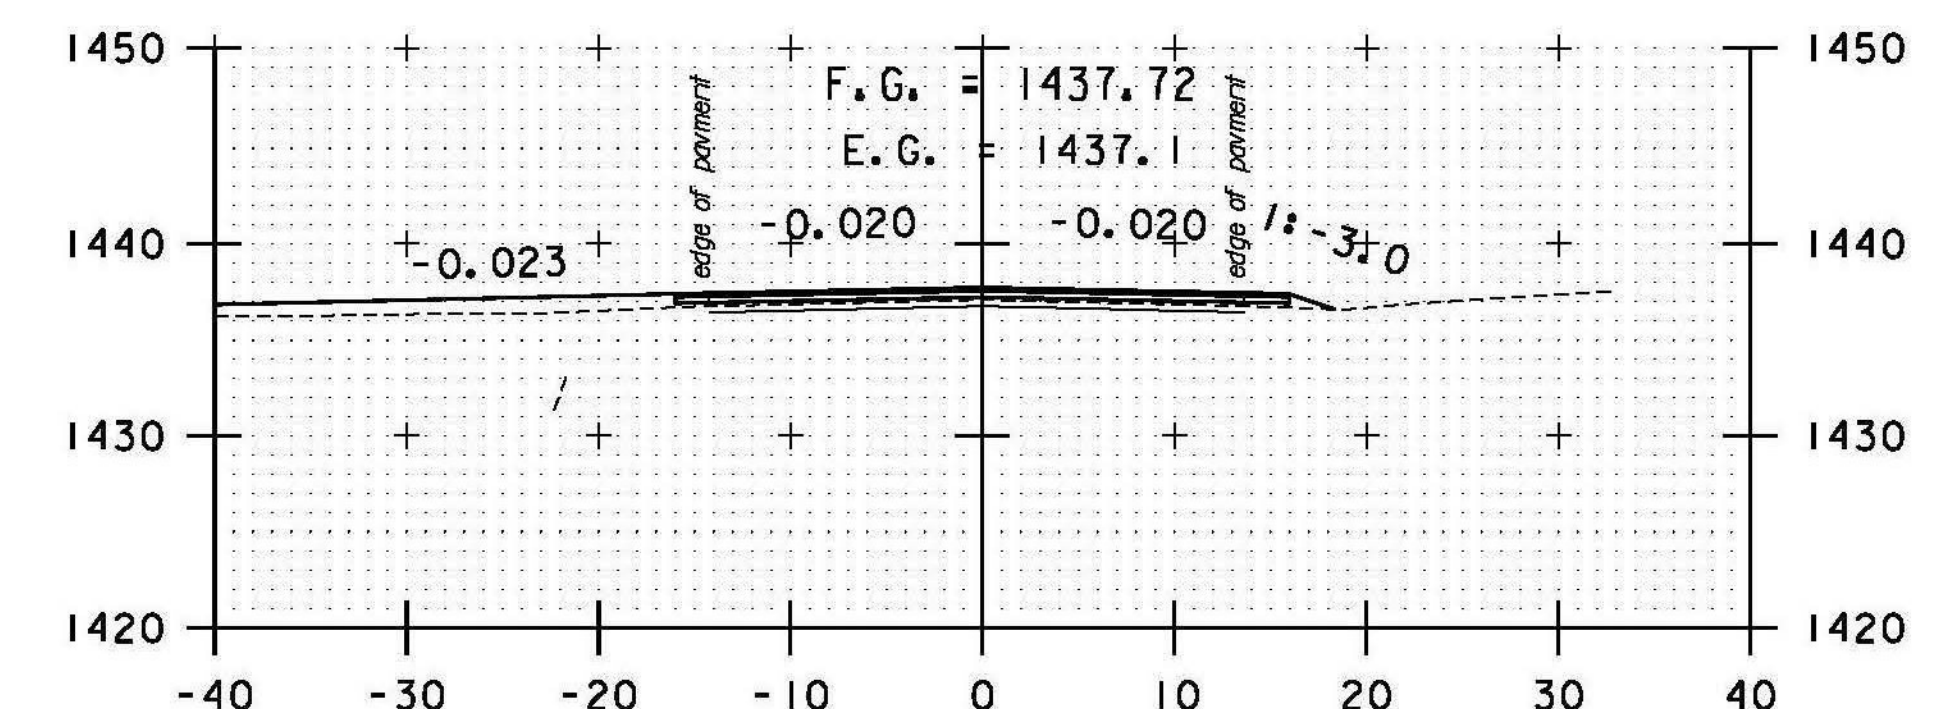


TH#30 LT  
232+50

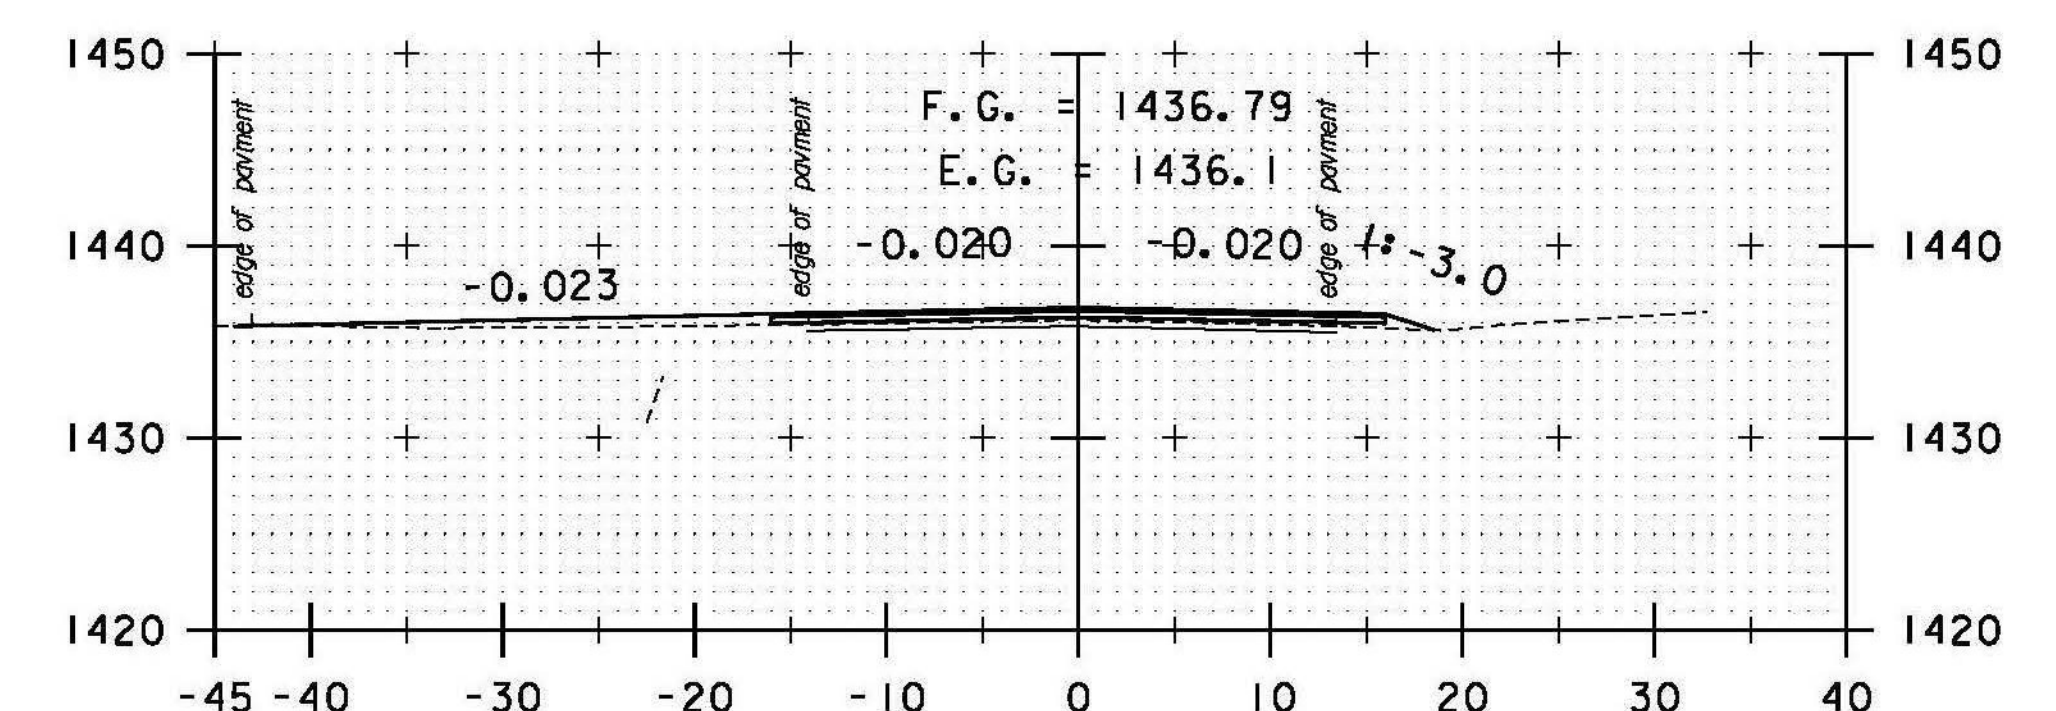

TH#30 LT  
232+40

STA. 229+50 TO STA. 233+00

DATUM  
VERTICAL NAVD 88  
HORIZONTAL NAD 83 (07)

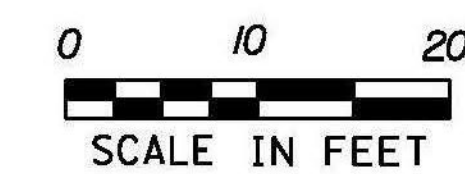

PROJECT NAME: RANDOLPH  
PROJECT NUMBER: STP 2932 (1)

FILE NAME: z10c270.dgn  
PROJECT LEADER: C. LATHROP  
DESIGNED BY: B. BRESLEND  
VT 66 CROSS SECTION SHEET 47

PLOT DATE: 6/5/2014  
DRAWN BY: B. BRESLEND  
CHECKED BY: C. LATHROP  
SHEET 203 OF 276