




234+50

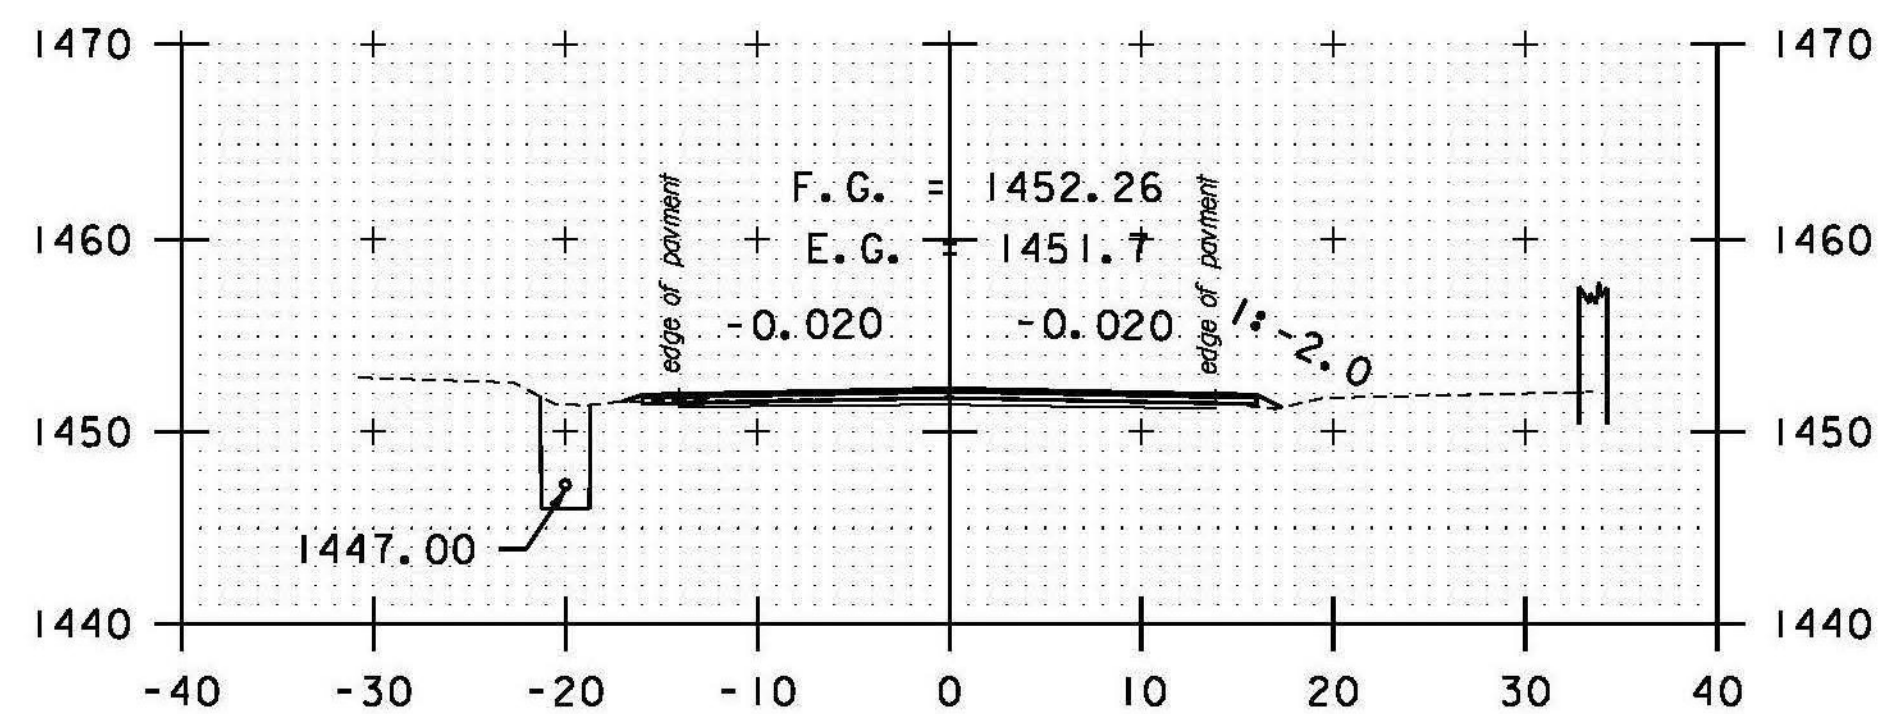


234+00

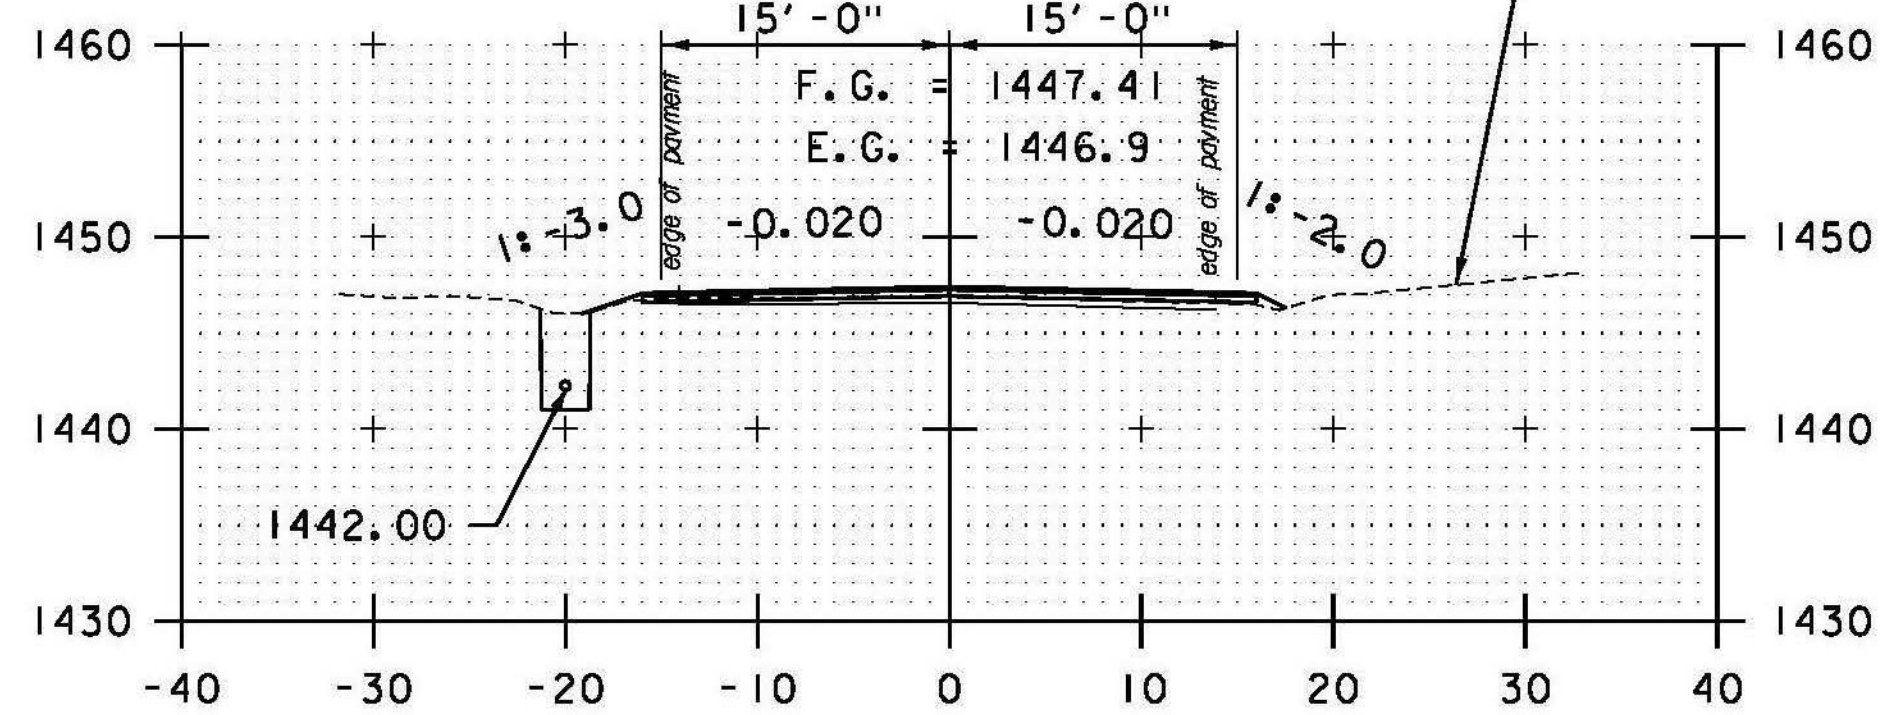


233+50

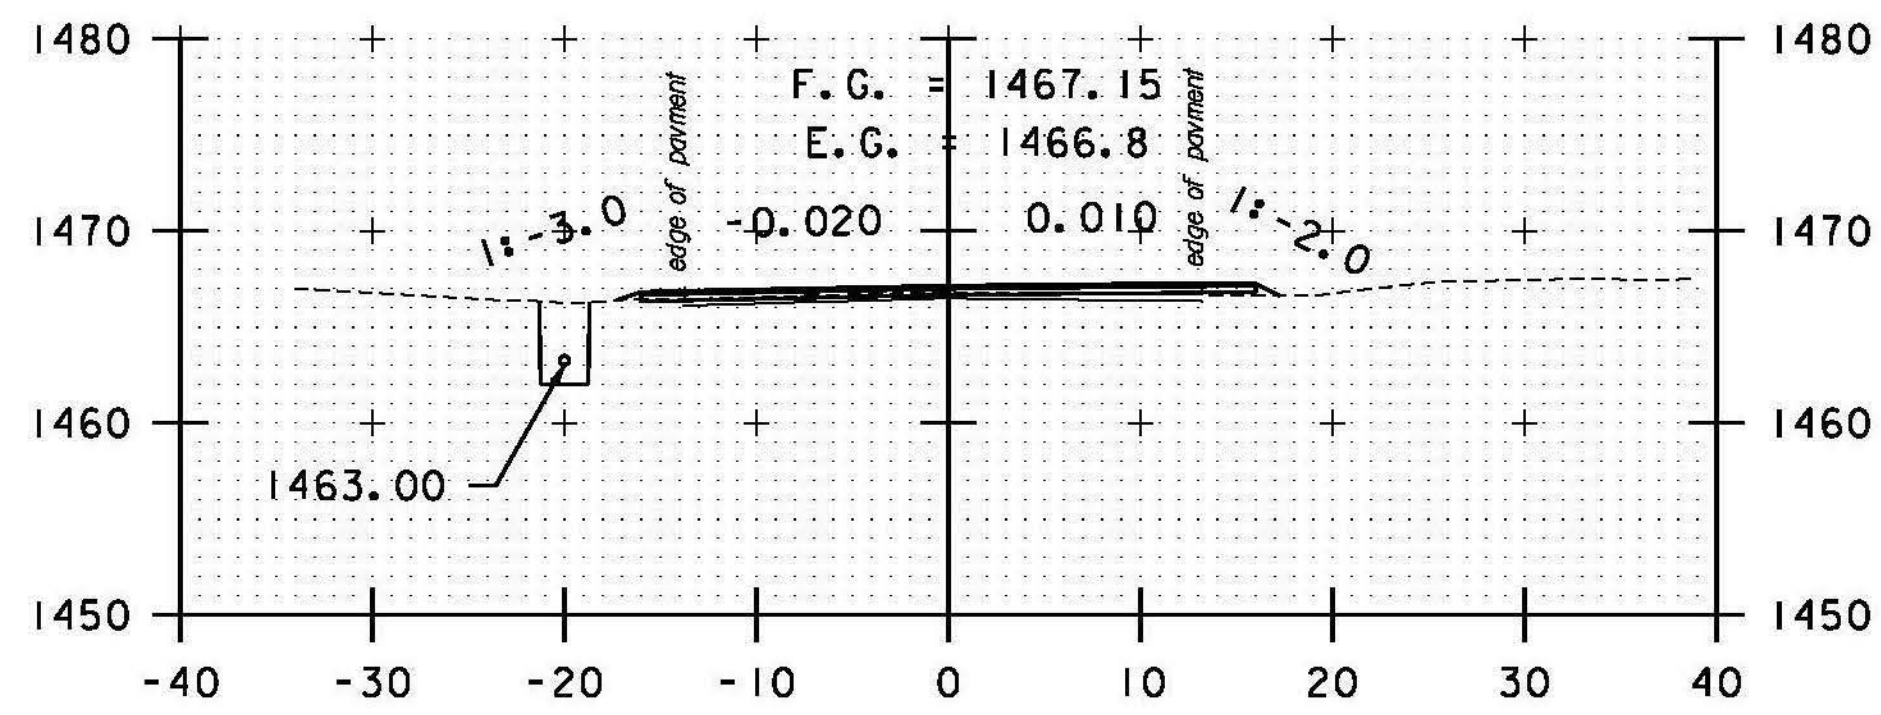


236+00

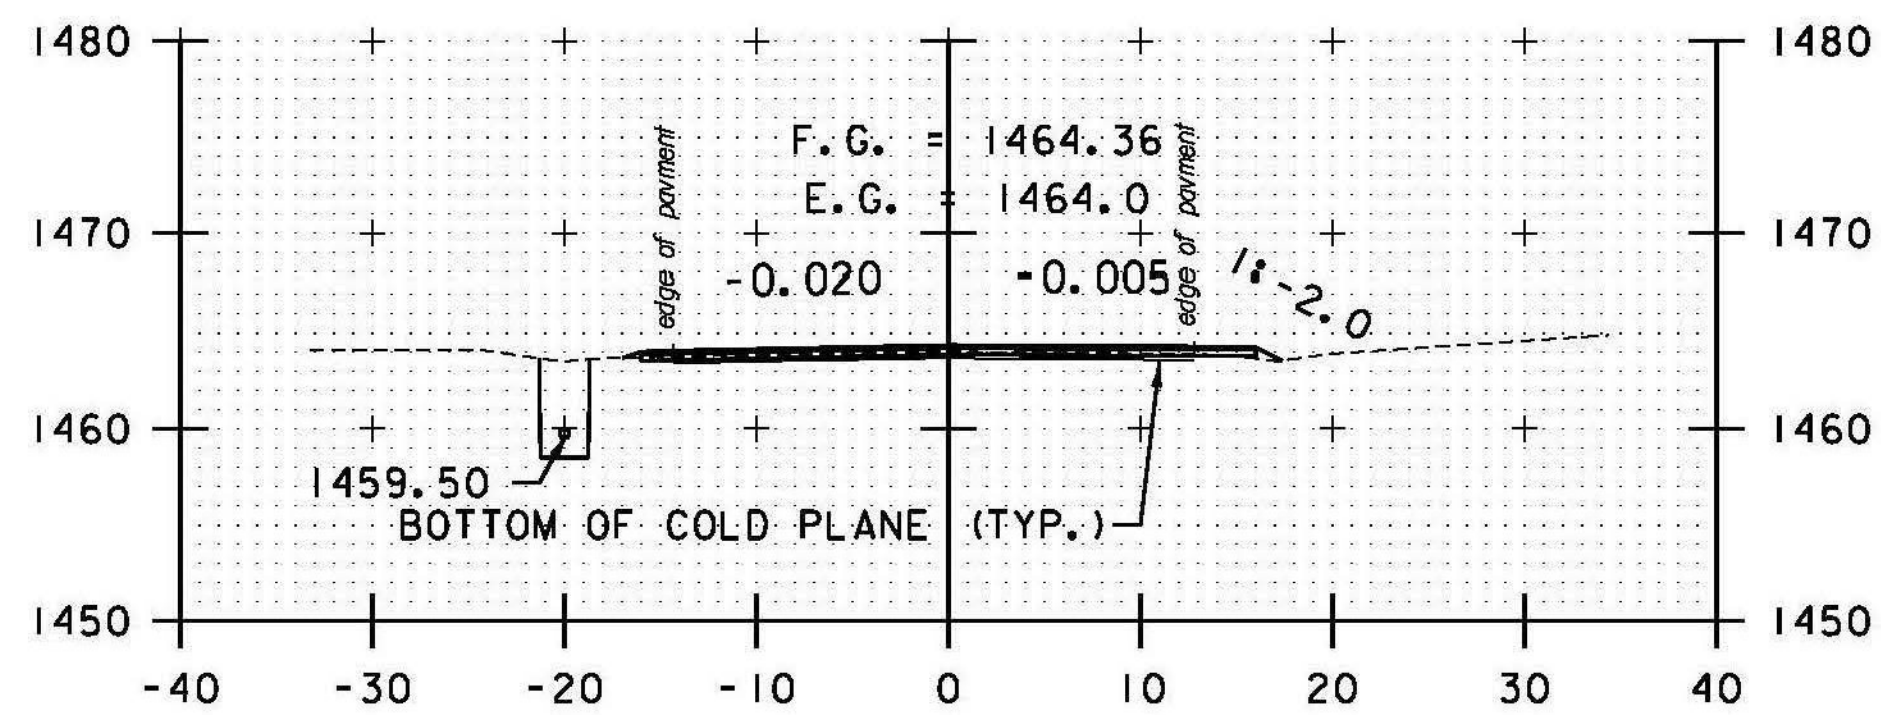


235+50

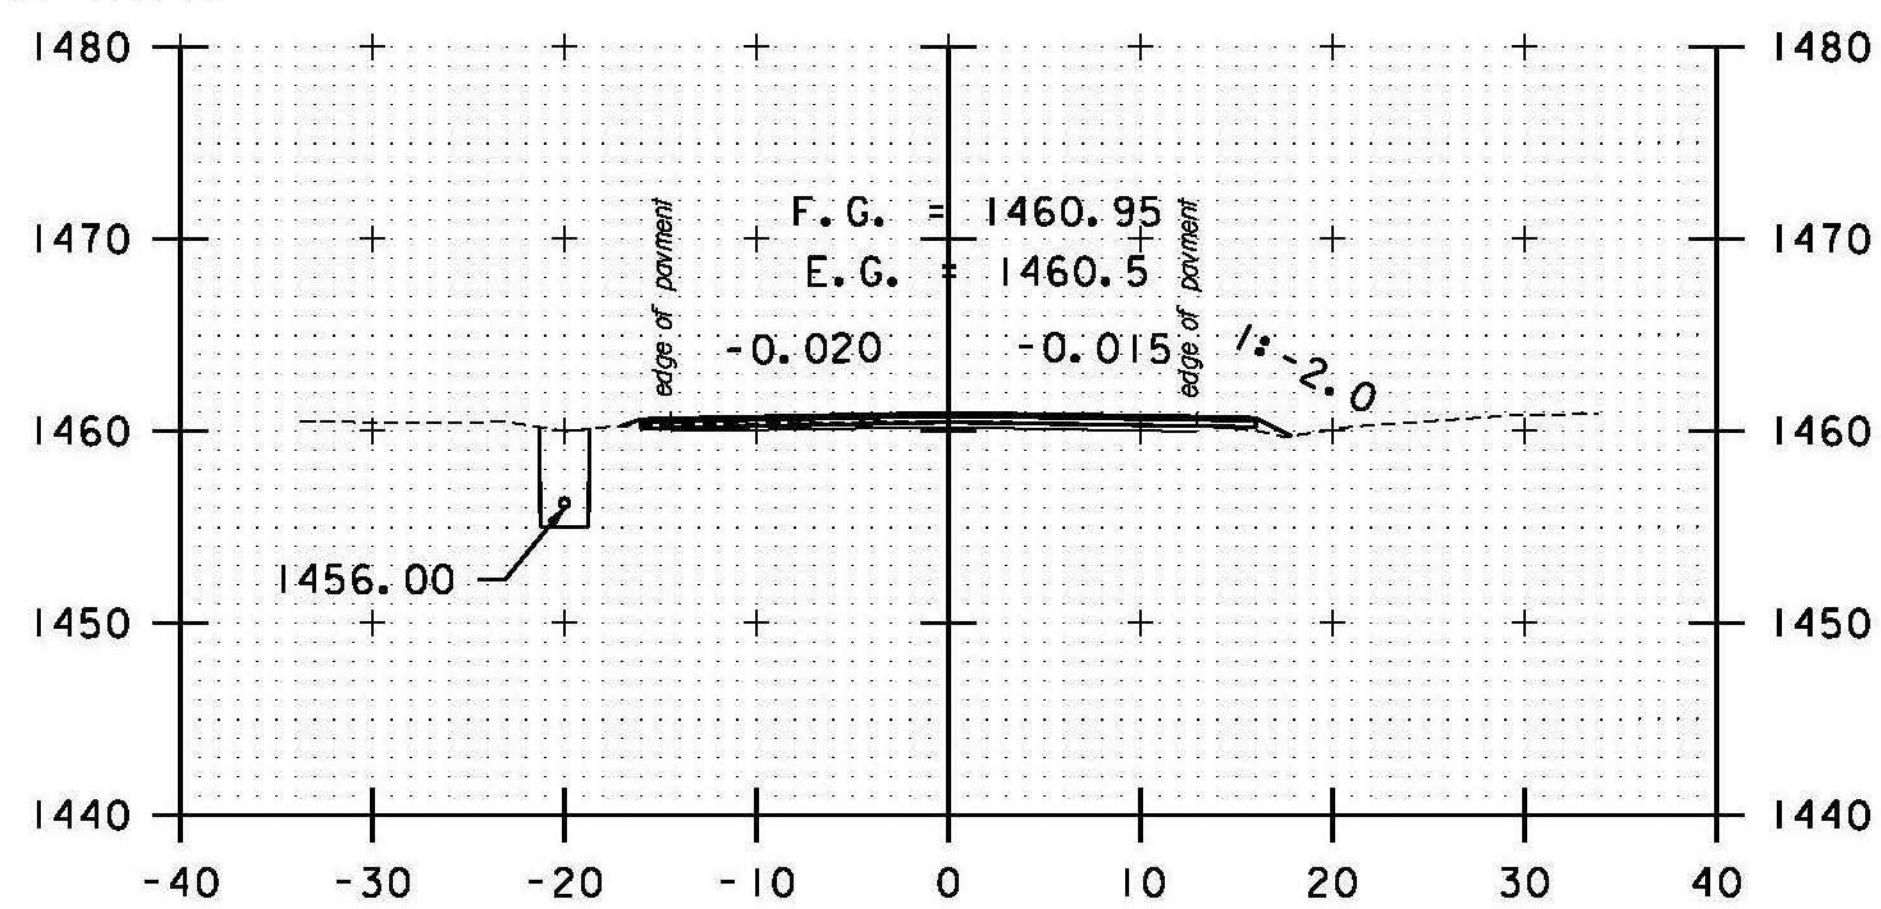


235+00

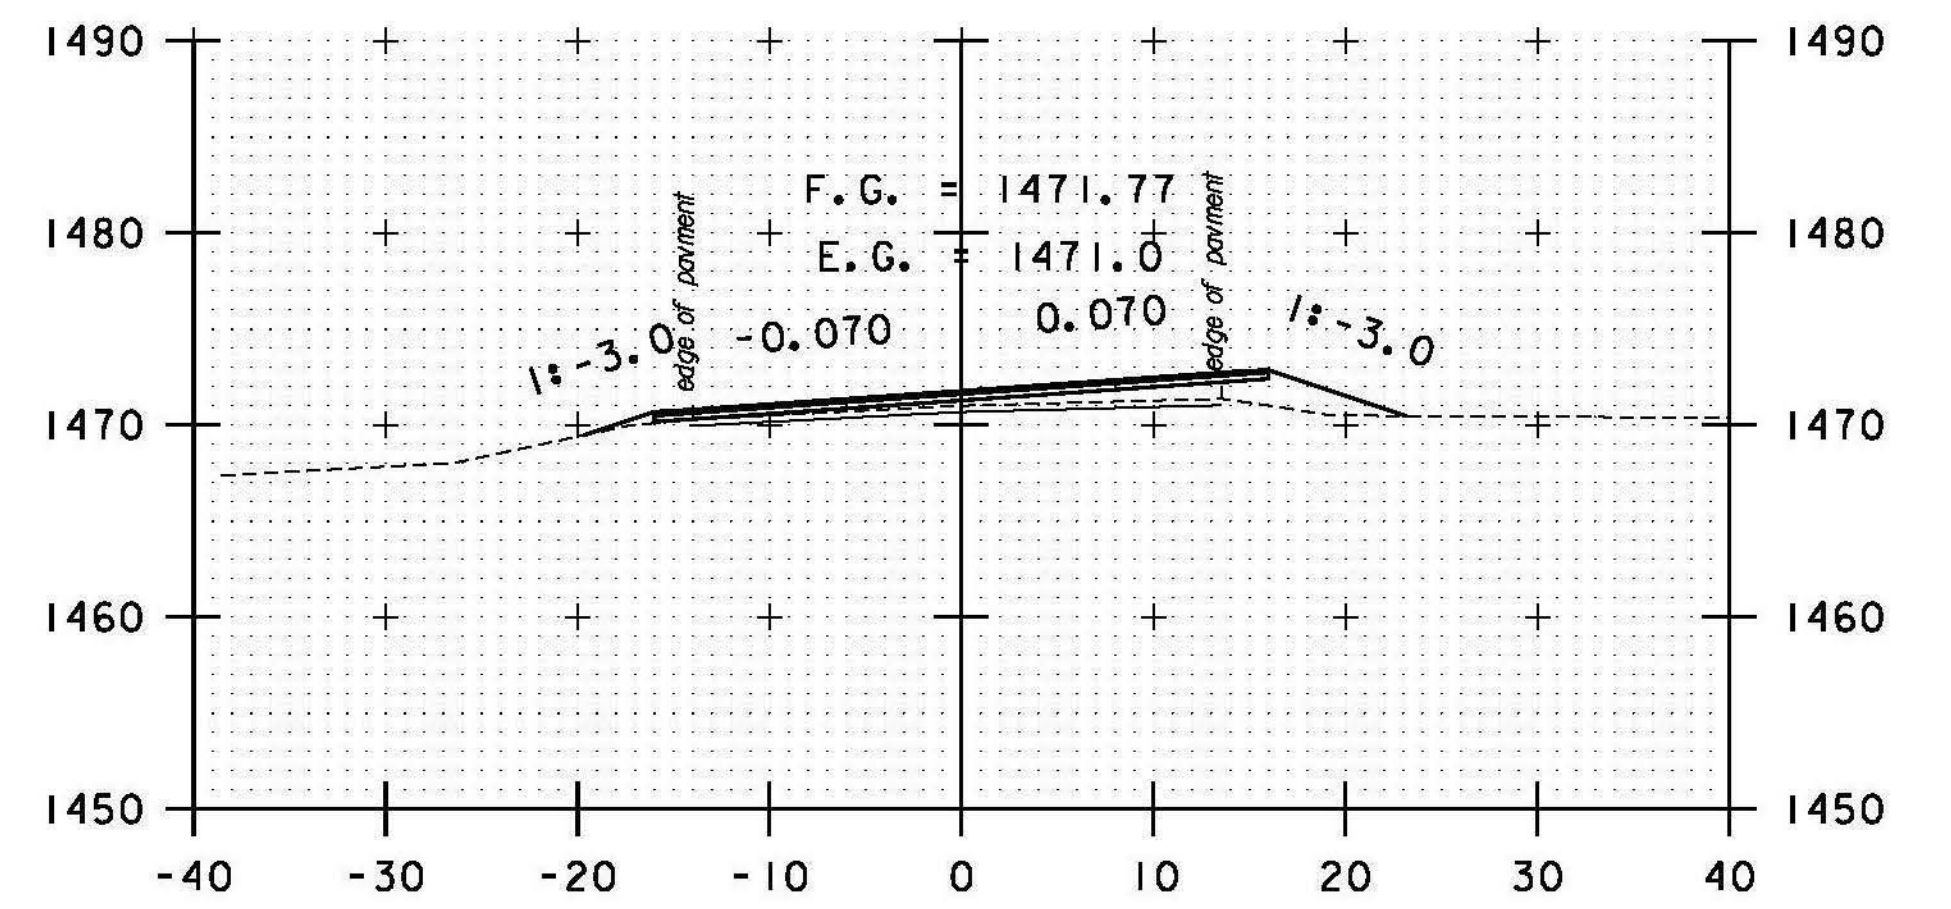

237+50

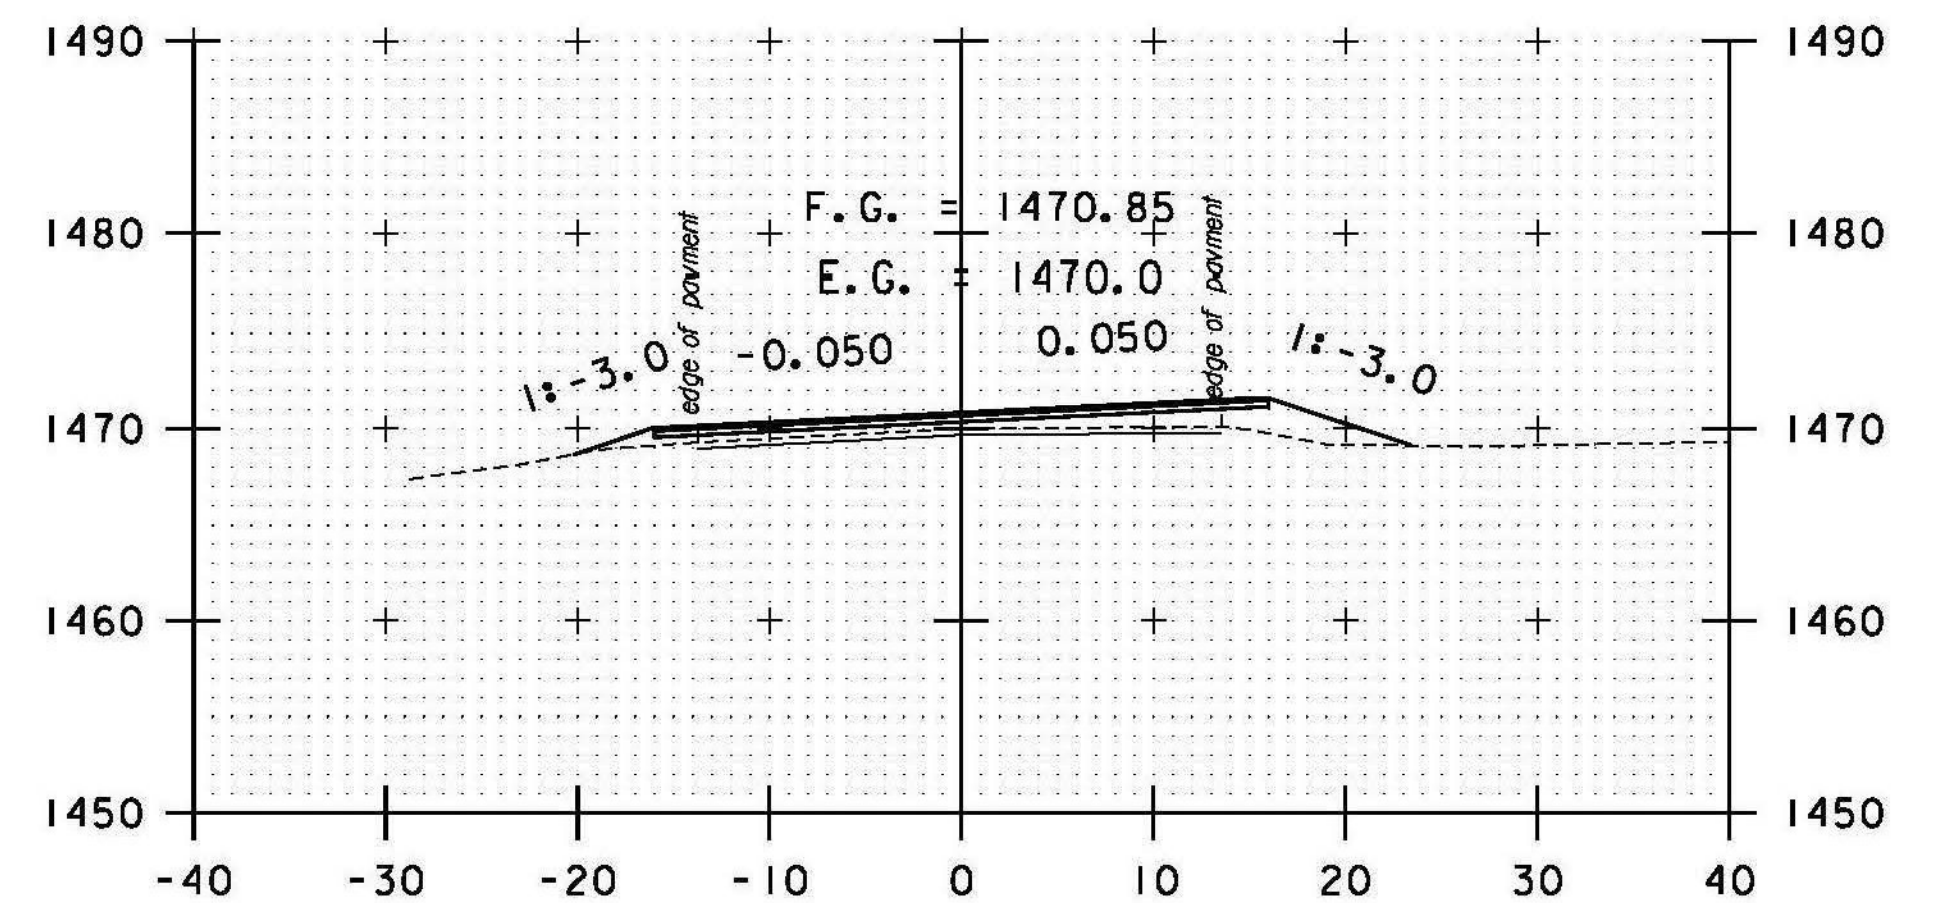


237+00

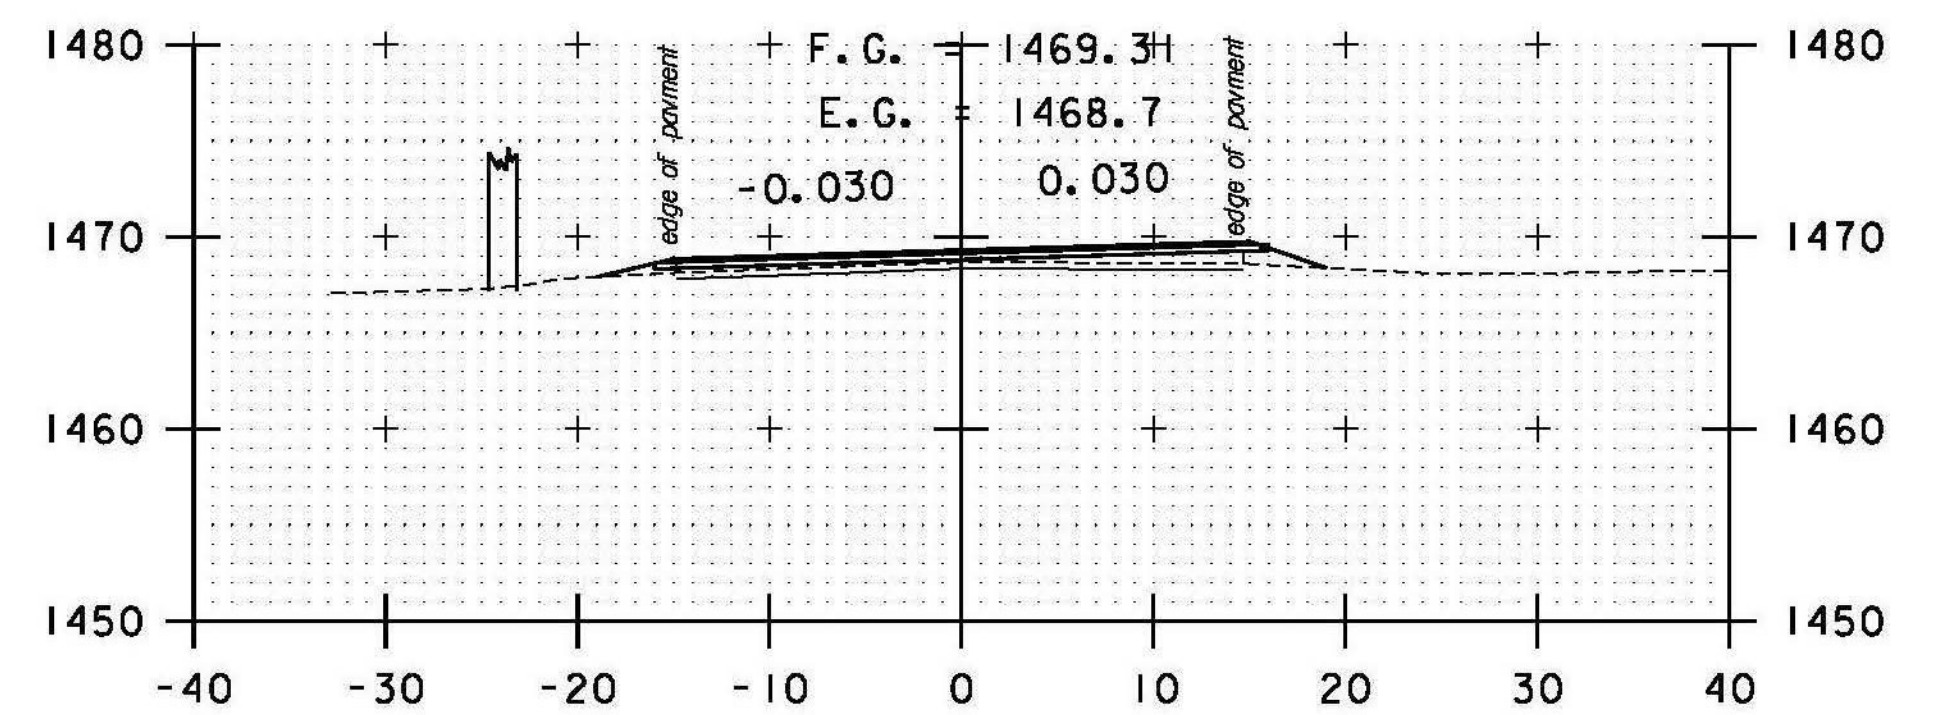

DRIVE LT / RT
236+50

STA. 233+50 TO STA. 237+50

DATUM
 VERTICAL NAVD 88
 HORIZONTAL NAD 83 (07)

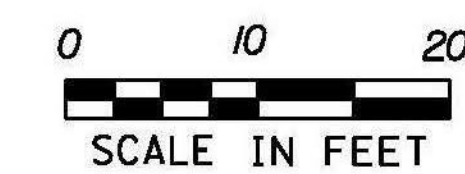

PROJECT NAME: RANDOLPH
 PROJECT NUMBER: STP 2932 (1)

FILE NAME: z10c270.dgn
 PROJECT LEADER: C. LATHROP
 DESIGNED BY: B. BRESLEND
 VT 66 CROSS SECTION SHEET 48

PLOT DATE: 6/5/2014
 DRAWN BY: B. BRESLEND
 CHECKED BY: C. LATHROP
 SHEET 204 OF 276