




239+00

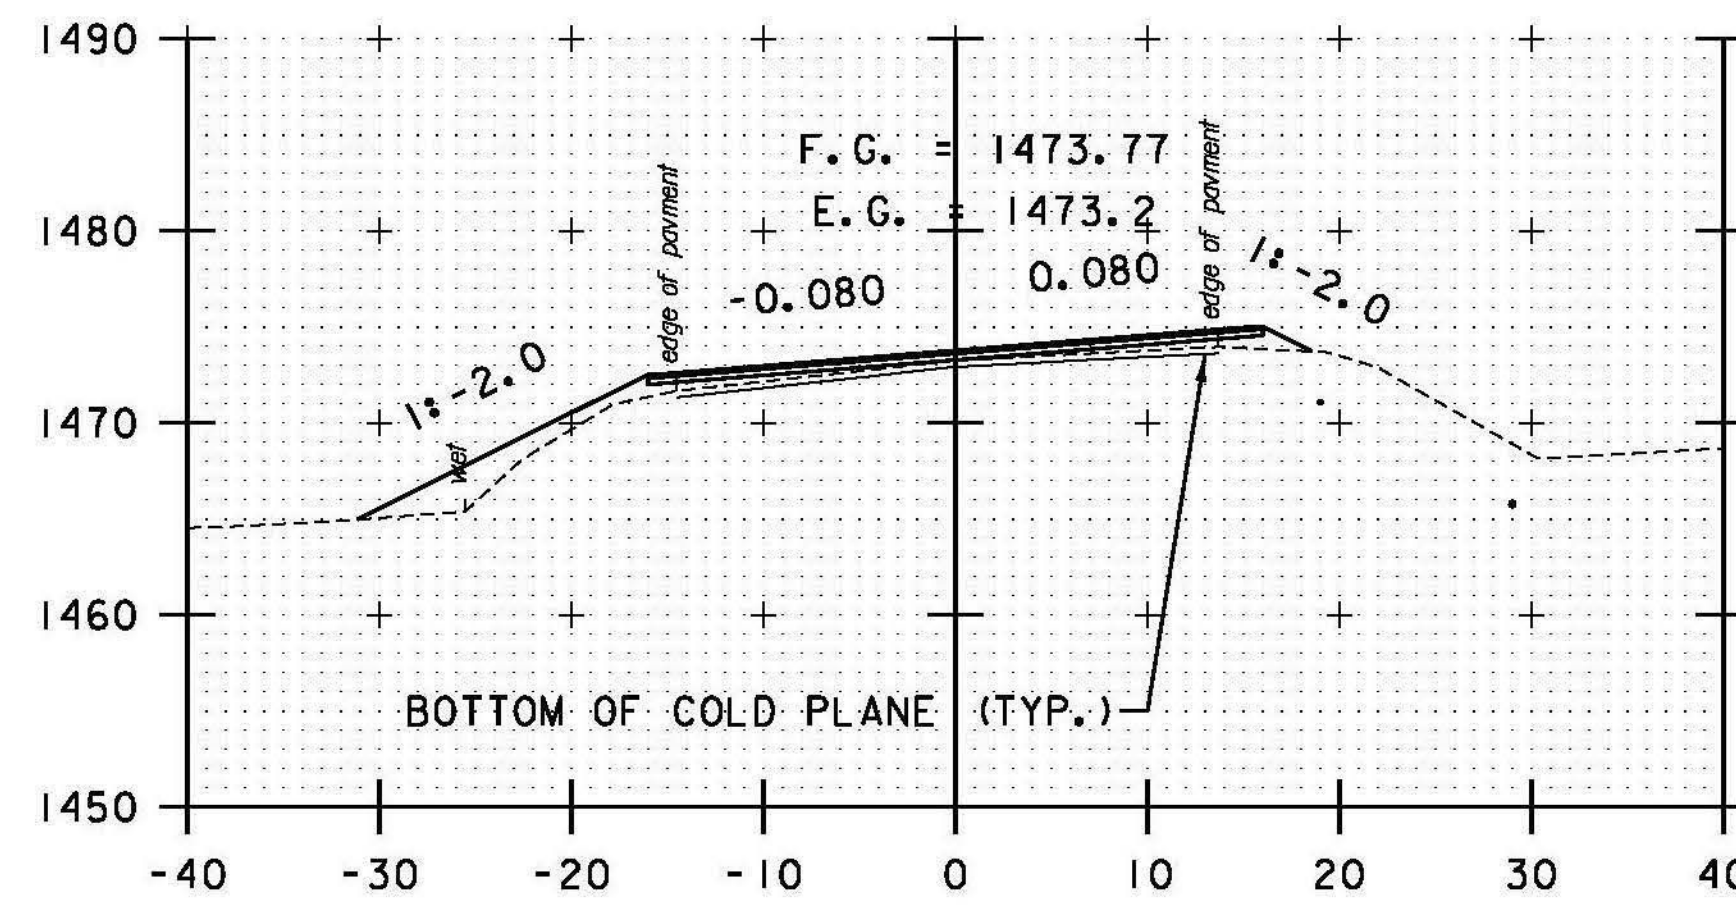


240+50

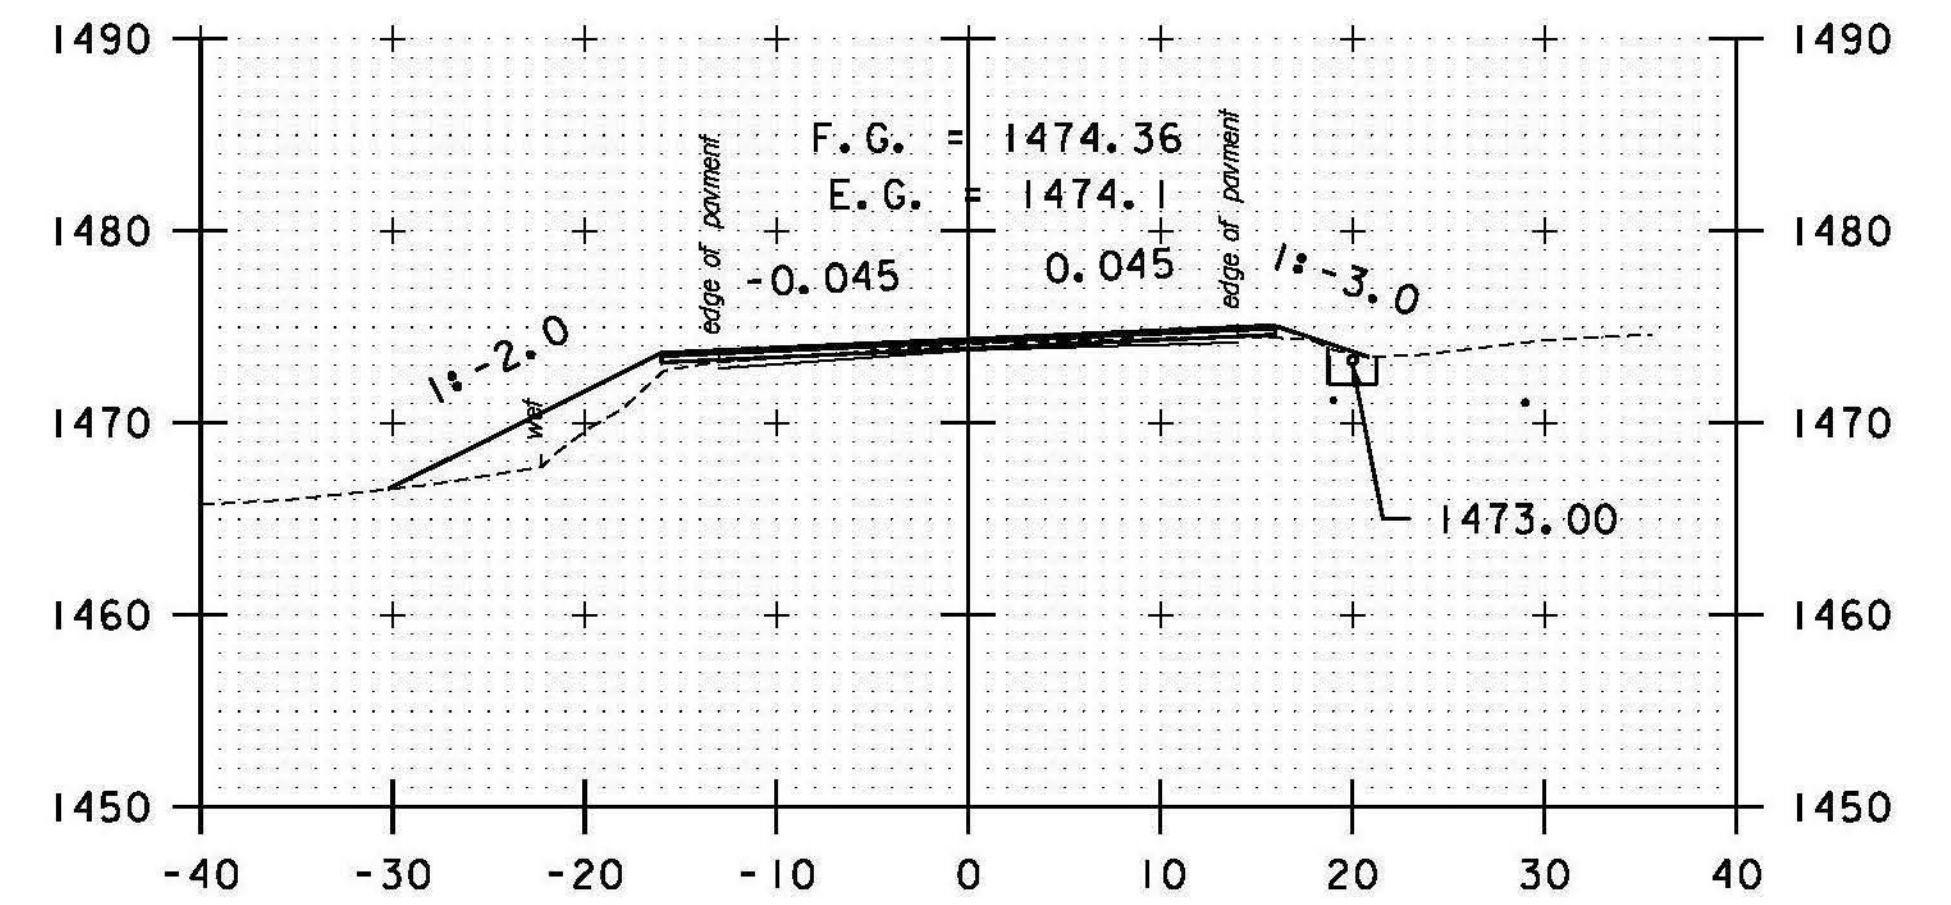


242+00

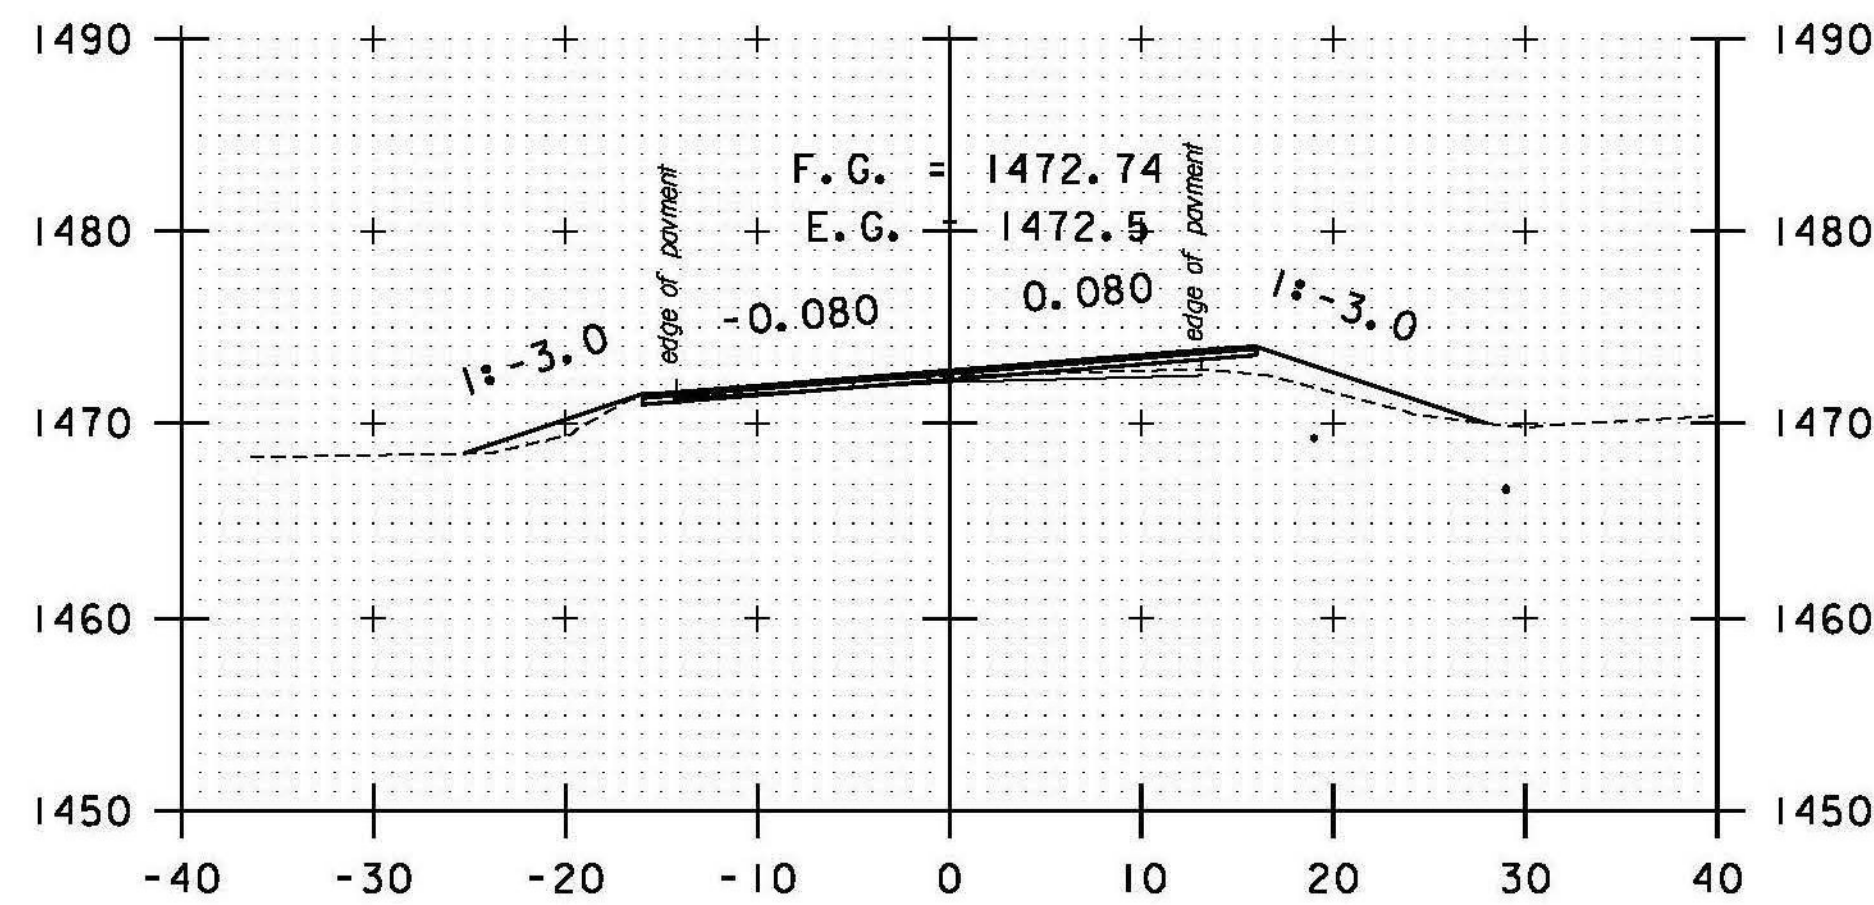


238+50

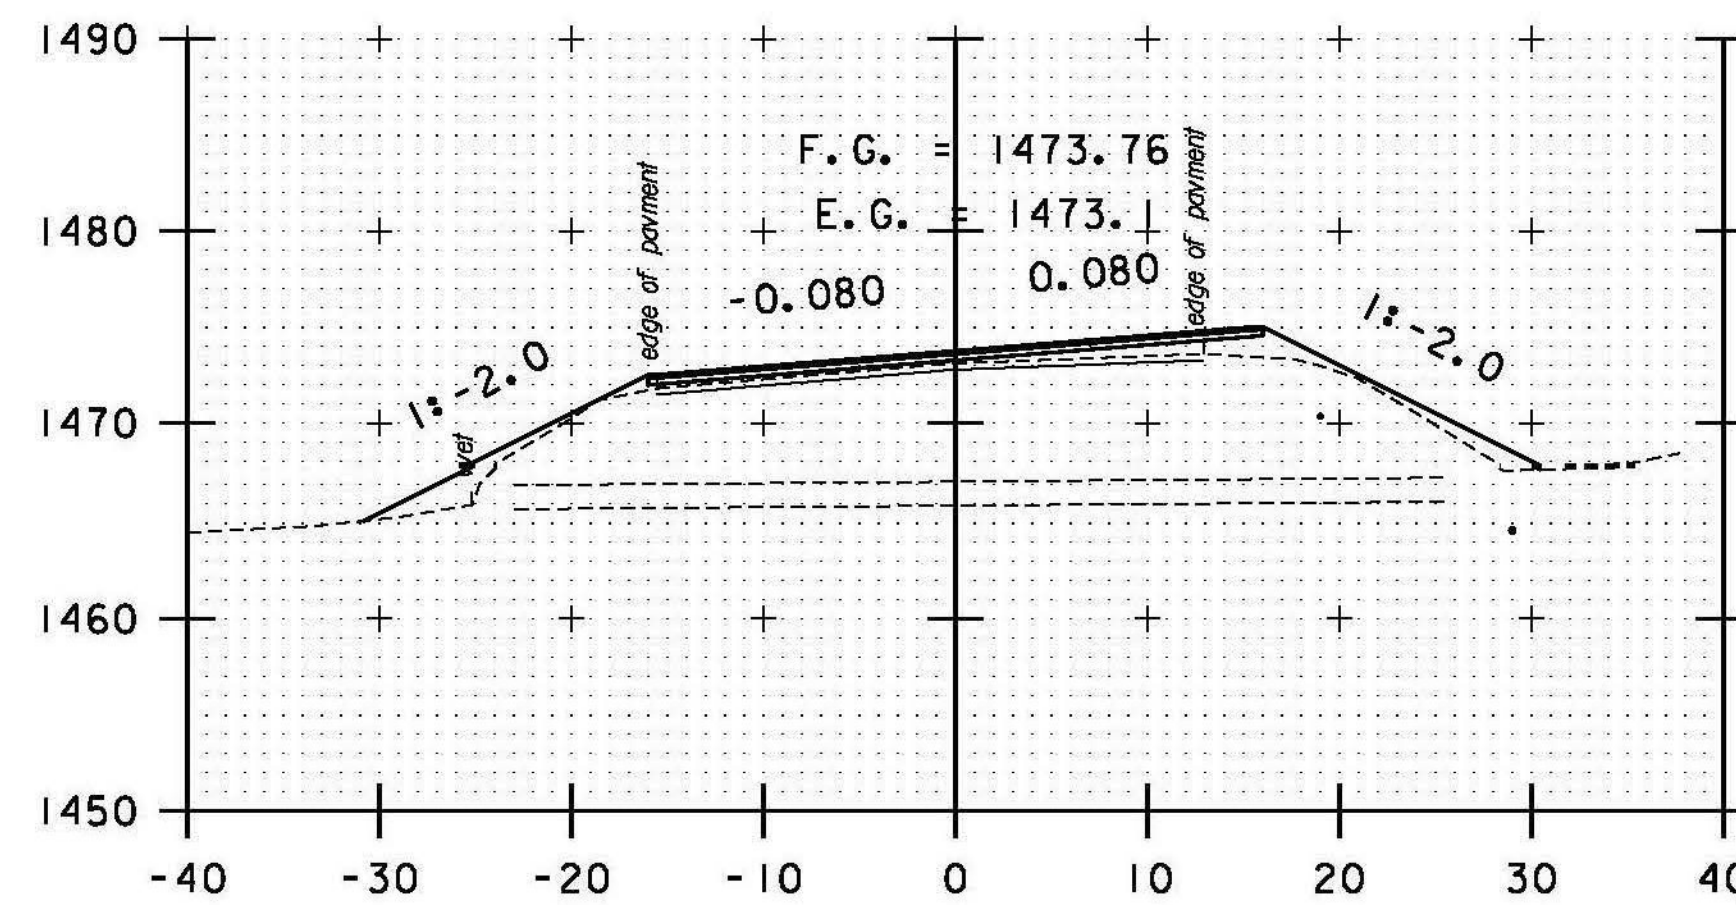


240+00

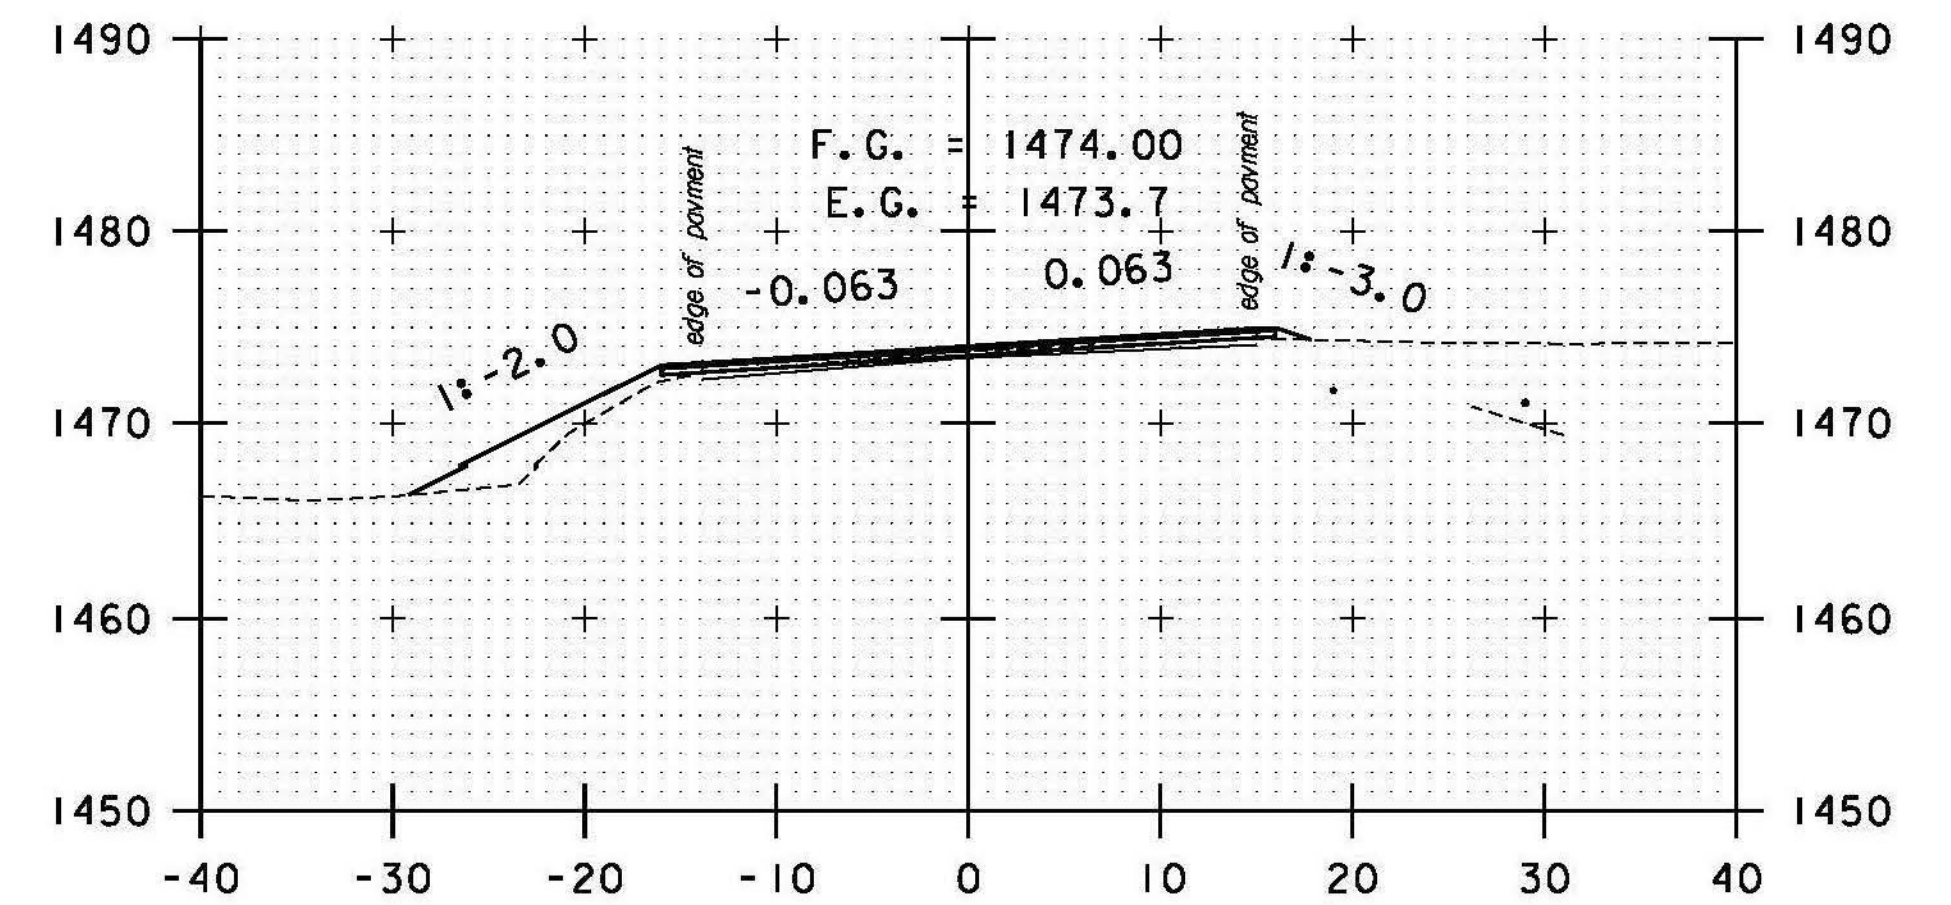


DRIVE RT
241+50

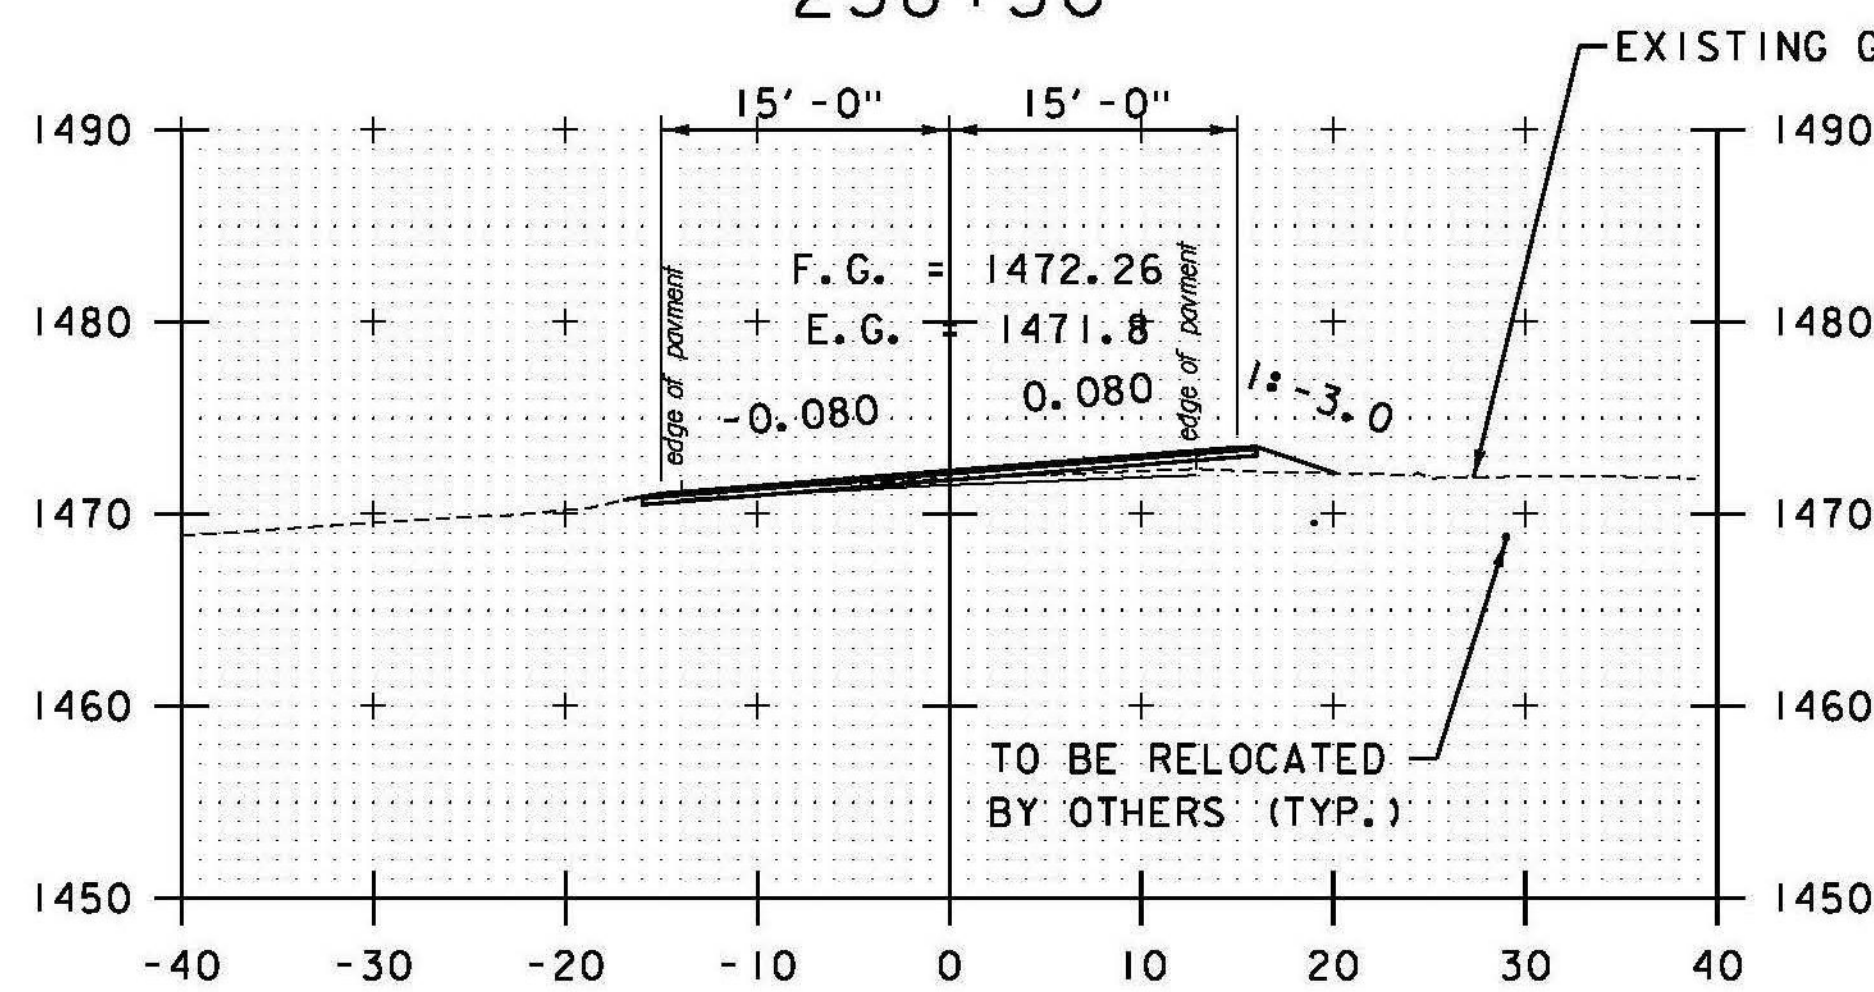

DRIVE LT
238+00

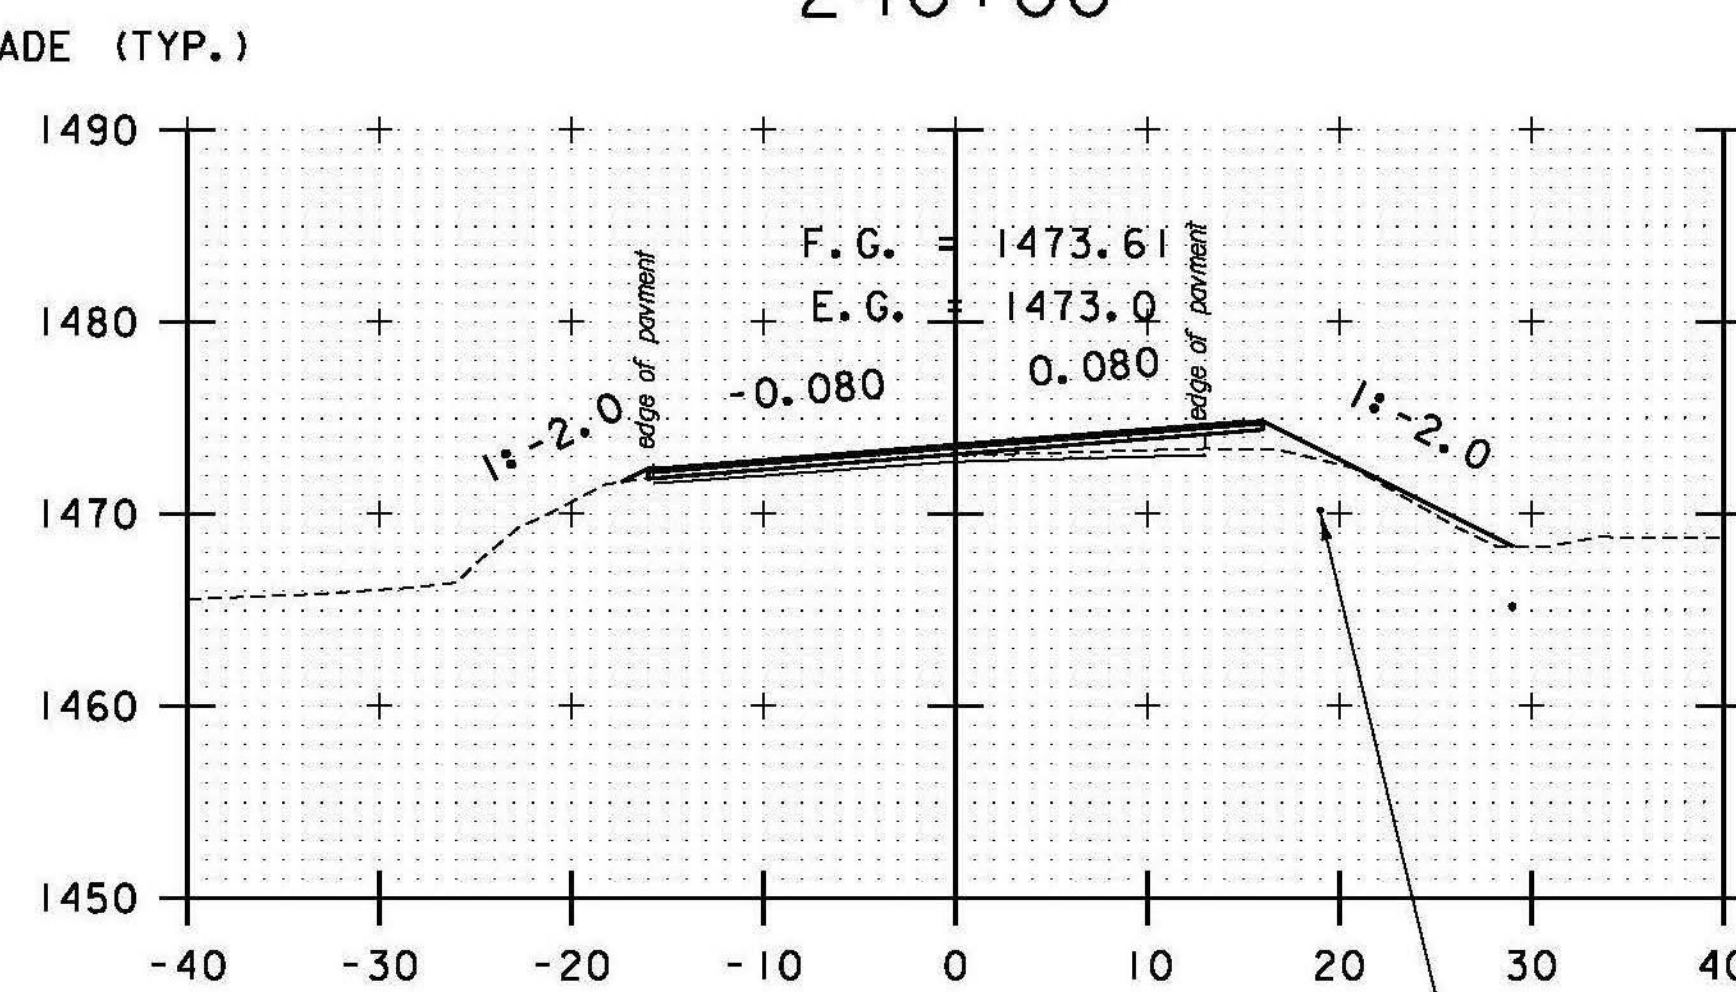


239+50

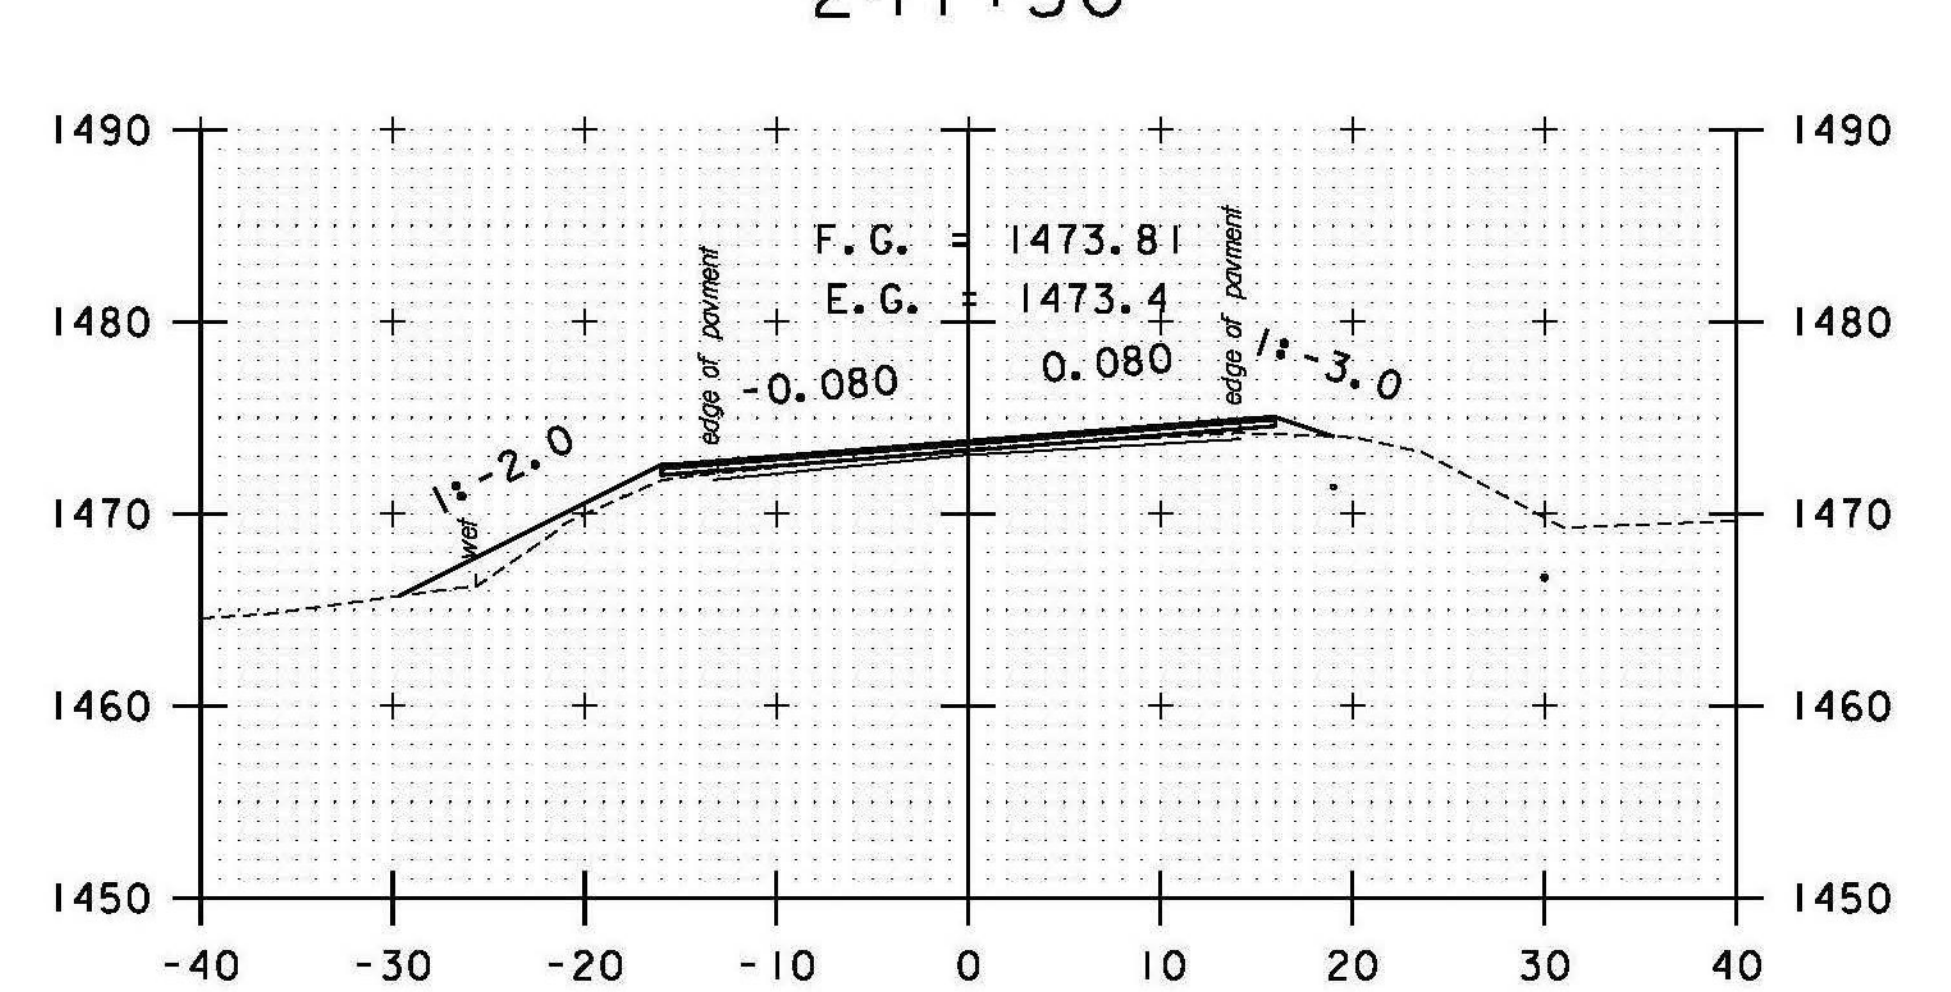

241+00

STA. 238+00 TO STA. 242+00

DATUM
 VERTICAL NAVD 88
 HORIZONTAL NAD 83 (07)

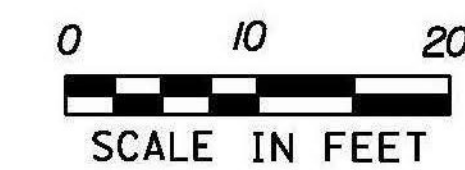

PROJECT NAME: RANDOLPH
 PROJECT NUMBER: STP 2932 (1)

FILE NAME: z10c270.dgn
 PROJECT LEADER: C. LATHROP
 DESIGNED BY: B. BRESLEND
 VT 66 CROSS SECTION SHEET 49

PLOT DATE: 6/5/2014
 DRAWN BY: B. BRESLEND
 CHECKED BY: C. LATHROP
 SHEET 205 OF 276