




243+50

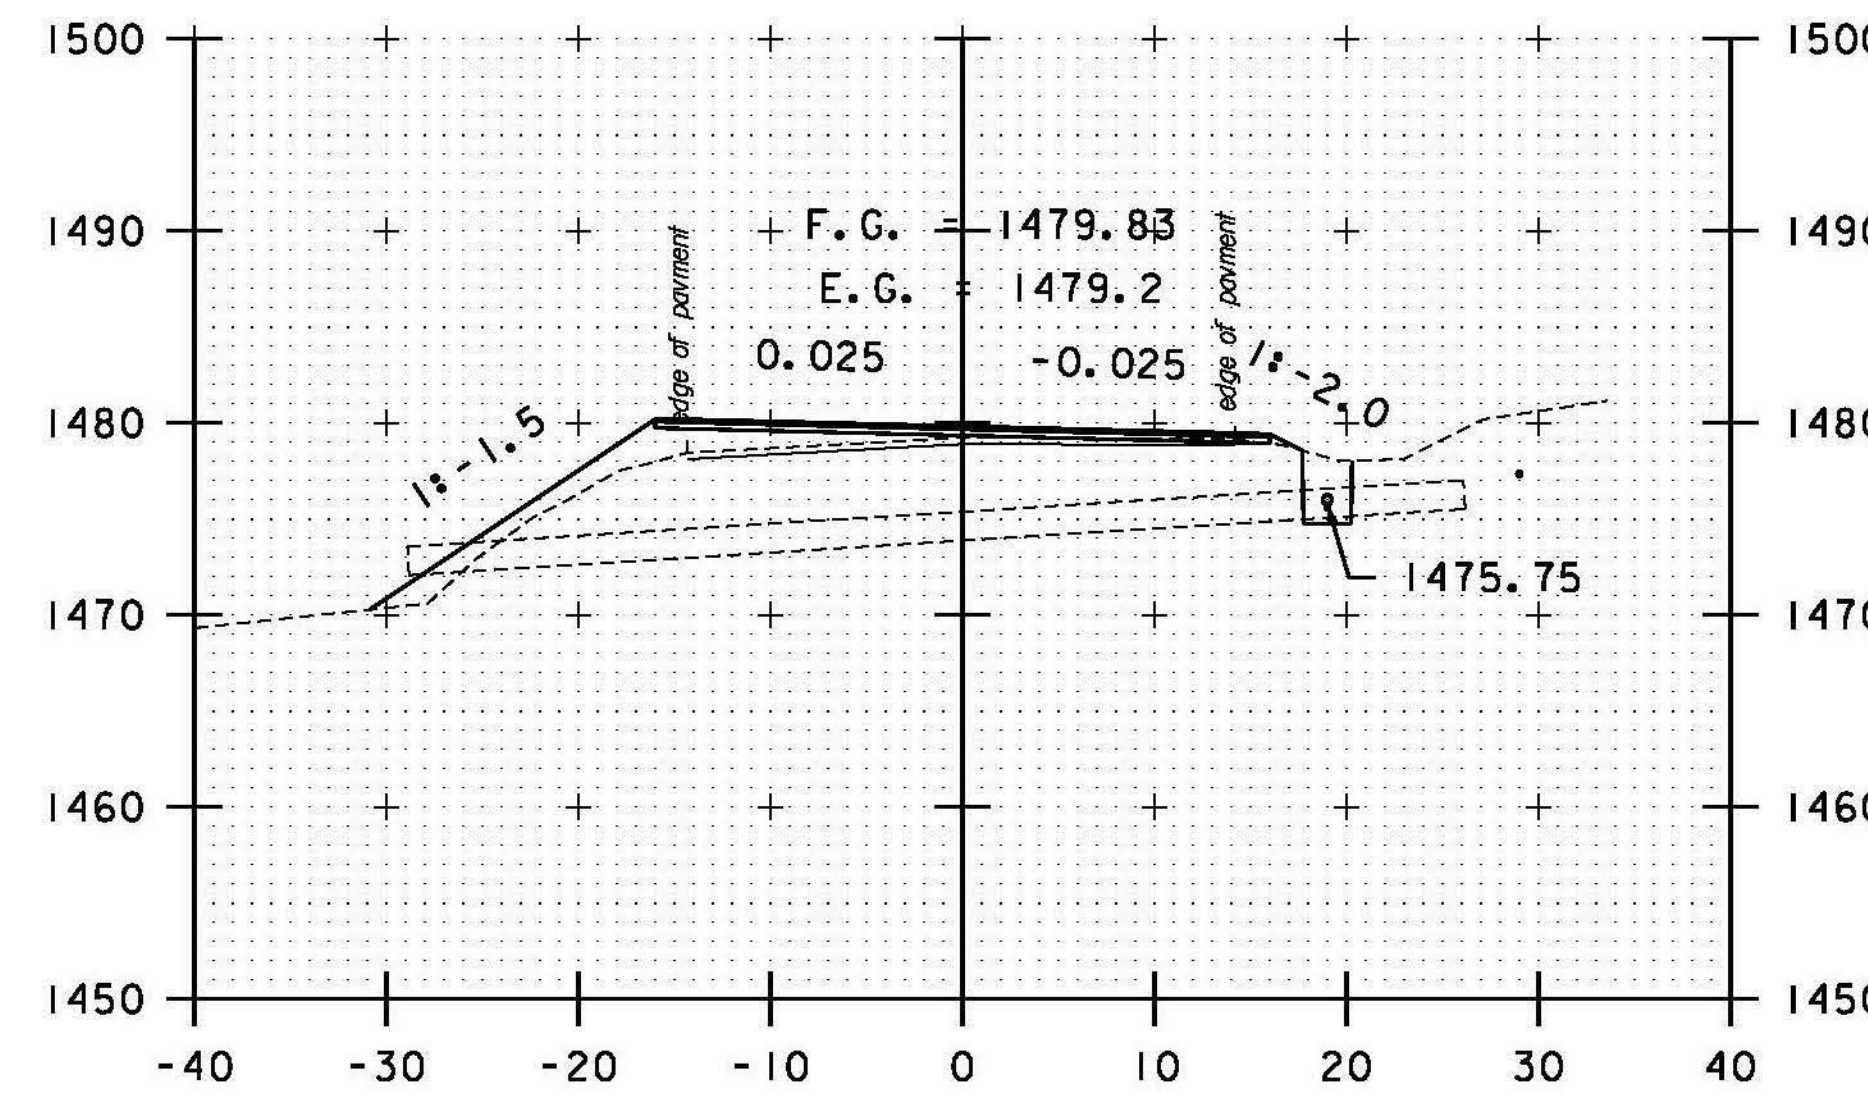


245+00

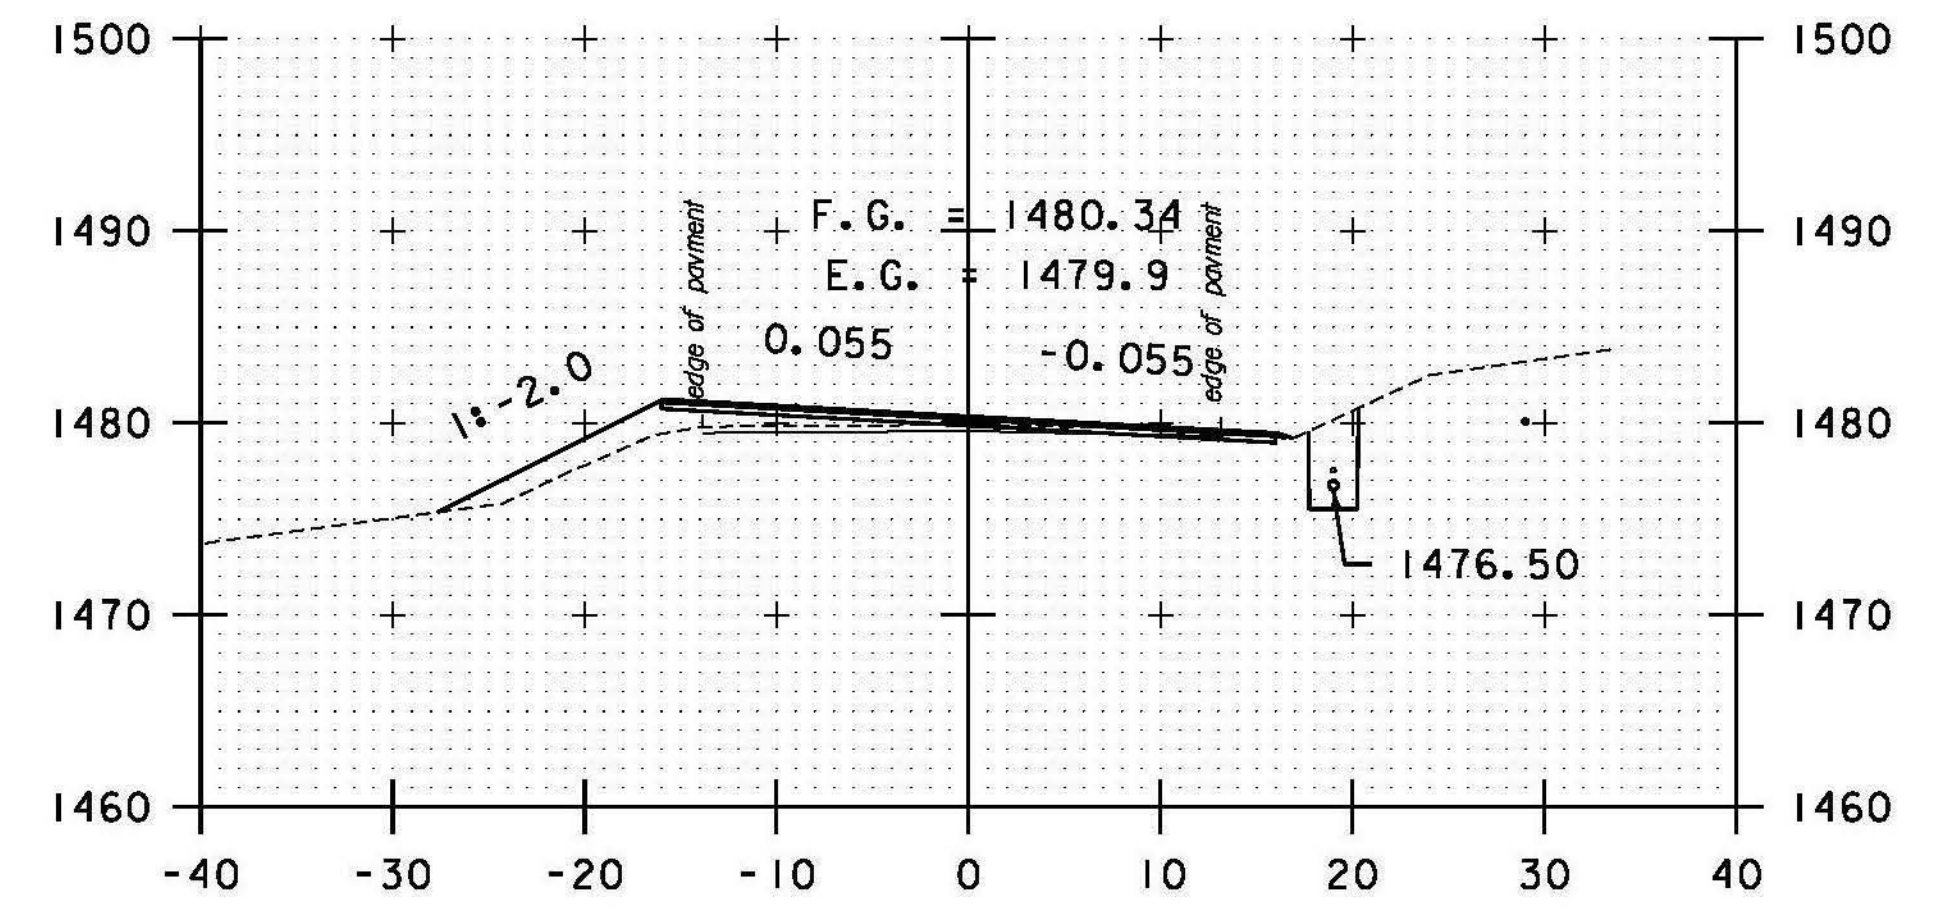


246+50

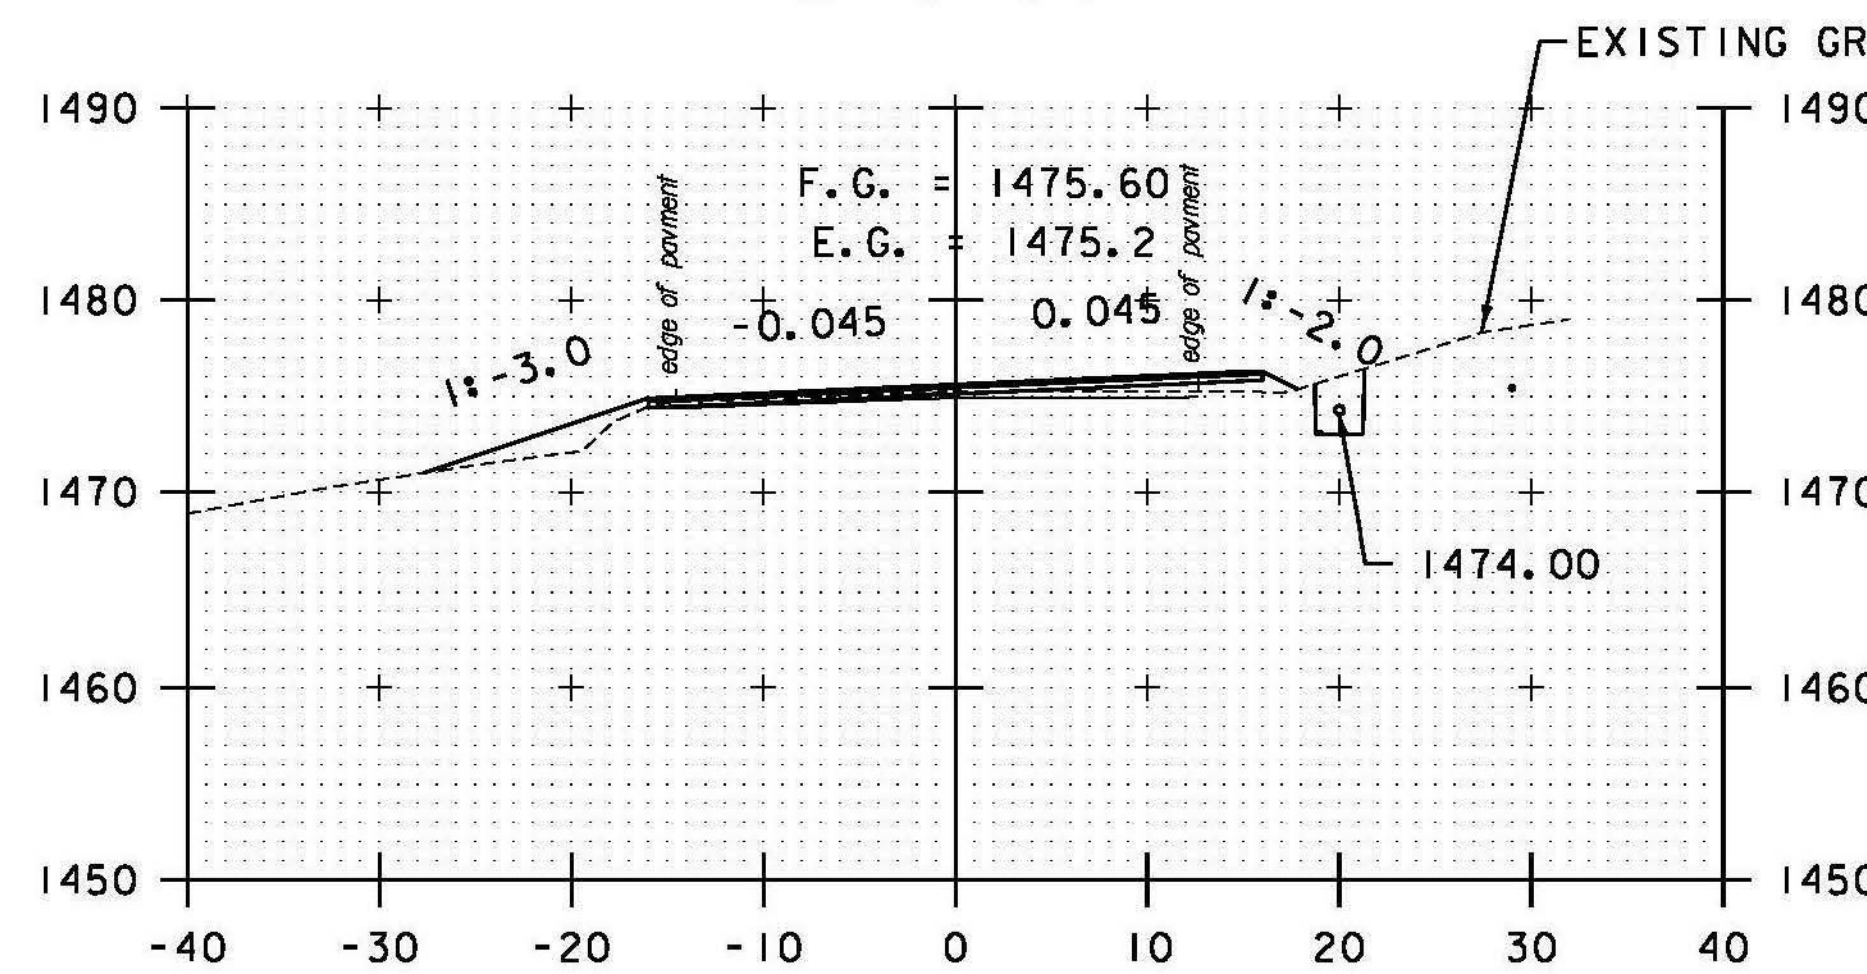


243+00

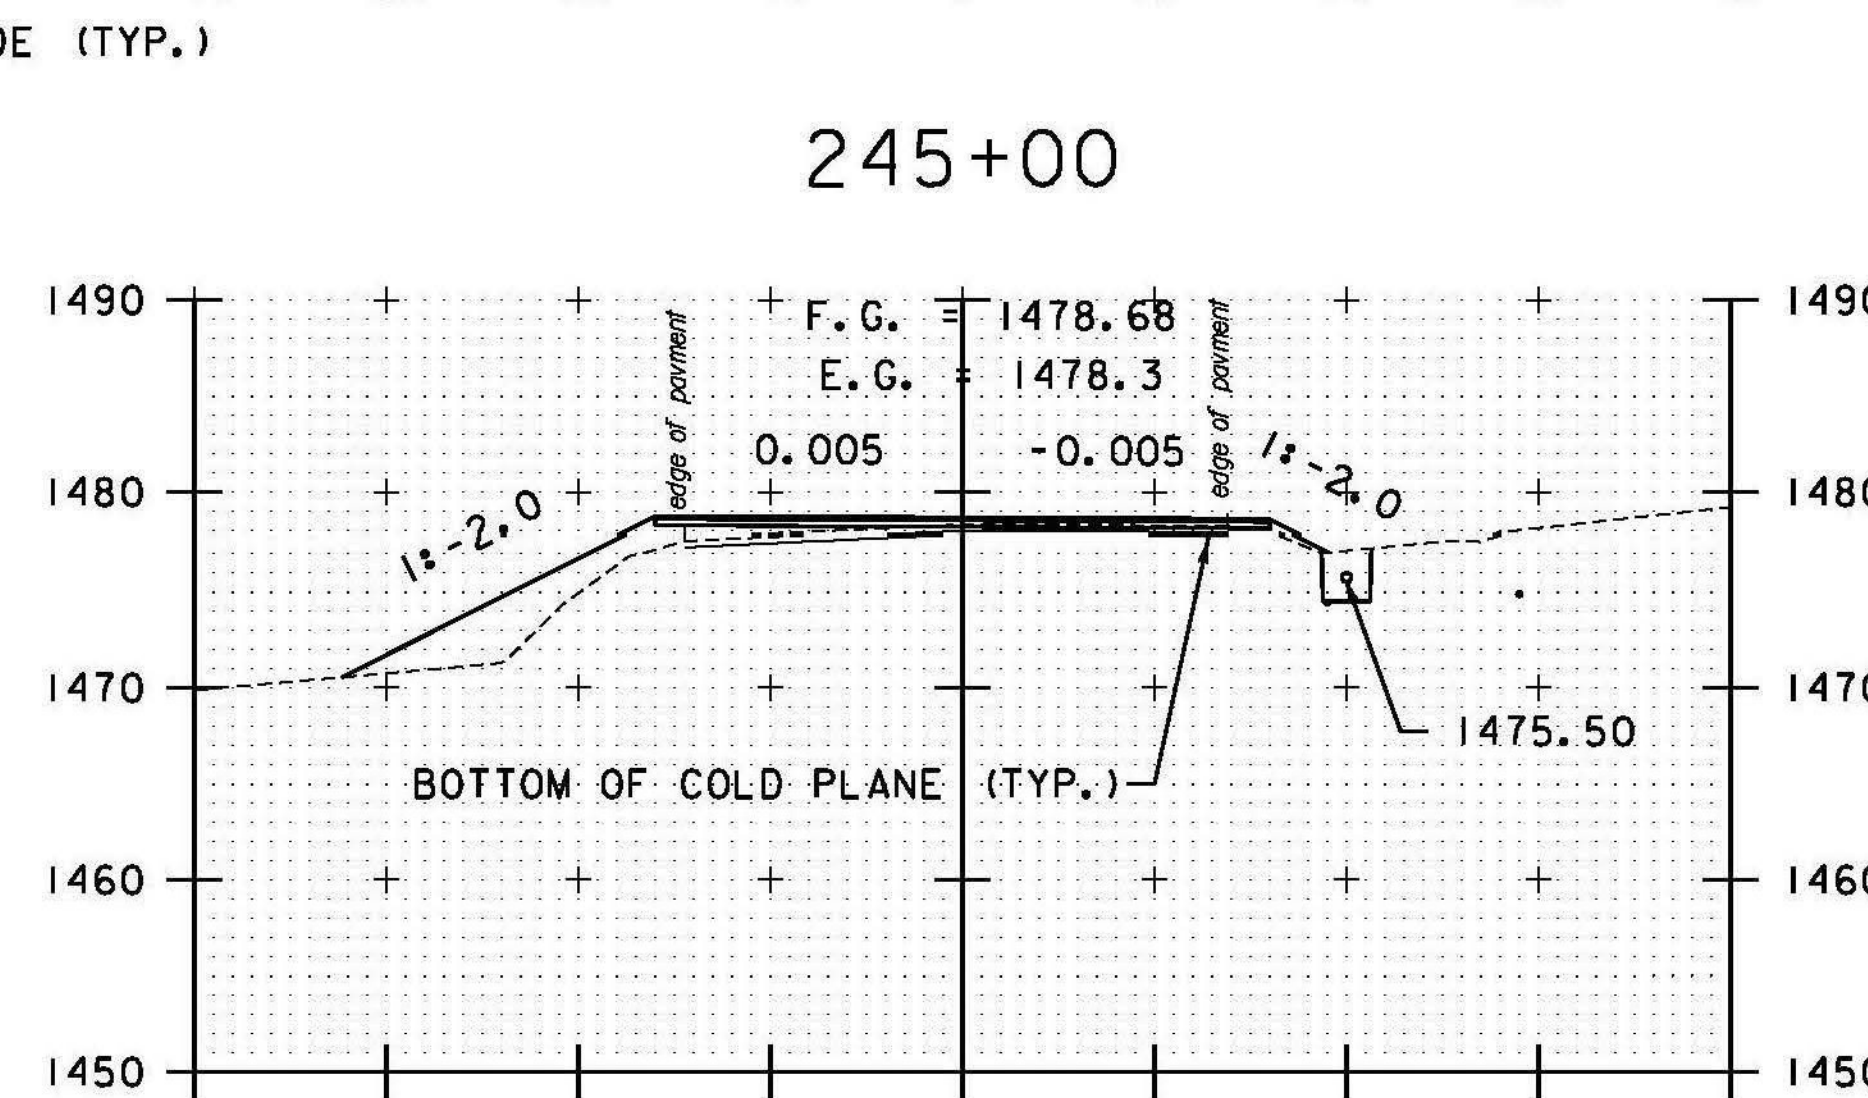


244+50

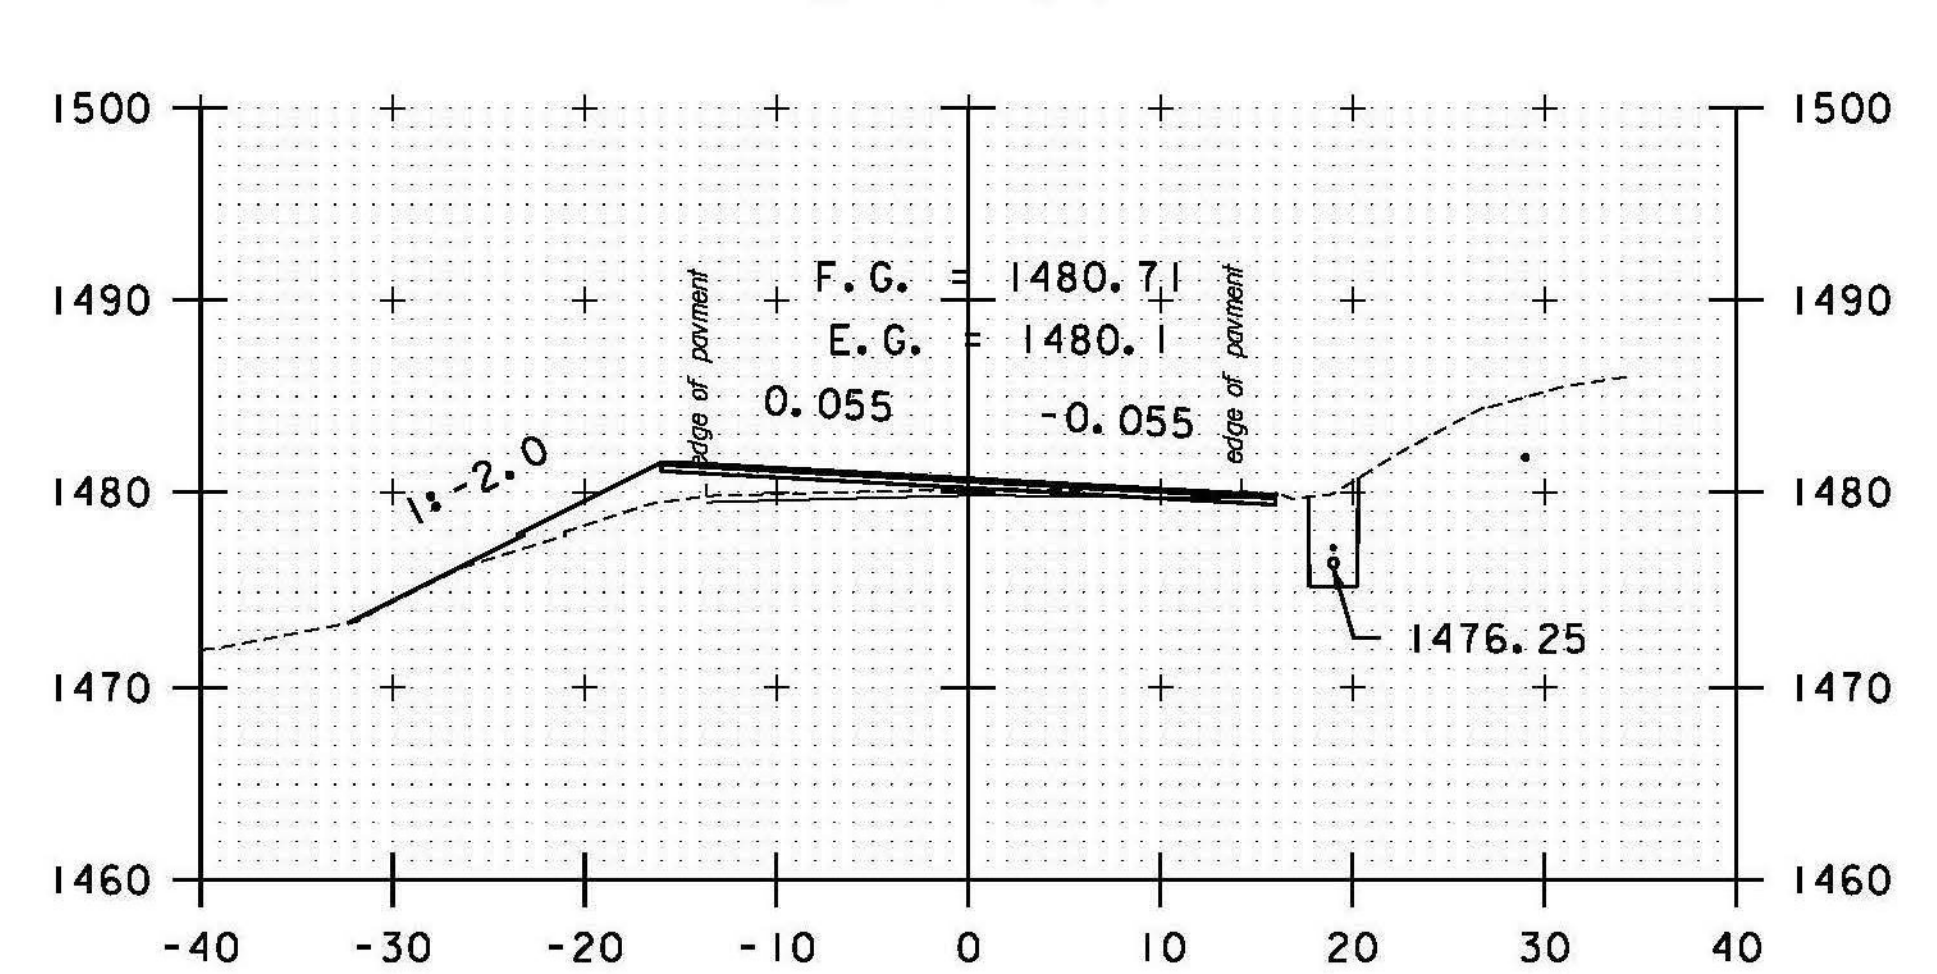


246+00

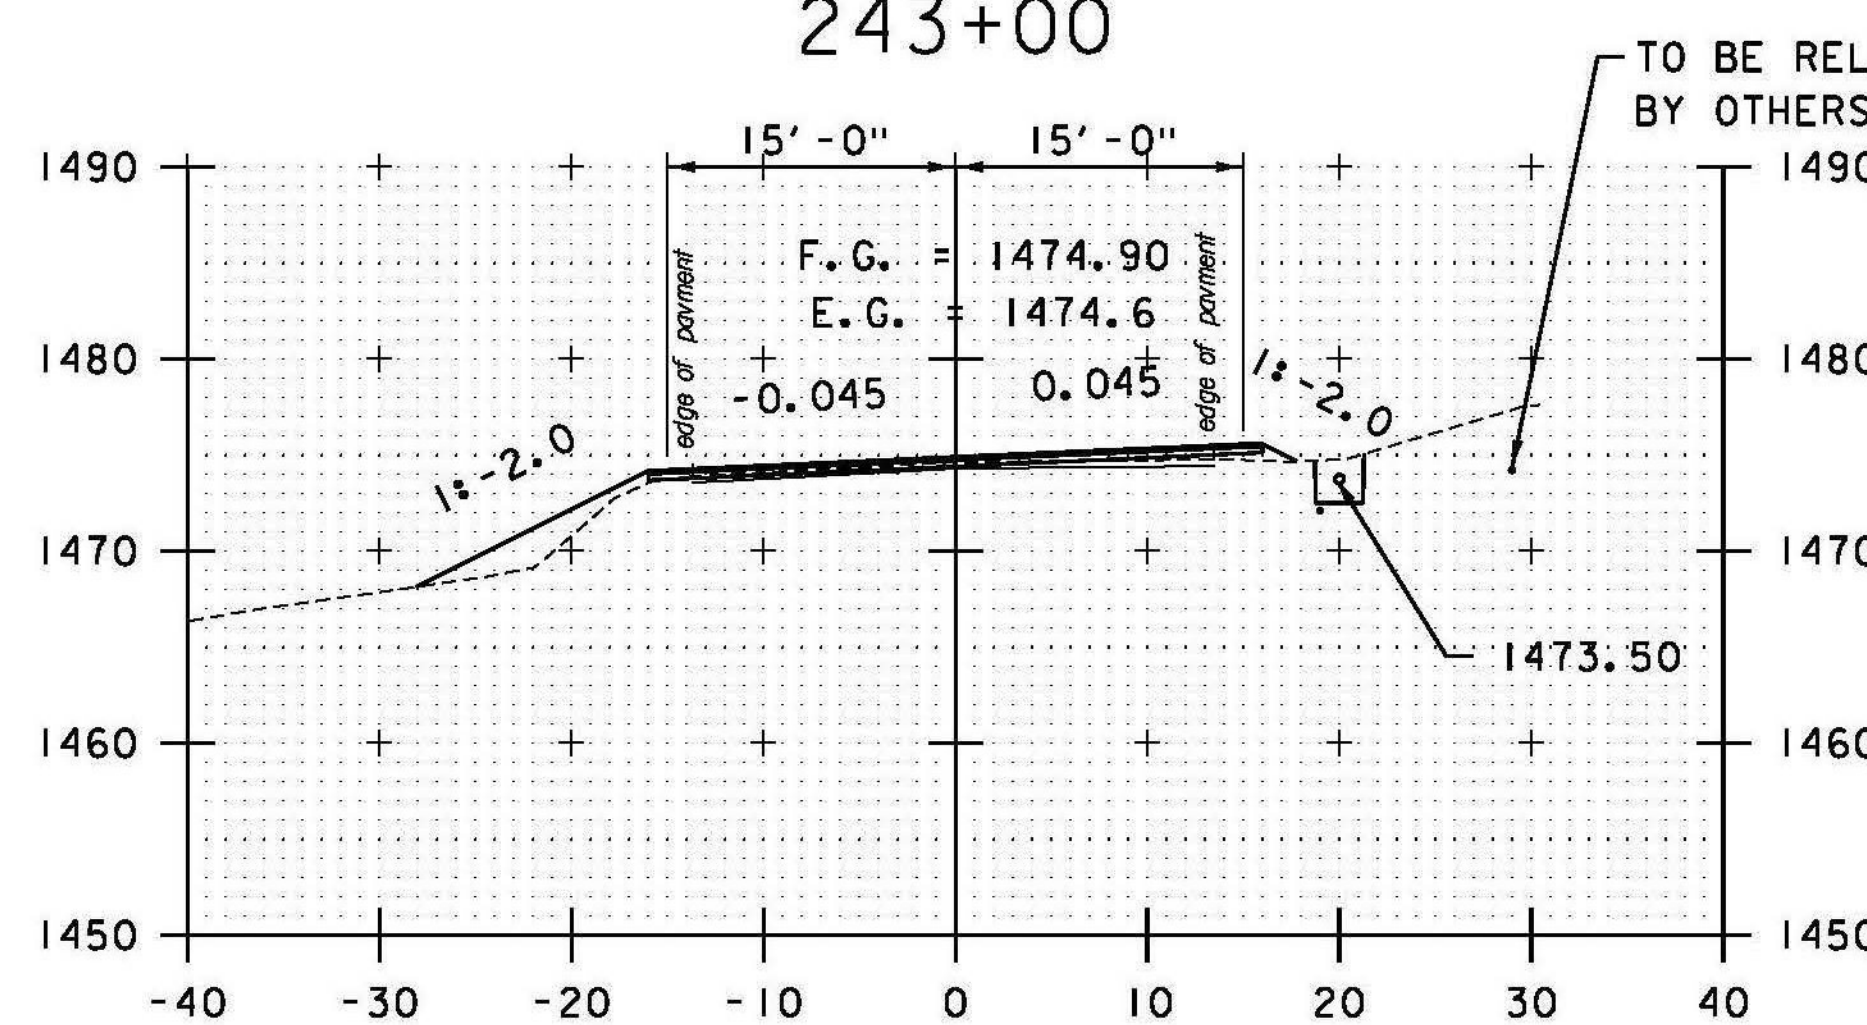

242+50

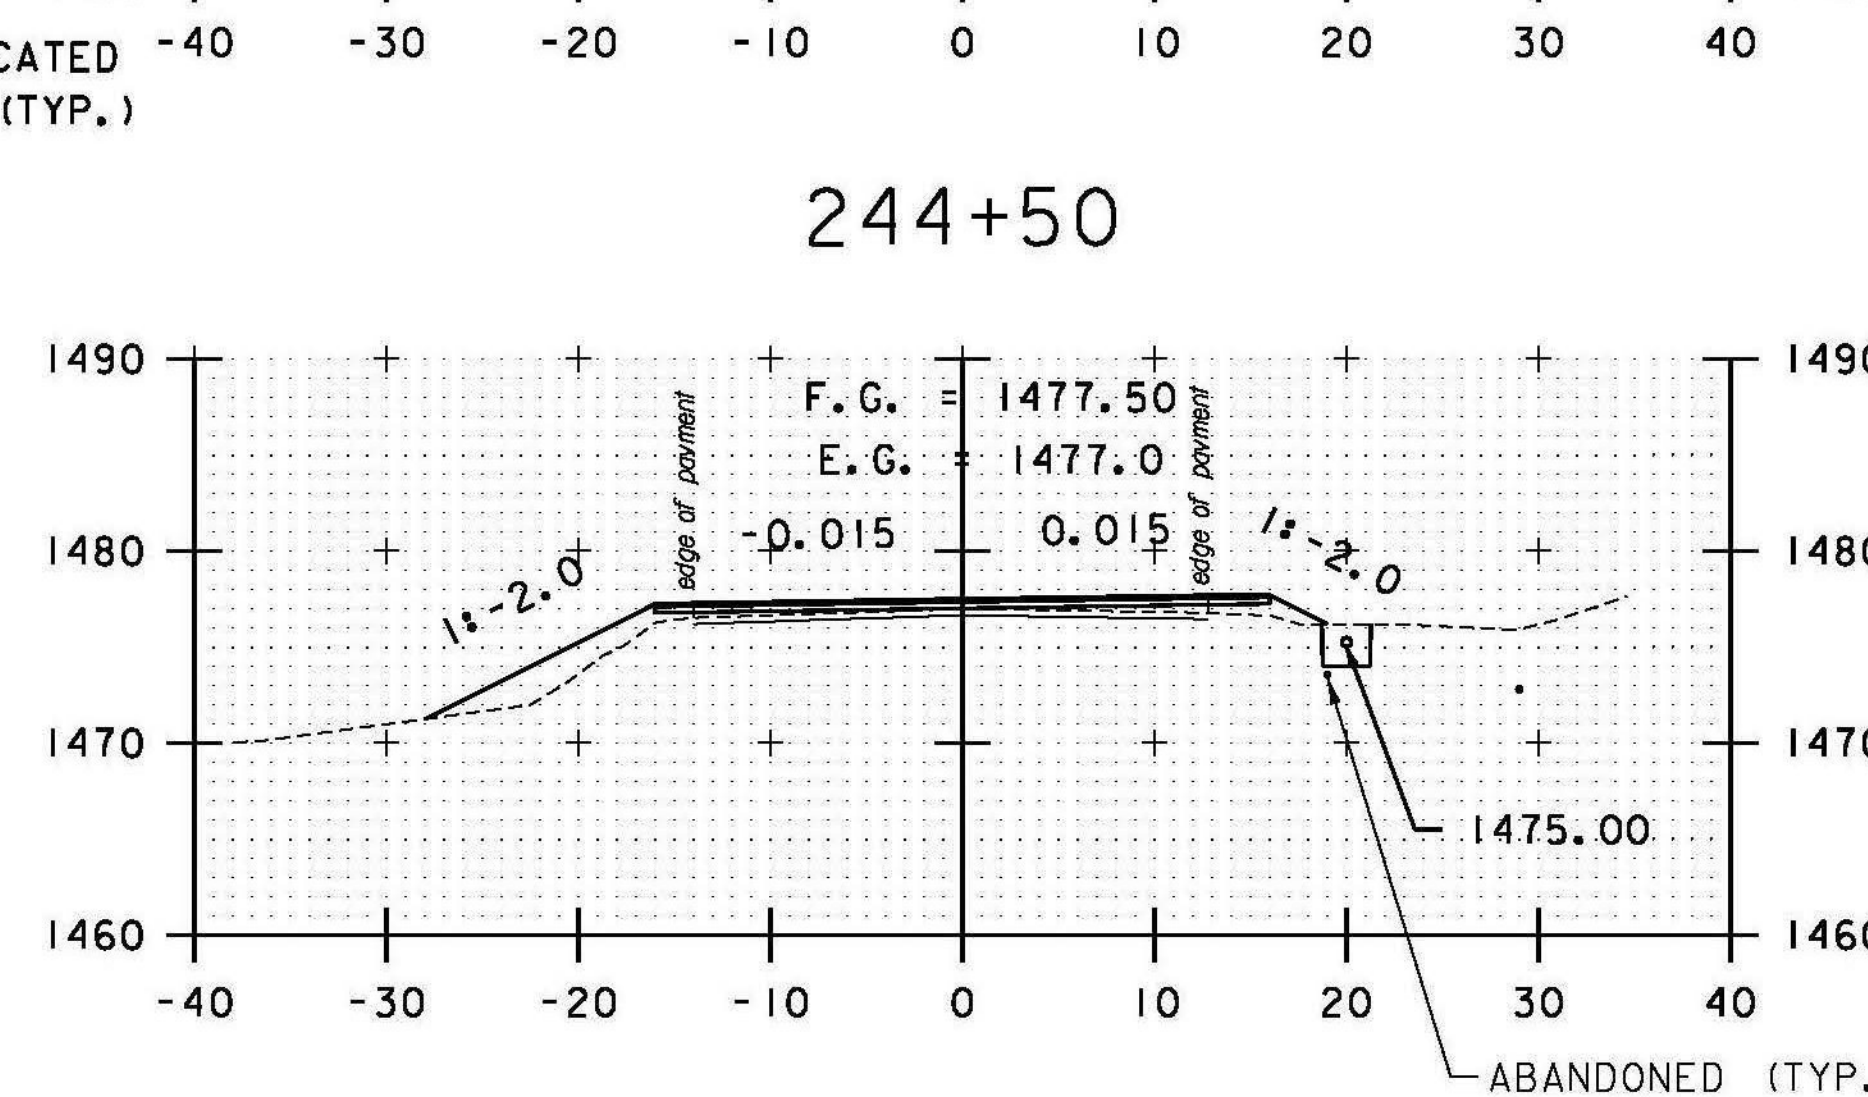


244+00

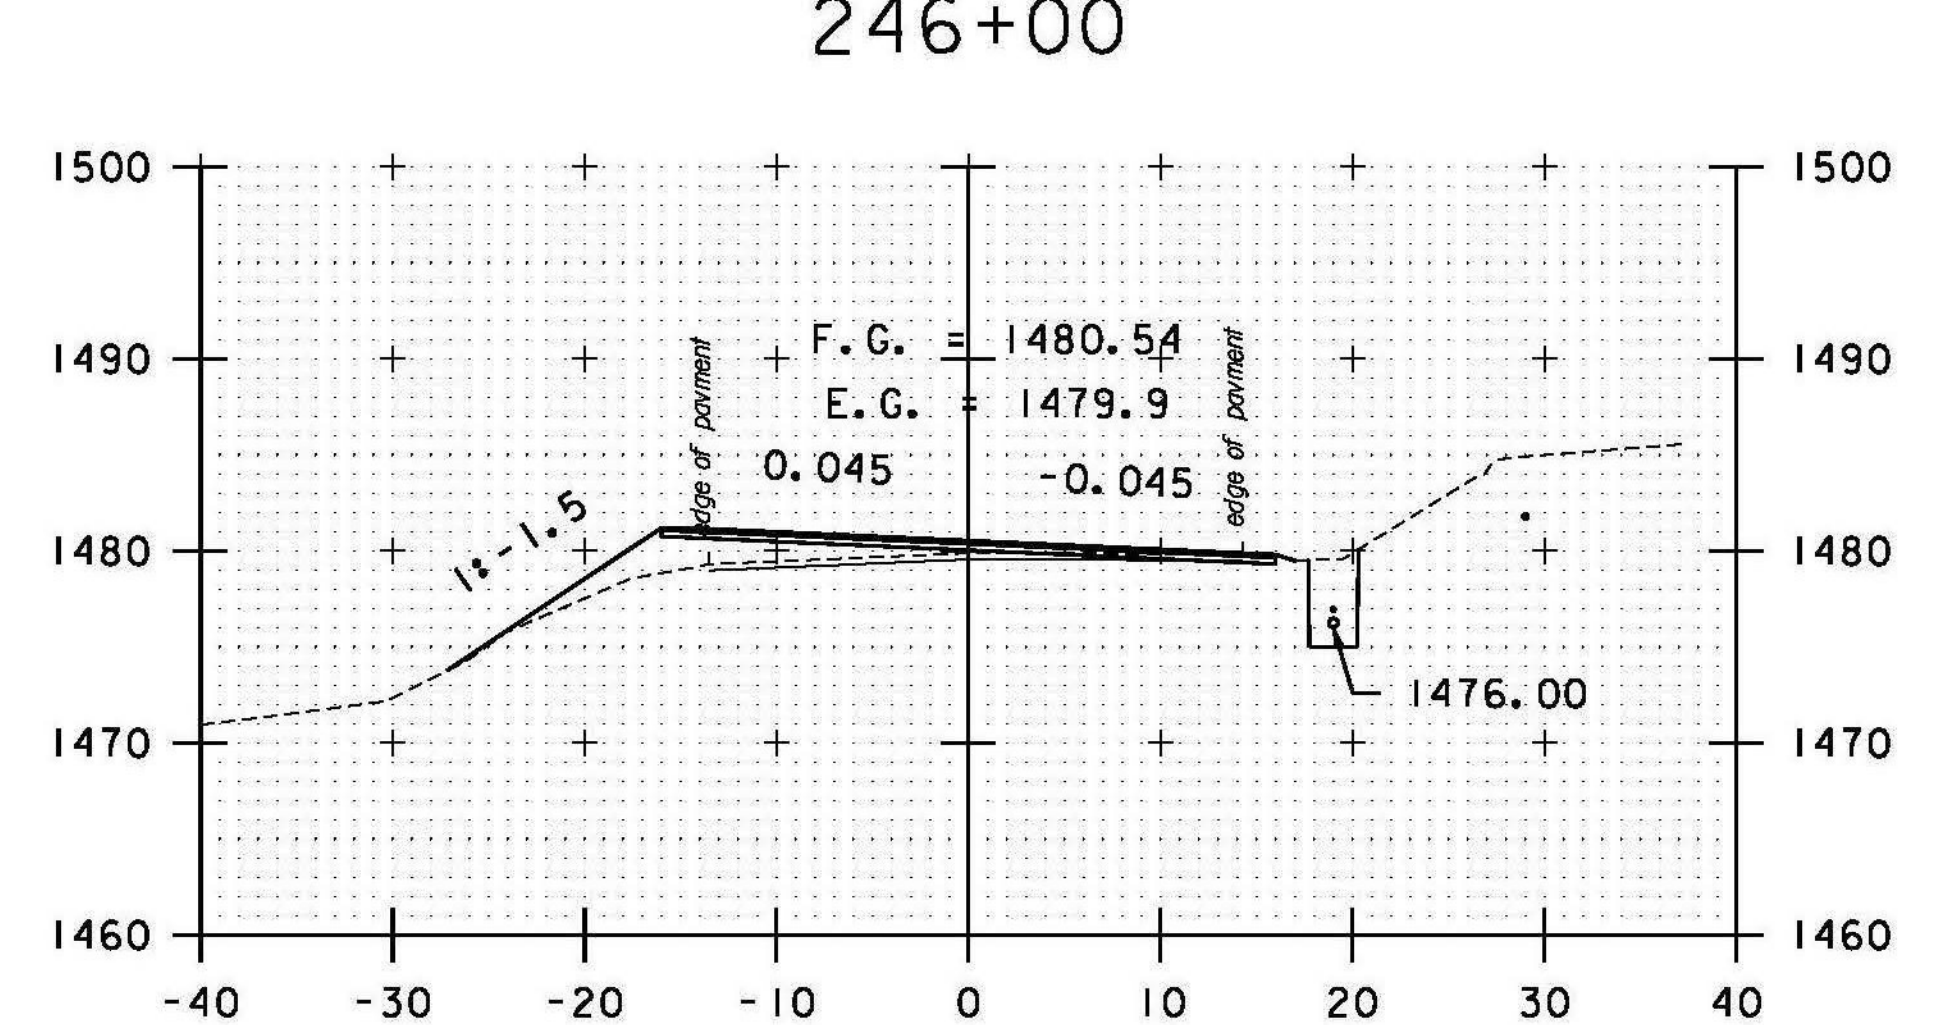

245+50

STA. 242+50 TO STA. 246+50

DATUM
 VERTICAL NAVD 88
 HORIZONTAL NAD 83 (07)

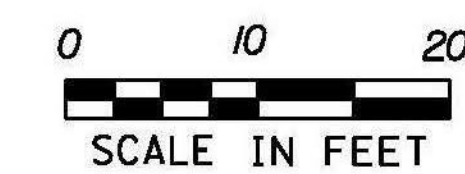

PROJECT NAME: RANDOLPH
 PROJECT NUMBER: STP 2932 (1)

FILE NAME: z10c270.dgn
 PROJECT LEADER: C. LATHROP
 DESIGNED BY: B. BRESLEND
 VT 66 CROSS SECTION SHEET 50

PLOT DATE: 6/5/2014
 DRAWN BY: B. BRESLEND
 CHECKED BY: C. LATHROP
 SHEET 206 OF 276