




321+50

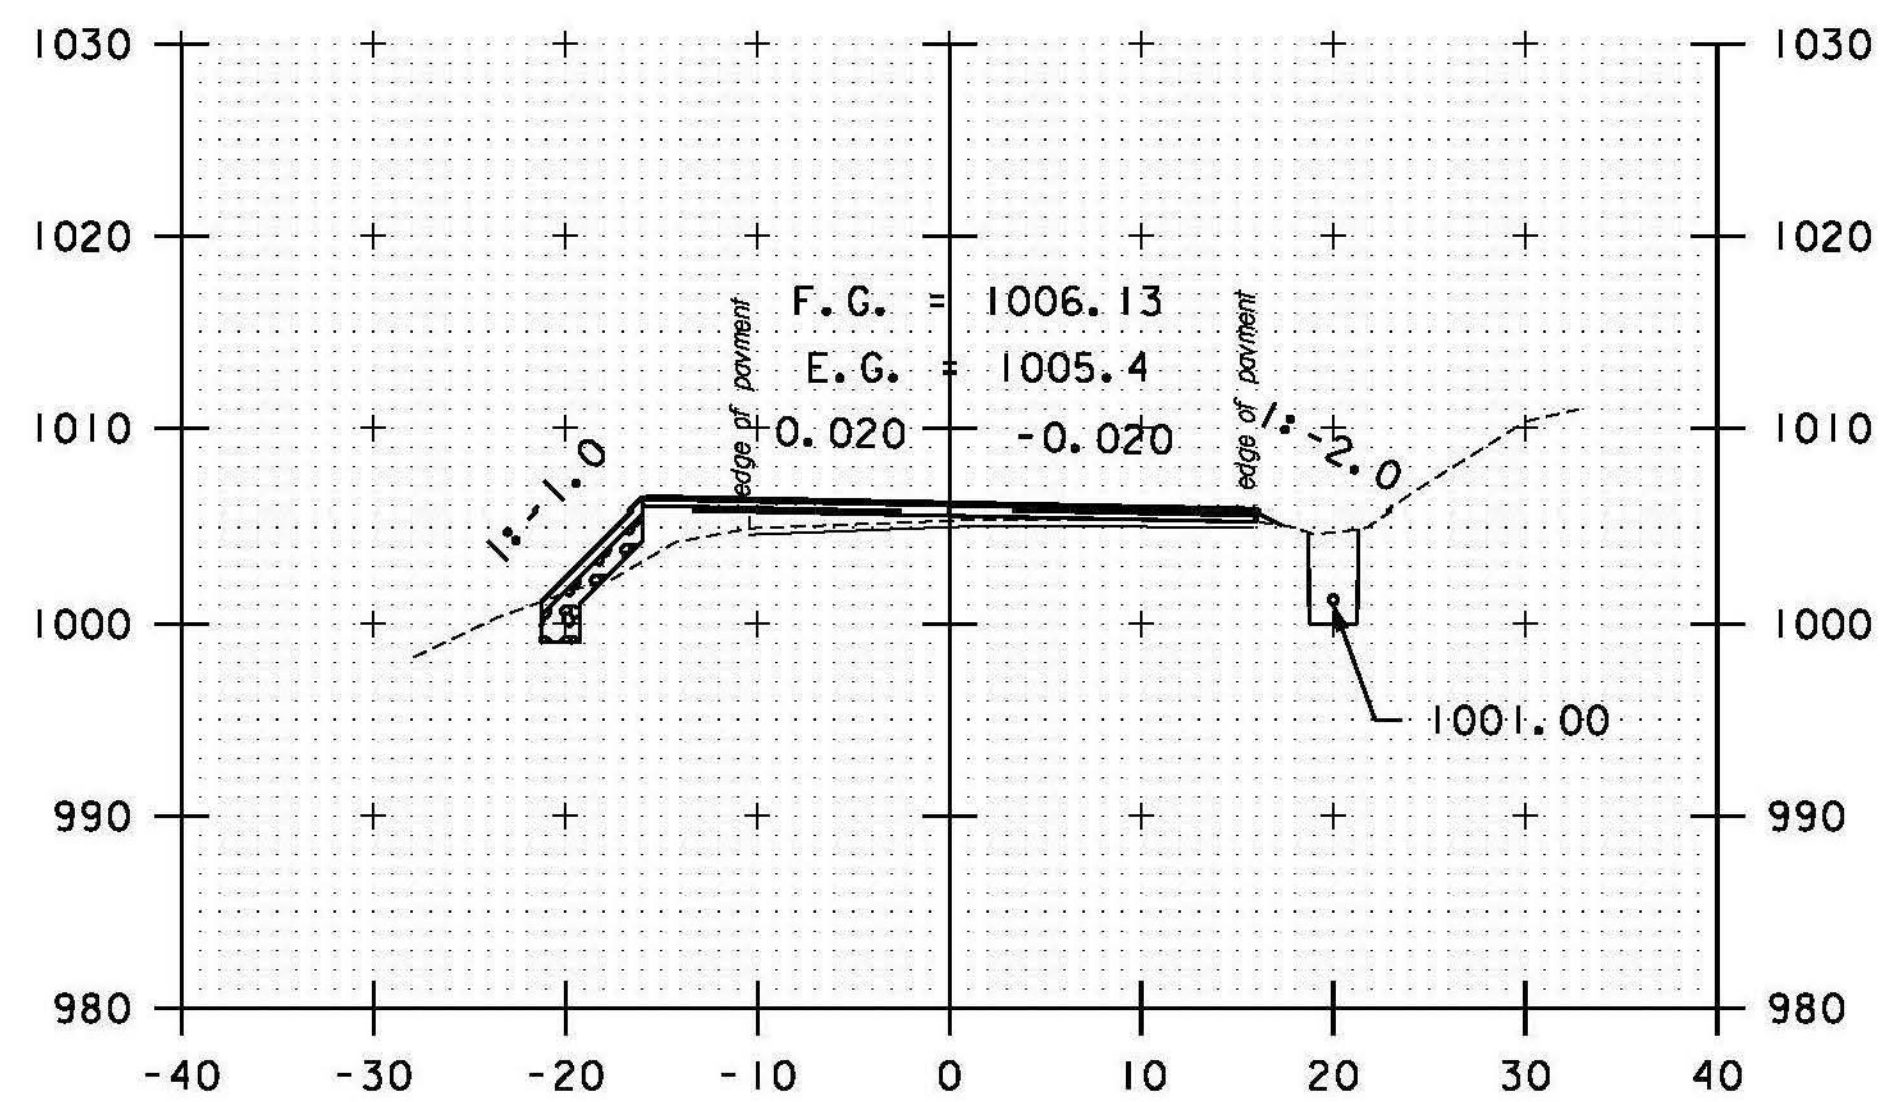


321+00

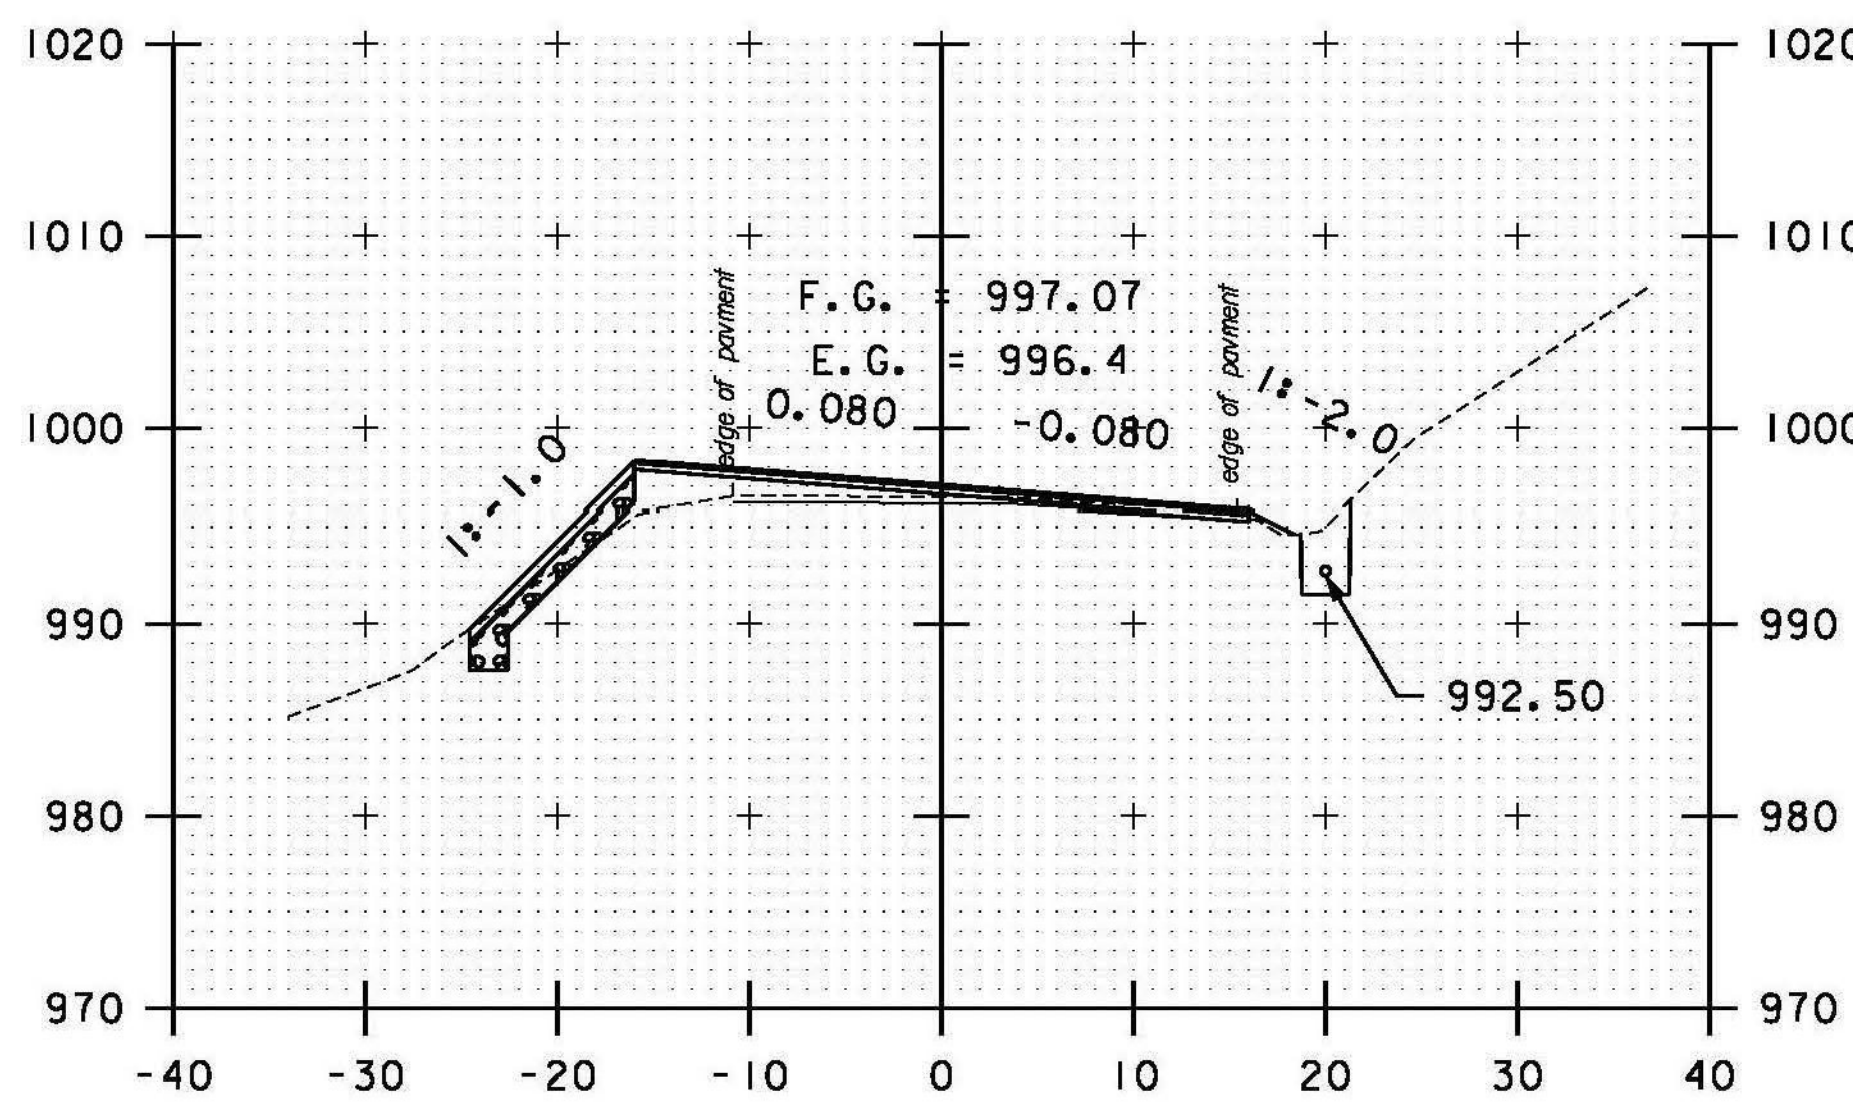


322+50

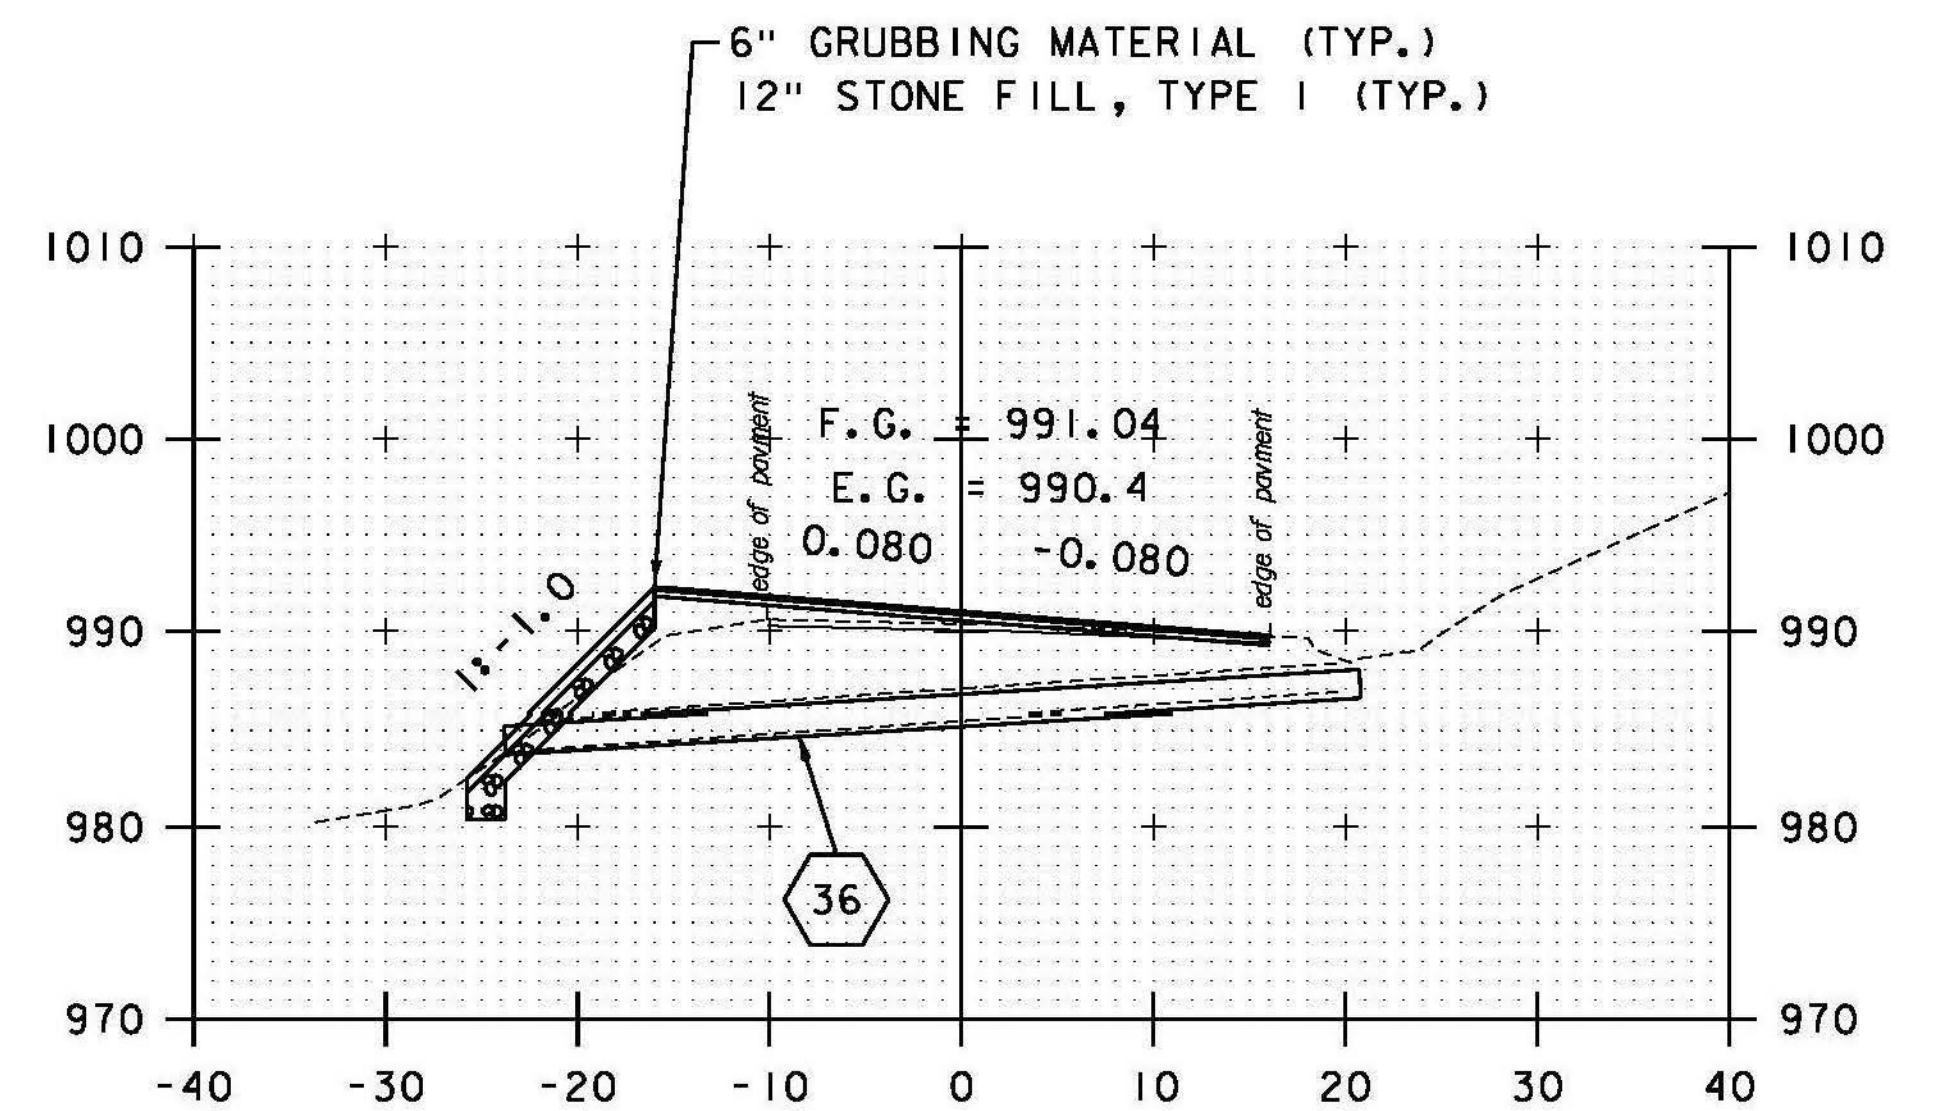


323+50

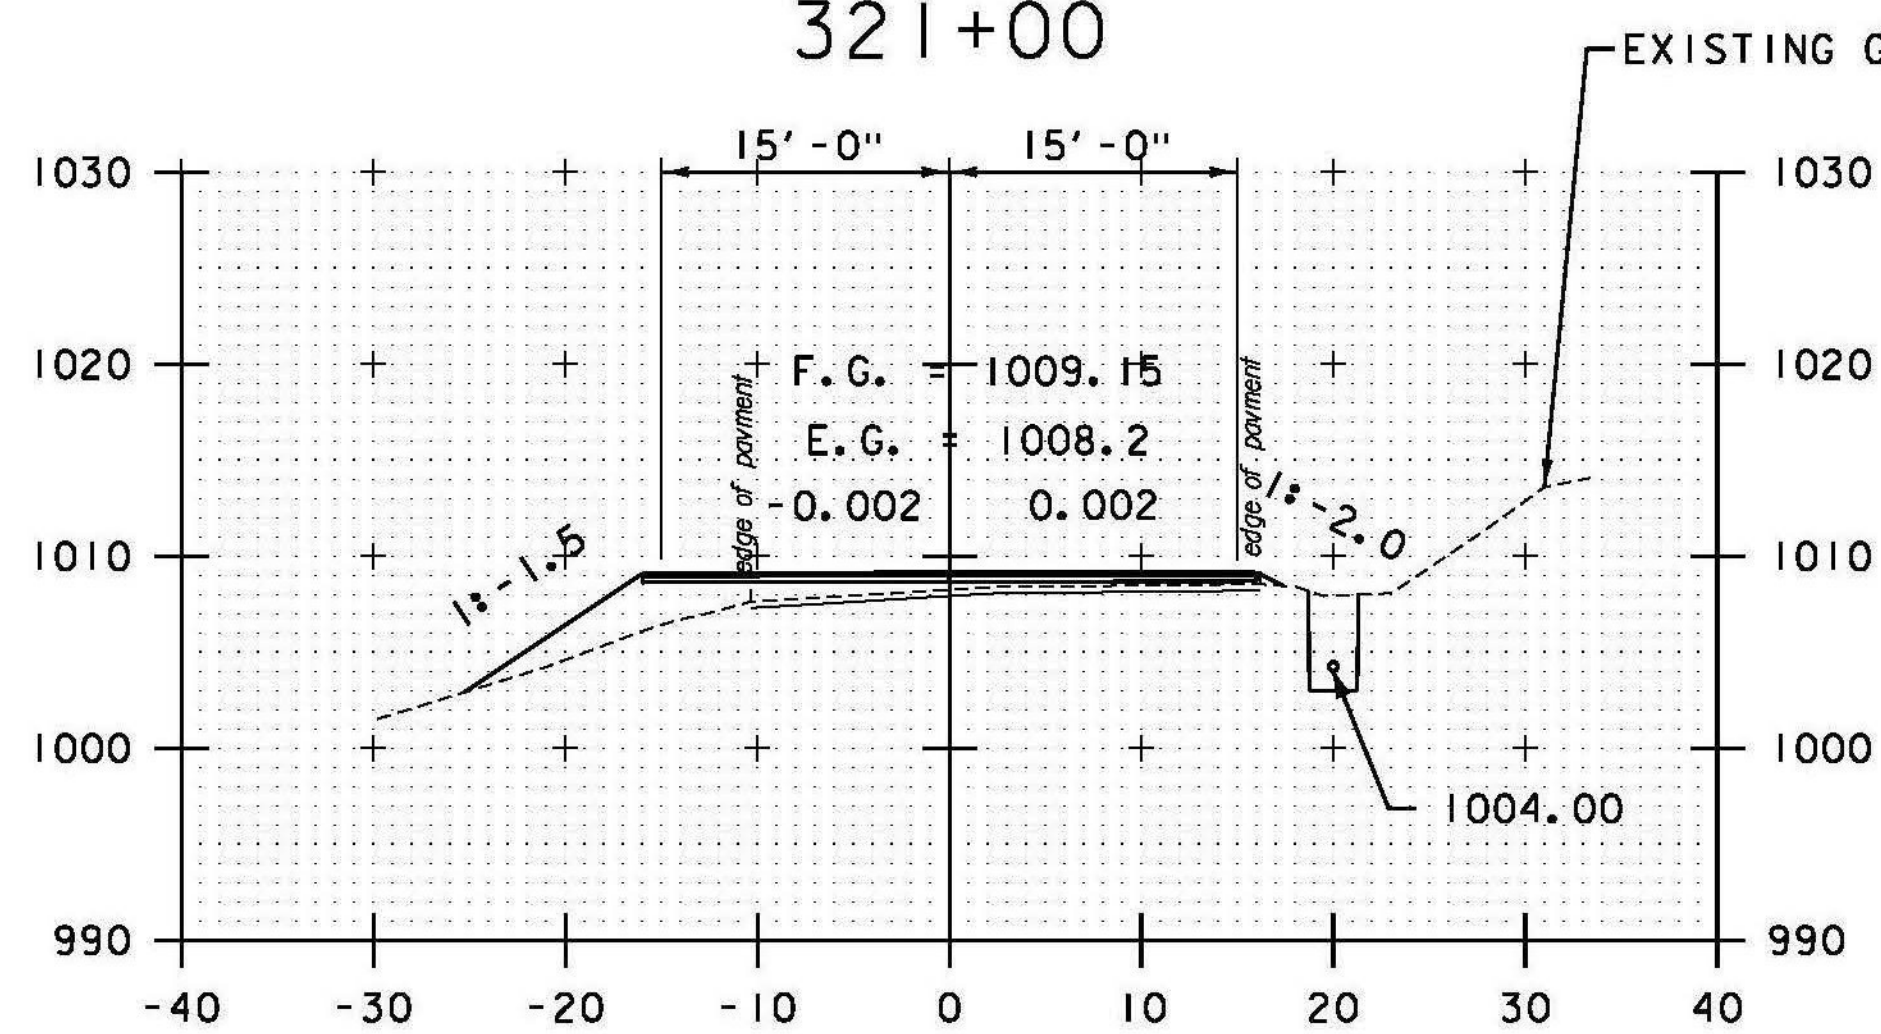

DRIVE LT  
320+50

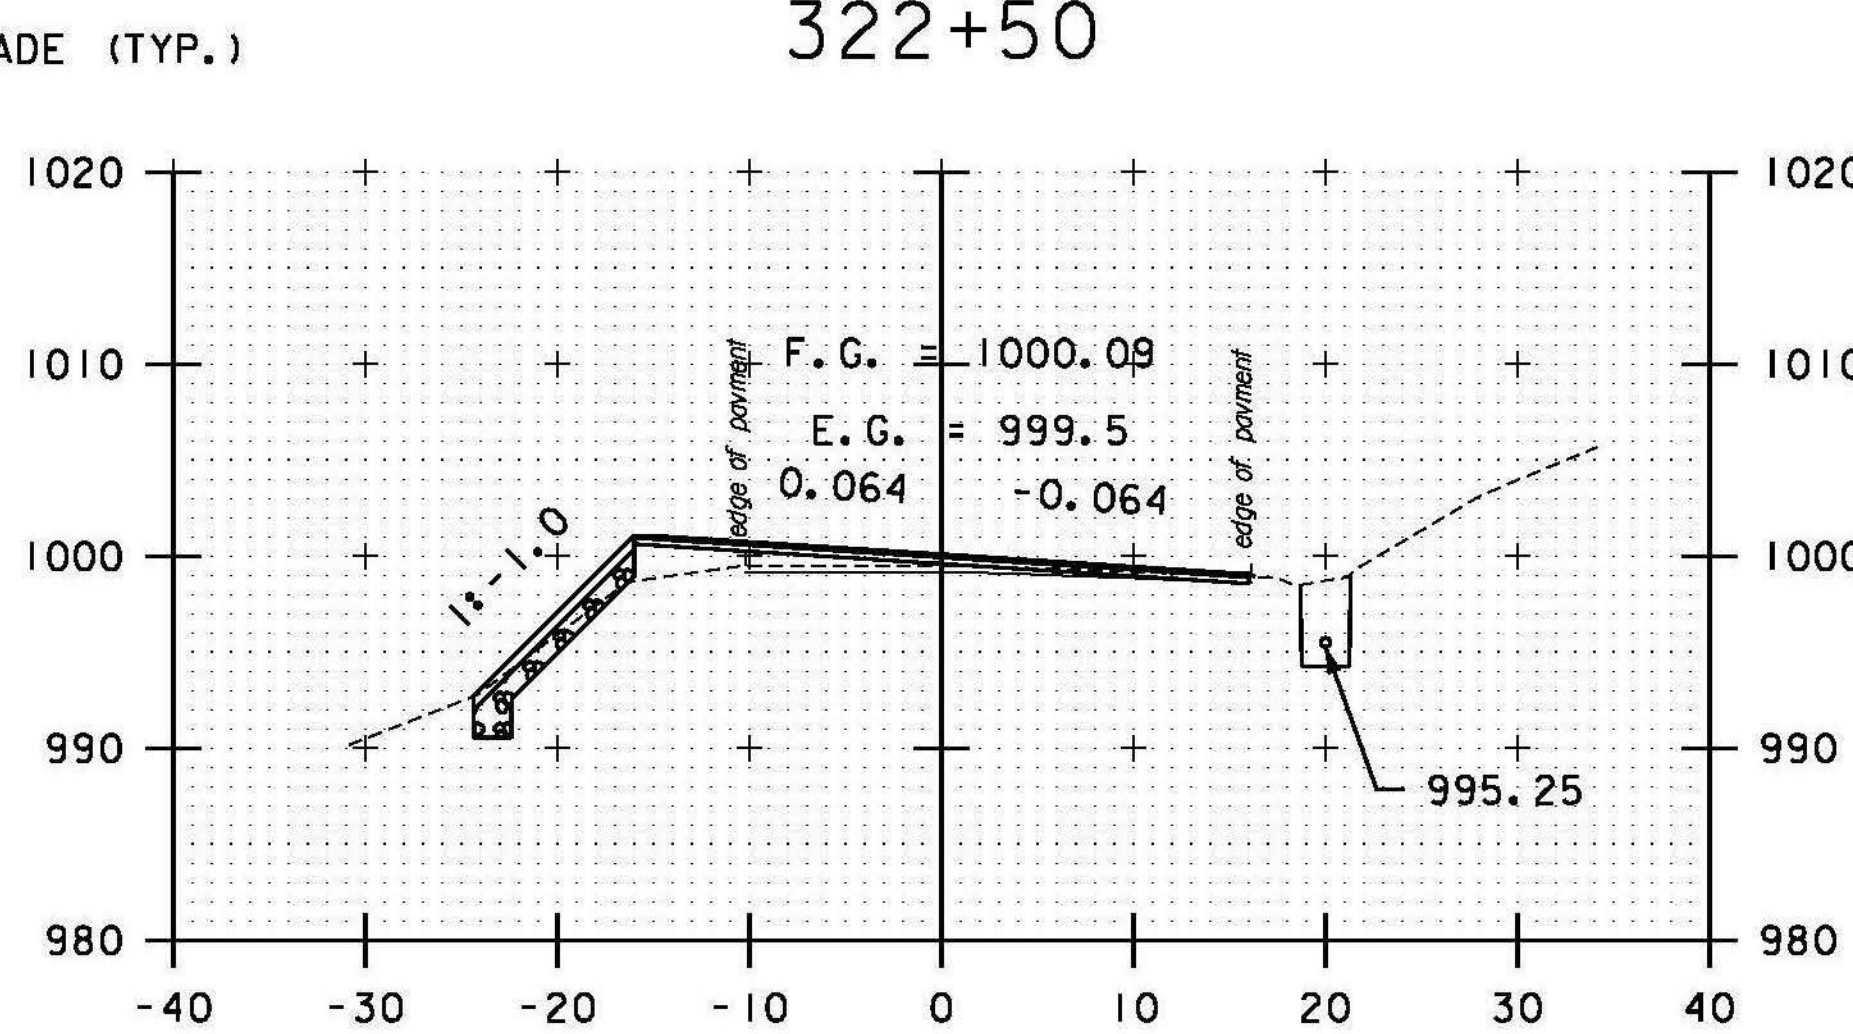

322+00

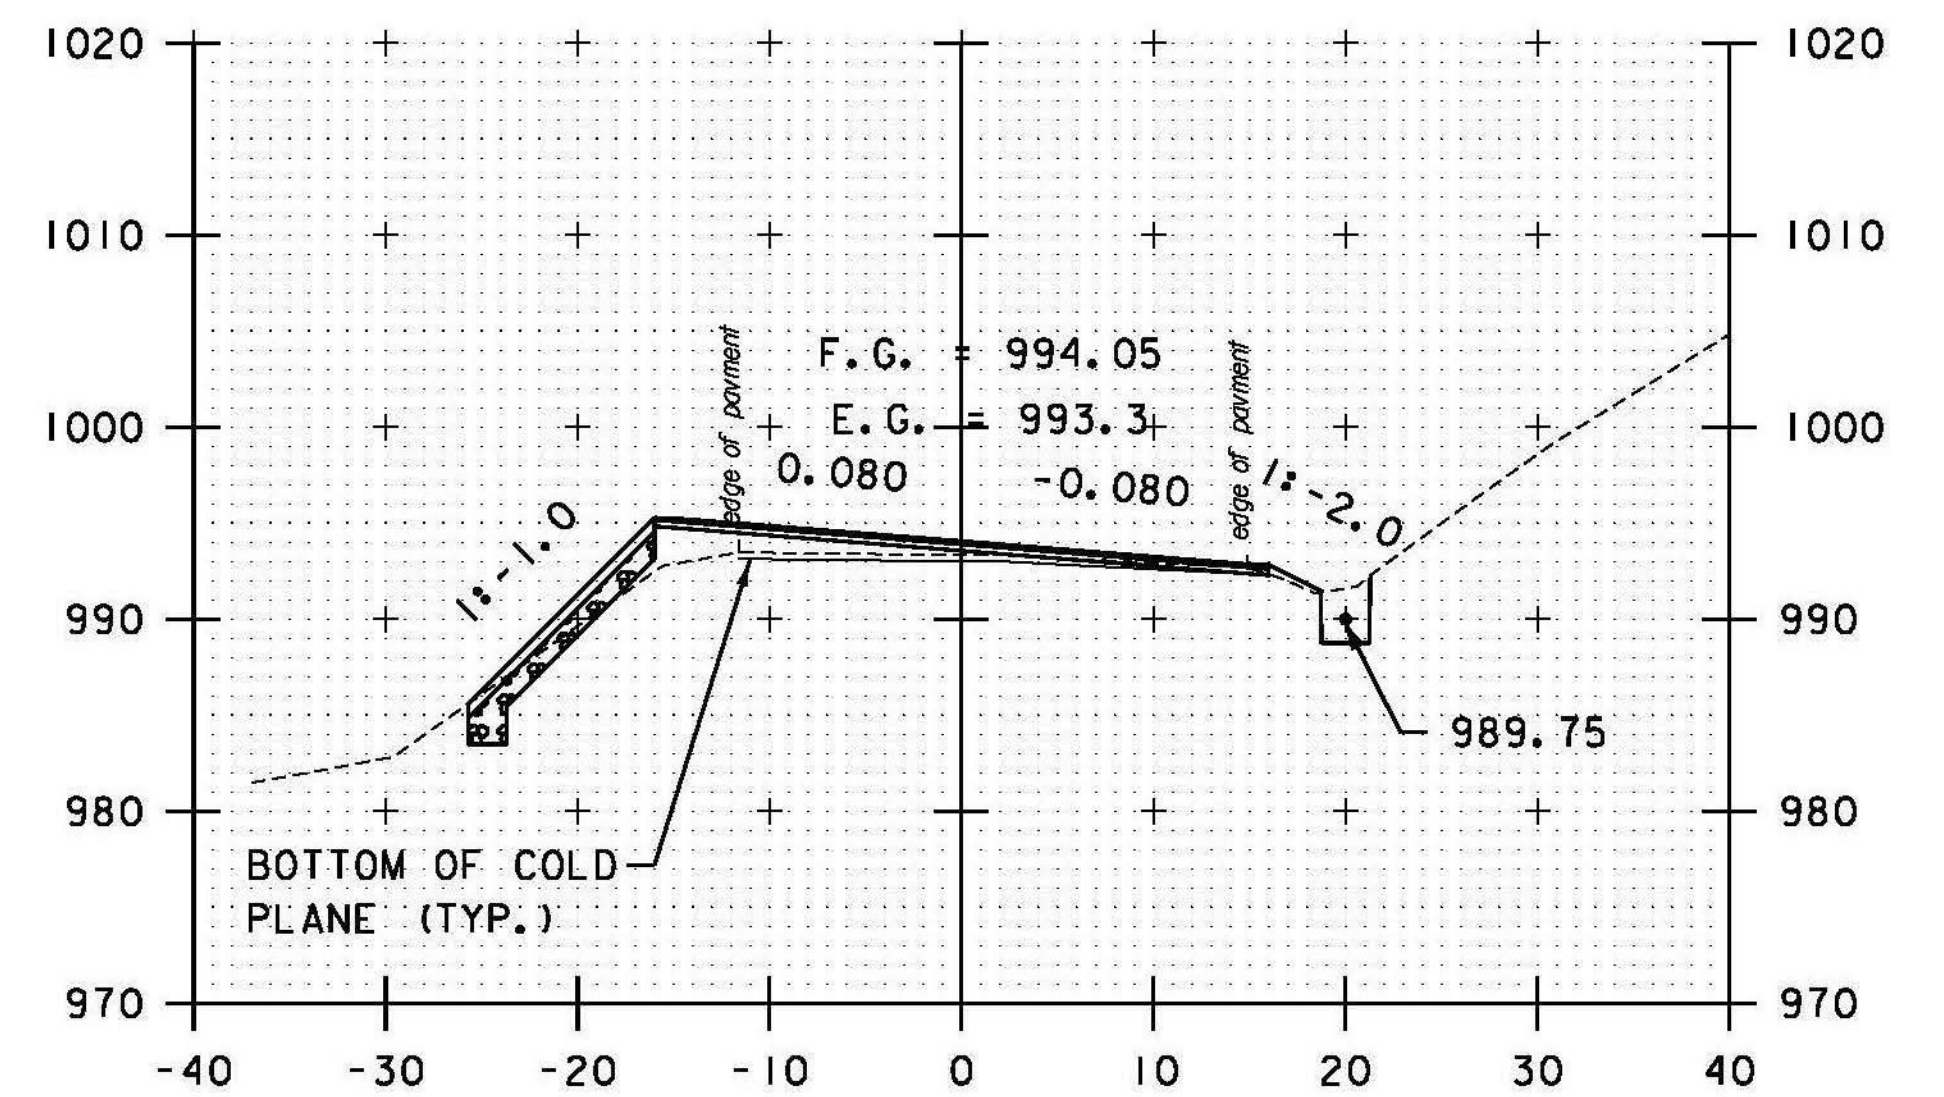


323+00

36 STA. 323+47.81 RT 20.80' TO  
 STA. 323+64.00 LT 27.54'  
 REMOVE HEADWALL AND PIPE  
 INSTALL 18" CPEP (51'-0")  
 INV. IN = 986.50'  
 INV. OUT = 980.25'

STA. 320+50 TO STA. 323+50

DATUM  
 VERTICAL NAVD 88  
 HORIZONTAL NAD 83 (07)

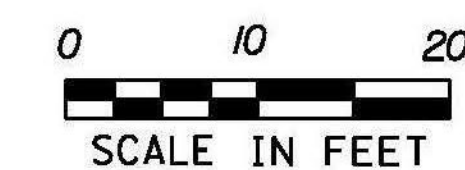

PROJECT NAME: RANDOLPH  
 PROJECT NUMBER: STP 2932 (I)

FILE NAME: z10c270.dgn  
 PROJECT LEADER: C. LATHROP  
 DESIGNED BY: B. BRESLEND  
 VT 66 CROSS SECTION SHEET 68  
 PLOT DATE: 6/5/2014  
 DRAWN BY: B. BRESLEND  
 CHECKED BY: C. LATHROP  
 SHEET 224 OF 276