


37 STA. 327+49.49 RT 21.78' TO
STA. 327+66.19 LT 27.47'
REMOVE HEADWALL AND PIPE
INSTALL 18" CPEP (52'-0")
INV. IN = 967.80'
INV. OUT = 963.20'

STA. 327+00 TO STA. 330+00

DATUM
VERTICAL NAVD 88
HORIZONTAL NAD 83 (07)

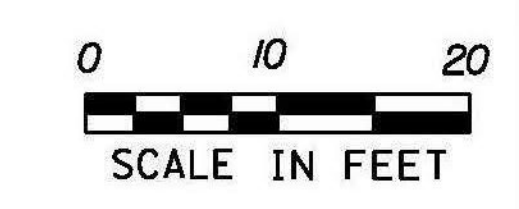

PROJECT NAME: RANDOLPH
PROJECT NUMBER: STP 2932 (1)
FILE NAME: z10c270.dgn
PROJECT LEADER: C. LATHROP
DESIGNED BY: B. BRESLEND
VT 66 CROSS SECTION SHEET 70
PLOT DATE: 6/5/2014
DRAWN BY: B. BRESLEND
CHECKED BY: C. LATHROP
SHEET 226 OF 276