


38 STA. 332+83.95 RT 18.61' TO
 STA. 332+93.91 RT 18.62'
 CONSTRUCT CONCRETE REINFORCED
 HEADWALL PER STD. D-33
 USE SCHEDULING AND DIMENSIONS
 FOR 30" PIPE WITH 2'-0" HEADER
 ABOVE PIPE

STA. 330+50 TO STA. 334+00

DATUM
 VERTICAL NAVD 88
 HORIZONTAL NAD 83 (07)

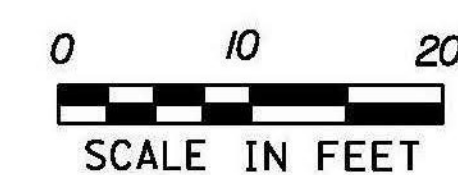

PROJECT NAME: RANDOLPH
 PROJECT NUMBER: STP 2932 (1)
 FILE NAME: z10c270.dgn
 PROJECT LEADER: C. LATHROP
 DESIGNED BY: B. BRESLEND
 VT 66 CROSS SECTION SHEET 71
 PLOT DATE: 6/5/2014
 DRAWN BY: B. BRESLEND
 CHECKED BY: C. LATHROP
 SHEET 227 OF 276