

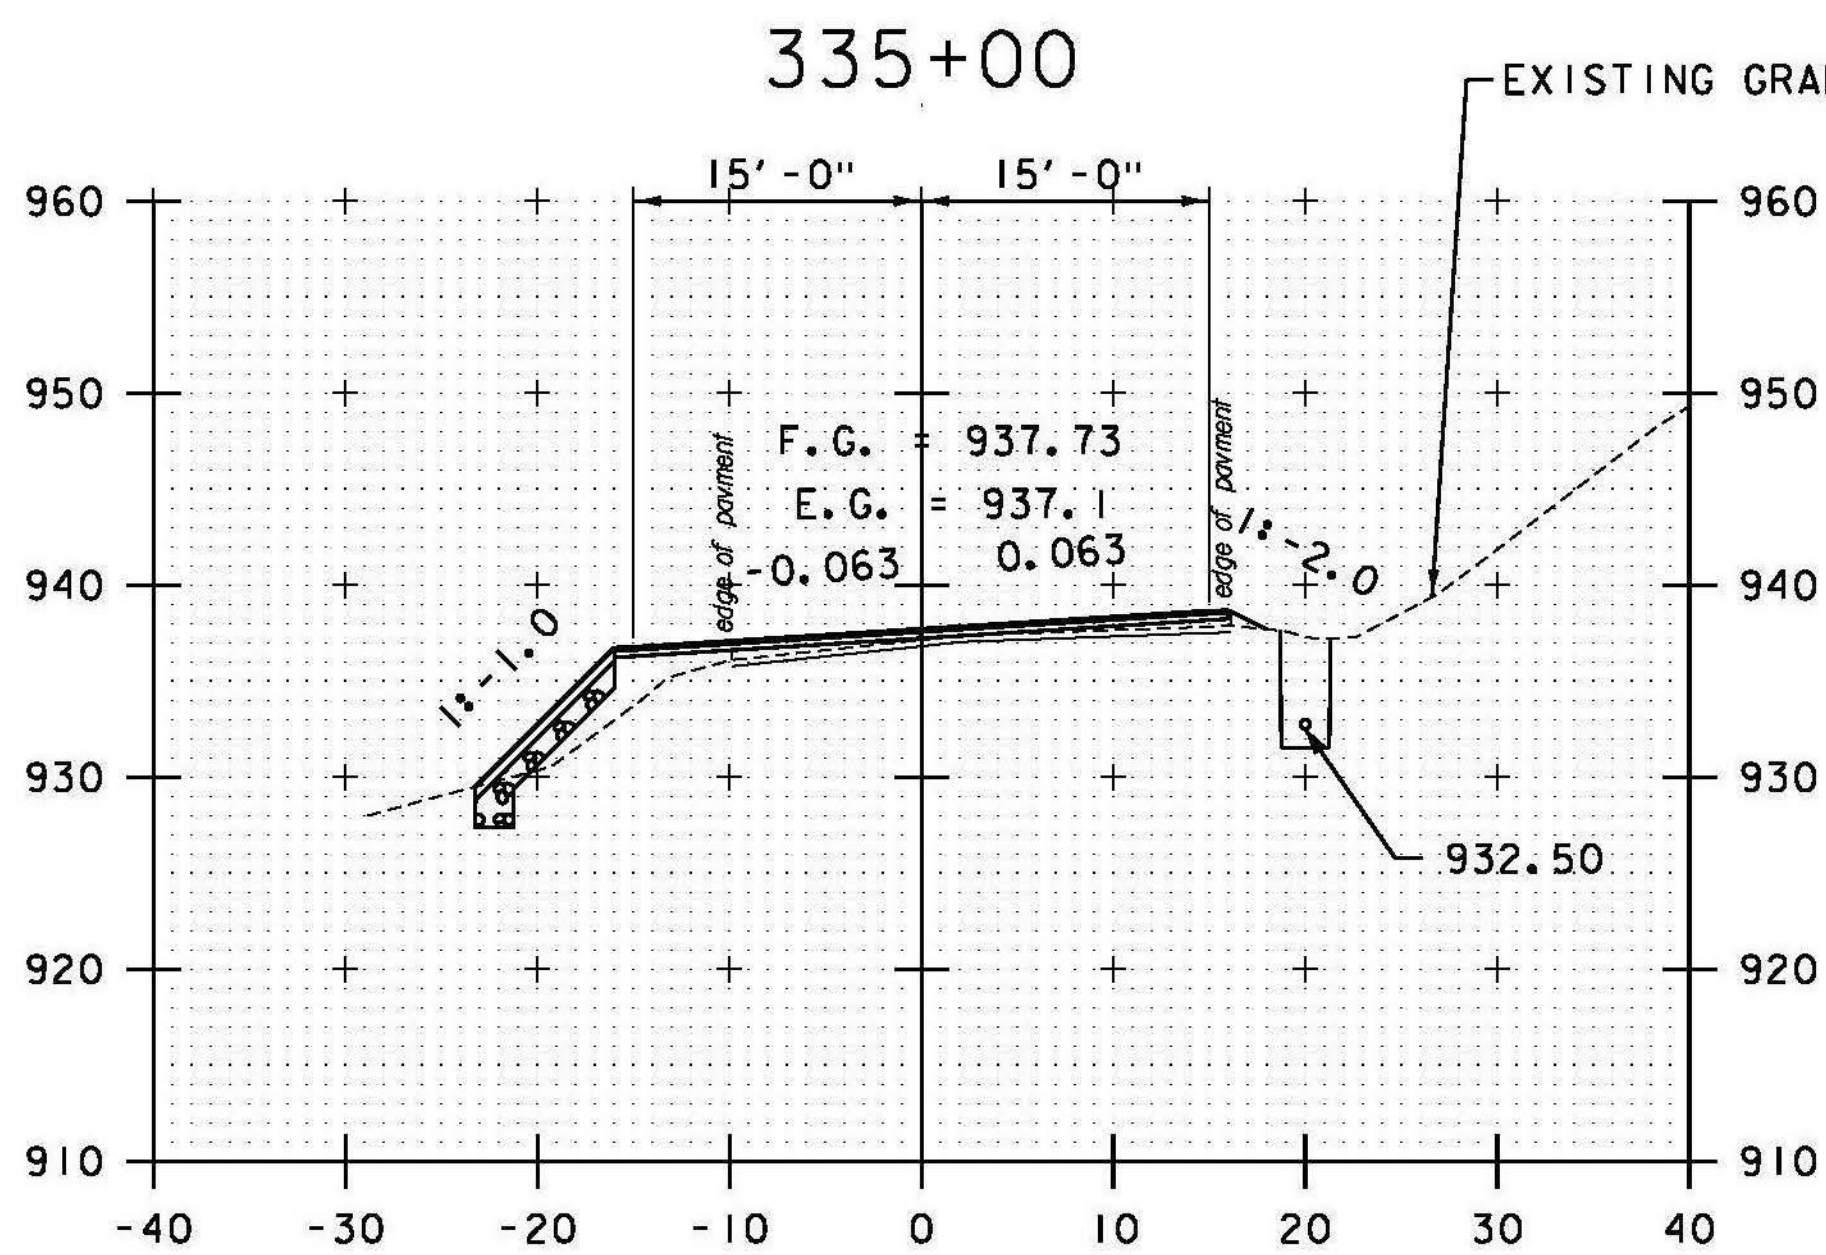



337+50

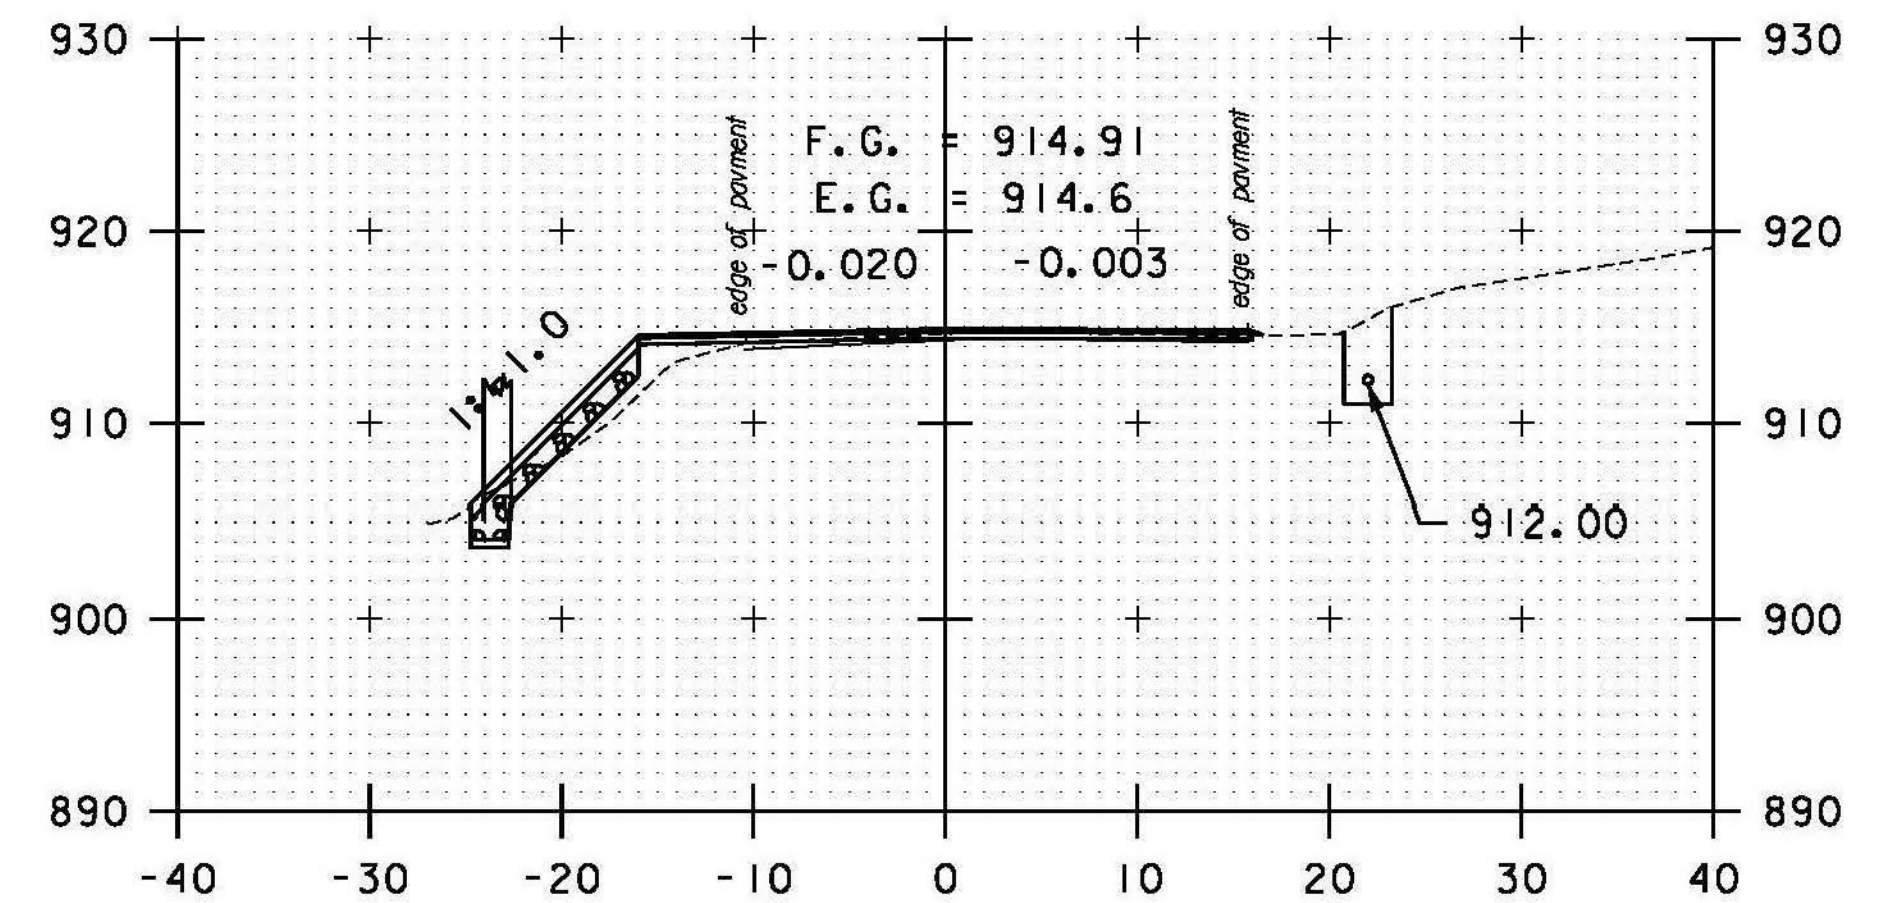

334+50

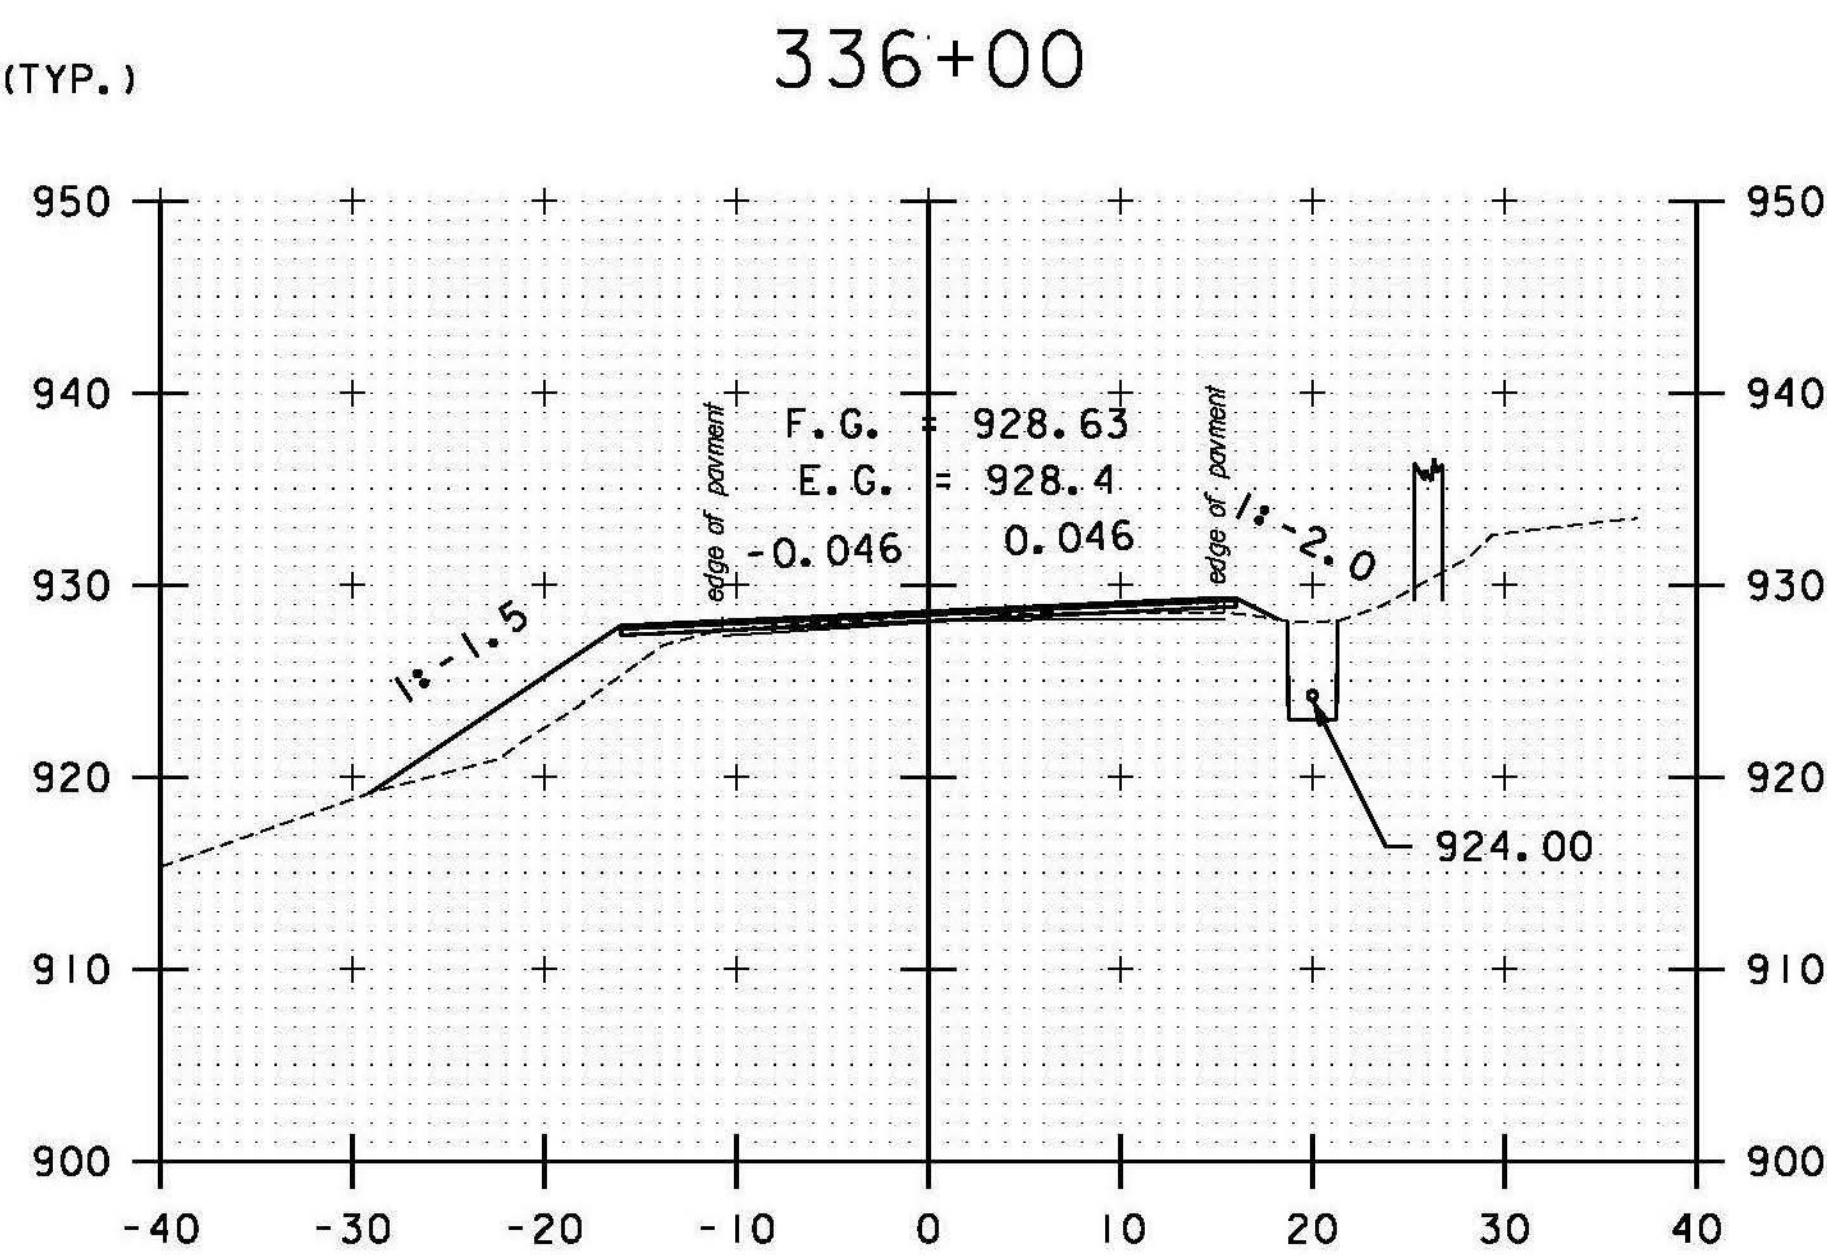


335+50

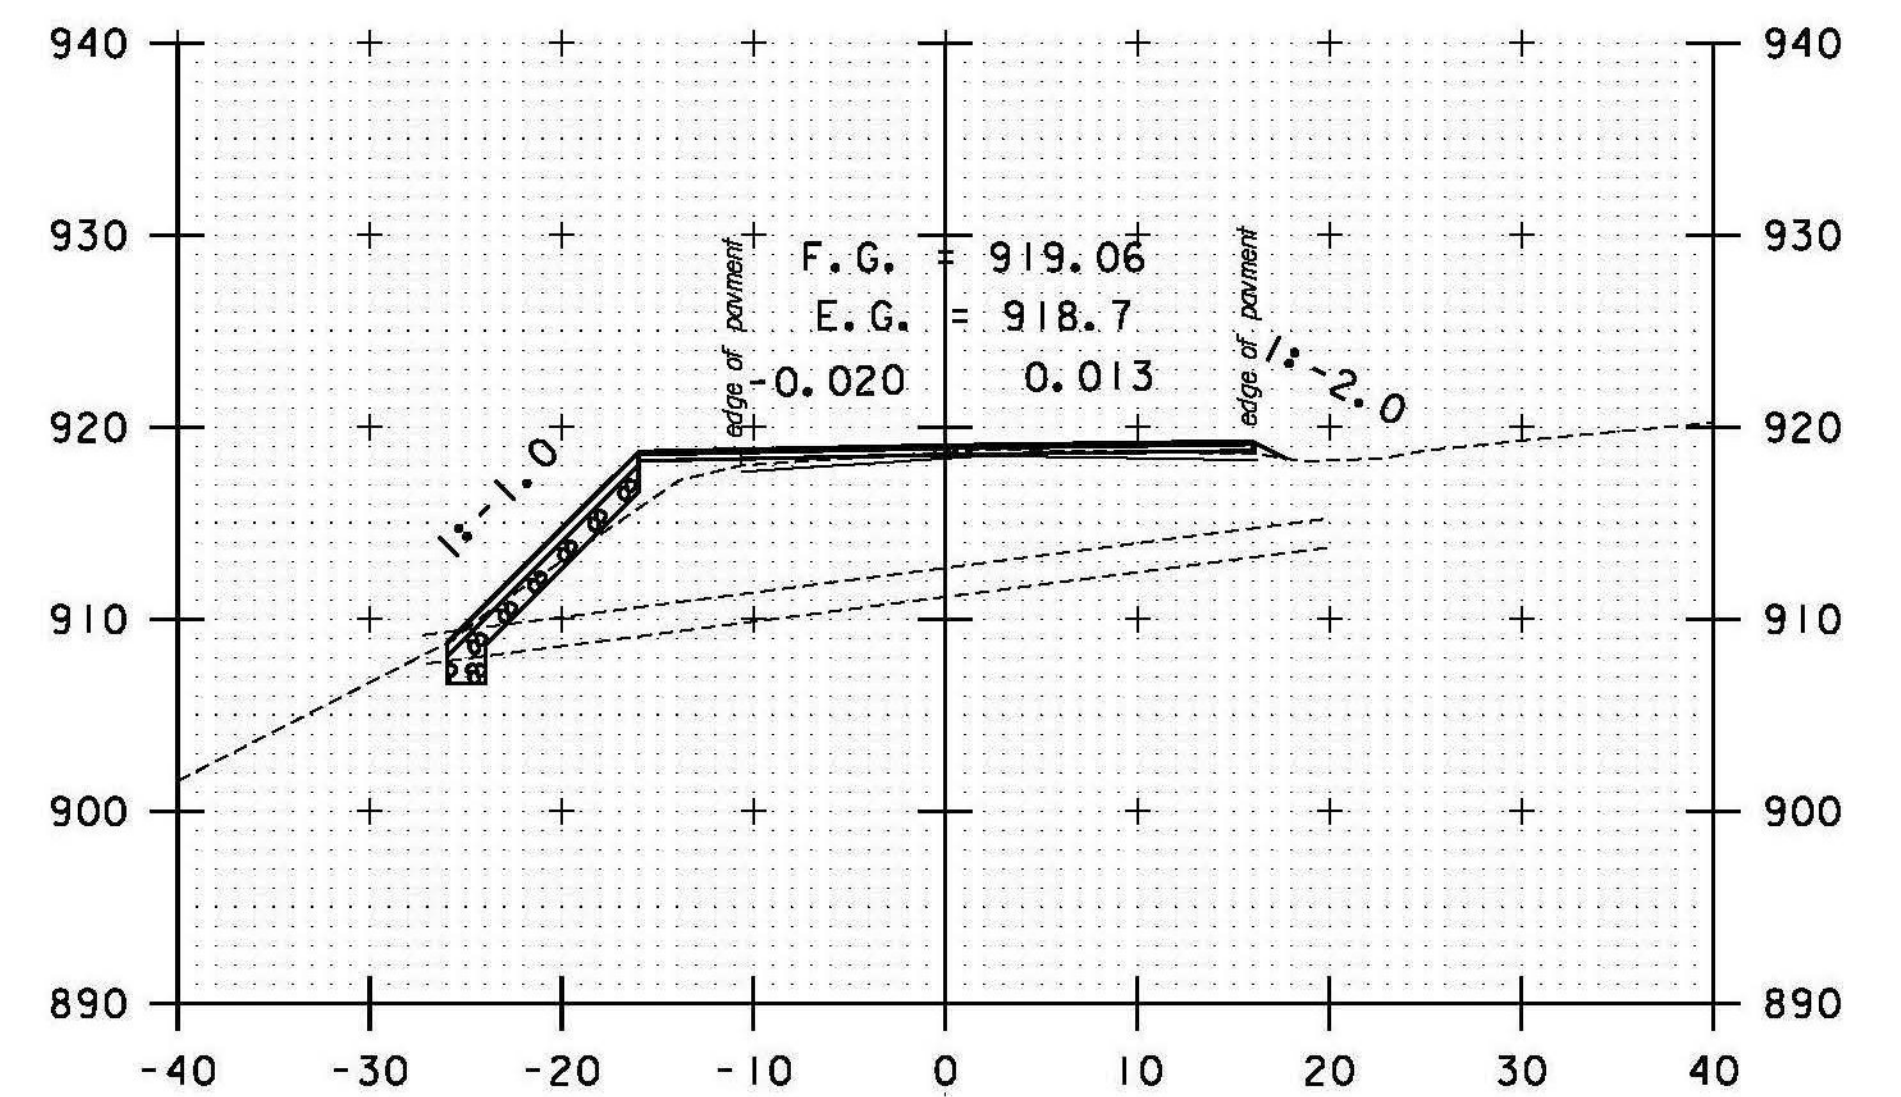

336+50

STA. 334+50 TO STA. 337+50

DATUM  
 VERTICAL NAVD 88  
 HORIZONTAL NAD 83 (07)

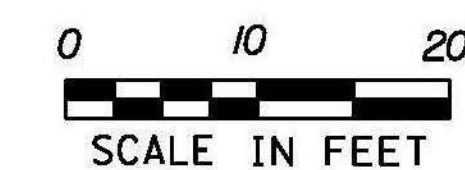

PROJECT NAME: RANDOLPH  
 PROJECT NUMBER: STP 2932 (1)

FILE NAME: z10c270.dgn  
 PROJECT LEADER: C. LATHROP  
 DESIGNED BY: B. BRESLEND  
 VT 66 CROSS SECTION SHEET 72

PLOT DATE: 6/5/2014  
 DRAWN BY: B. BRESLEND  
 CHECKED BY: C. LATHROP  
 SHEET 228 OF 276