




343+00

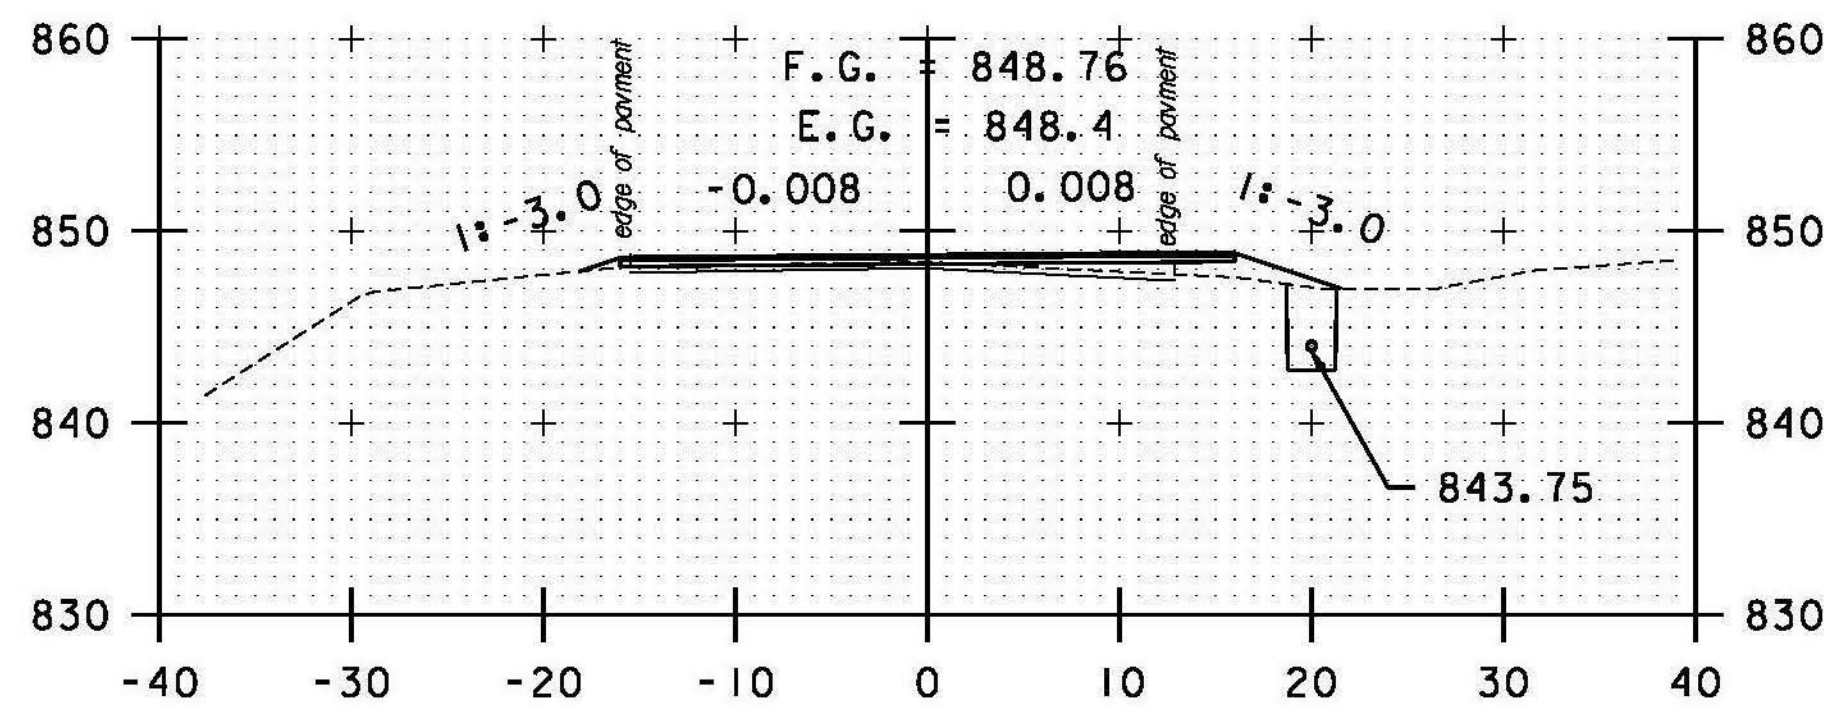


344+50

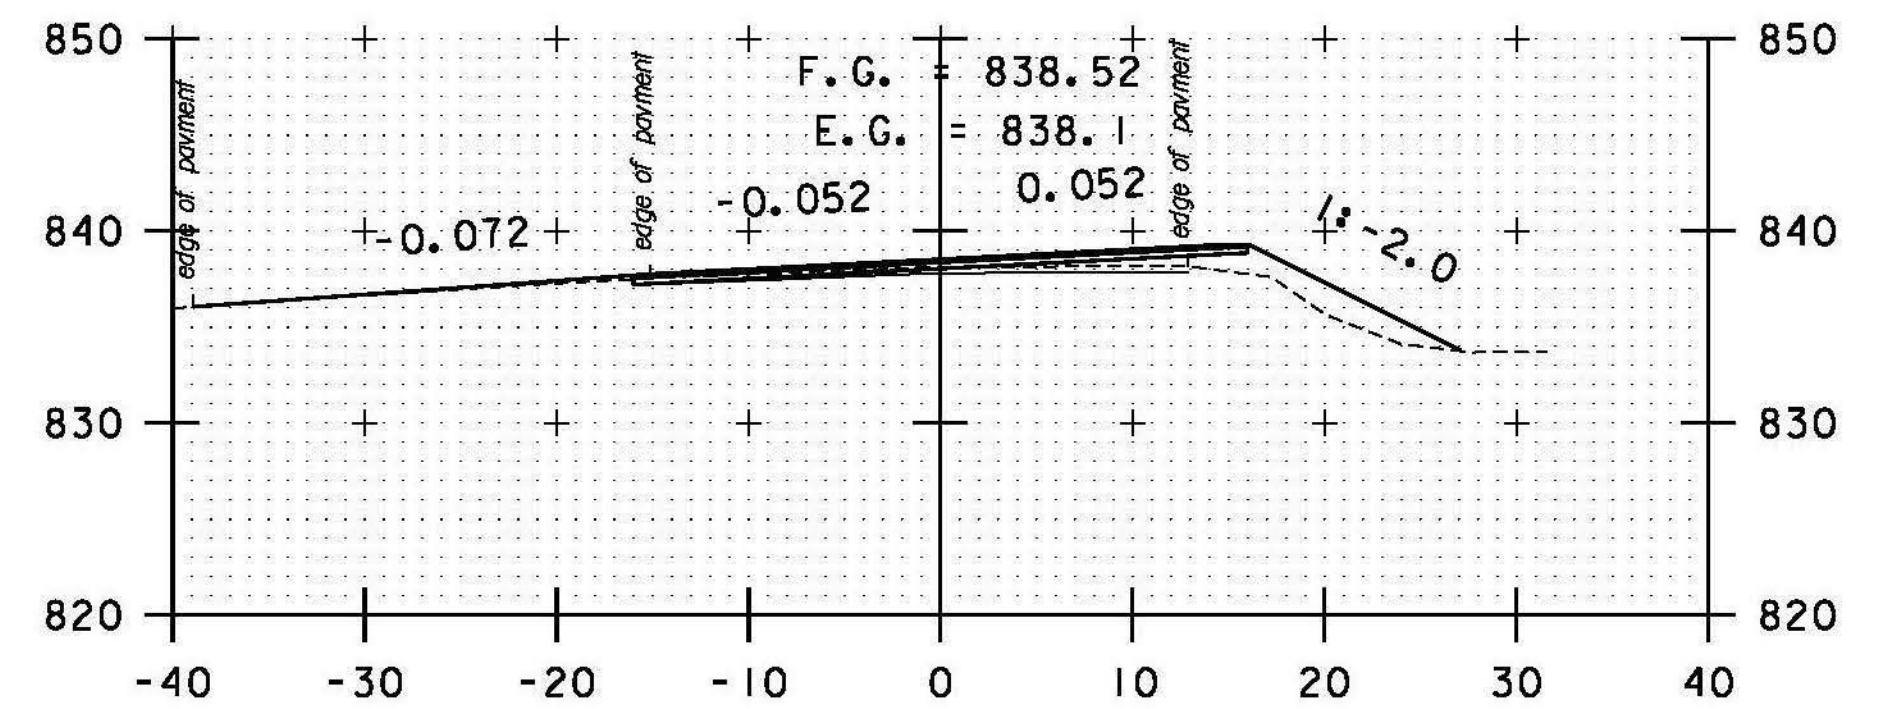


TH#33 LT  
345+50

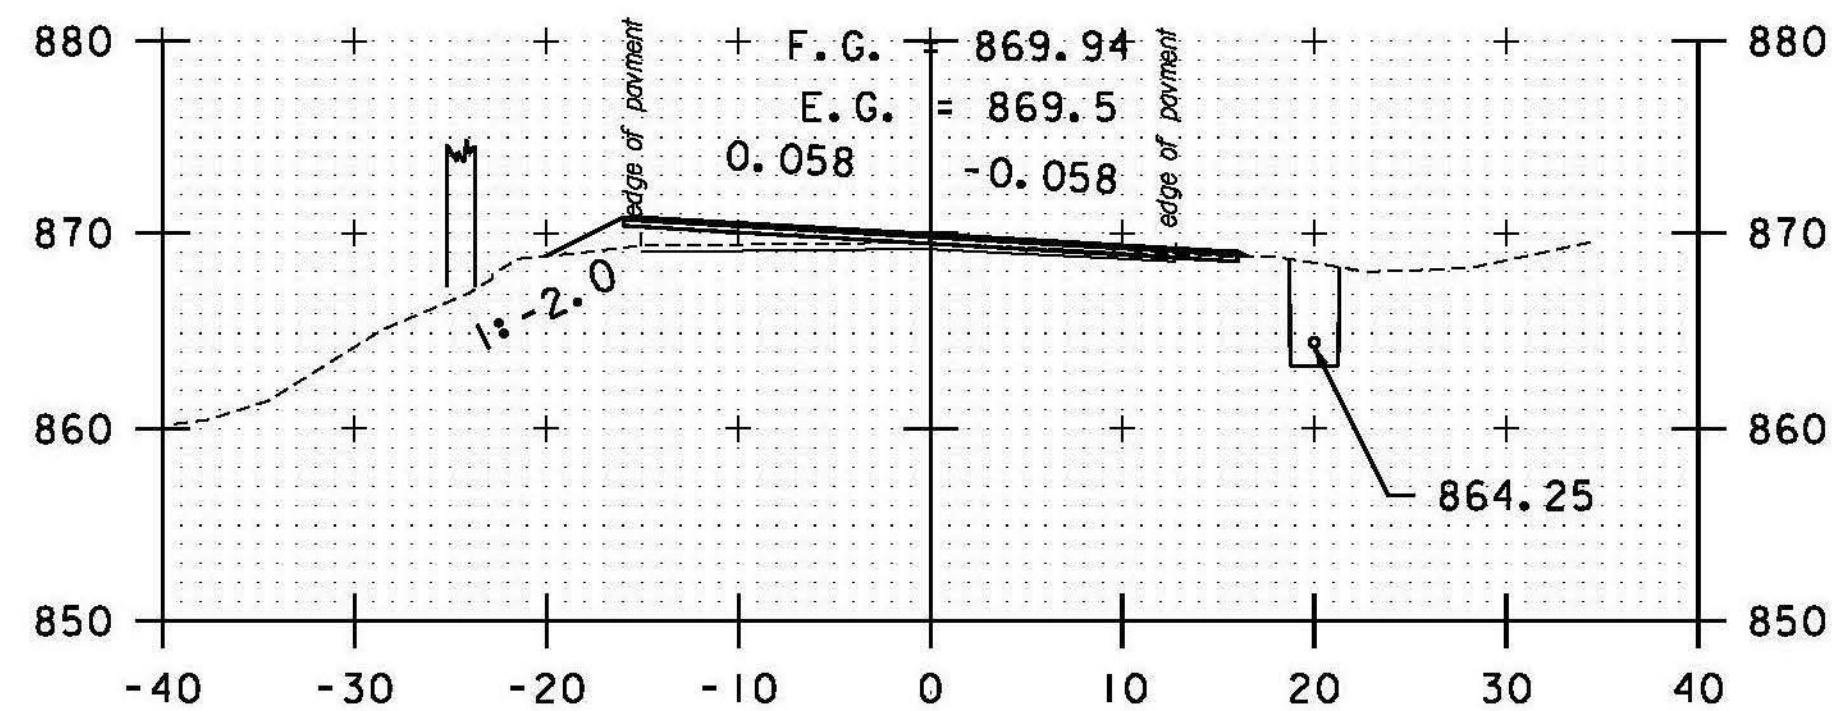


342+50

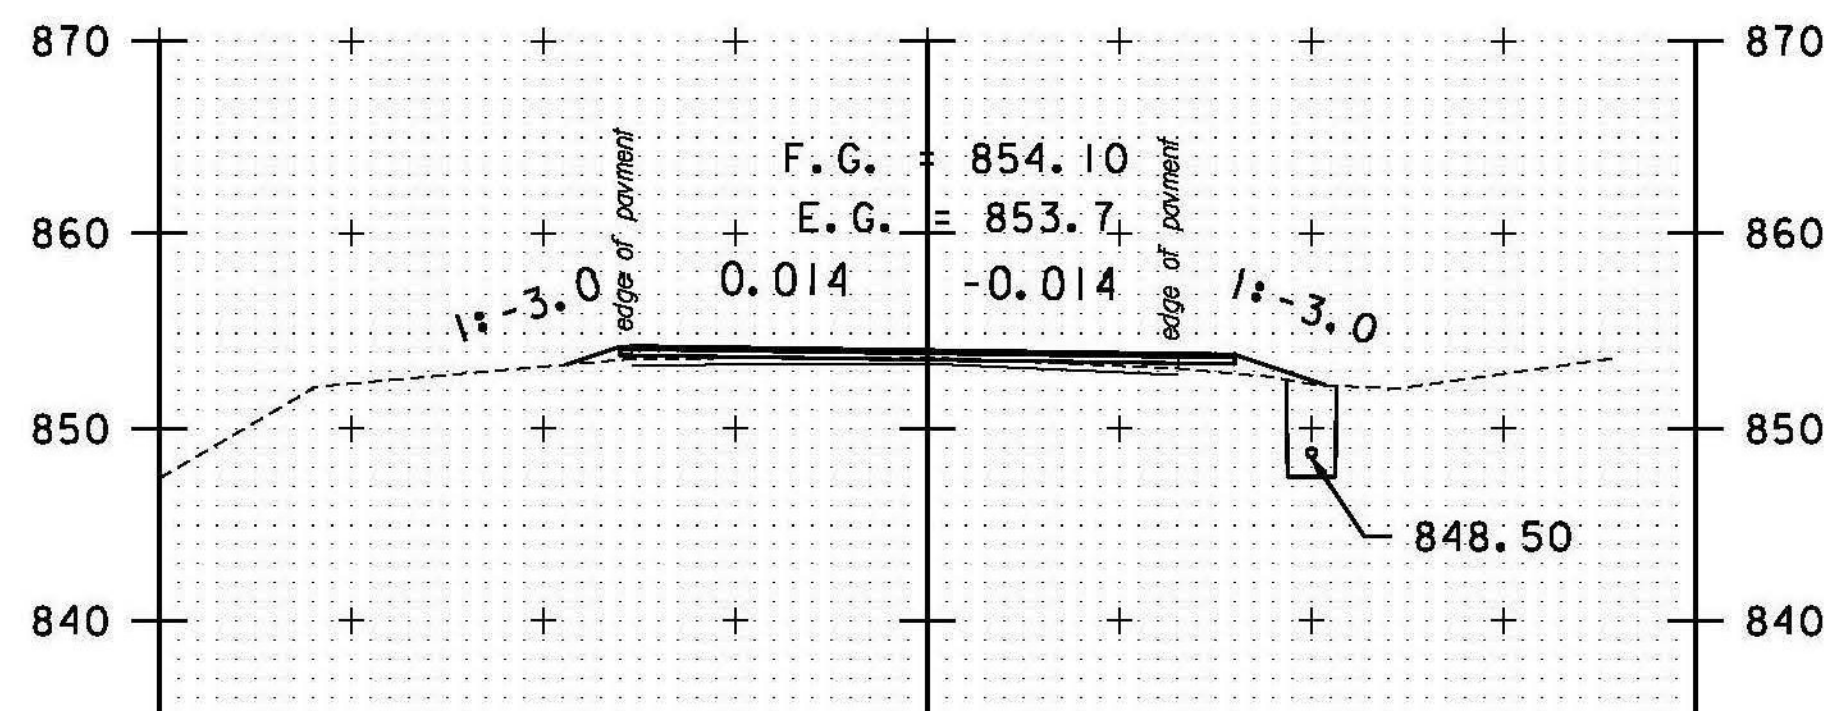


344+00

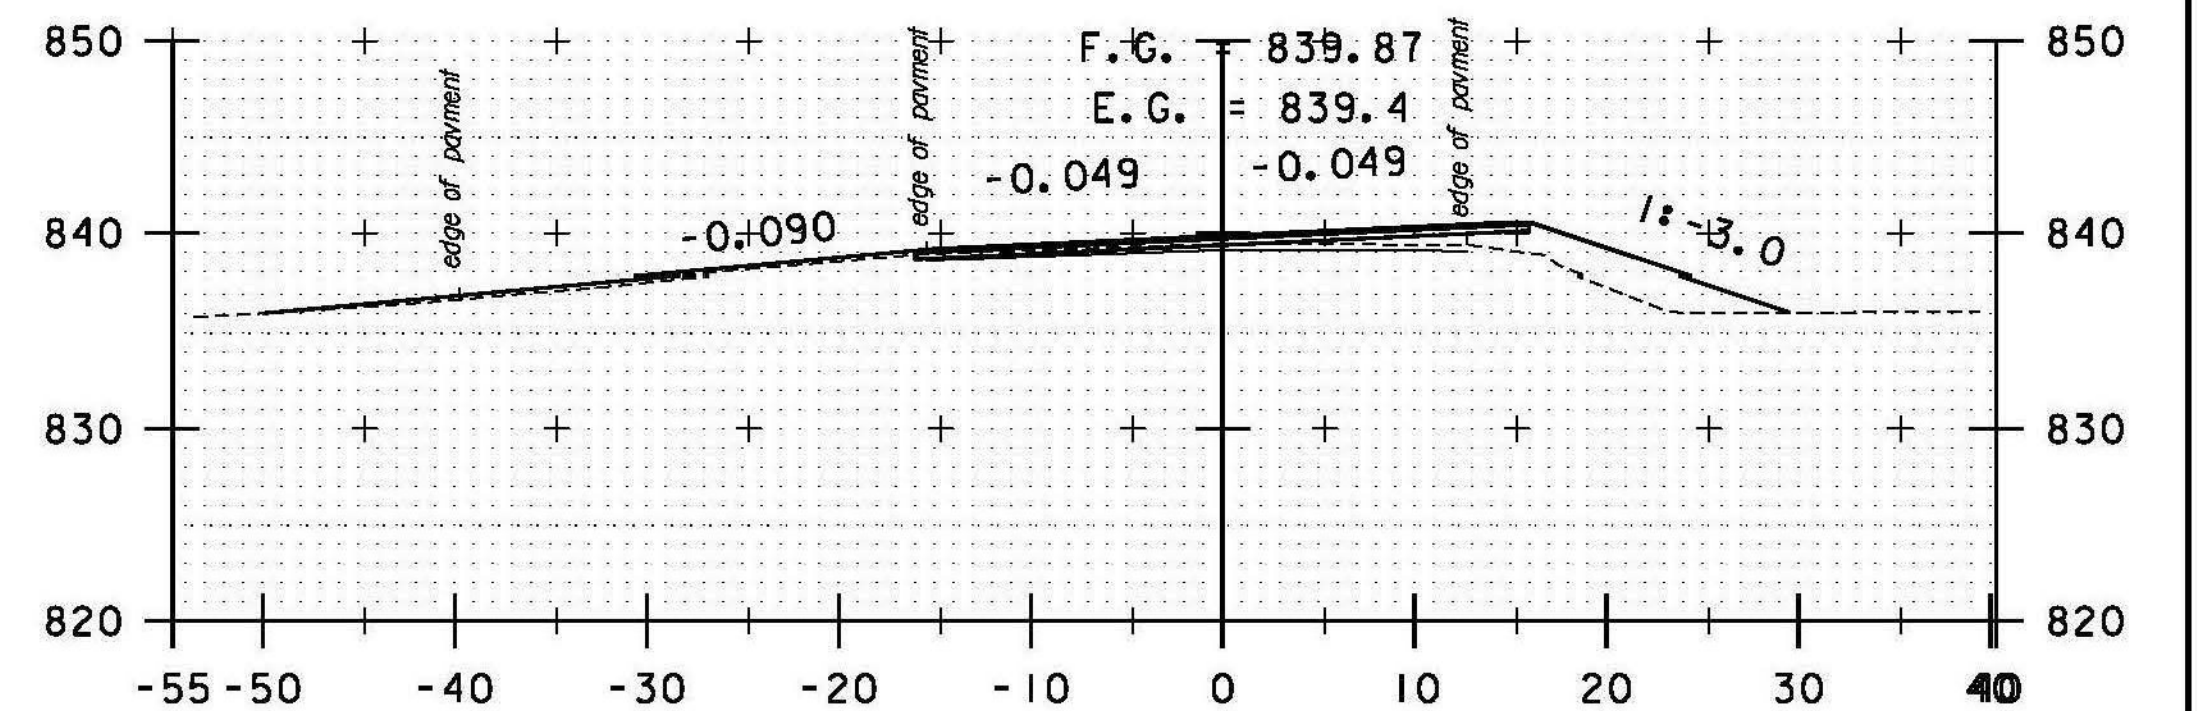


TH#33 LT  
345+36

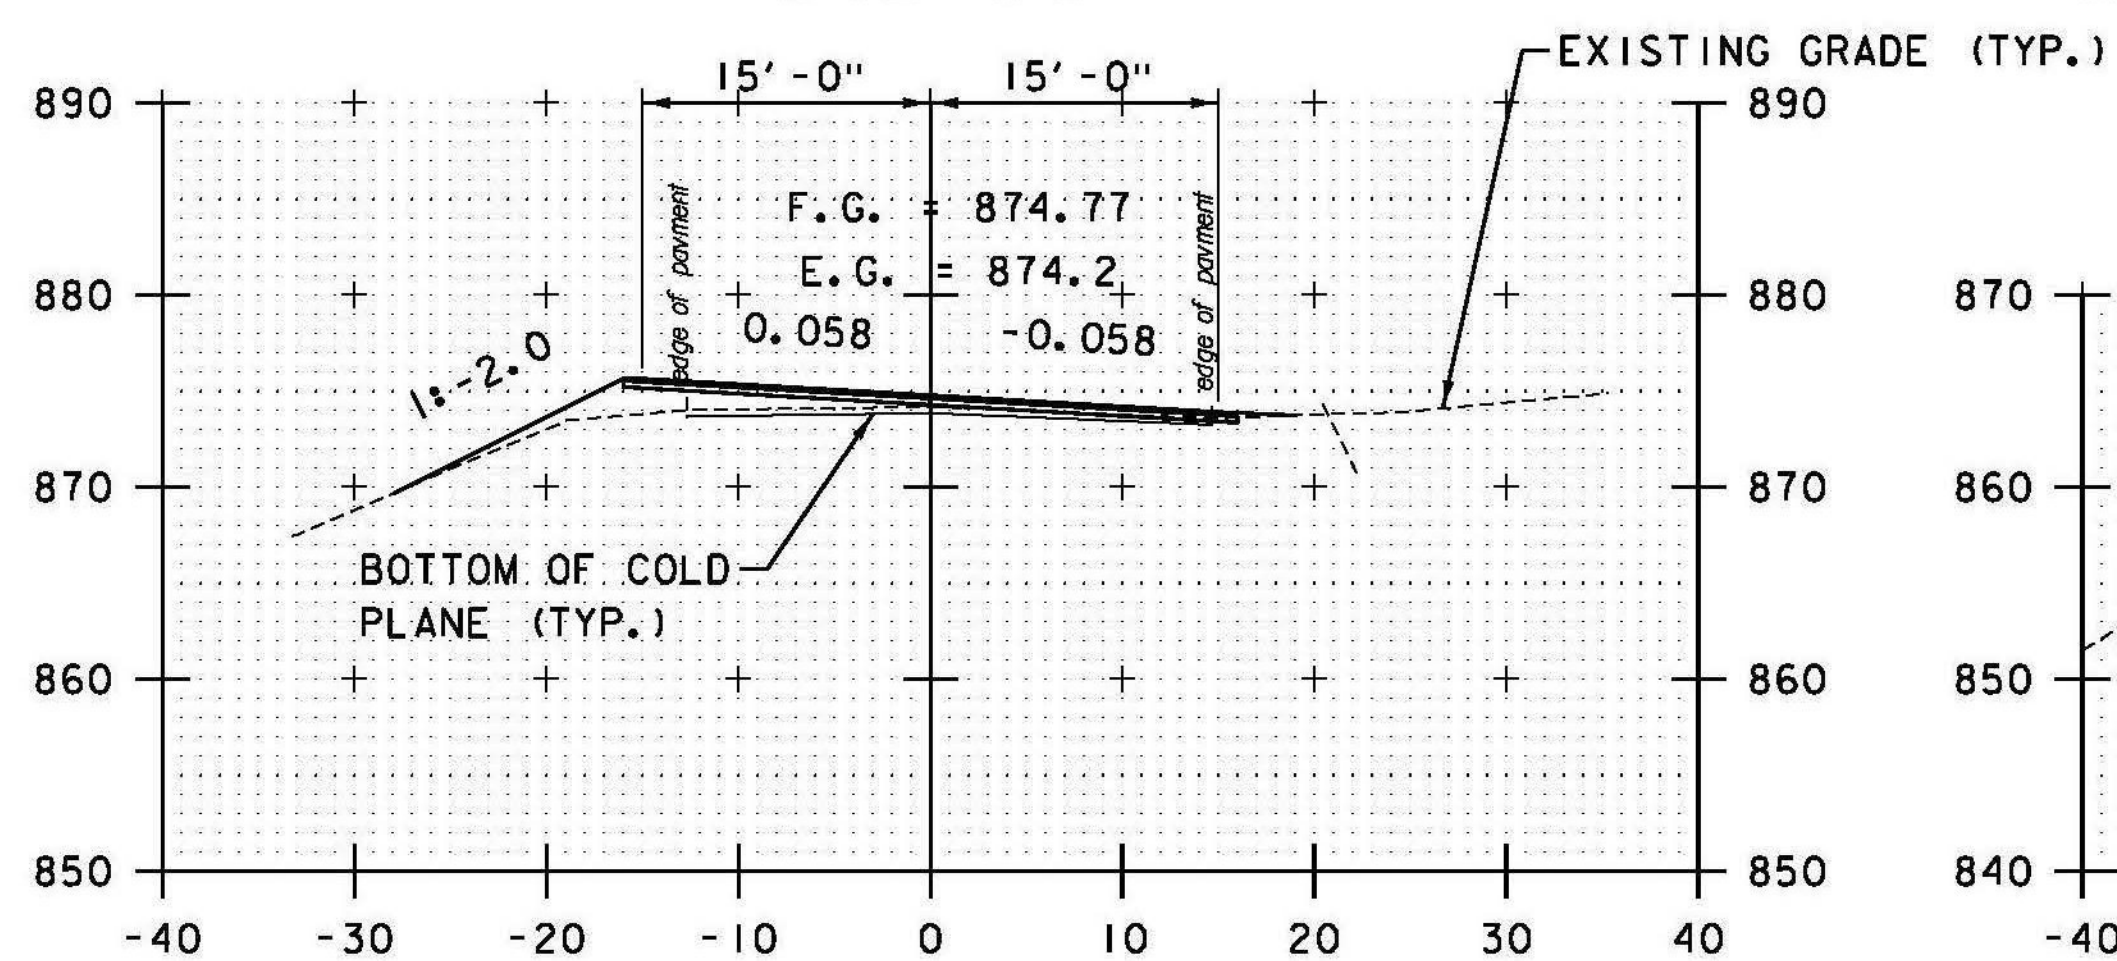

DRIVE RT  
342+00

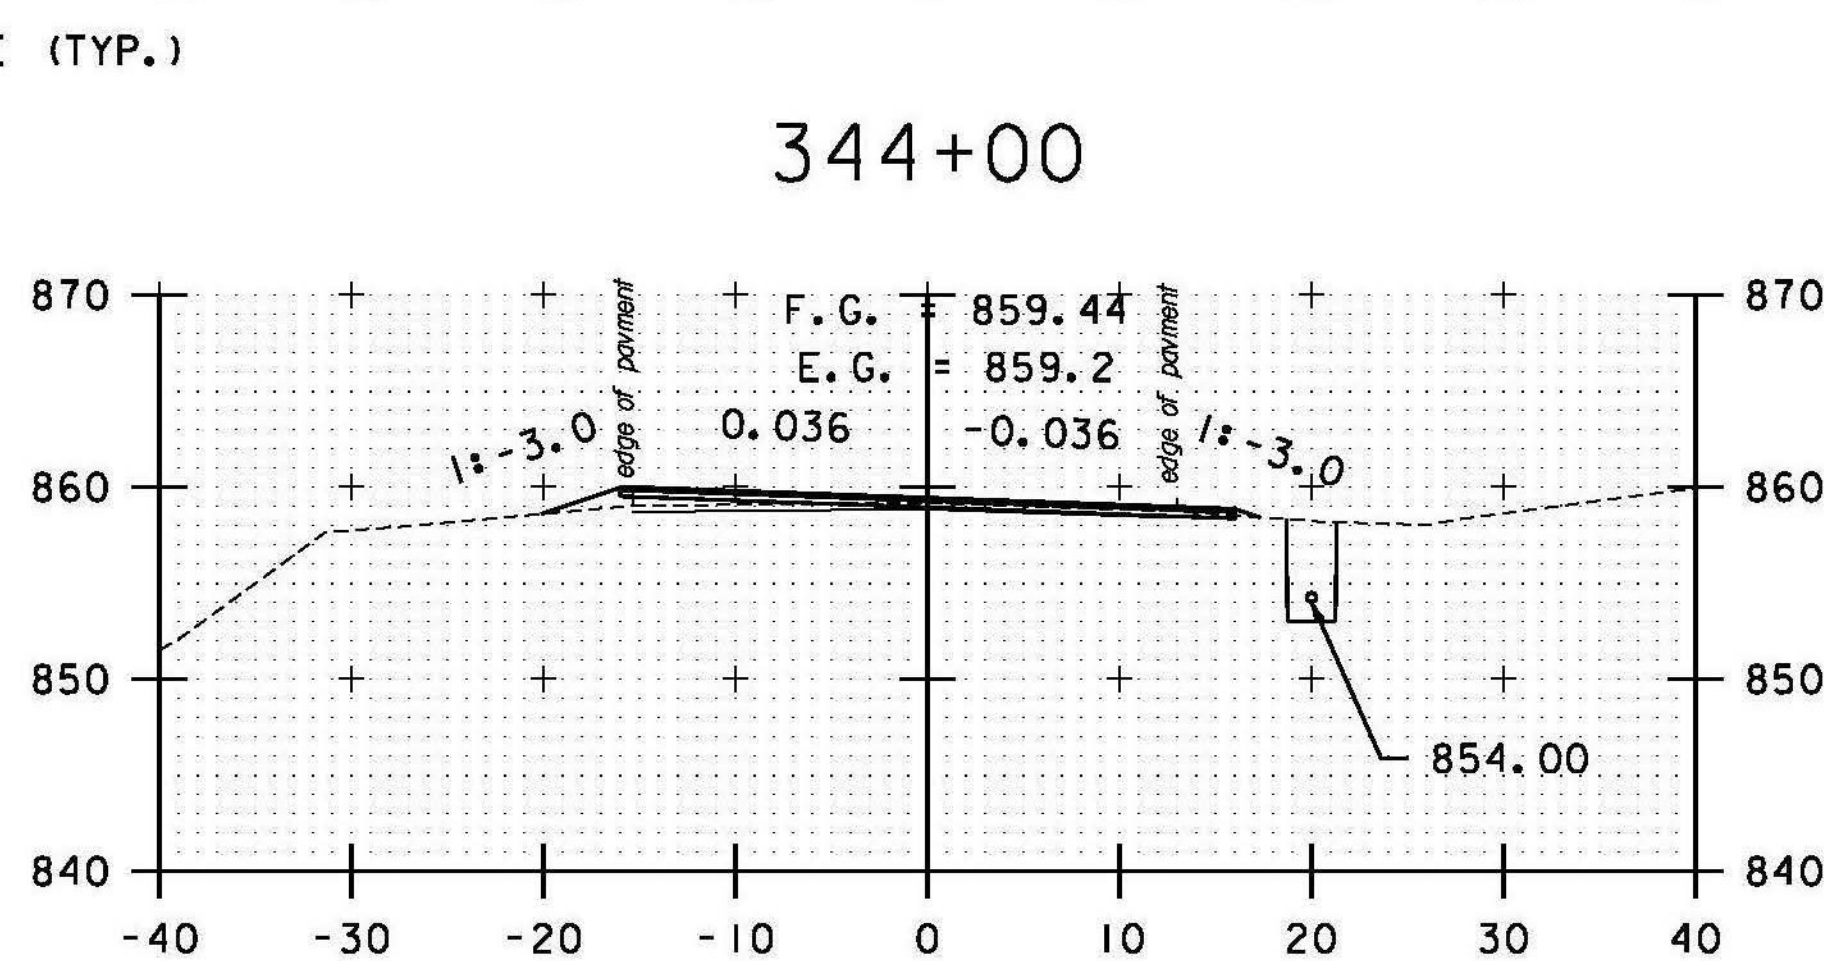


343+50

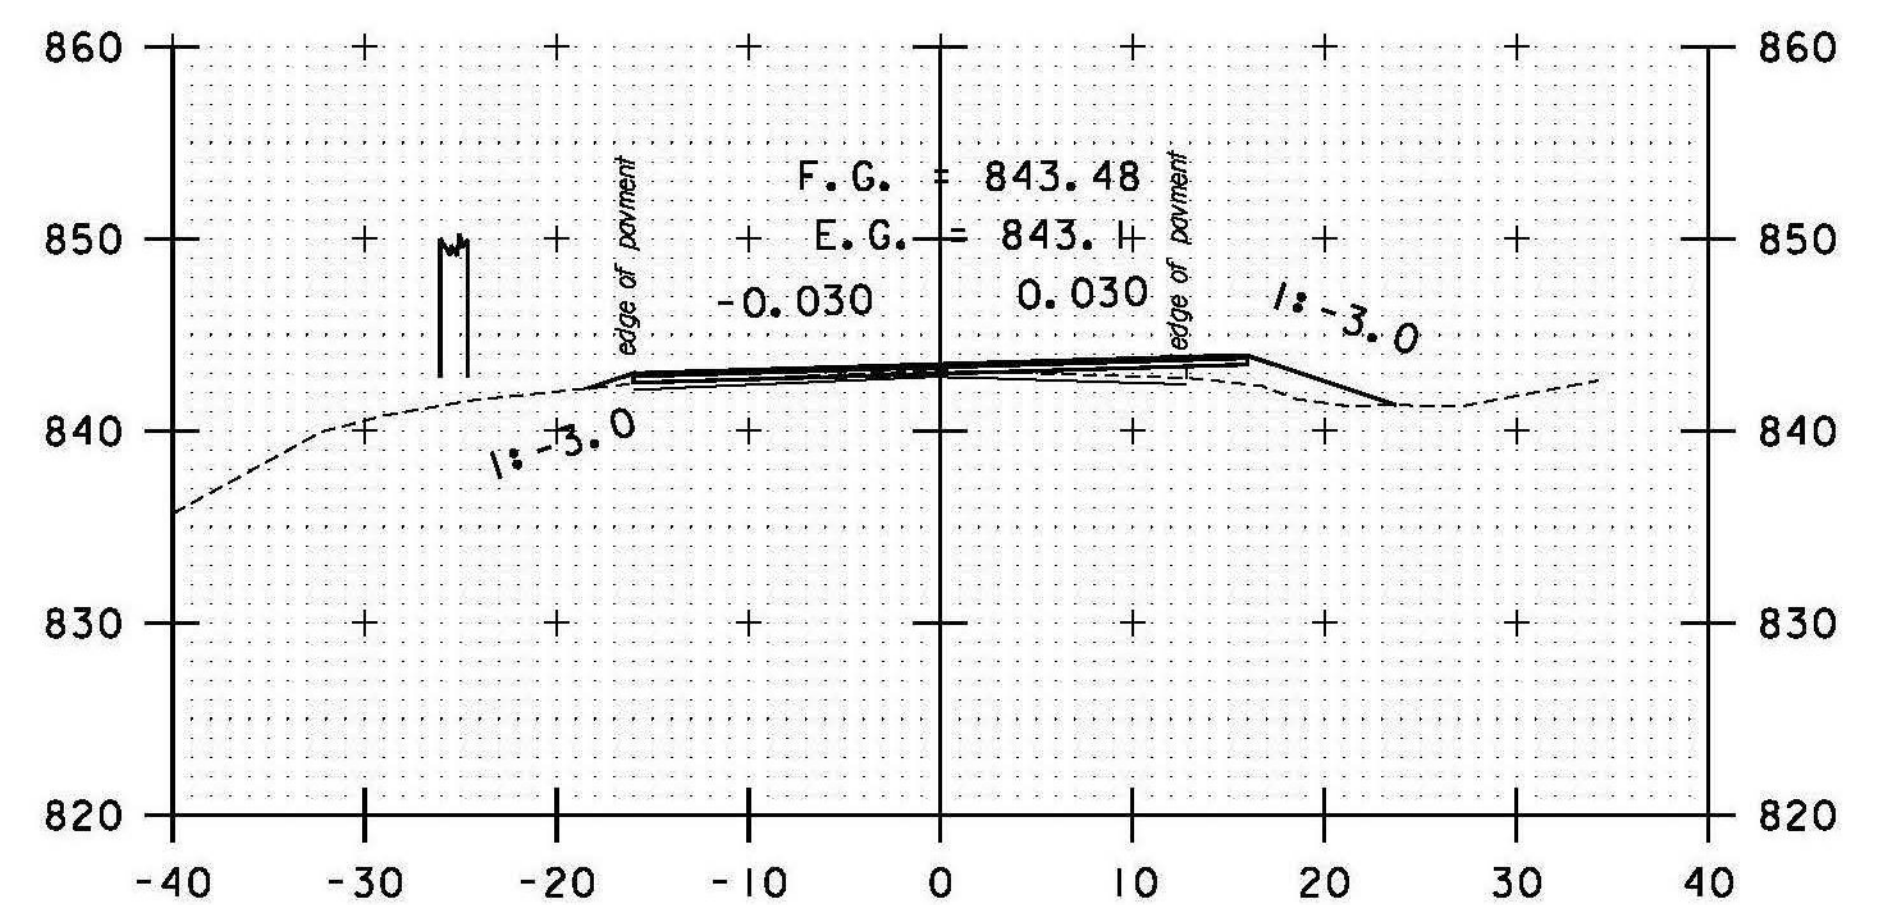

345+00

STA. 342+00 TO STA. 345+50

DATUM  
 VERTICAL NAVD 88  
 HORIZONTAL NAD 83 (07)

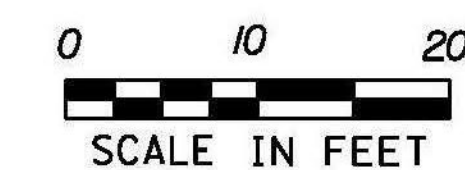

PROJECT NAME: RANDOLPH  
 PROJECT NUMBER: STP 2932 (1)

FILE NAME: z10c270.dgn  
 PROJECT LEADER: C. LATHROP  
 DESIGNED BY: B. BRESLEND  
 VT 66 CROSS SECTION SHEET 74

PLOT DATE: 6/5/2014  
 DRAWN BY: B. BRESLEND  
 CHECKED BY: C. LATHROP  
 SHEET 230 OF 276