

LT#6 RT
346+00




STA. 349+13.80 RT 25.88' TO
STA. 349+19.00 LT 27.86'
REMOVE HEADWALL AND PIPE
INSTALL 18" CPEP (54'-0")
INV. IN = 805.25'
INV. OUT = 802.95'

DRIVE LT
347+50

STA. 346+00 TO STA. 350+00

349+00

DATUM
VERTICAL NAVD 88
HORIZONTAL NAD 83 (07)

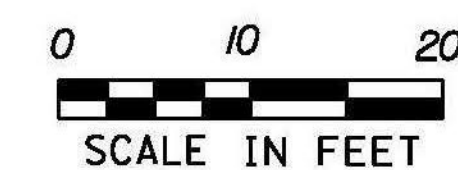

PROJECT NAME: RANDOLPH
PROJECT NUMBER: STP 2932 (1)

FILE NAME: z10c270.dgn
PROJECT LEADER: C. LATHROP
DESIGNED BY: B. BRESLEND
VT 66 CROSS SECTION SHEET 75

PLOT DATE: 6/5/2014
DRAWN BY: B. BRESLEND
CHECKED BY: C. LATHROP
SHEET 231 OF 276