


43 STA. 367+59.50 RT 24.98' TO
STA. 367+61.41 LT 27.98'
REMOVE HEADWALL AND PIPE
INSTALL 18" CPEP (53'-0")
INV. IN = 694.50'
INV. OUT = 691.90'

STA. 364+00 TO STA. 367+50

DATUM
VERTICAL NAVD 88
HORIZONTAL NAD 83 (07)

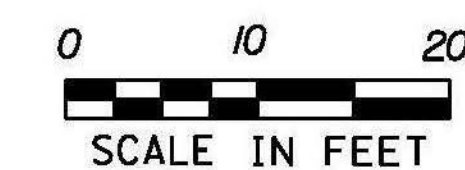

PROJECT NAME: RANDOLPH
PROJECT NUMBER: STP 2932 (1)

FILE NAME: z10c270.dgn
PROJECT LEADER: C. LATHROP
DESIGNED BY: B. BRESLEND
VT 66 CROSS SECTION SHEET 79

PLOT DATE: 6/5/2014
DRAWN BY: B. BRESLEND
CHECKED BY: C. LATHROP
SHEET 235 OF 276