
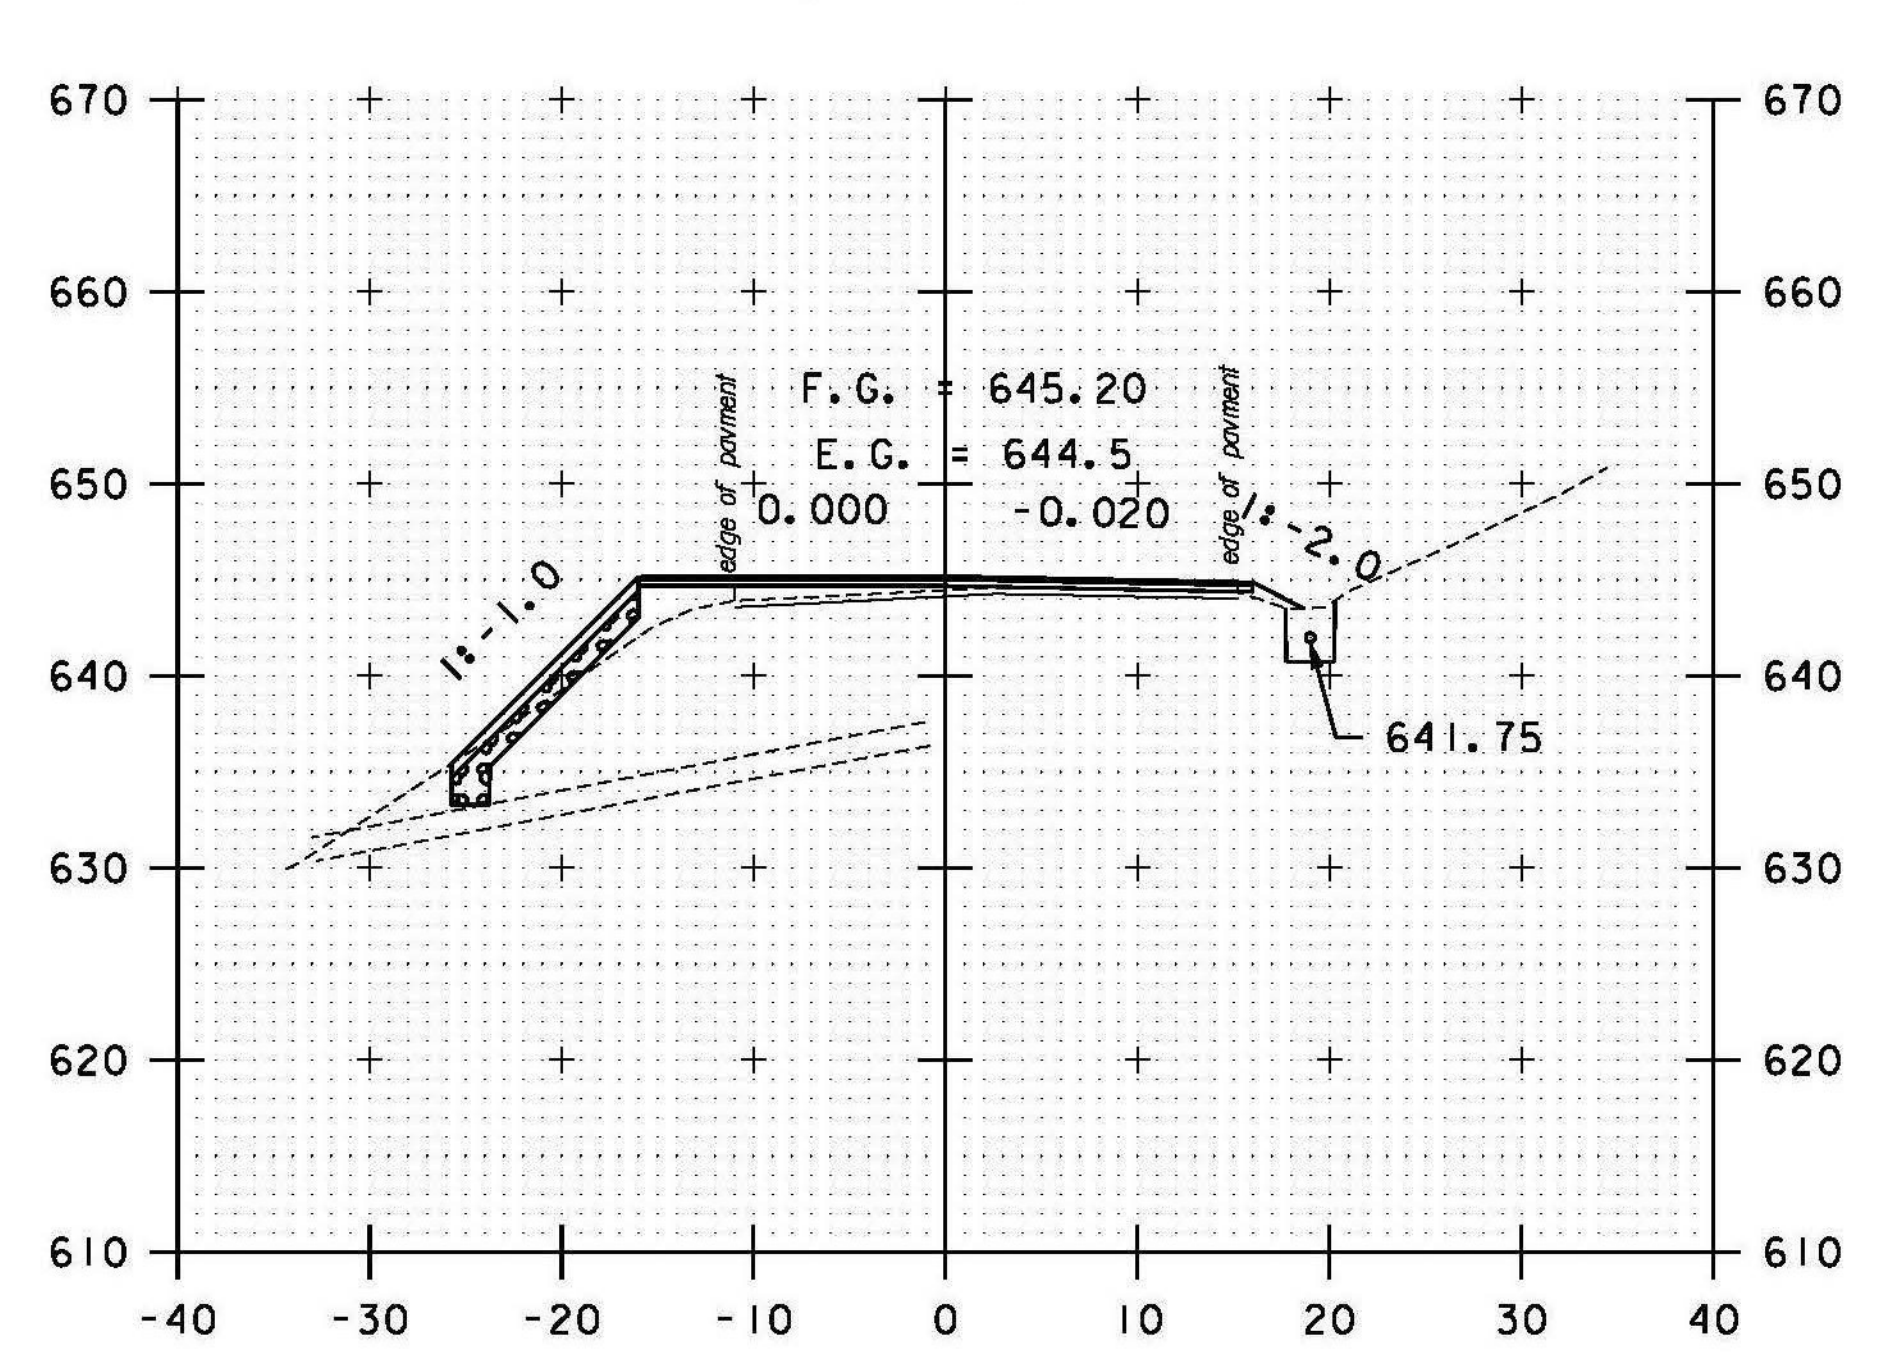
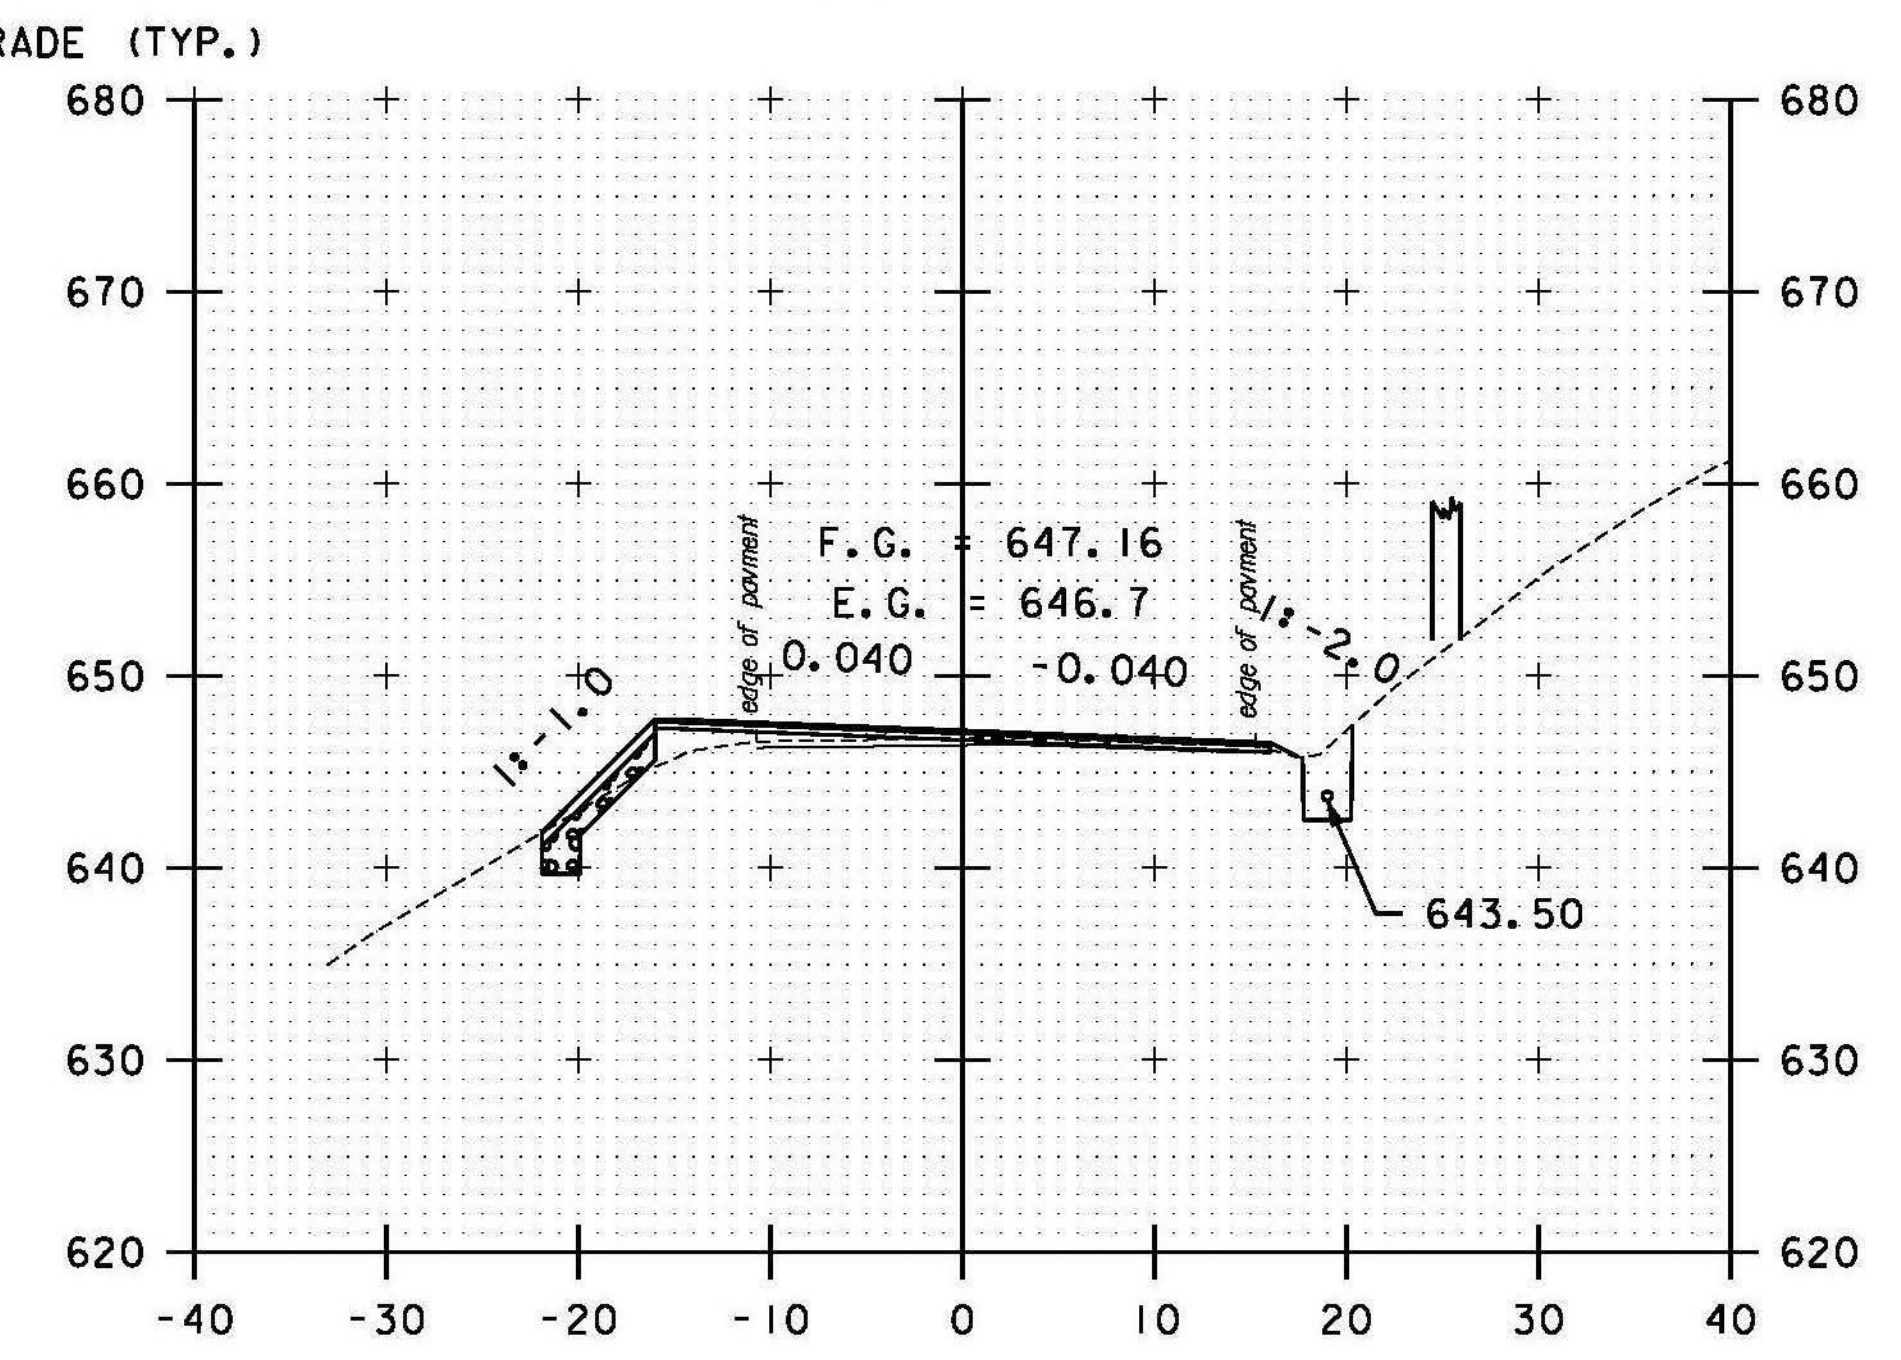
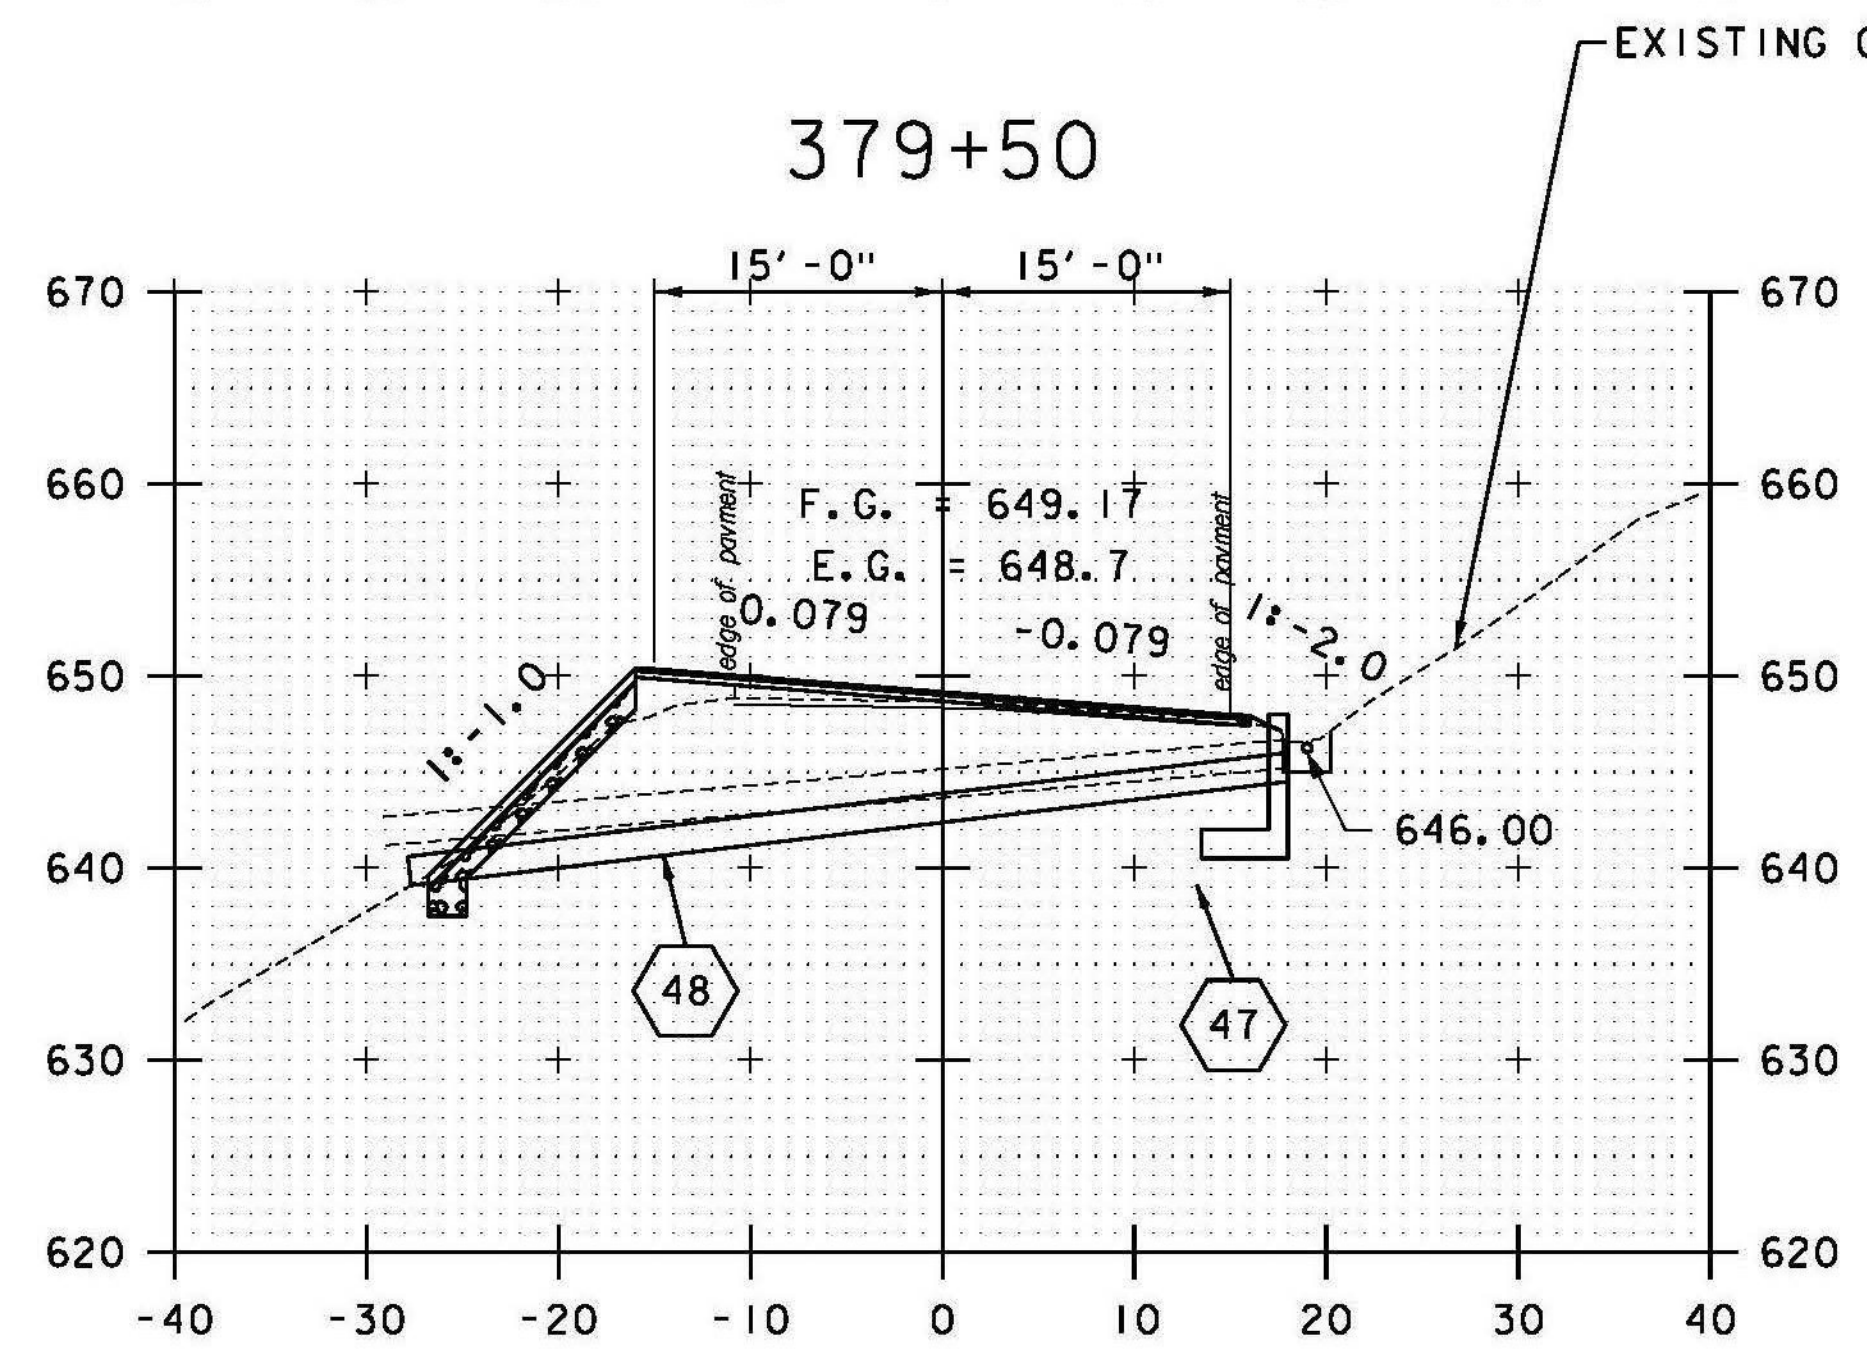
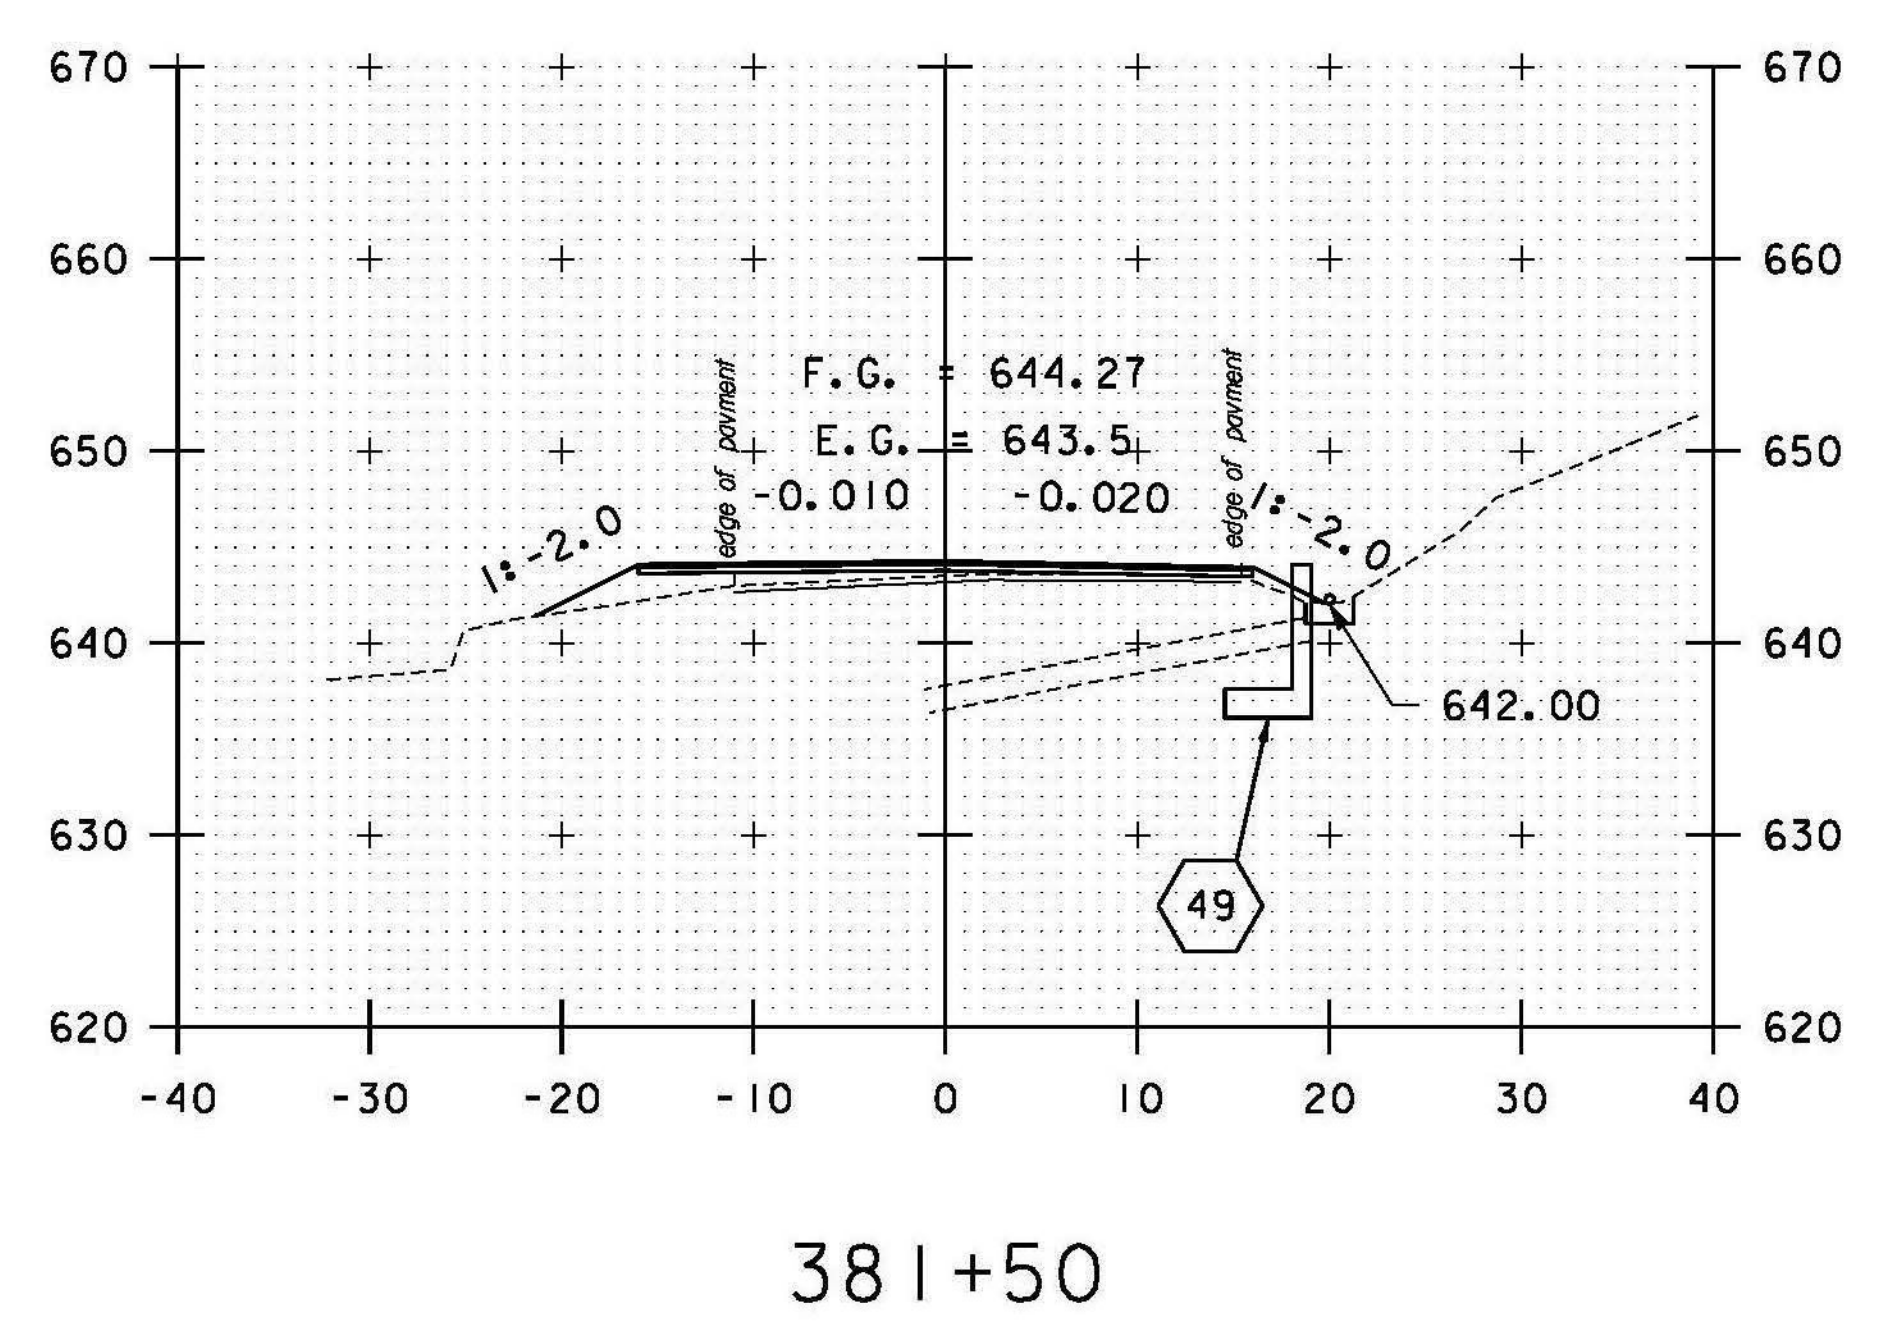
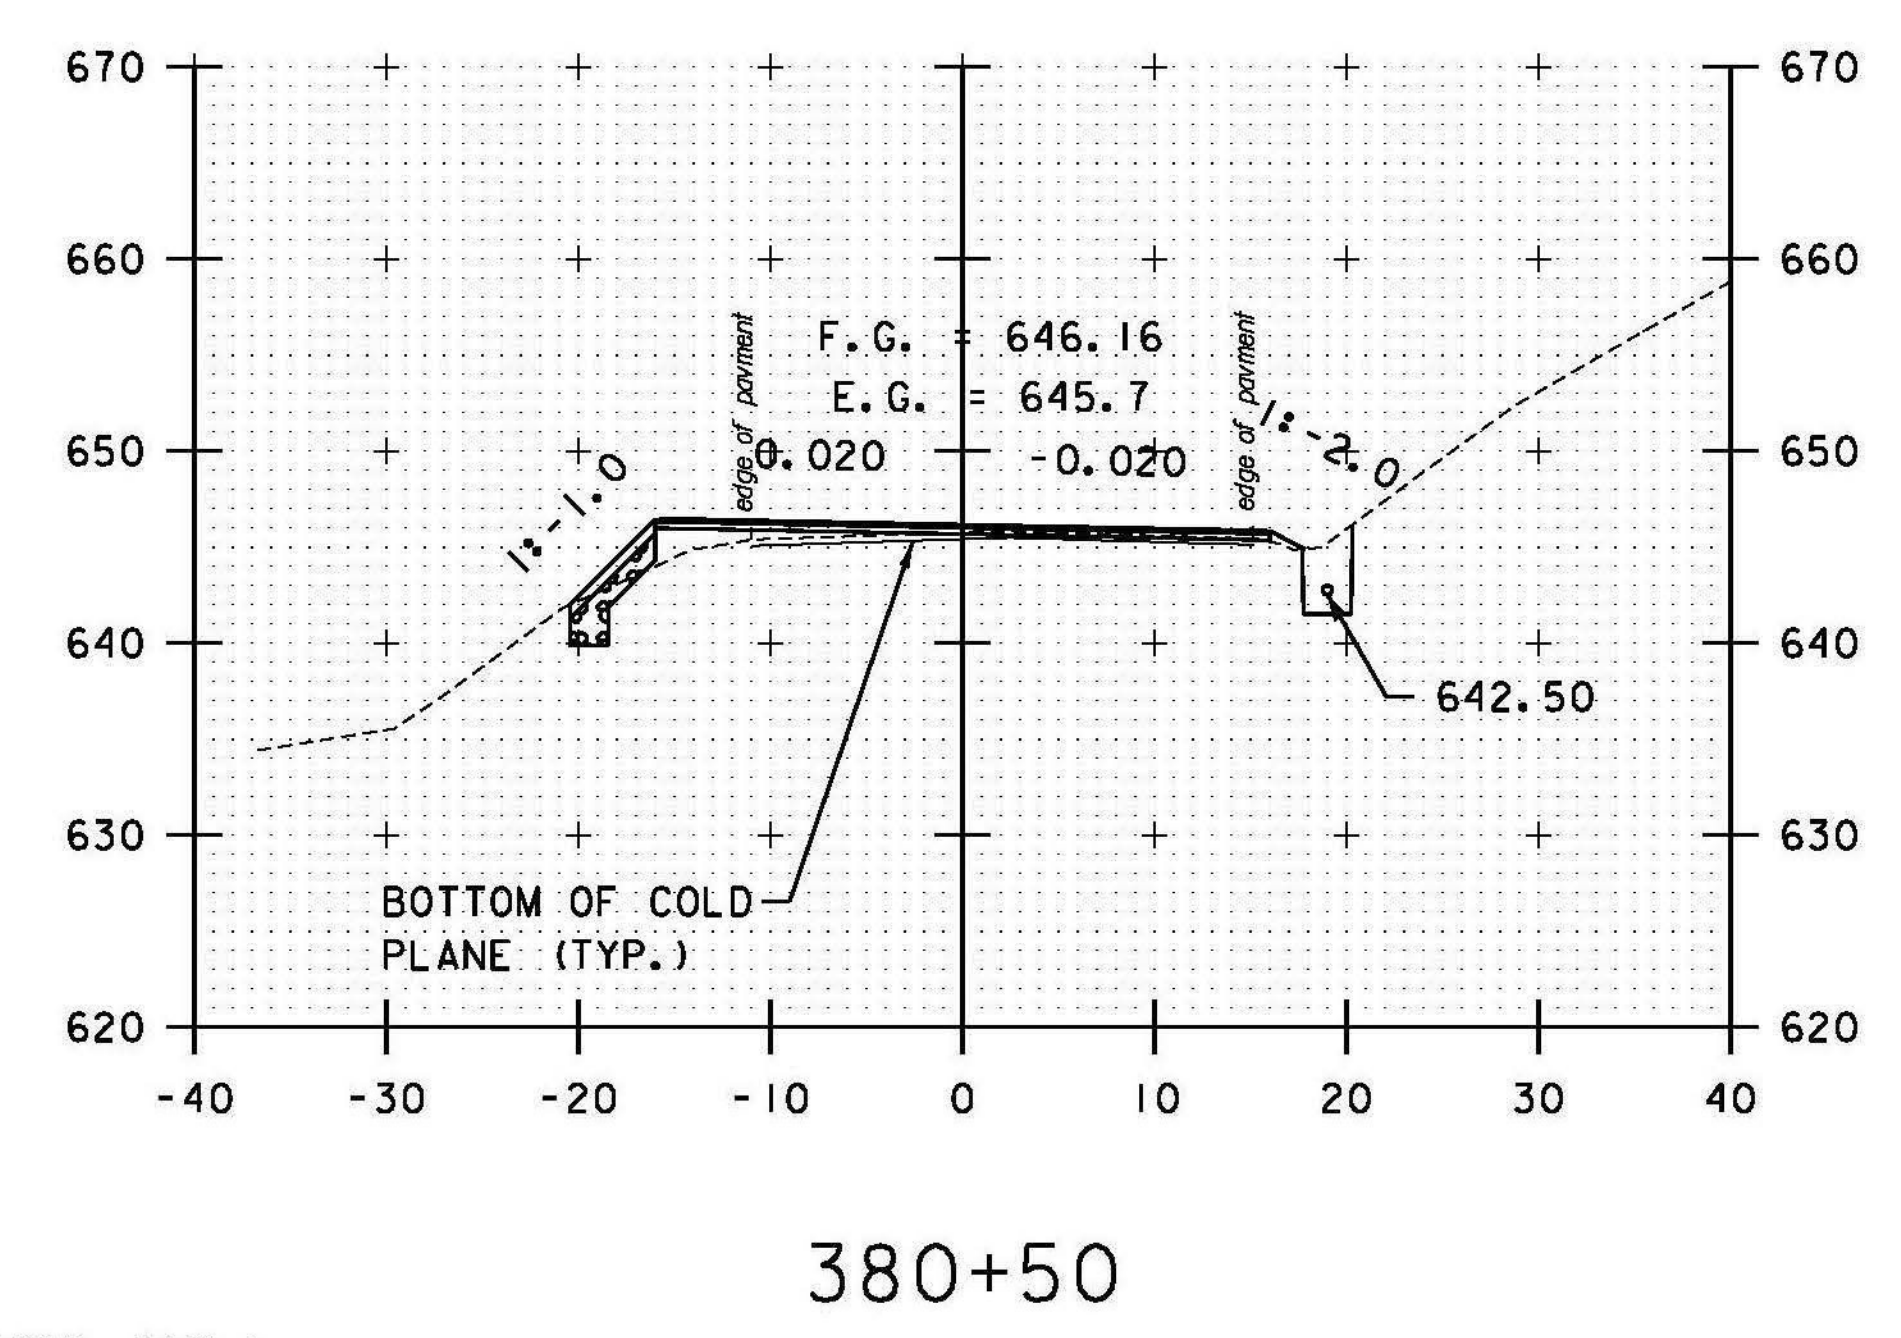


49 STA. 381+20.34 RT 18.06' TO  
 STA. 381+30.32 RT 18.06'  
 CONSTRUCT CONCRETE REINFORCED  
 HEADWALL PER STD. D-33  
 USE SCHEDULING AND DIMENSIONS  
 FOR 30" PIPE WITH 2'-9" HEADER  
 ABOVE PIPE

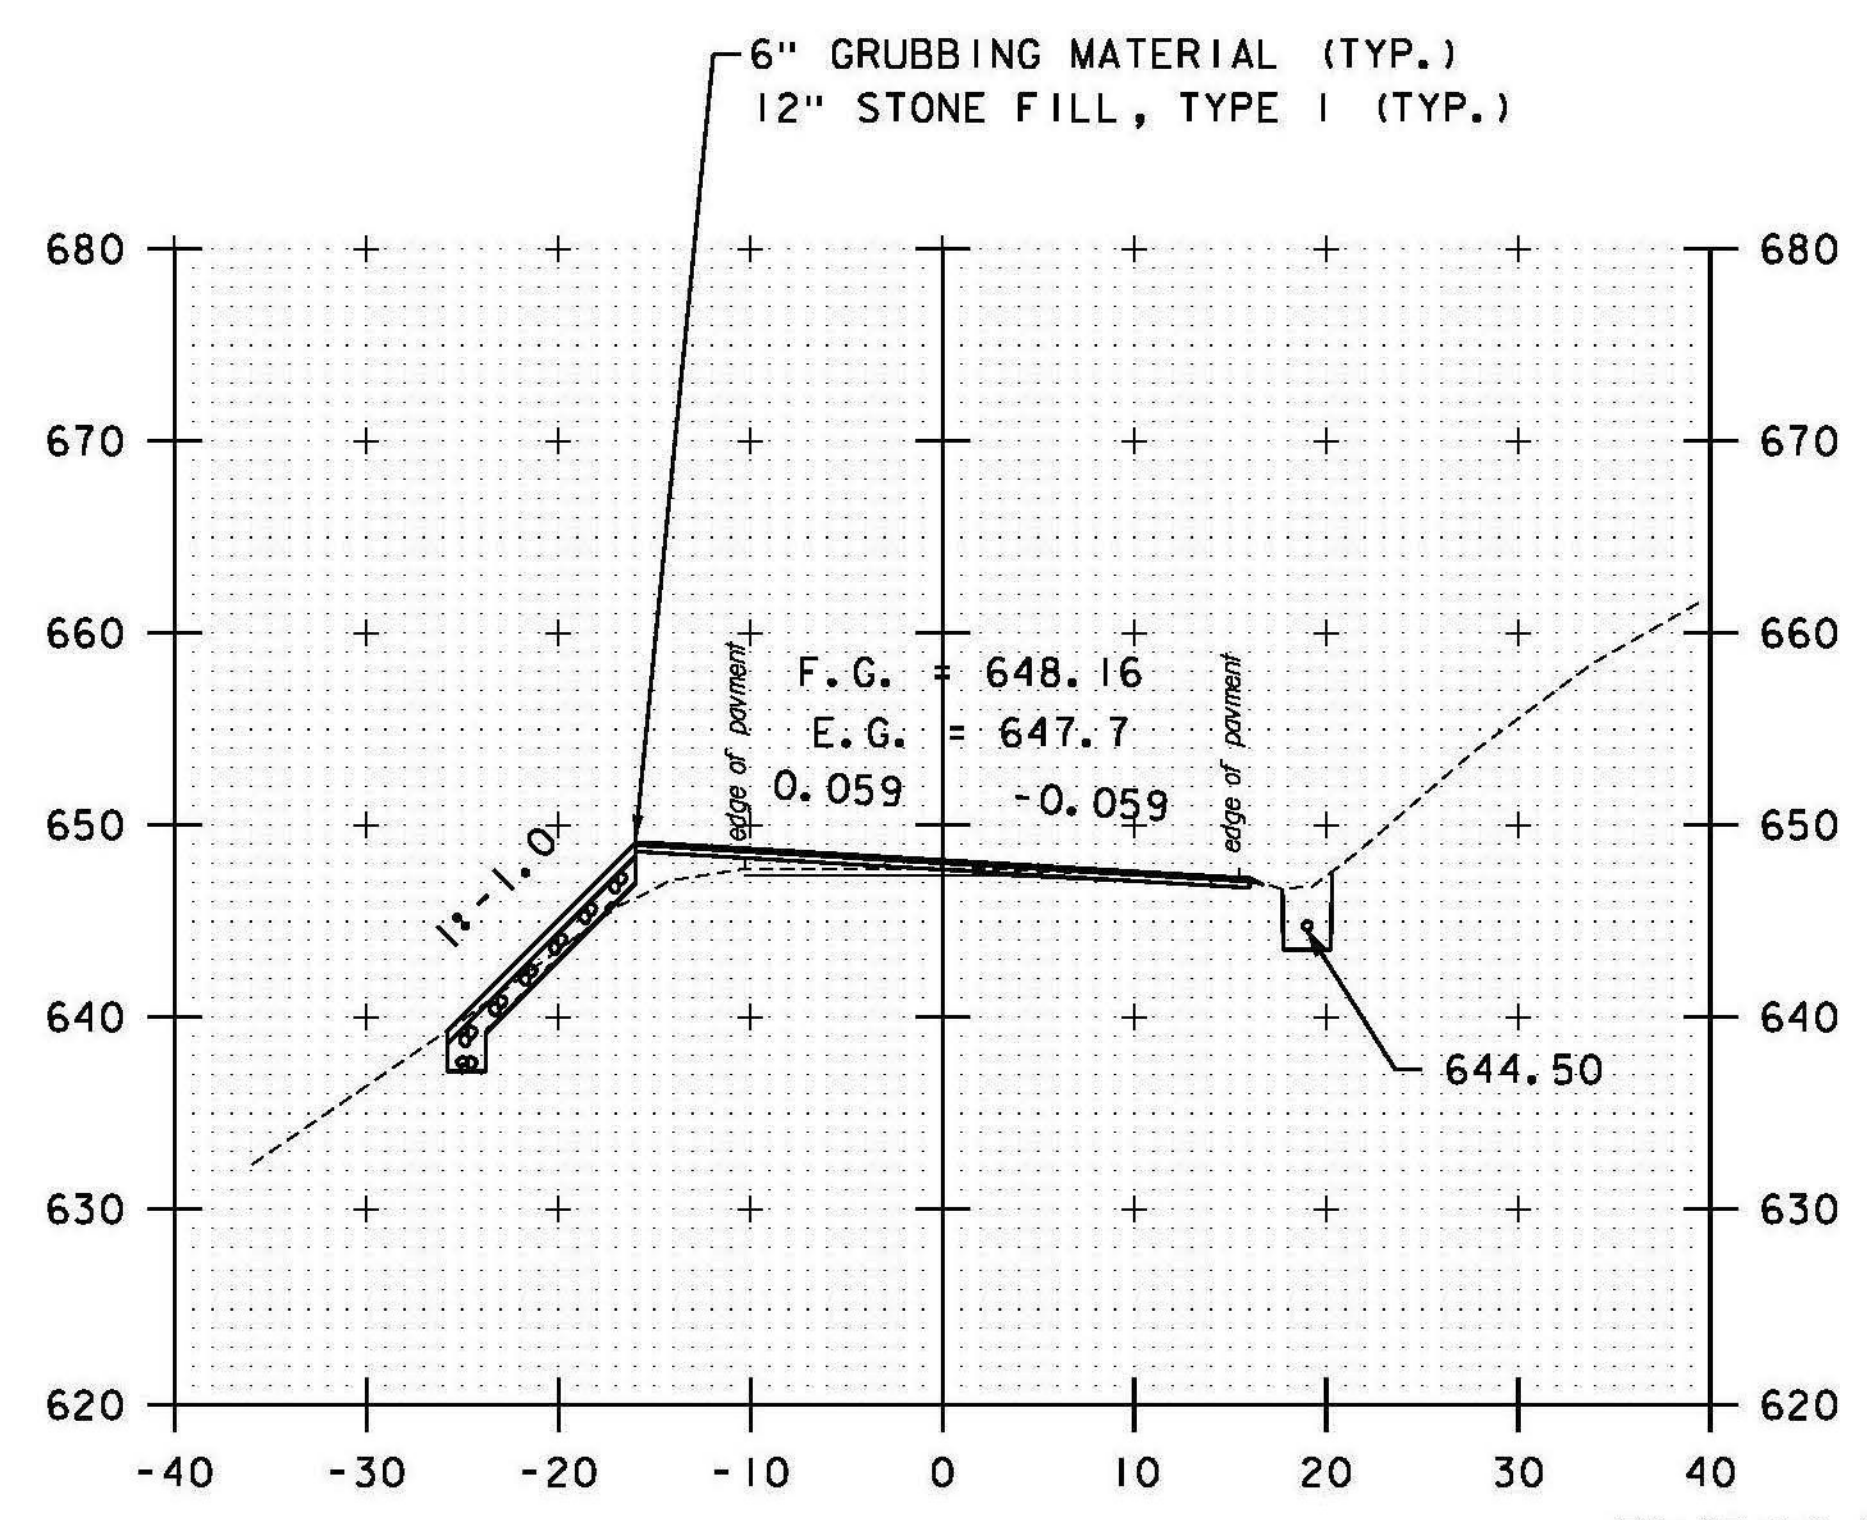

48 STA. 378+78.14 RT 18.00' TO  
 STA. 378+85.35 LT 27.66'  
 REMOVE EXISTING PIPE  
 INSTALL 18" CPEP (47'-0")  
 INV. IN = 644.50'  
 INV. OUT = 639.10'

379+00


47 STA. 378+73.07 RT 16.99' TO  
 STA. 378+83.22 RT 16.99'  
 REMOVE HEADWALL  
 CONSTRUCT CONCRETE REINFORCED  
 HEADWALL PER STD. D-33  
 USE SCHEDULING AND DIMENSIONS  
 FOR 30" PIPE WITH 2'-0" HEADER  
 ABOVE PIPE

380+00

STA. 379+00 TO STA. 381+50

381+00

DATUM  
 VERTICAL NAVD 88  
 HORIZONTAL NAD 83 (07)

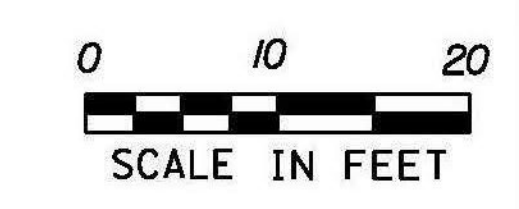

PROJECT NAME: RANDOLPH  
 PROJECT NUMBER: STP 2932 (1)  
 FILE NAME: z10c270.dgn  
 PROJECT LEADER: C. LATHROP  
 DESIGNED BY: B. BRESLEND  
 VT 66 CROSS SECTION SHEET 83  
 PLOT DATE: 6/5/2014  
 DRAWN BY: B. BRESLEND  
 CHECKED BY: C. LATHROP  
 SHEET 239 OF 276