


STA. 382+00 TO STA. 384+50

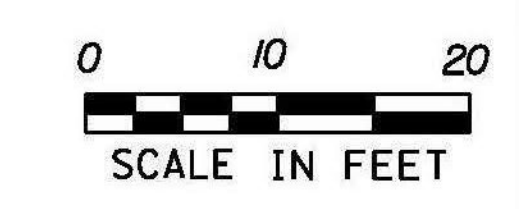

| | |
|------------------------------|------------------------|
| PROJECT NAME: RANDOLPH | |
| PROJECT NUMBER: STP 2932 (1) | |
| FILE NAME: z10c270.dgn | PLOT DATE: 6/5/2014 |
| PROJECT LEADER: C. LATHROP | DRAWN BY: B. BRESLEND |
| DESIGNED BY: B. BRESLEND | CHECKED BY: C. LATHROP |
| VT 66 CROSS SECTION SHEET 84 | SHEET 240 OF 276 |

DATUM
VERTICAL NAVD 88
HORIZONTAL NAD 83 (07)