

385+00


50 STA. 387+47.59 RT 31.85' TO
STA. 387+48.69 RT 25.97'
EXTEND 24" CSP (6'-0")
INV. OUT = 618.07'

386+00

STA. 385+00 TO STA. 388+00

387+00

DATUM
VERTICAL NAVD 88
HORIZONTAL NAD 83 (07)

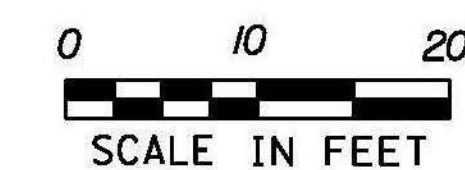

PROJECT NAME: RANDOLPH
PROJECT NUMBER: STP 2932 (I)

FILE NAME: z10c270.dgn
PROJECT LEADER: C. LATHROP
DESIGNED BY: B. BRESLEND
VT 66 CROSS SECTION SHEET 85

PLOT DATE: 6/5/2014
DRAWN BY: B. BRESLEND
CHECKED BY: C. LATHROP
SHEET 241 OF 276