




396+50

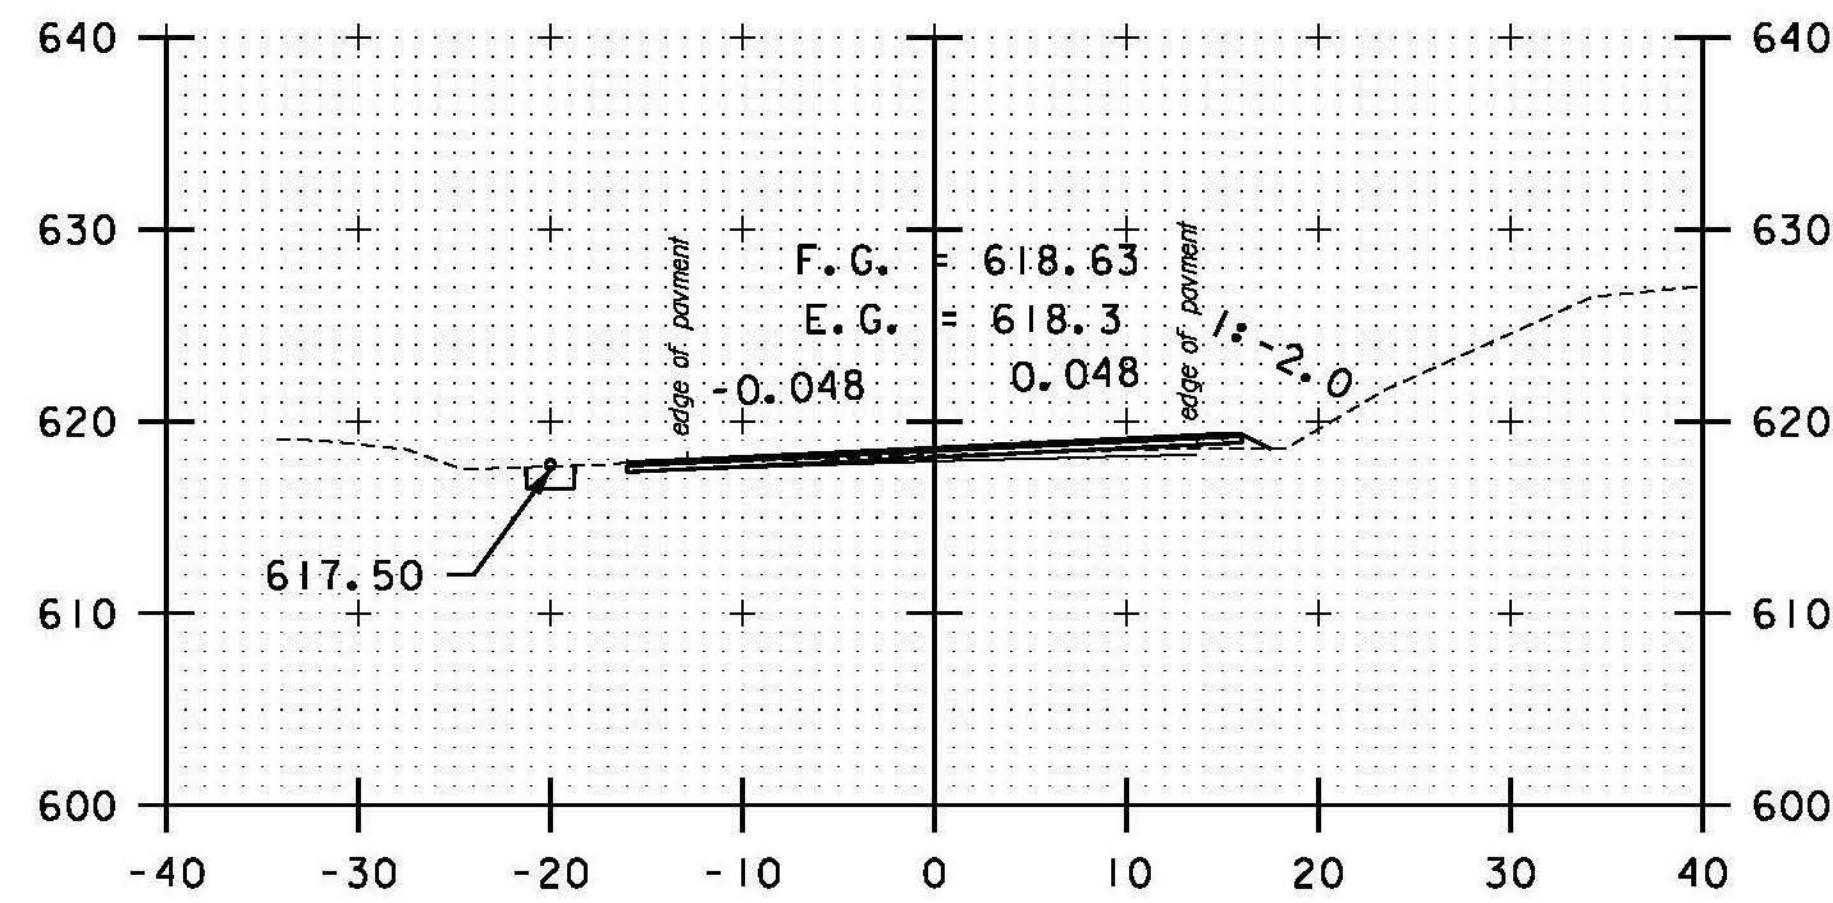


398+00

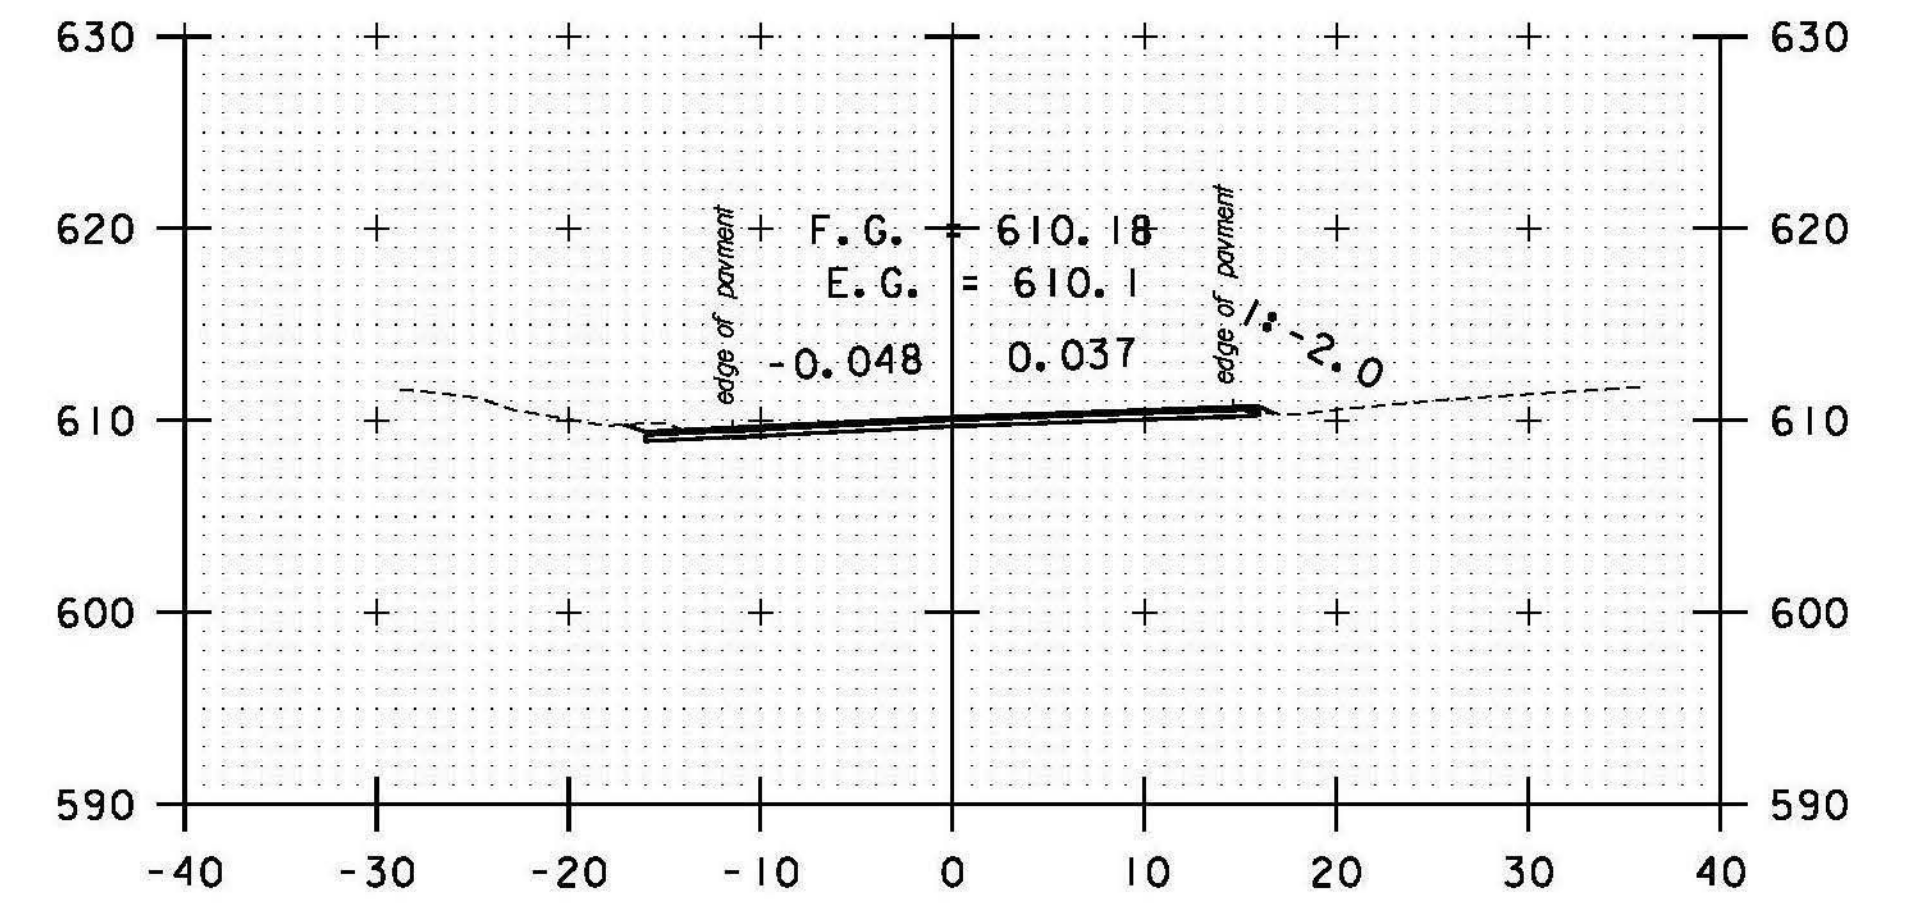


399+50

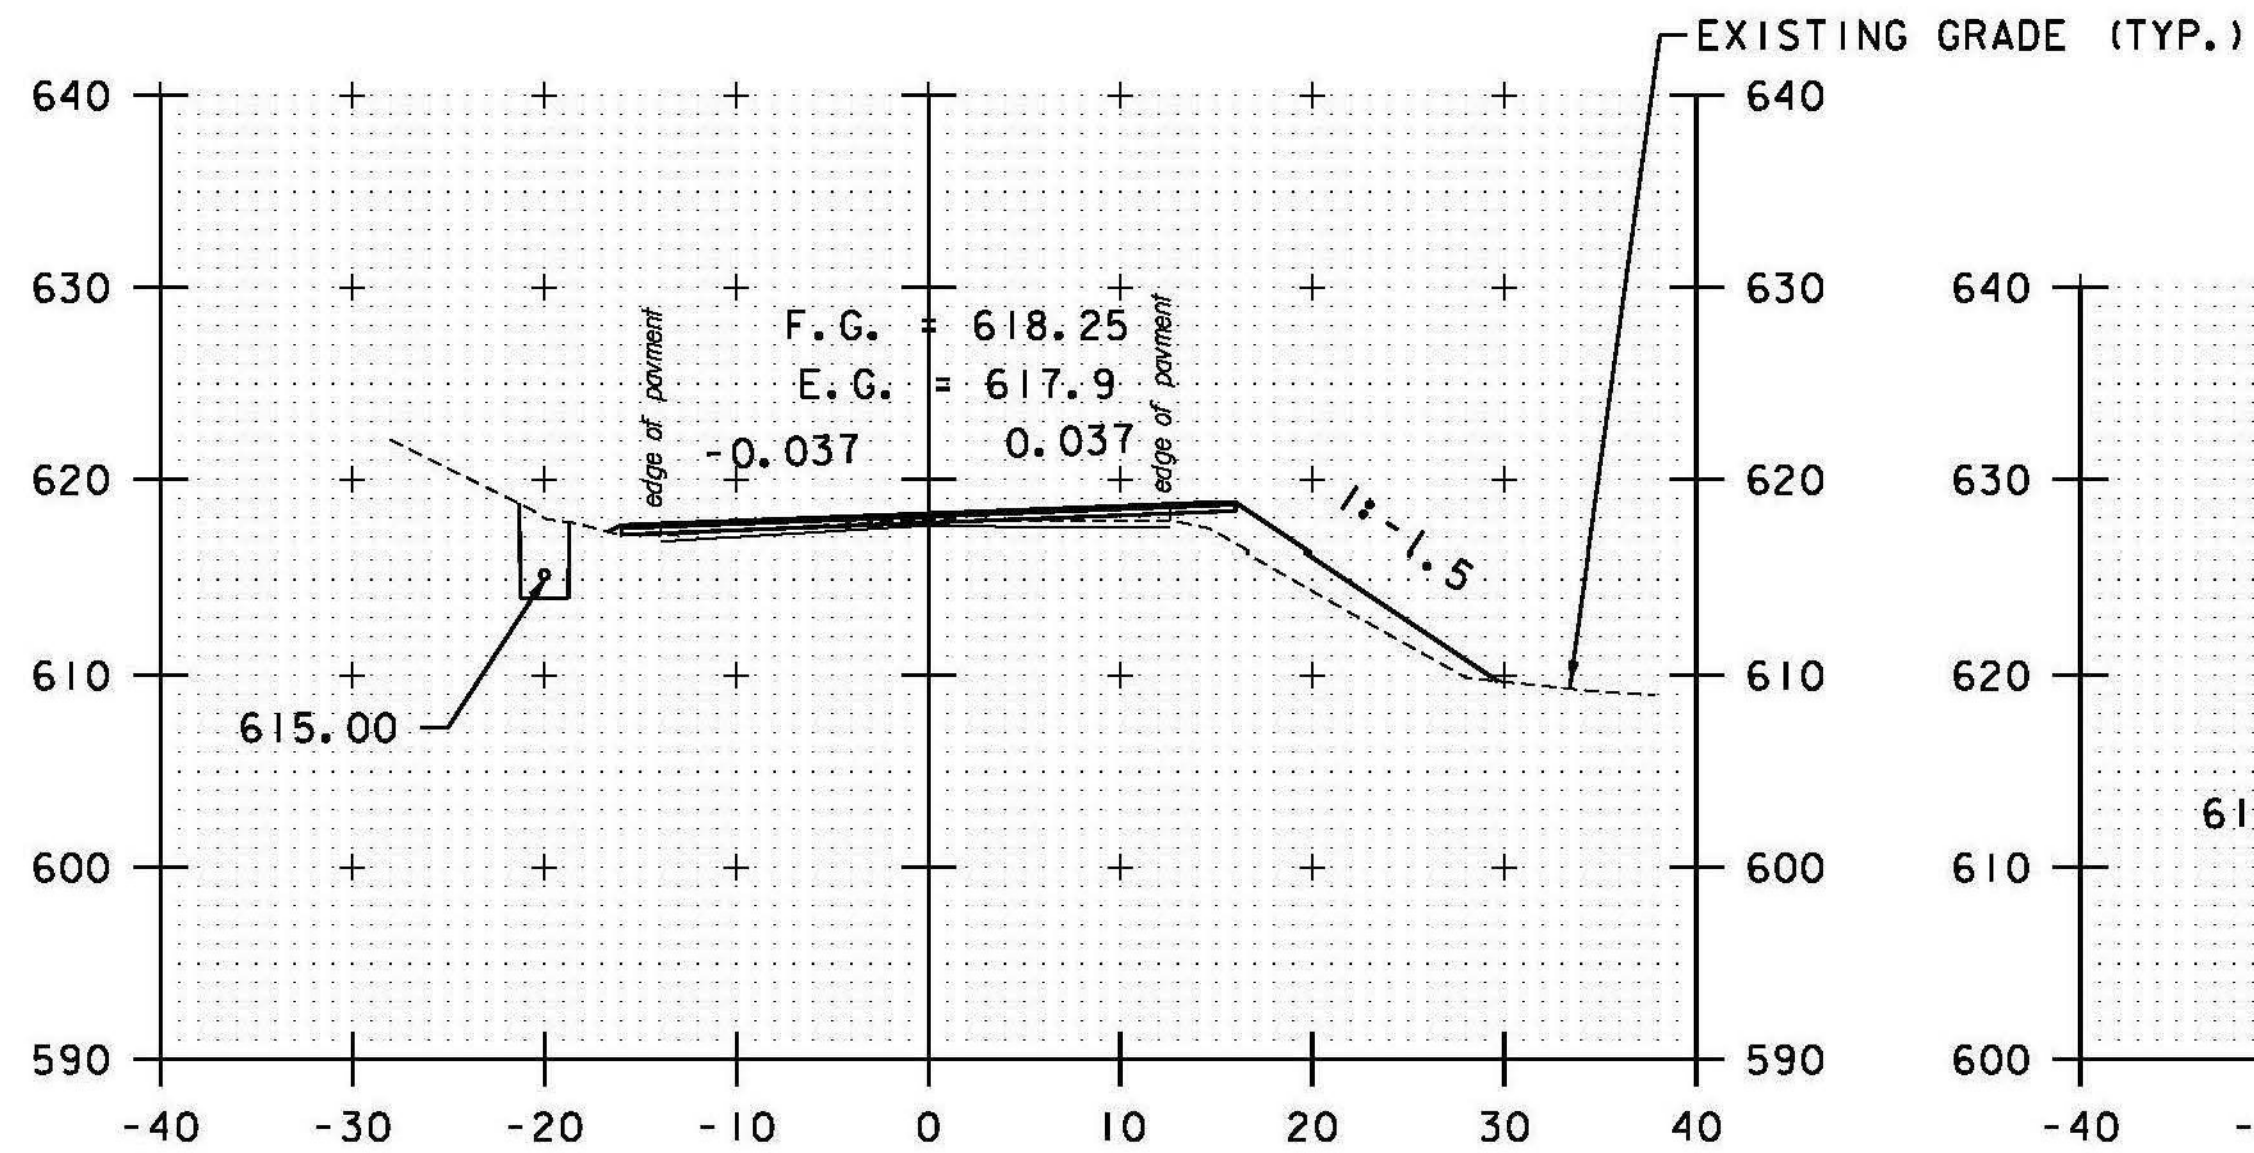


396+00

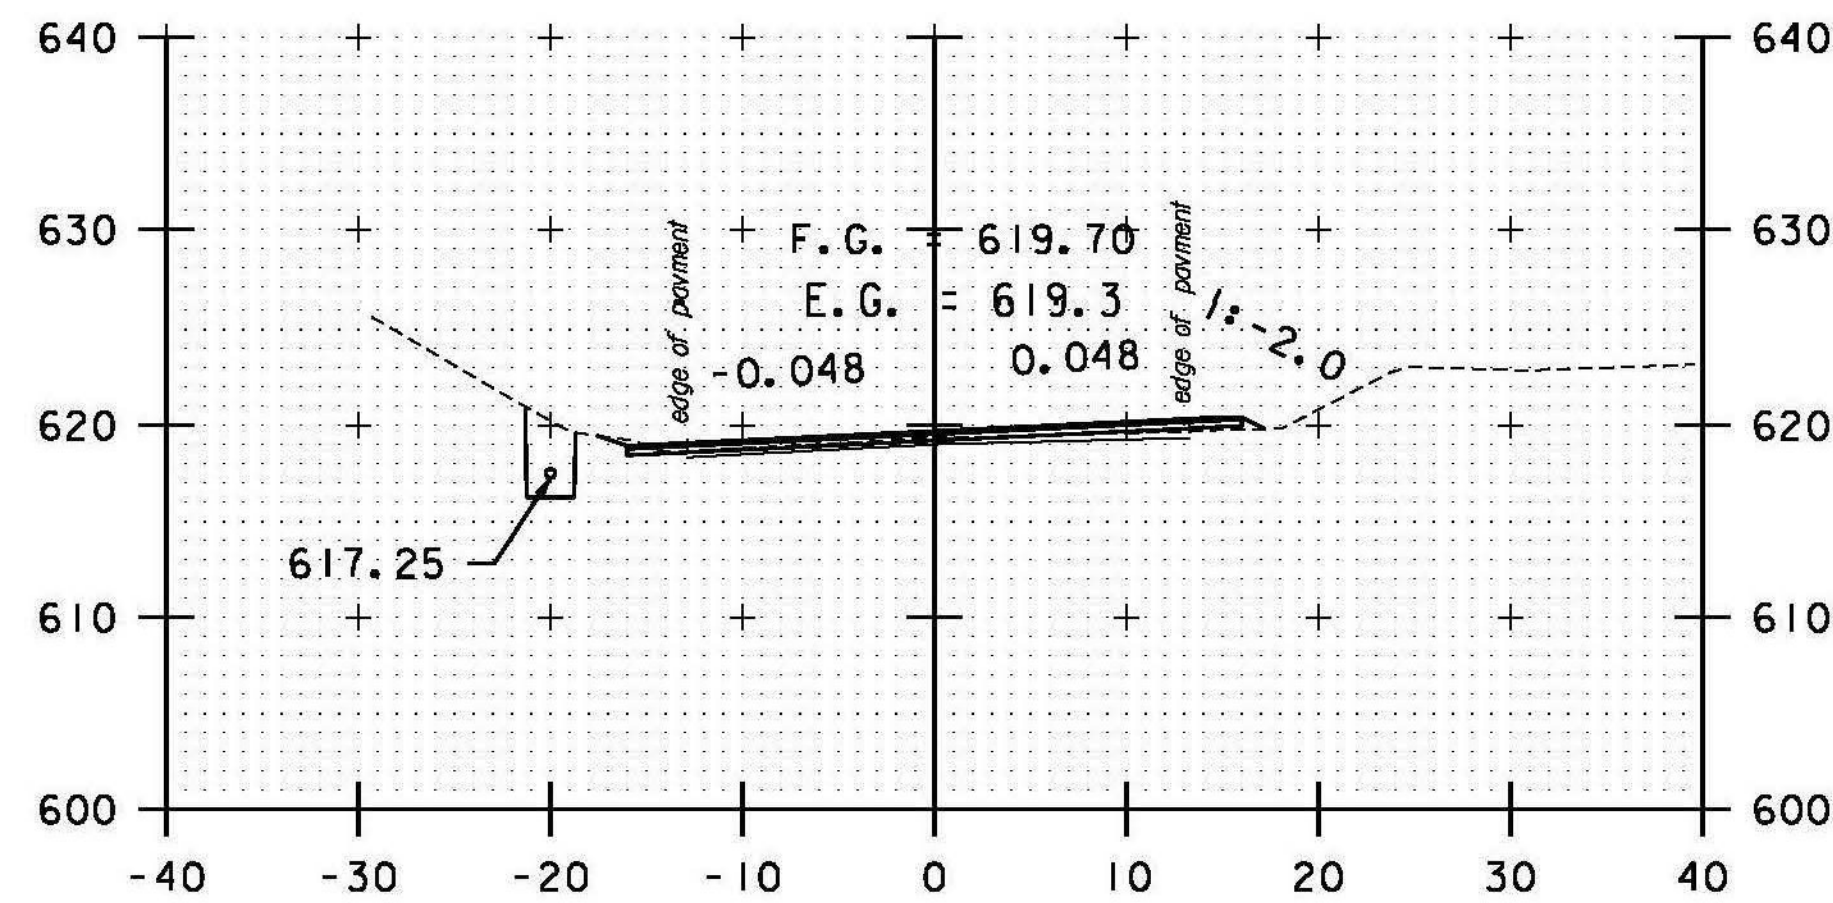


397+50

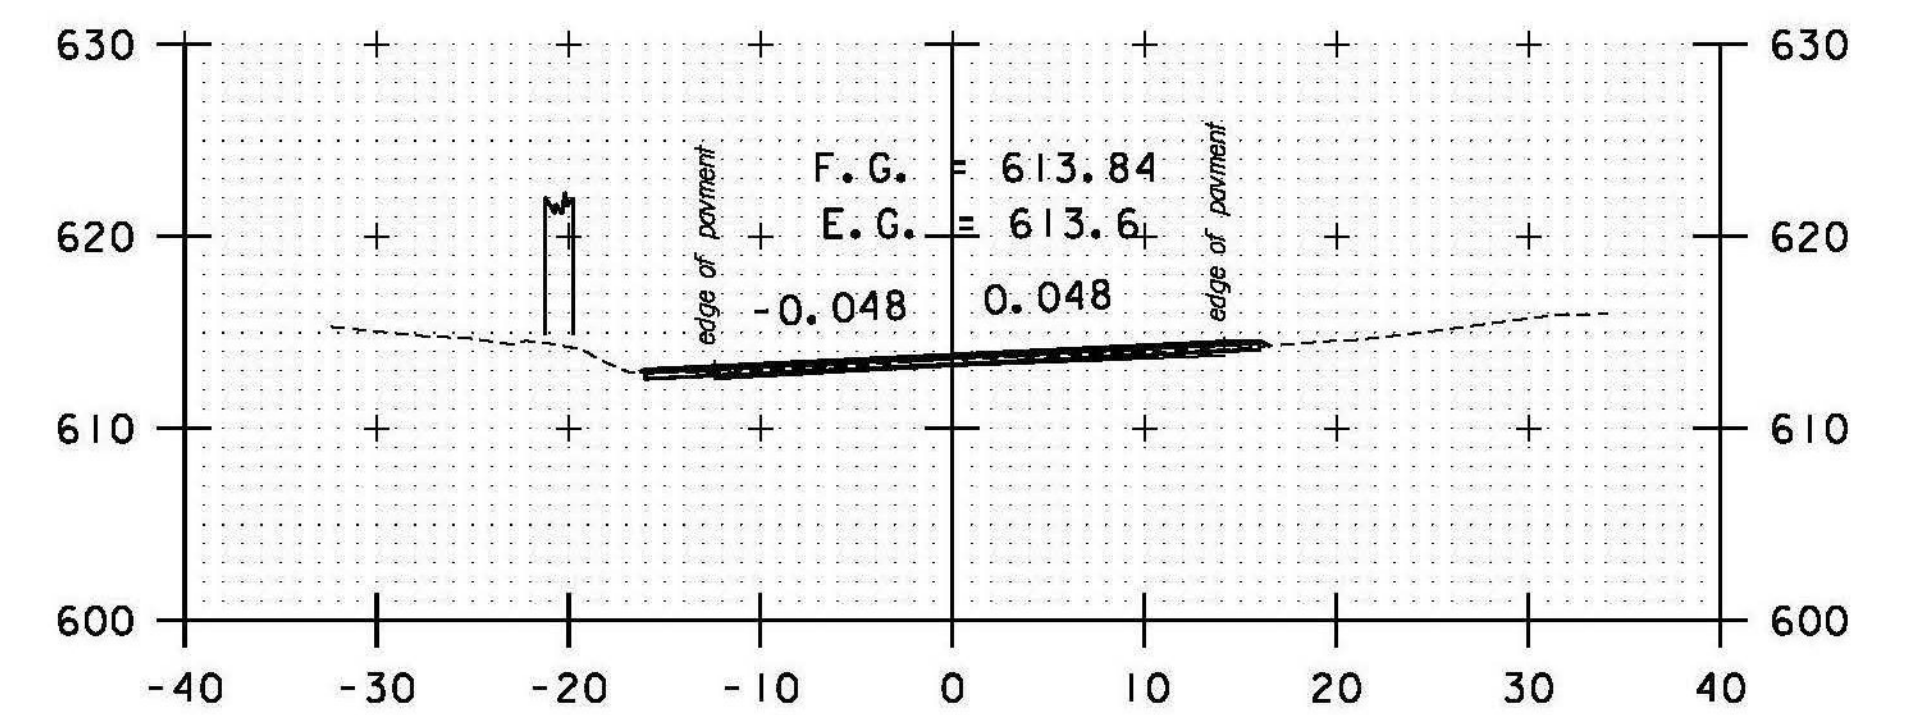


399+00

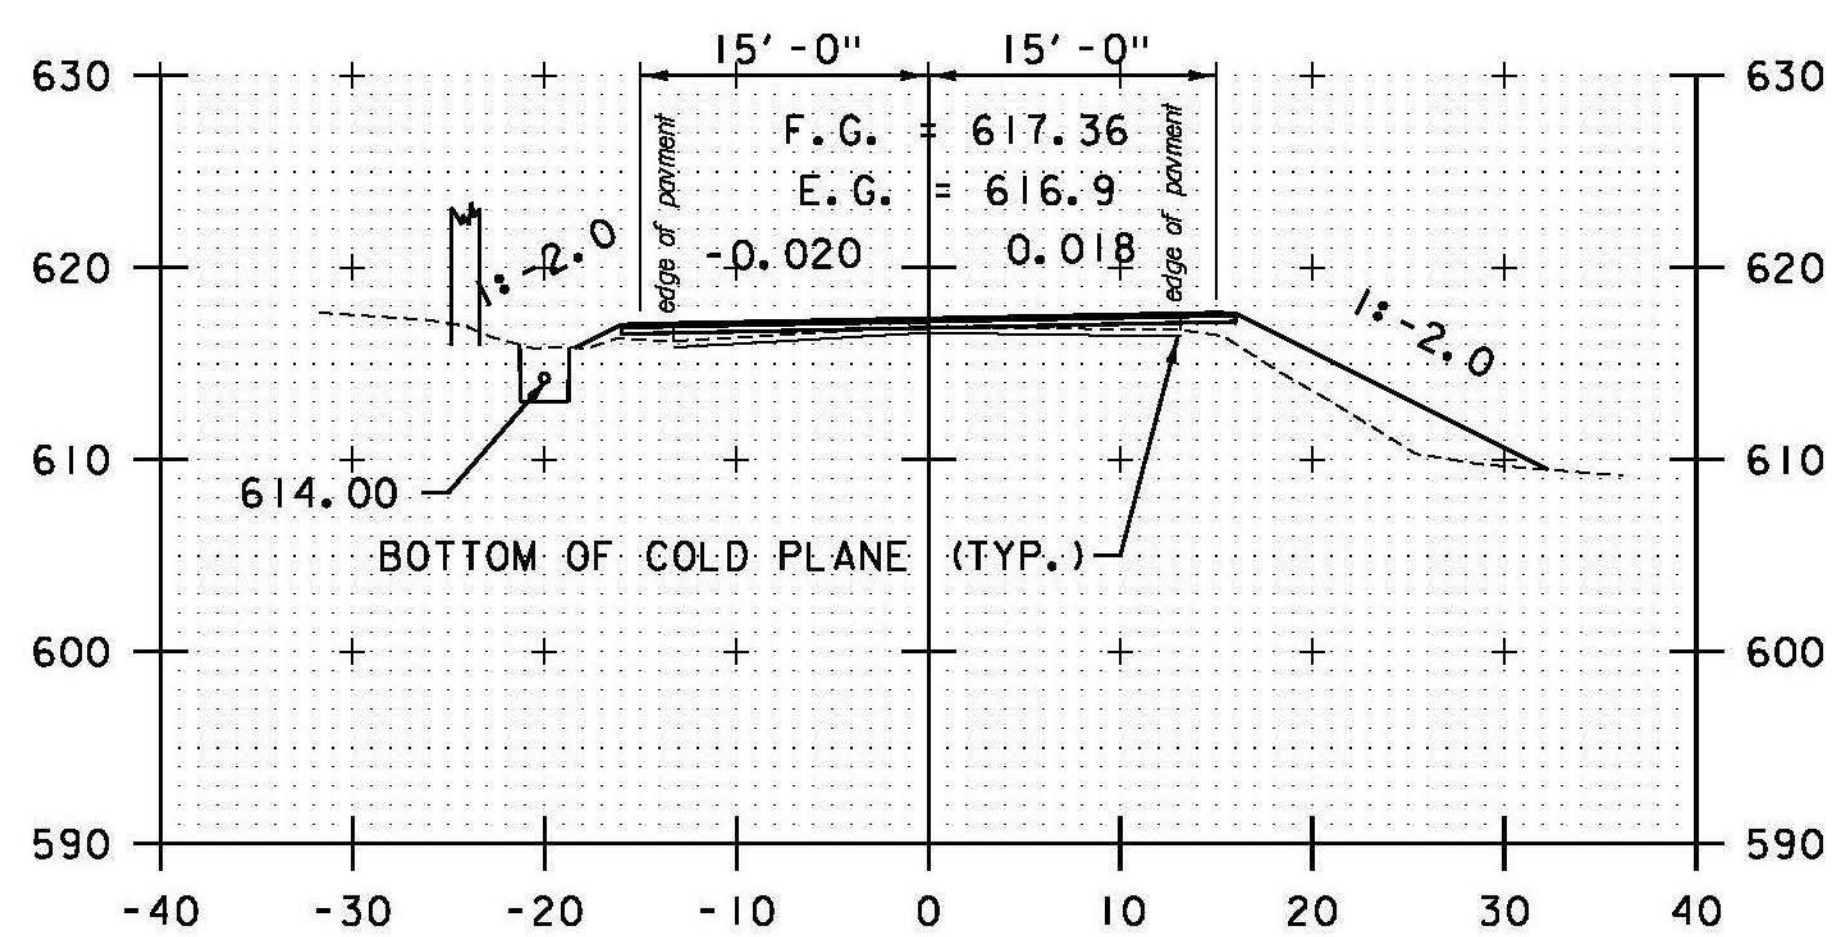

395+50

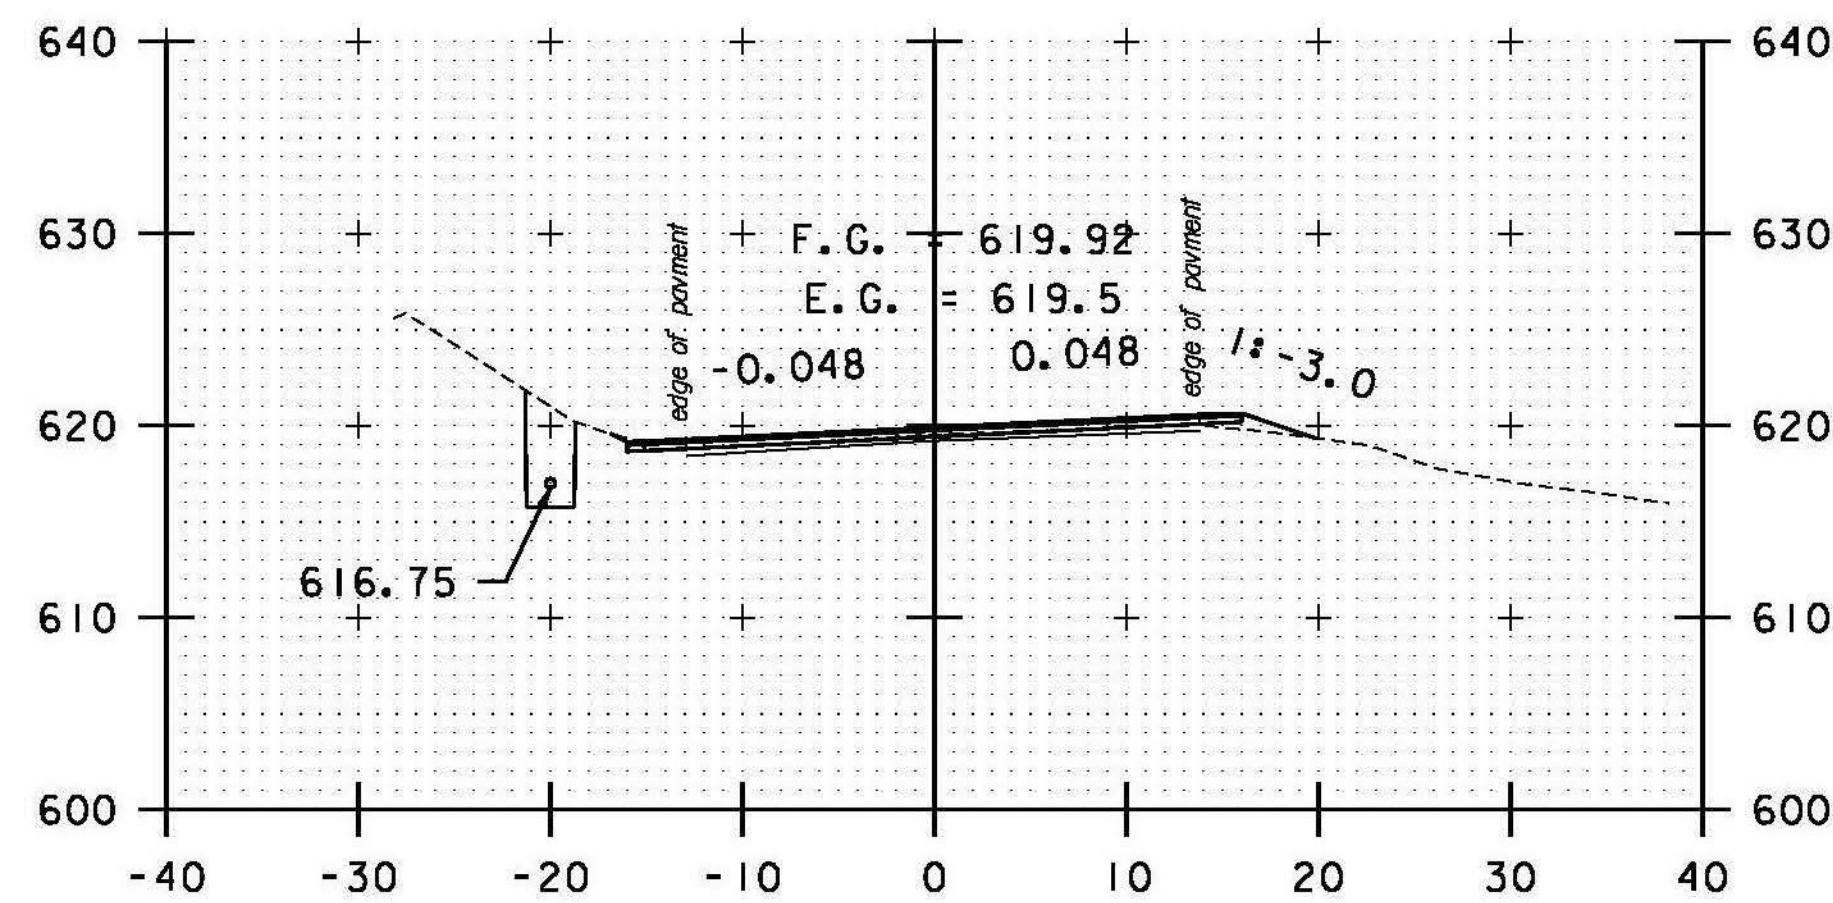


397+00

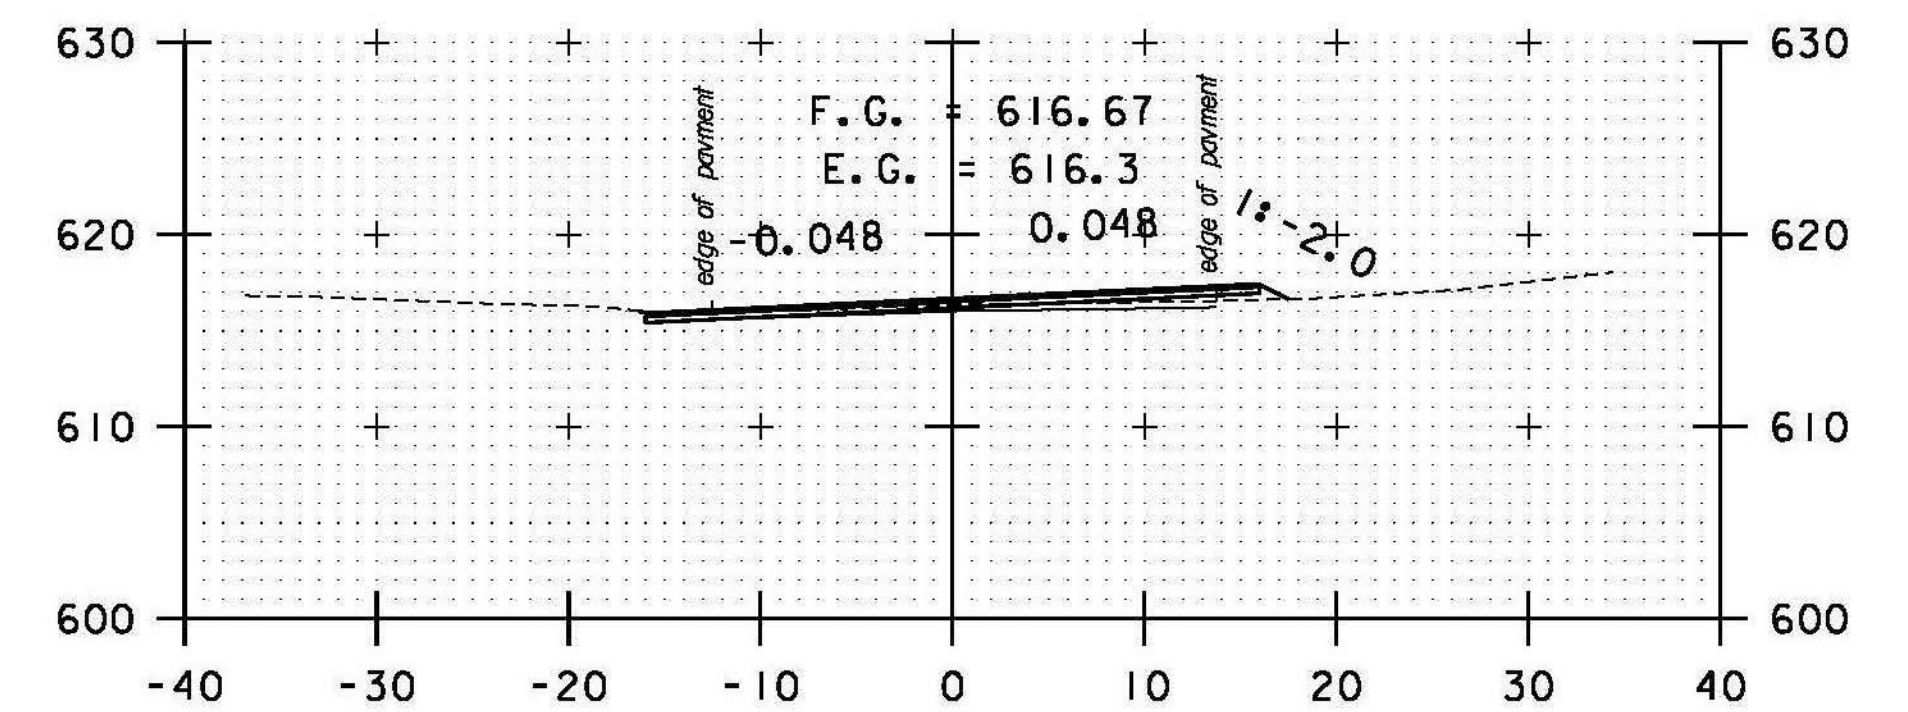

398+50

STA. 395+50 TO STA. 399+50

DATUM  
VERTICAL NAVD 88  
HORIZONTAL NAD 83 (07)

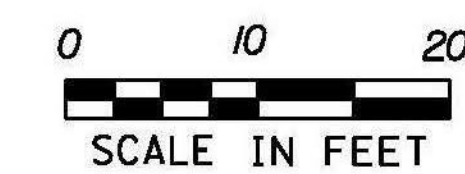

PROJECT NAME: RANDOLPH  
PROJECT NUMBER: STP 2932 (1)

FILE NAME: z10c270.dgn  
PROJECT LEADER: C. LATHROP  
DESIGNED BY: B. BRESLEND  
VT 66 CROSS SECTION SHEET 88

PLOT DATE: 6/5/2014  
DRAWN BY: B. BRESLEND  
CHECKED BY: C. LATHROP  
SHEET 244 OF 276