




DRIVE RT
401+00

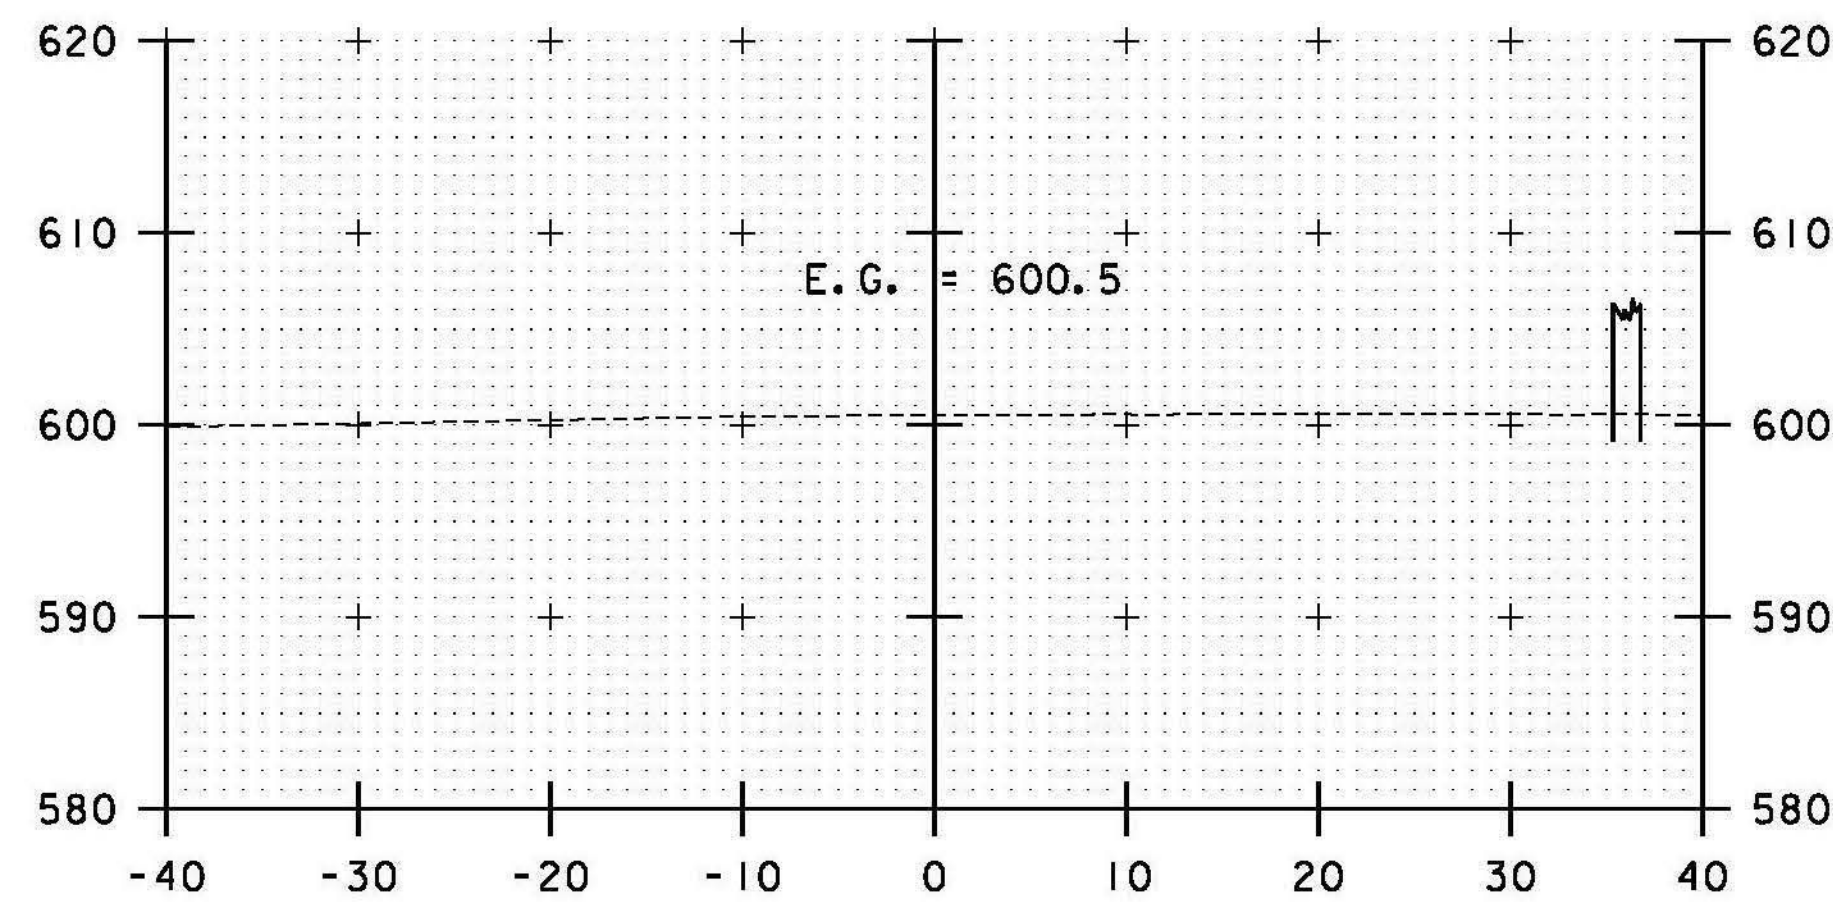


401+54

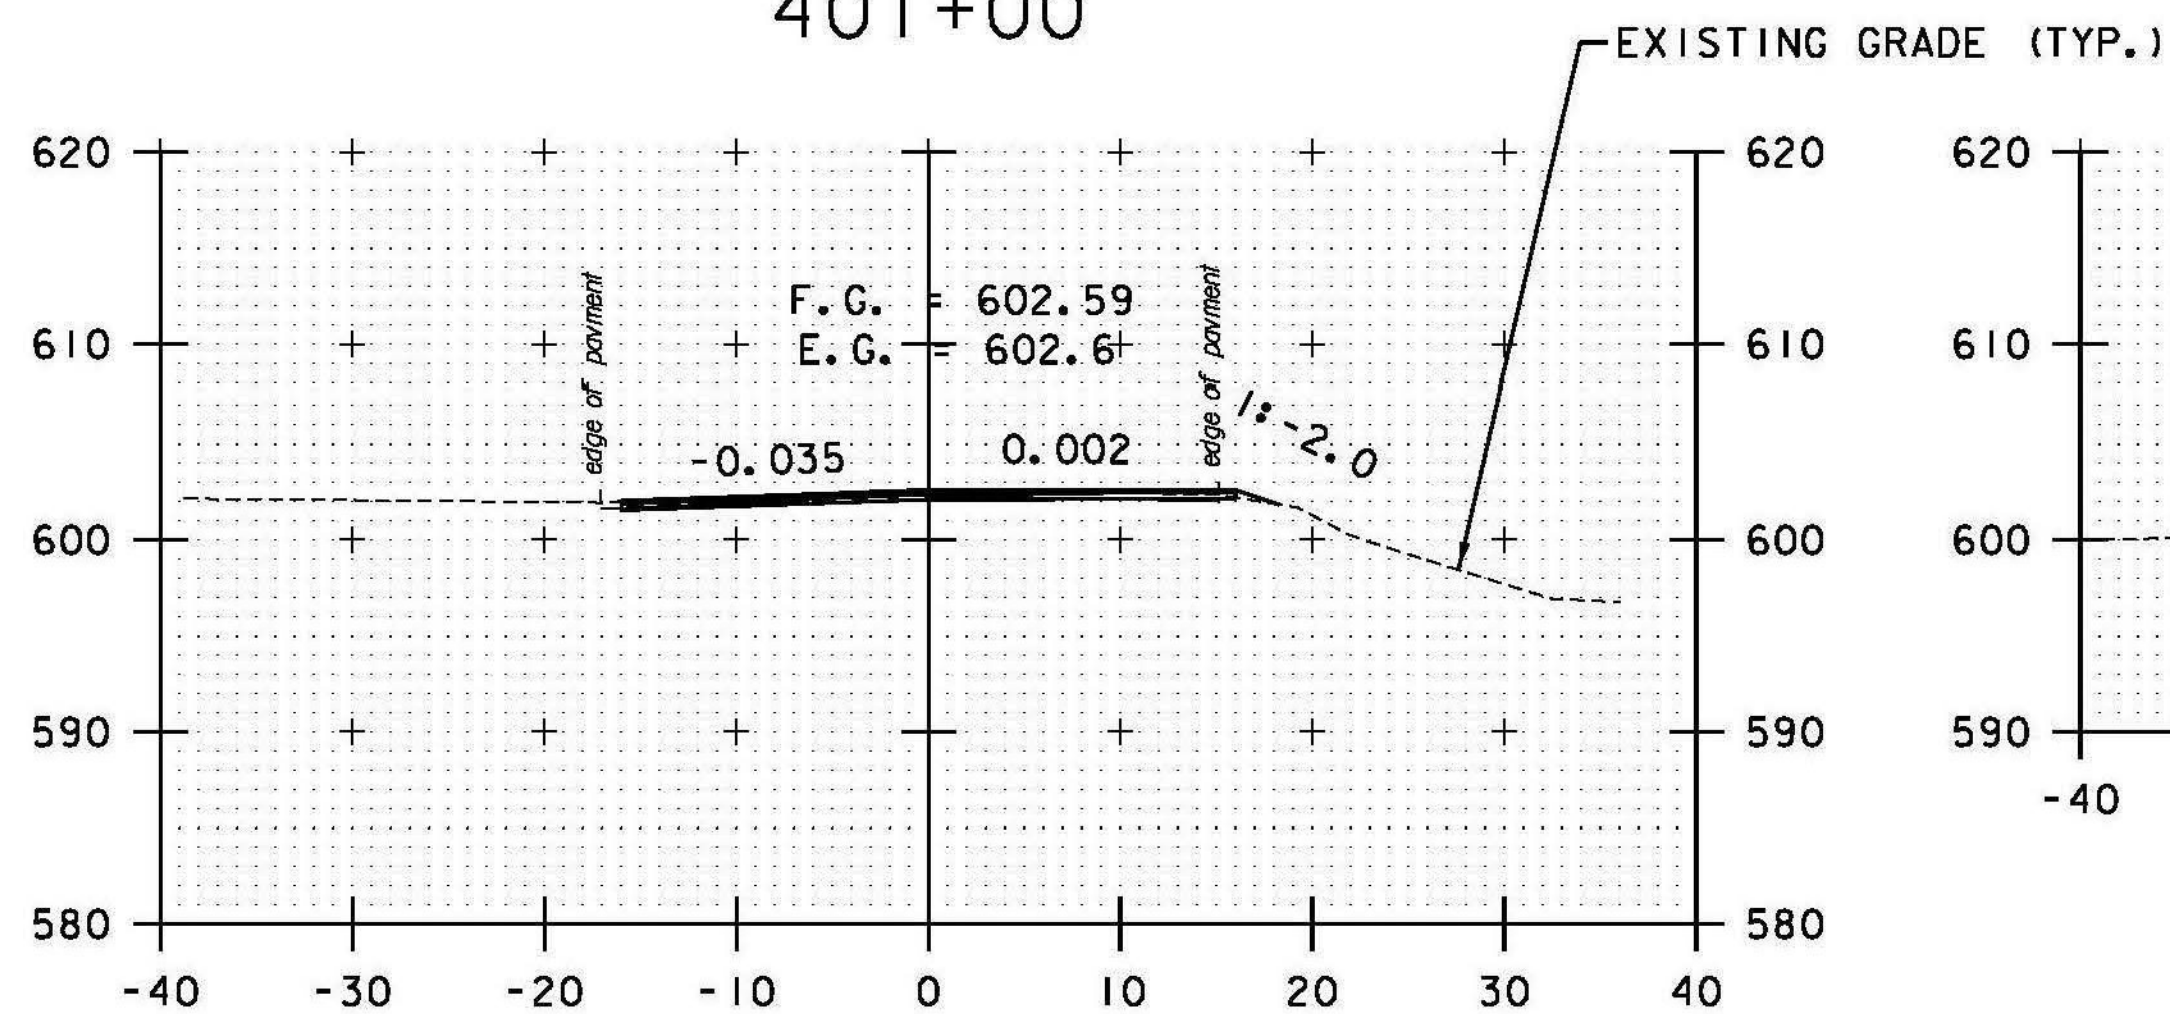


400+50

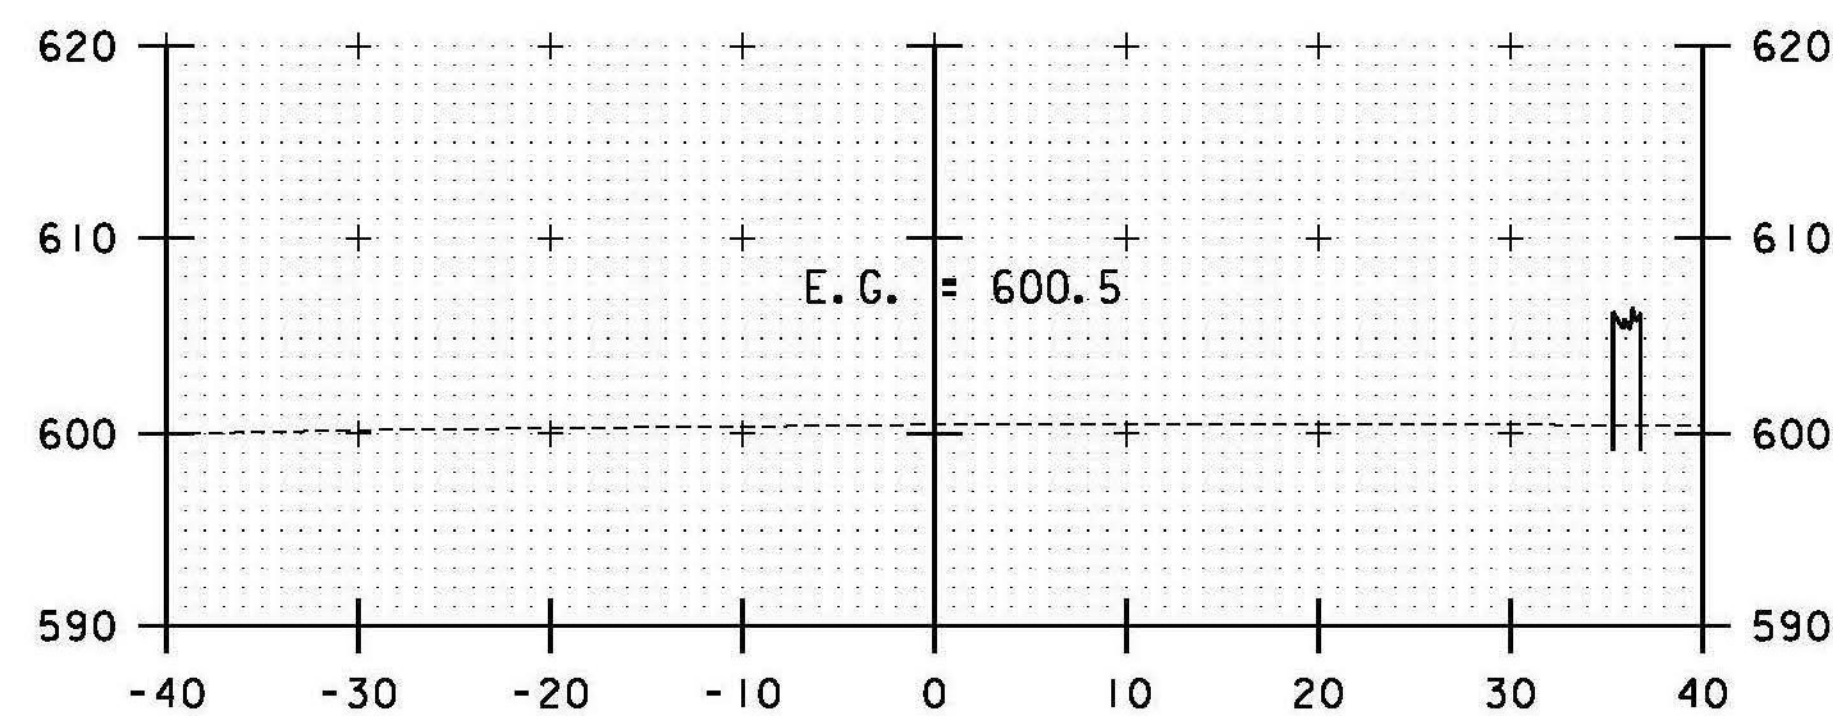

401+50

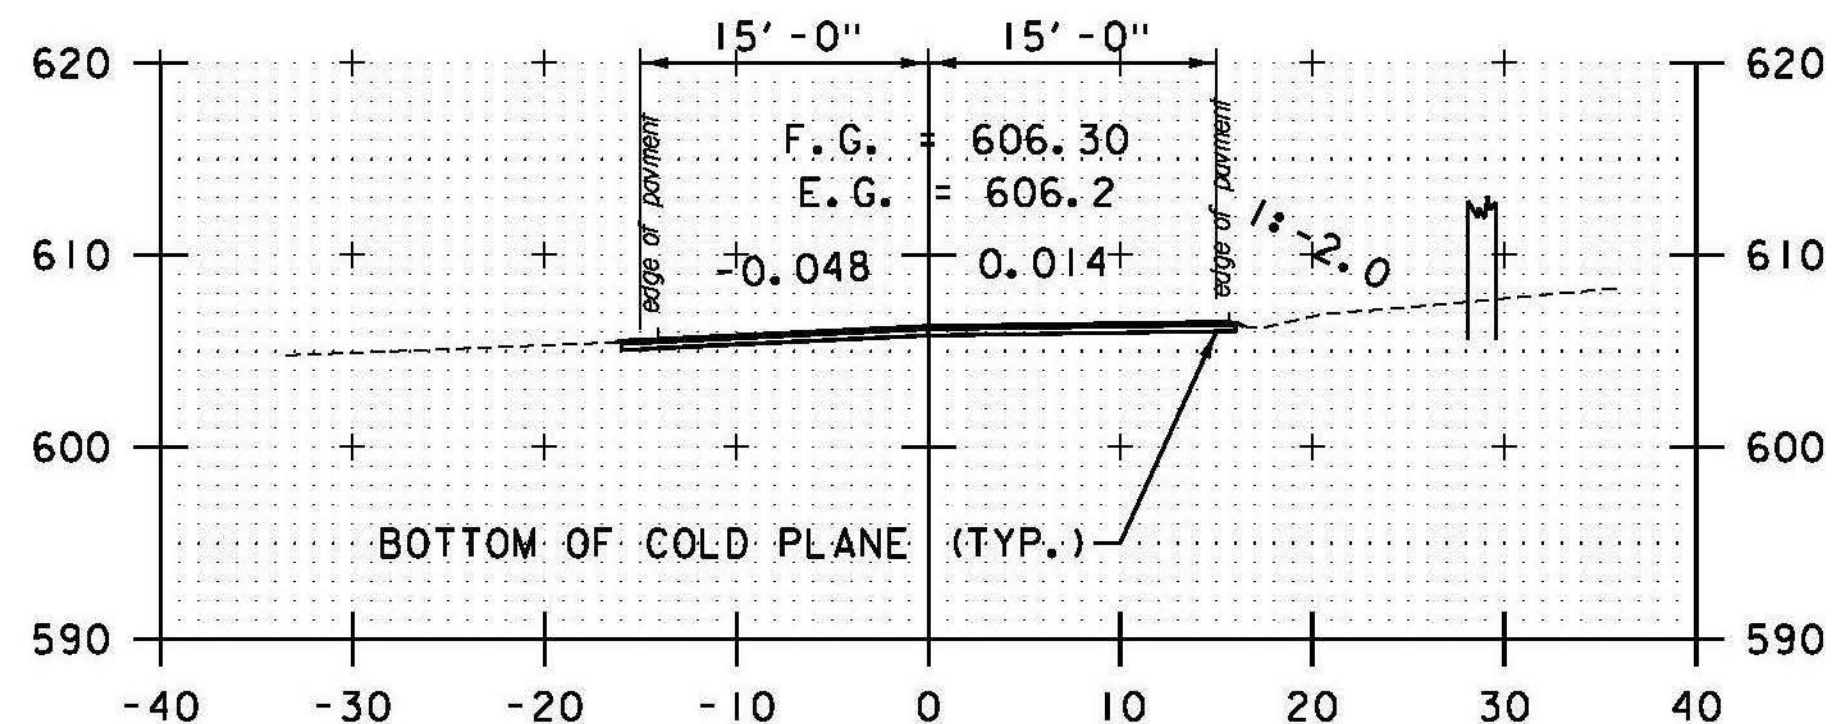


400+00

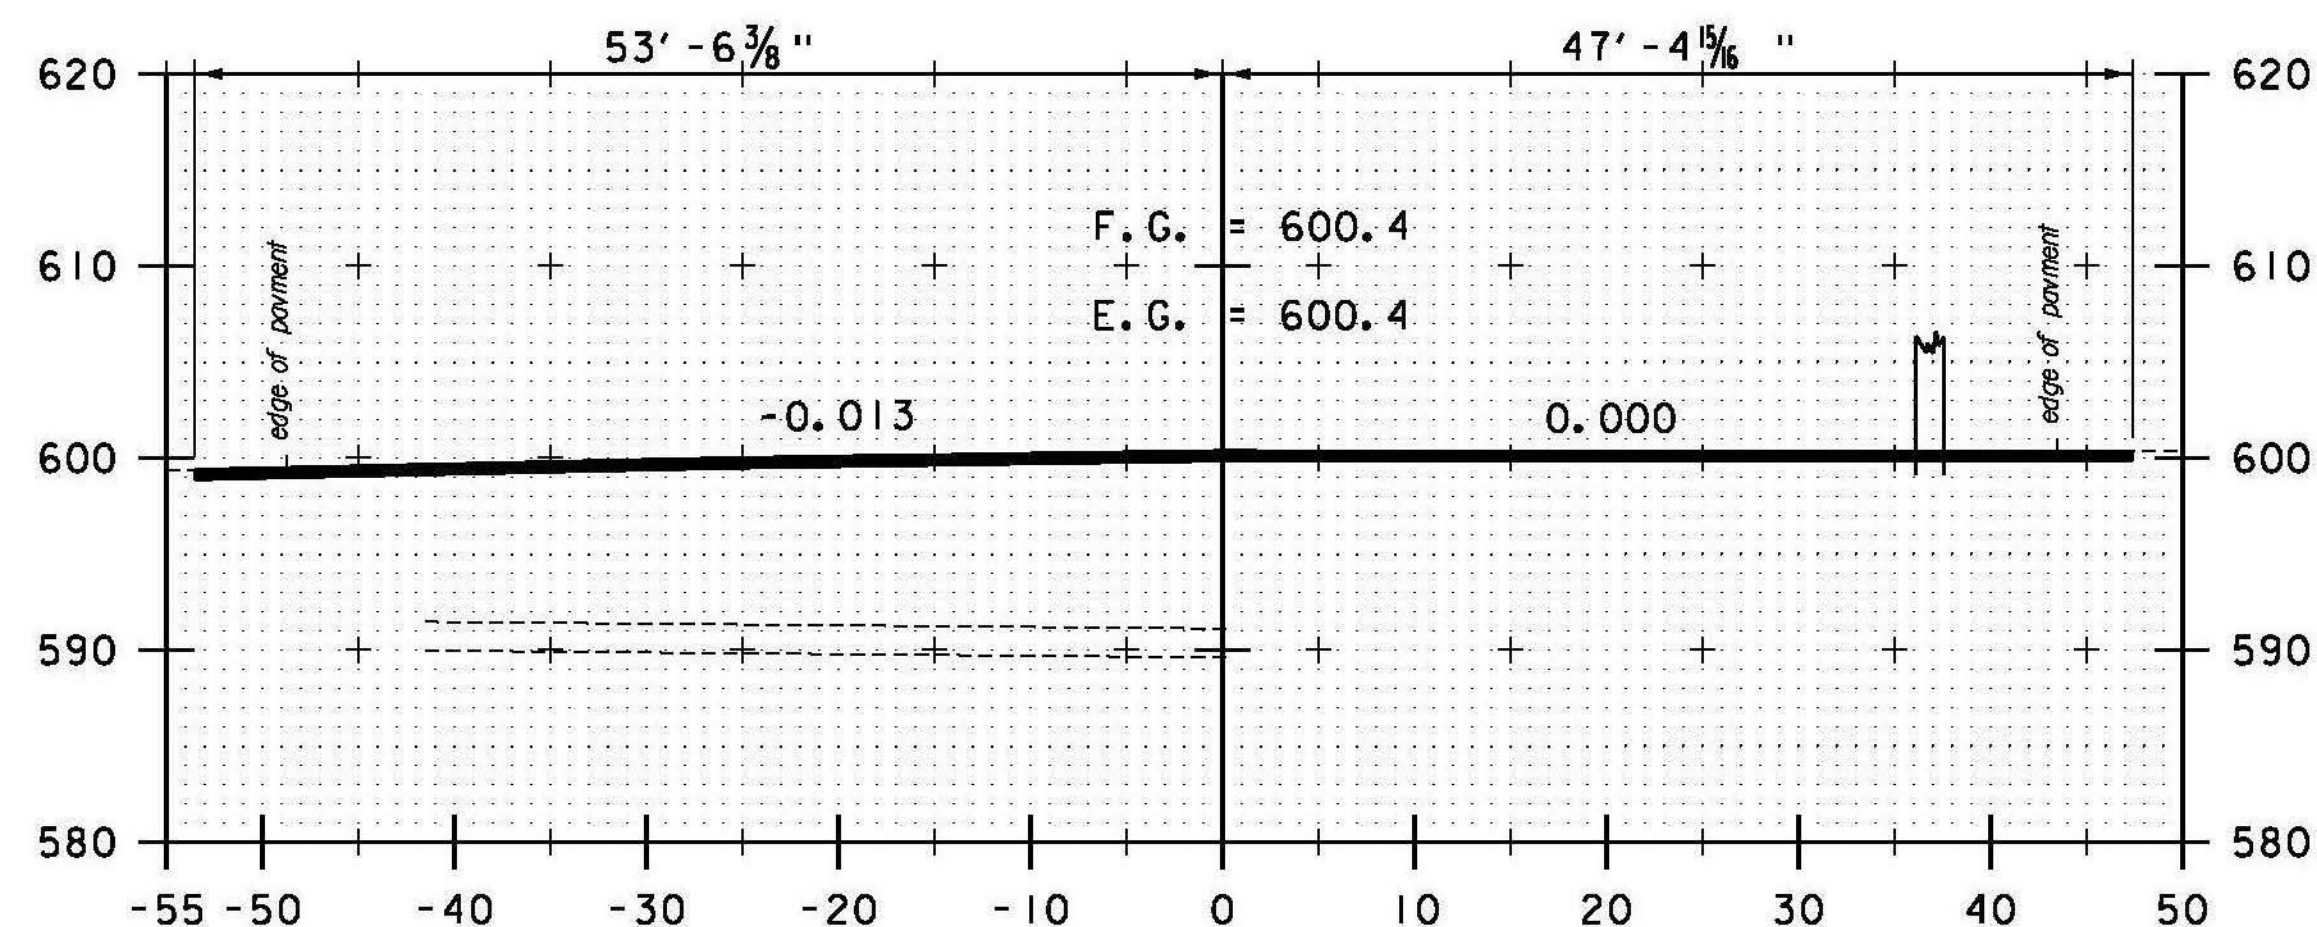

SKEWED / END PROJECT / MATCH EXISTING
401+37

STA. 400+00 TO STA. 401+54

DATUM
VERTICAL NAVD 88
HORIZONTAL NAD 83 (07)

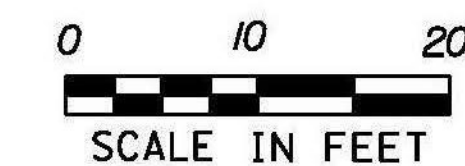

PROJECT NAME: RANDOLPH
PROJECT NUMBER: STP 2932 (1)

FILE NAME: z10c270.dgn
PROJECT LEADER: C. LATHROP
DESIGNED BY: B. BRESLEND
VT 66 CROSS SECTION SHEET 89
PLOT DATE: 6/5/2014
DRAWN BY: B. BRESLEND
CHECKED BY: C. LATHROP
SHEET 245 OF 276