




502+25

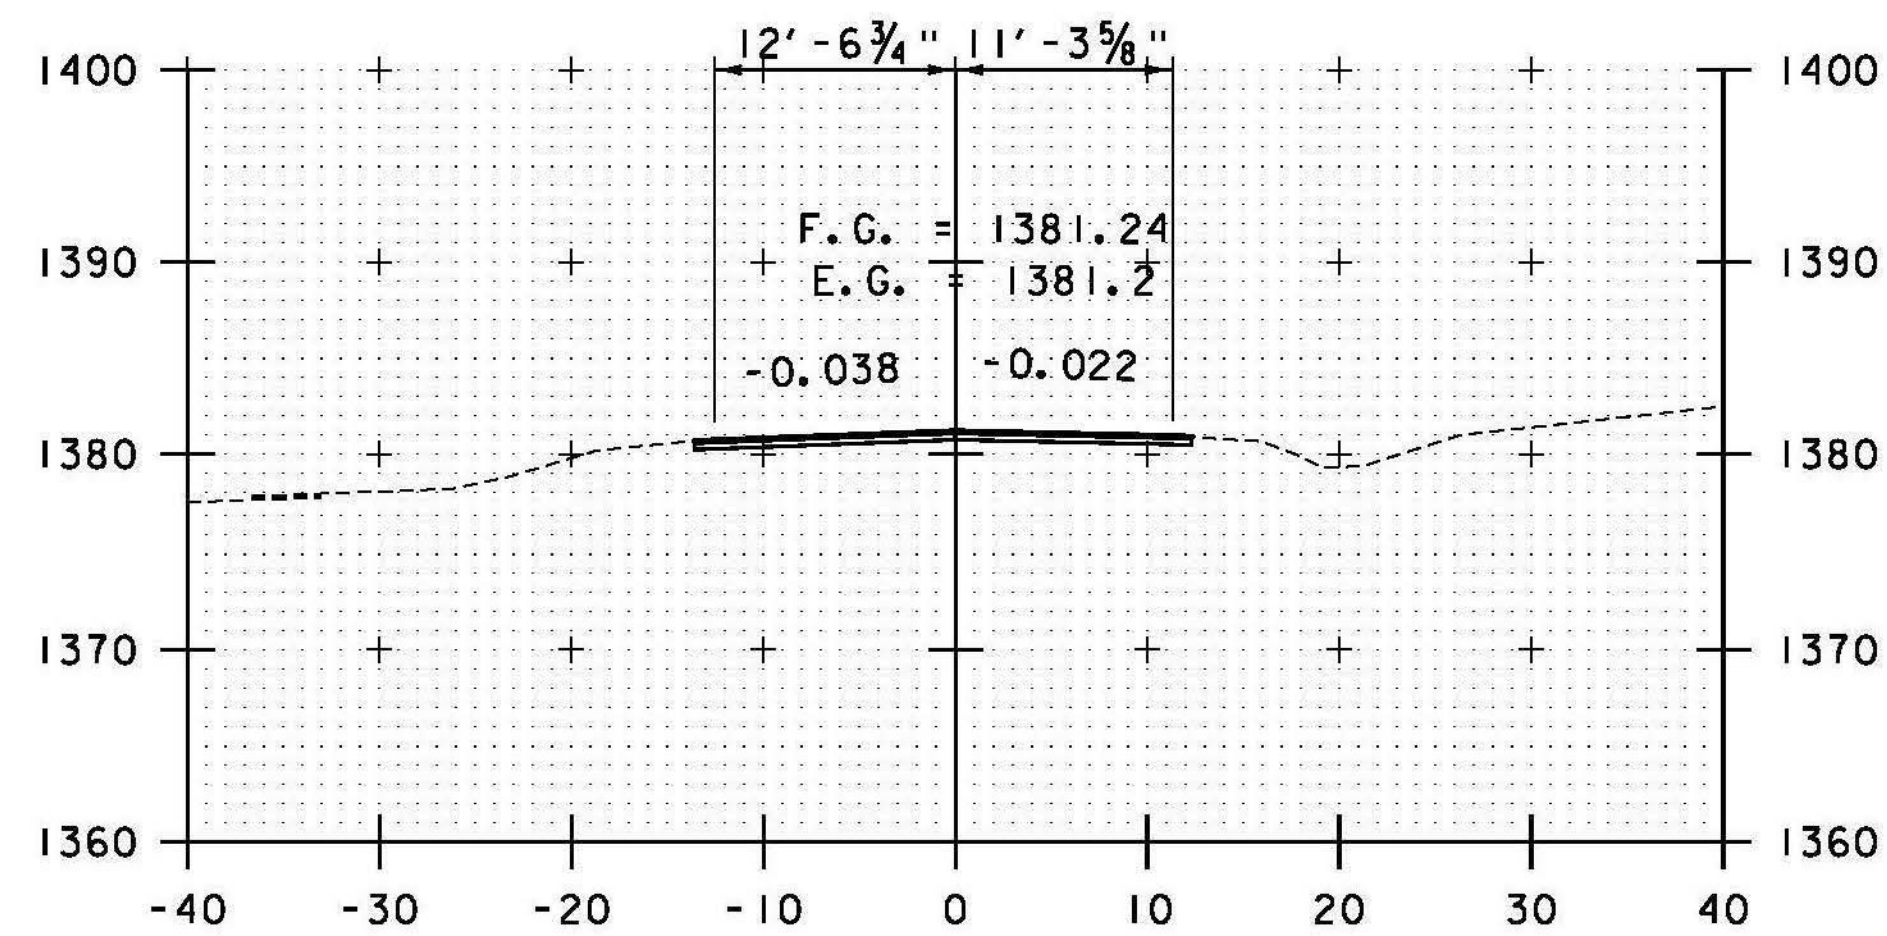


END APPROACH / MATCH EXISTING
502+10

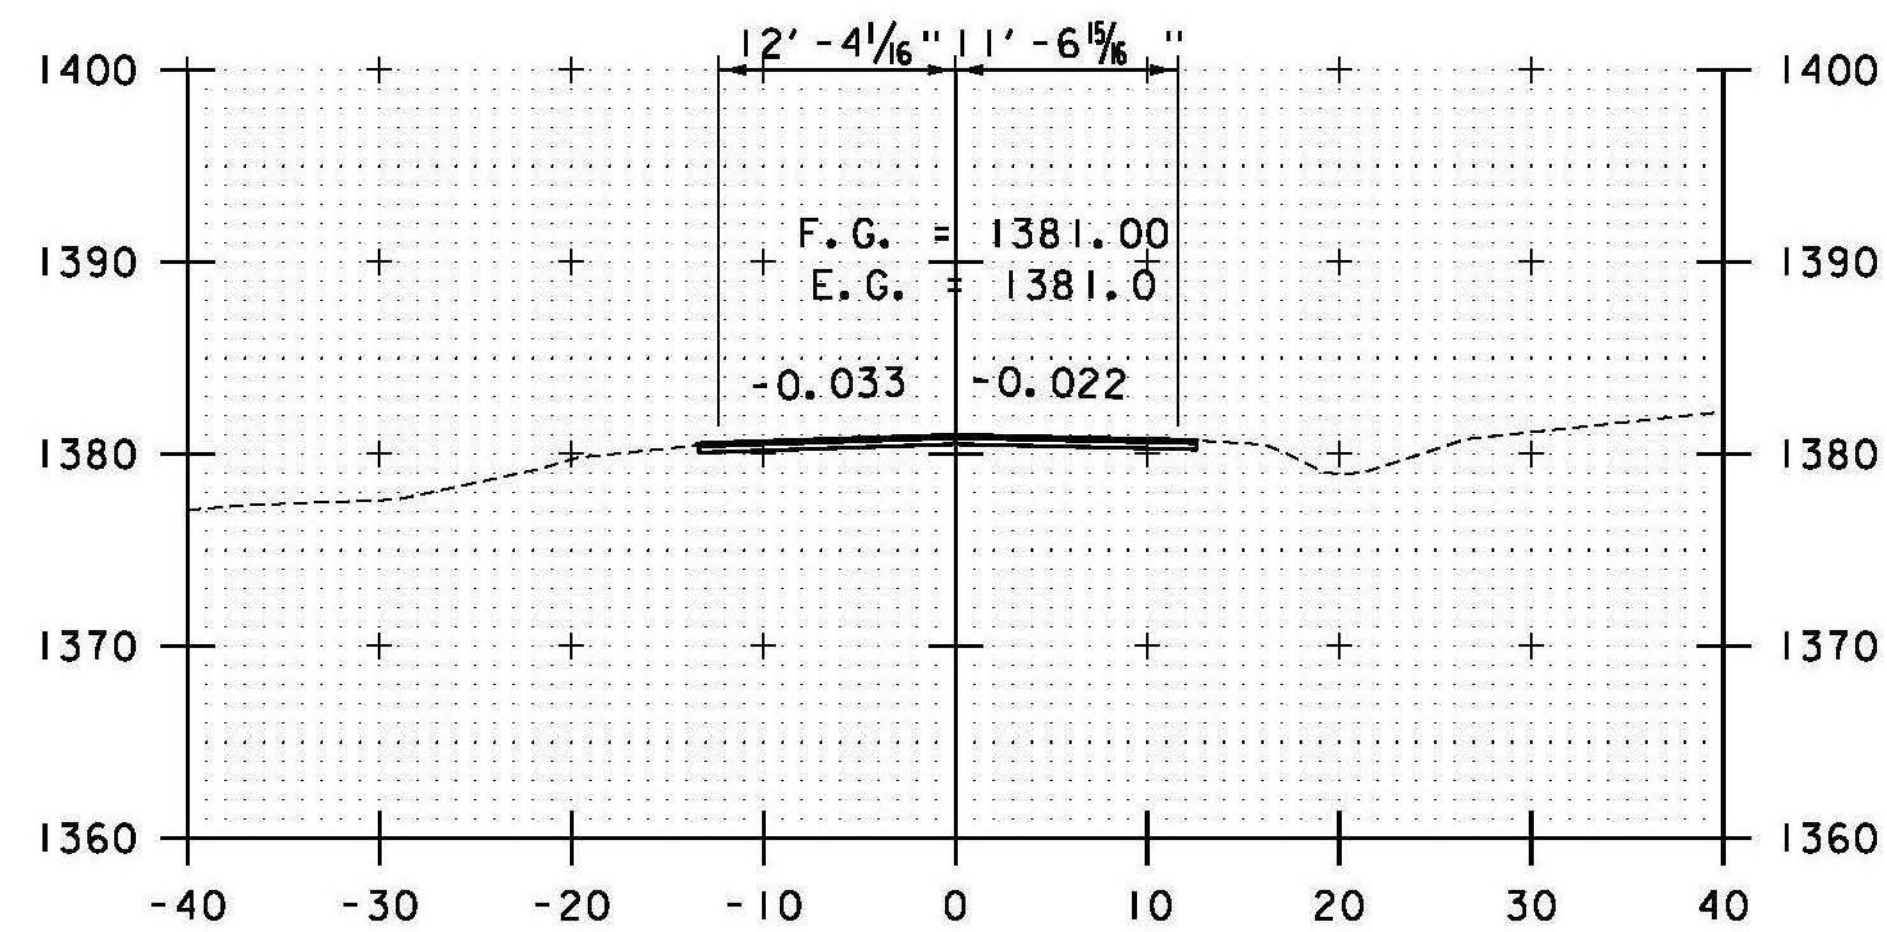


502+00

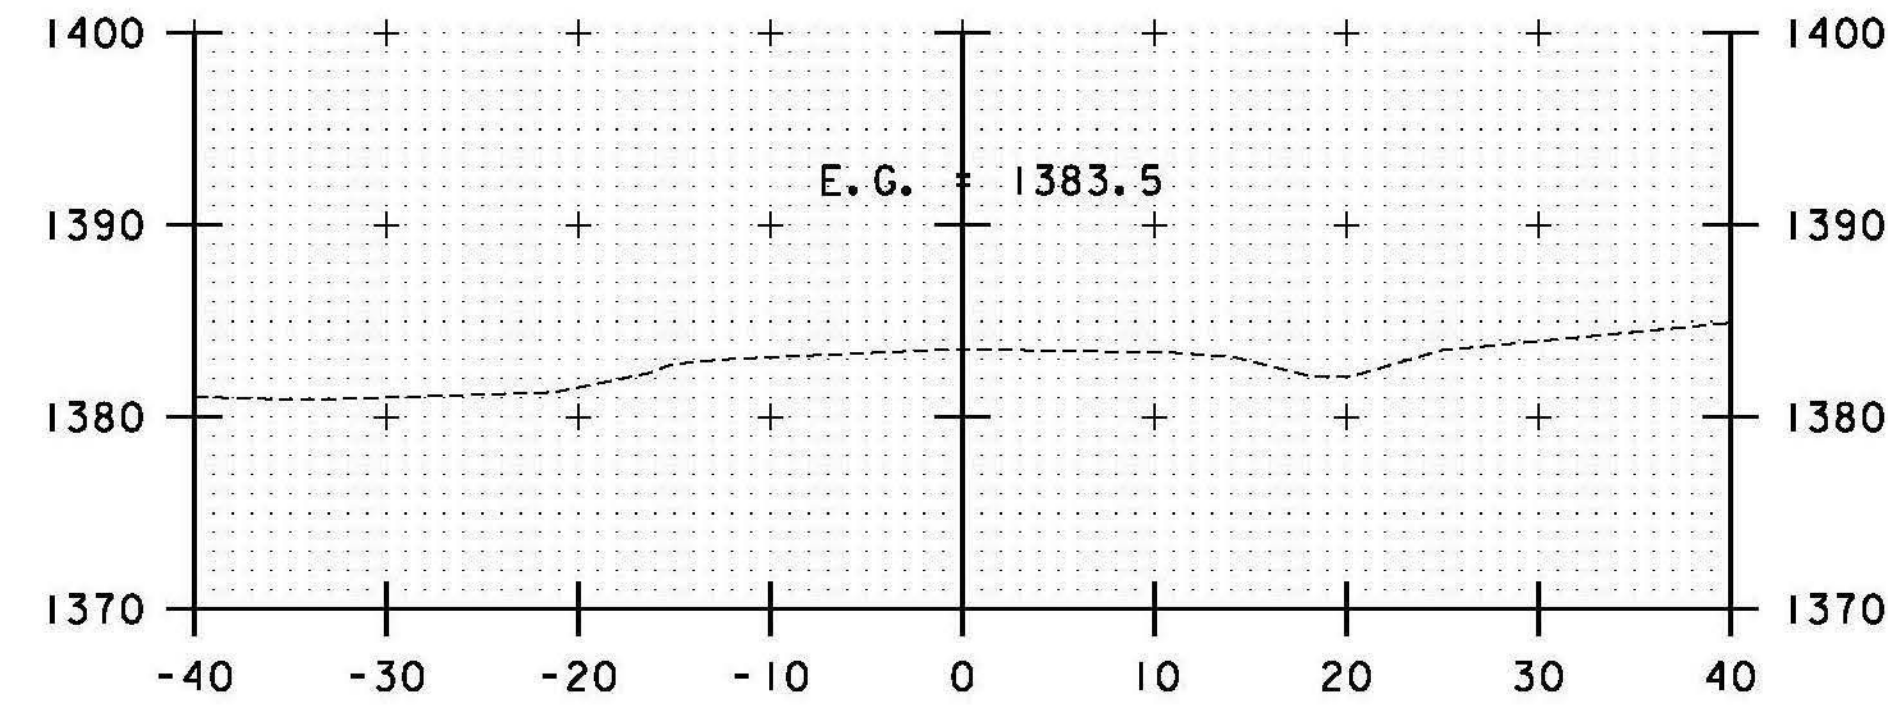

503+00

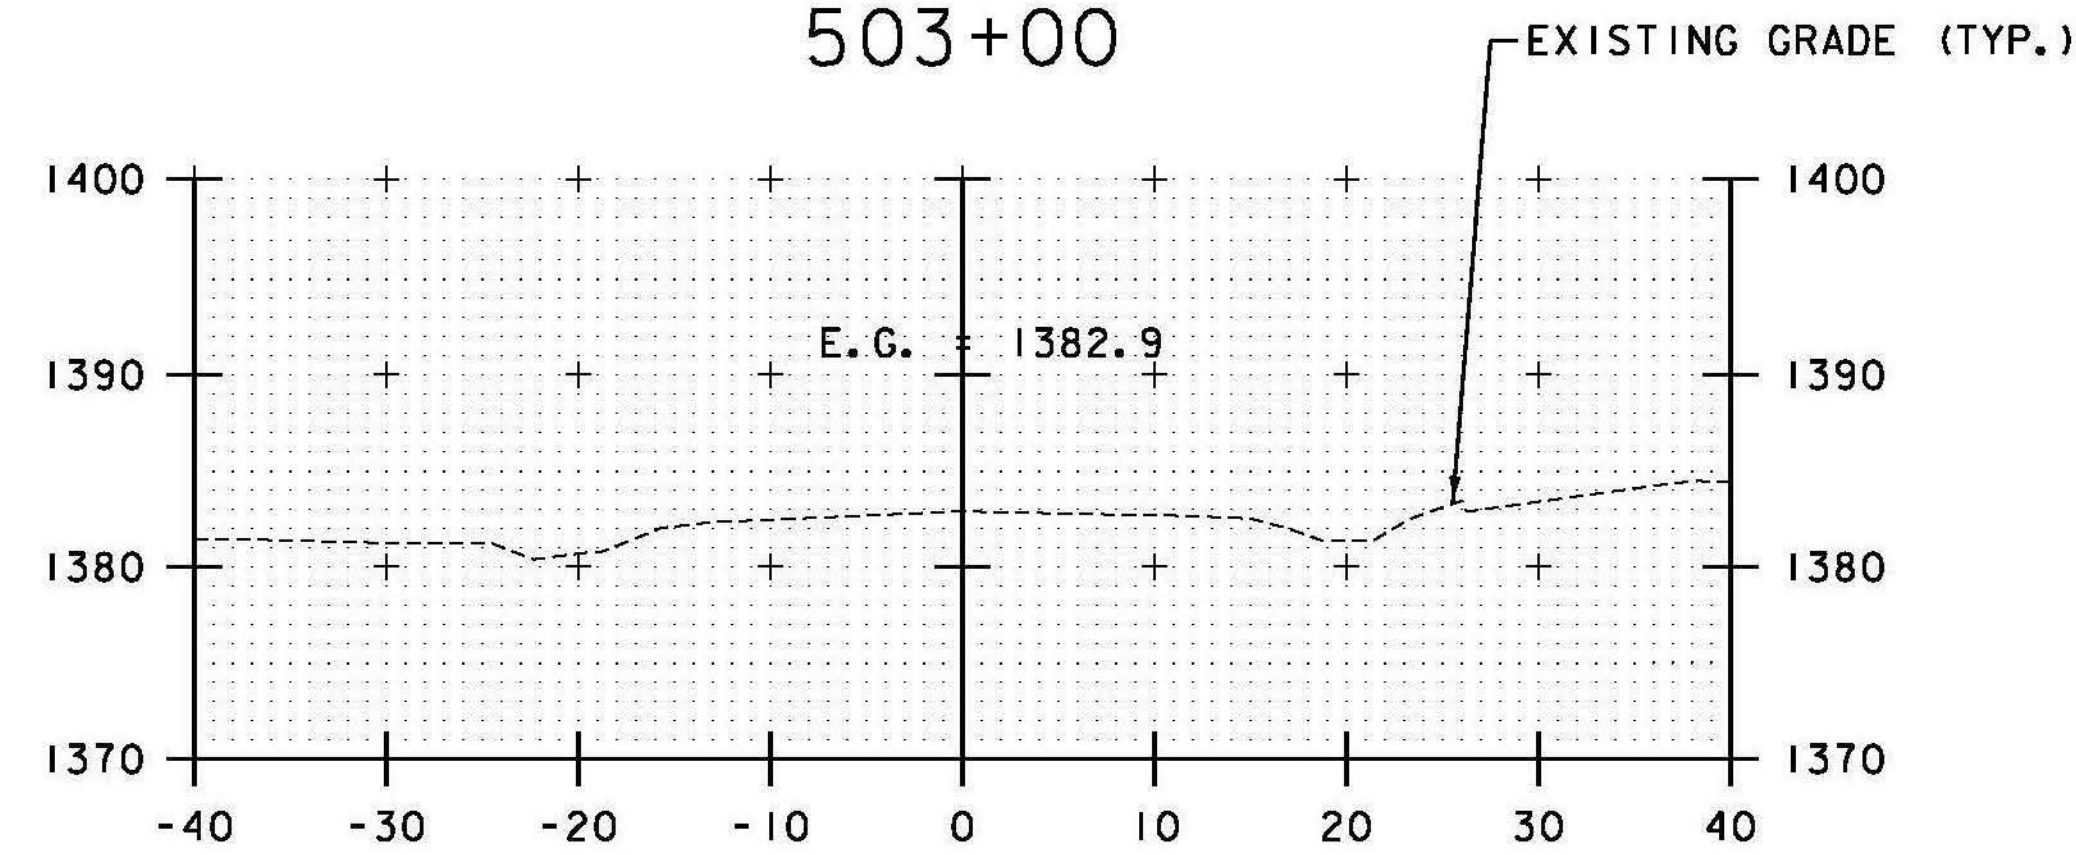


502+75

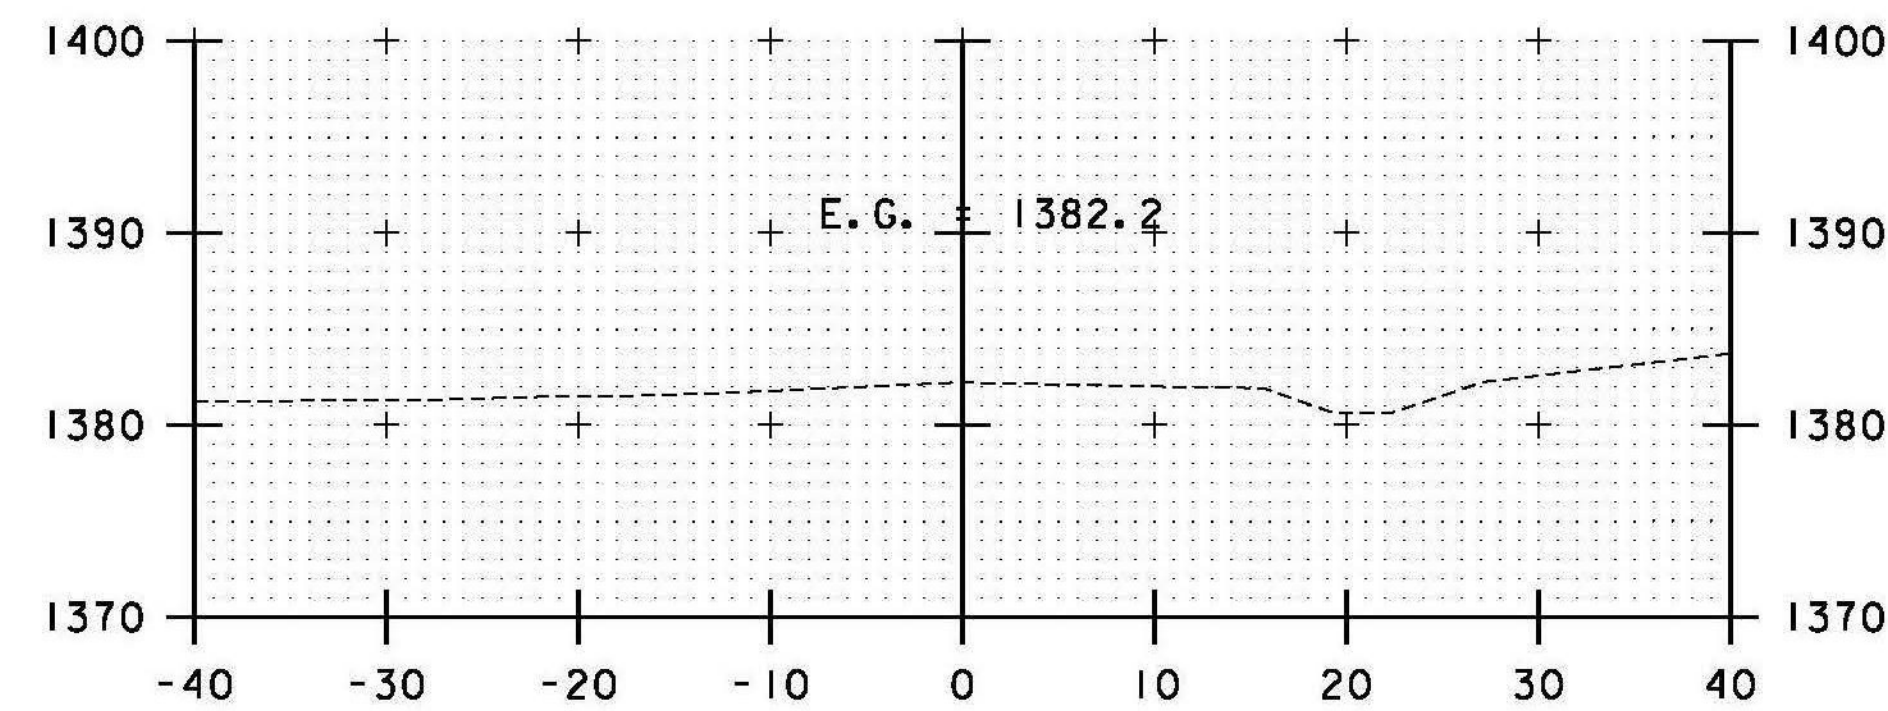

502+50

STA. 502+00 TO STA. 503+00

DATUM
VERTICAL NAVD 88
HORIZONTAL NAD 83 (07)

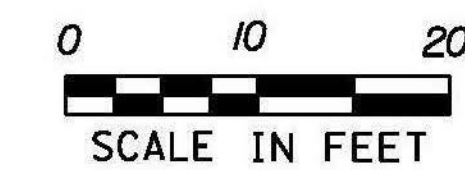

PROJECT NAME: RANDOLPH
PROJECT NUMBER: STP 2932 (1)

FILE NAME: z10c270.dgn	PLOT DATE: 6/5/2014
PROJECT LEADER: C. LATHROP	DRAWN BY: B. BRESLEND
DESIGNED BY: B. BRESLEND	CHECKED BY: C. LATHROP
TH #1 CROSS SECTION SHEET 2	SHEET 247 OF 276