



DRIVE RT
36+78

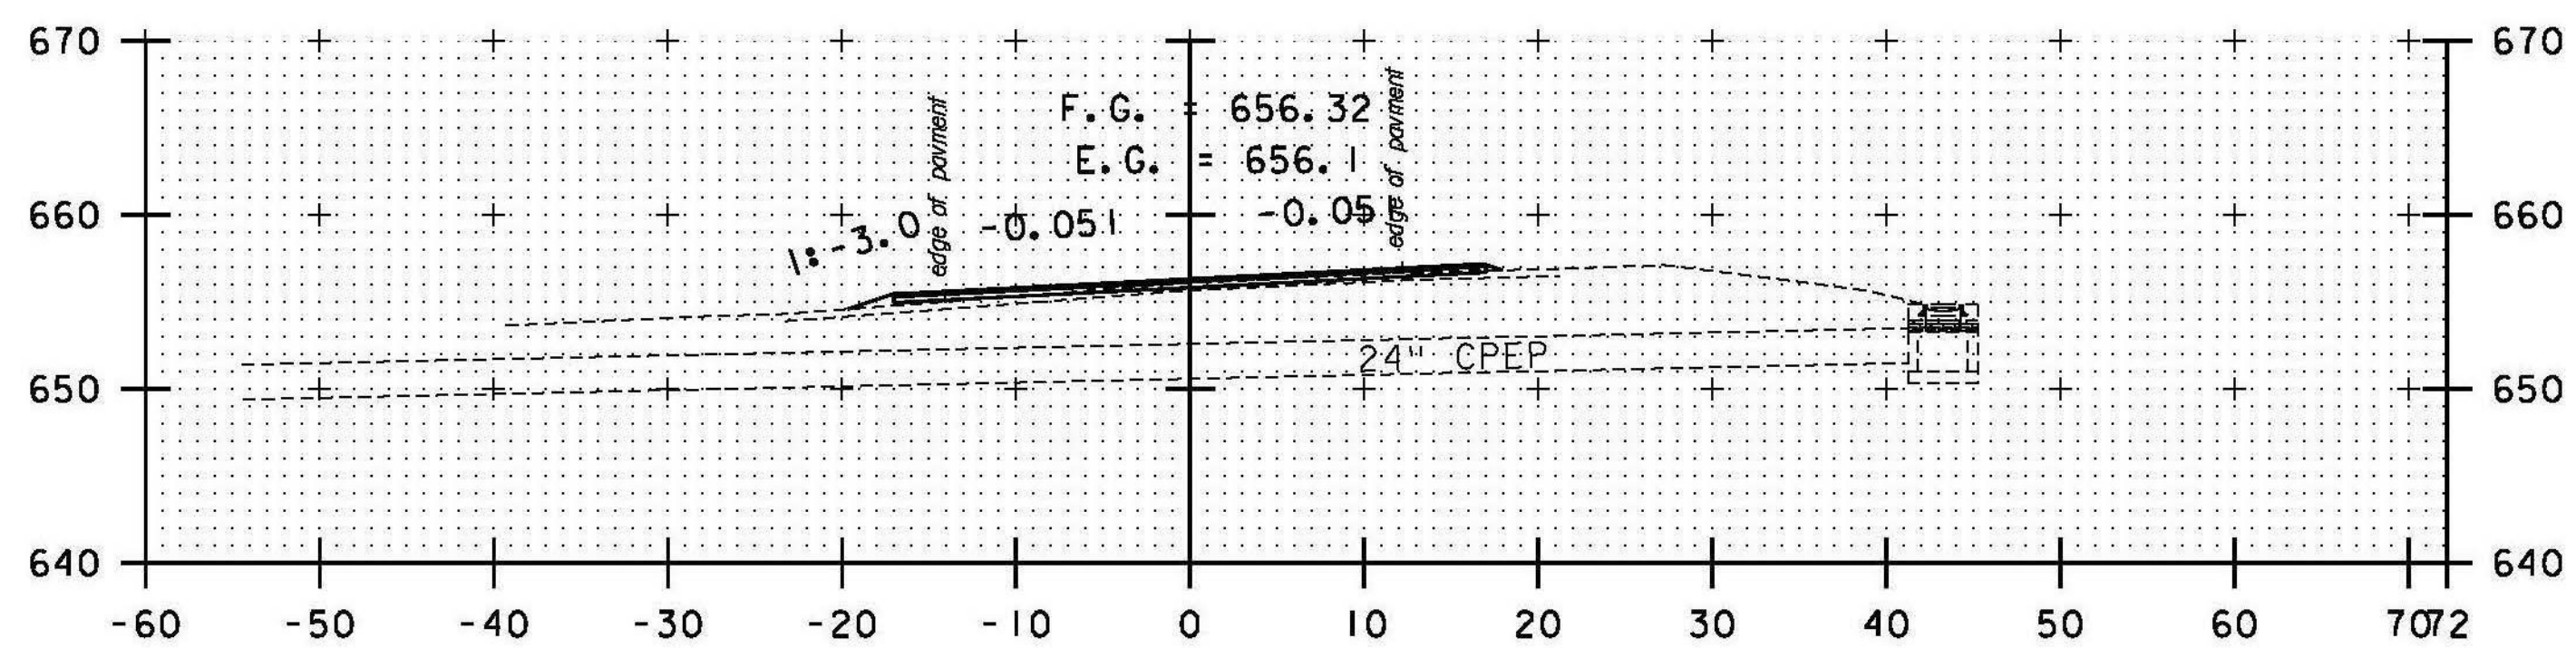


34+29

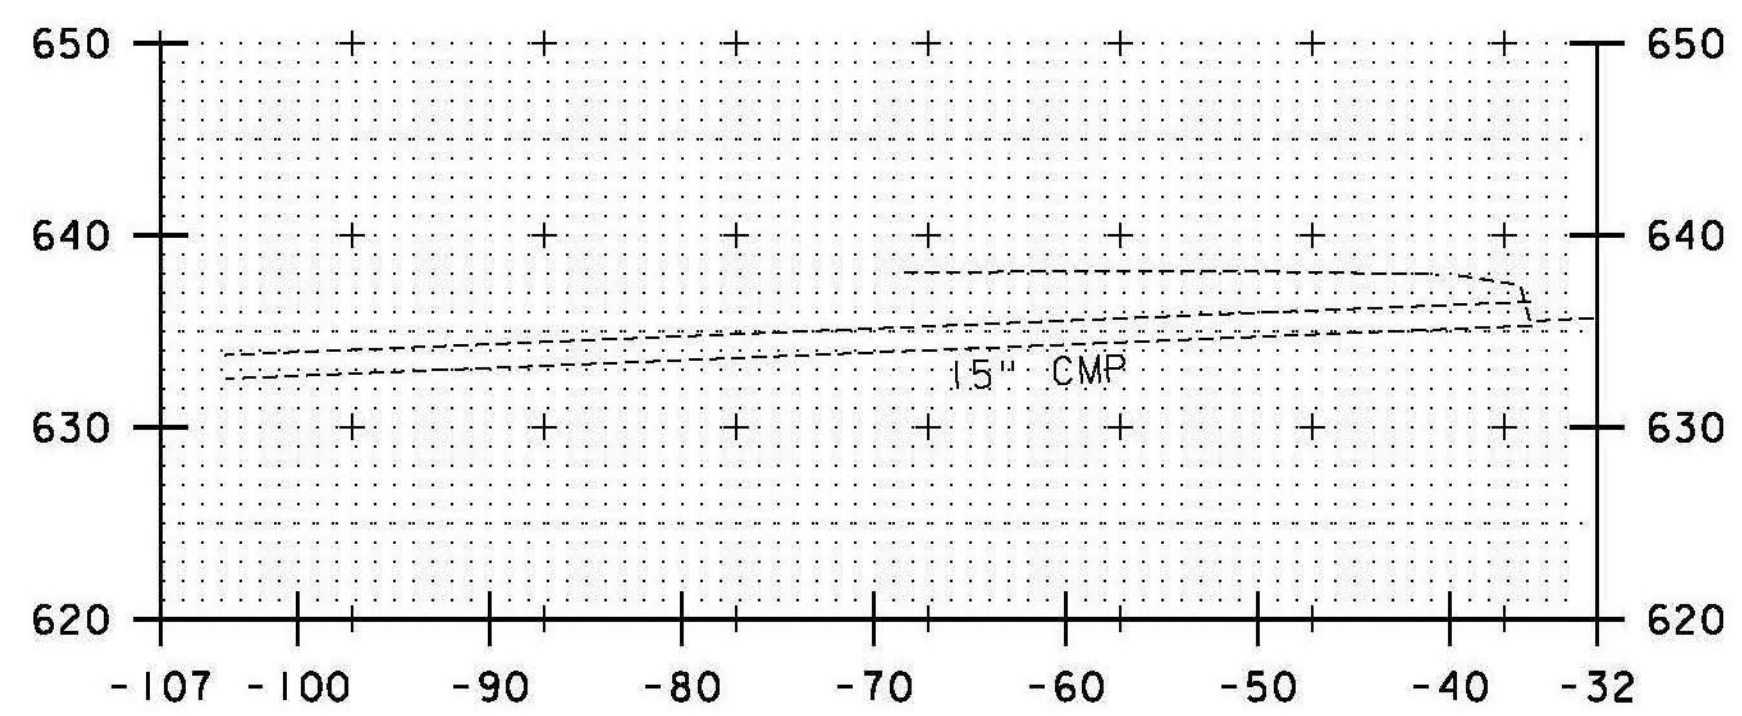

DRIVE LT
23+97

DATUM
VERTICAL NAVD 88
HORIZONTAL NAD 83

STA. 23+97 TO STA. 36+78

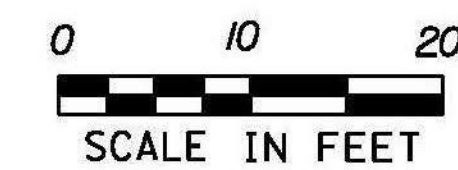

PROJECT NAME: RANDOLPH	PLOT DATE: 6/5/2014
PROJECT NUMBER: STP 2932 (1)	DRAWN BY: B. BRESLEND
FILE NAME: z10c270.dgn	CHECKED BY: C. LATHROP
PROJECT LEADER: C. LATHROP	SHEET 248 OF 276
DESIGNED BY: B. BRESLEND	CULVERT CROSS SECTION SHEET 1